



INTERIOR ELEVATIONS - LABORATORY
SCALE 1/4" = 1'-0"

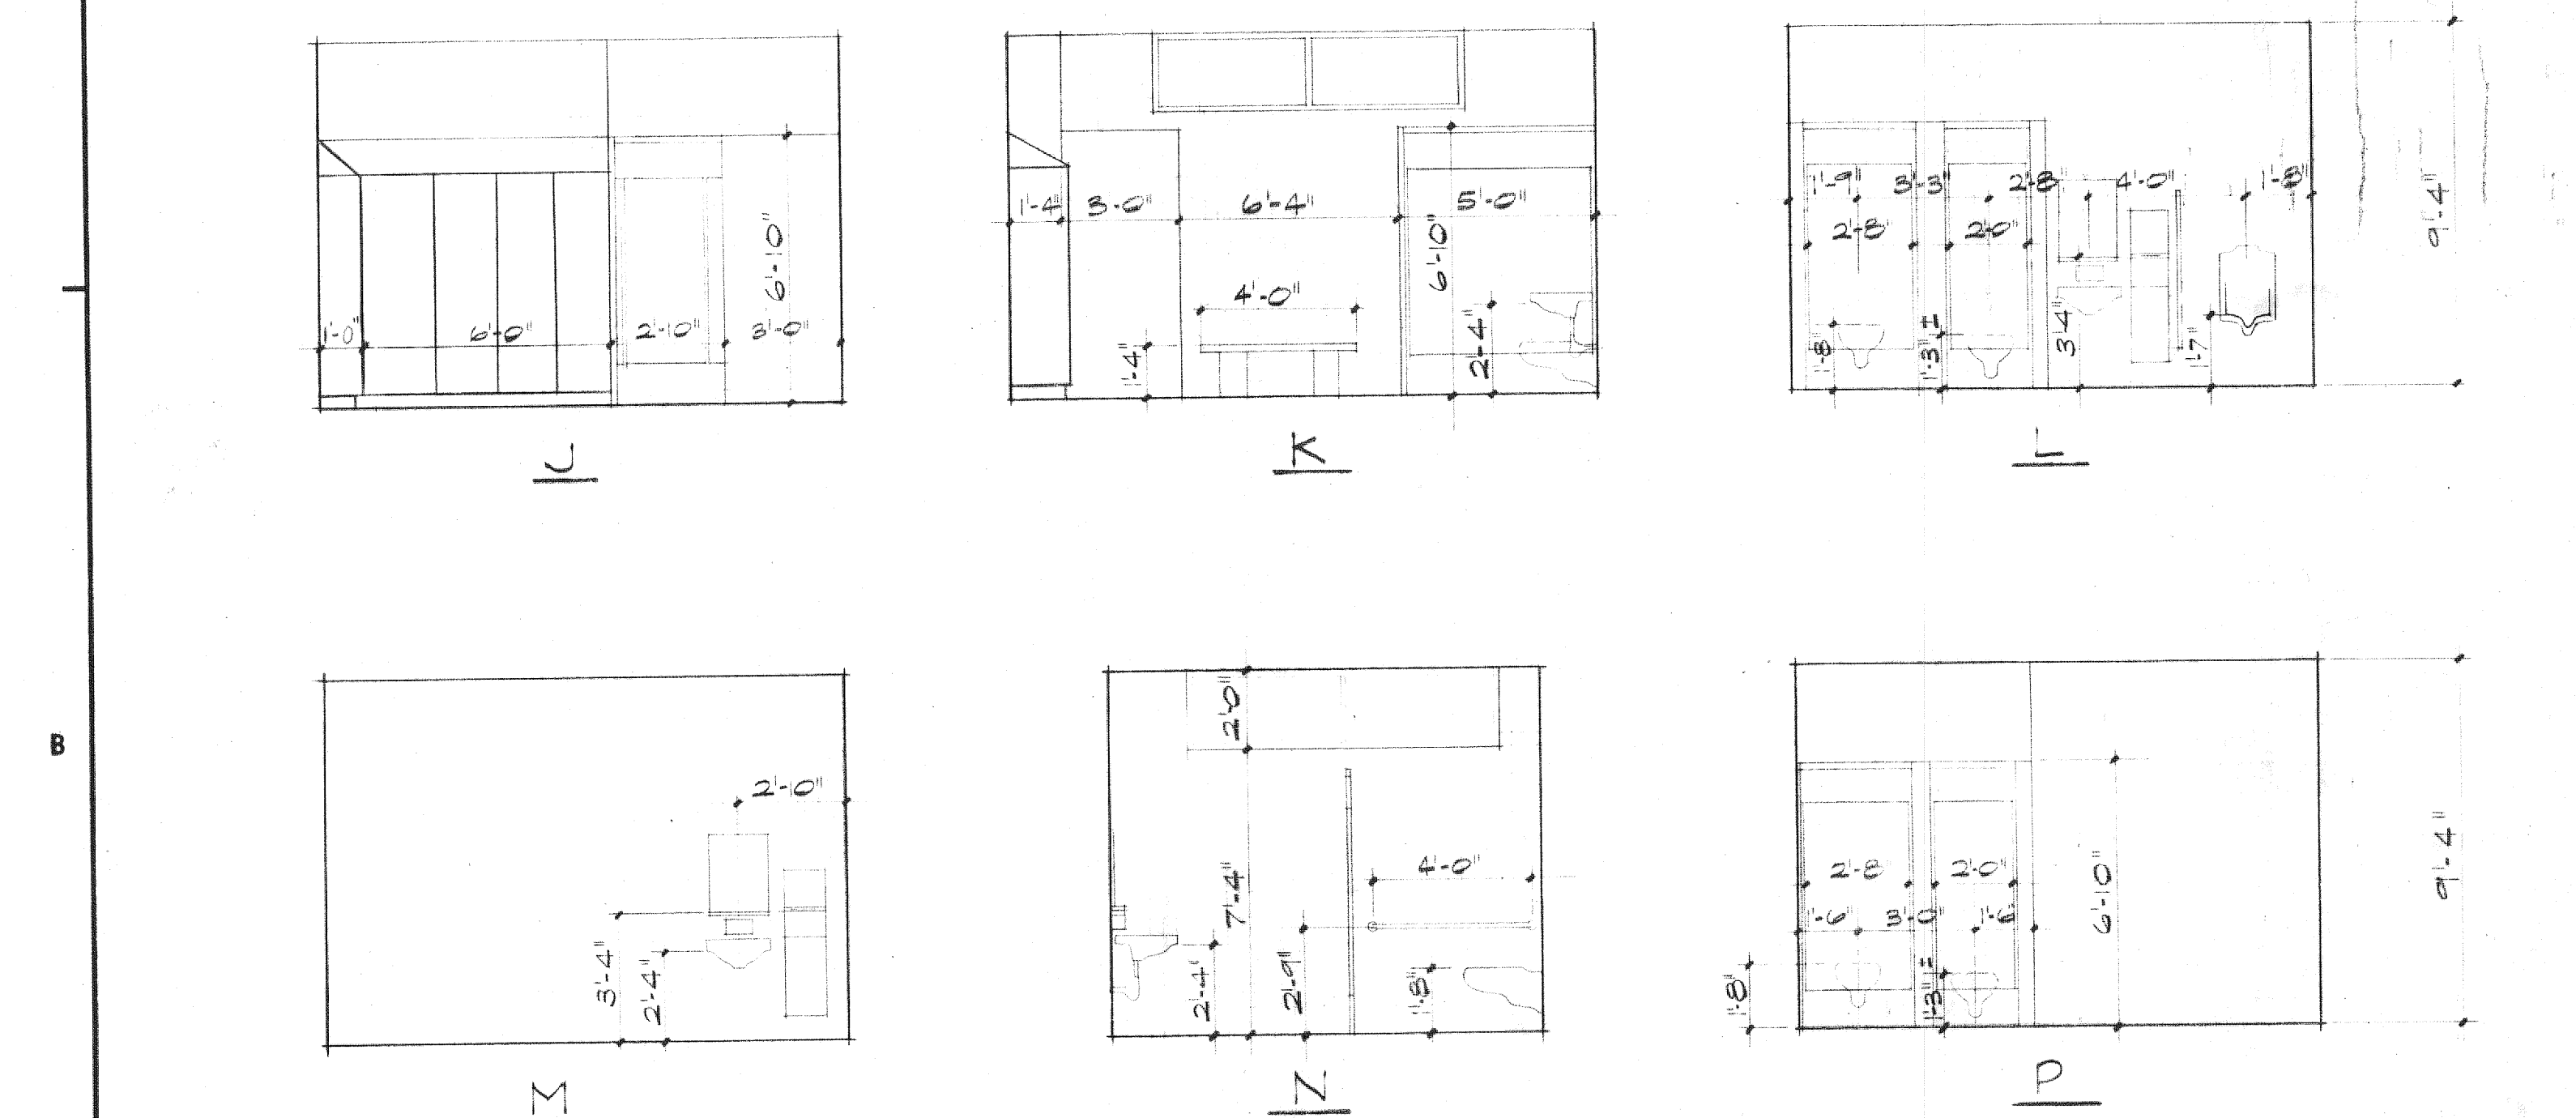

INTERIOR ELEVATIONS - TOILET & LOCKER ROOMS
SCALE 1/4" = 1'-0"

NOTES:
1. THE SUSPENDED CEILINGS IN THE LOBBY AND CONFERENCE ROOM ARE 10'-4" HIGH FROM THE FLOOR; ALL OTHER CEILINGS ARE 9'-4" HIGH.
2. THE AREAS SHOWN CROSSED INDICATE REVEALED EDGE TYPE OF CEILING PANELS.

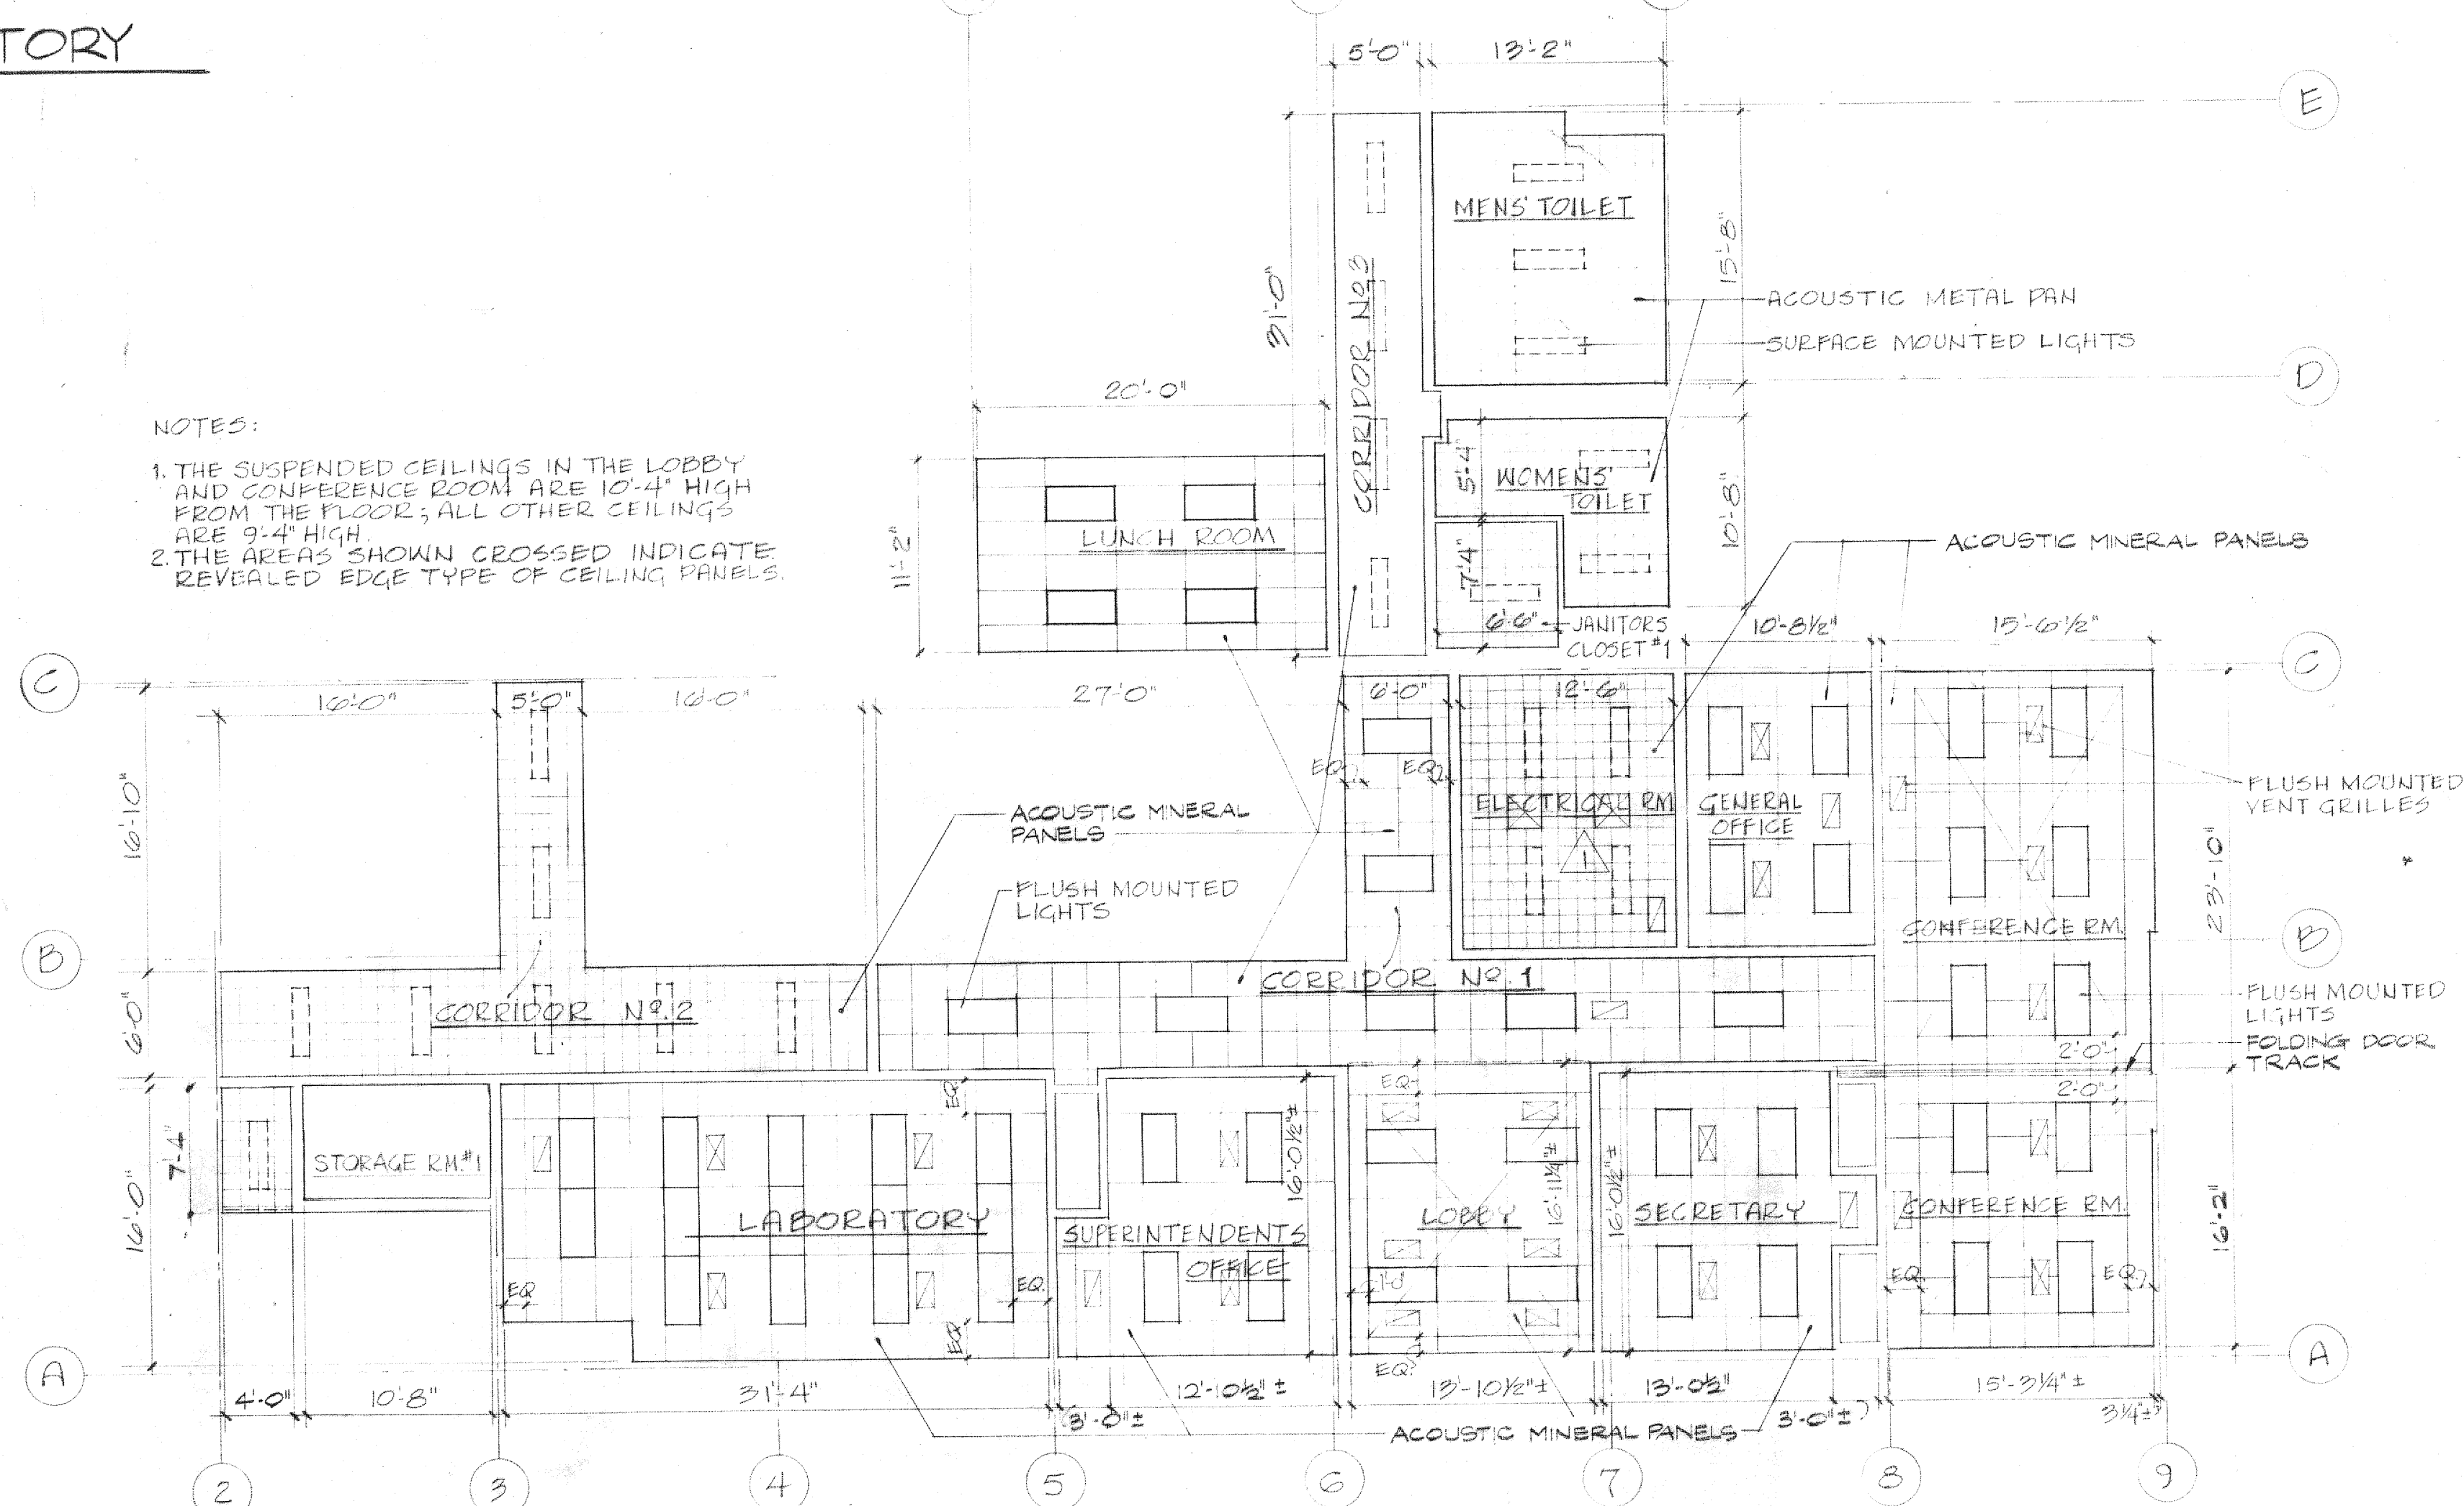

REFLECTED CEILING PLAN
SCALE 1/8" = 1'-0"

RECORD DRAWING

--	--	