
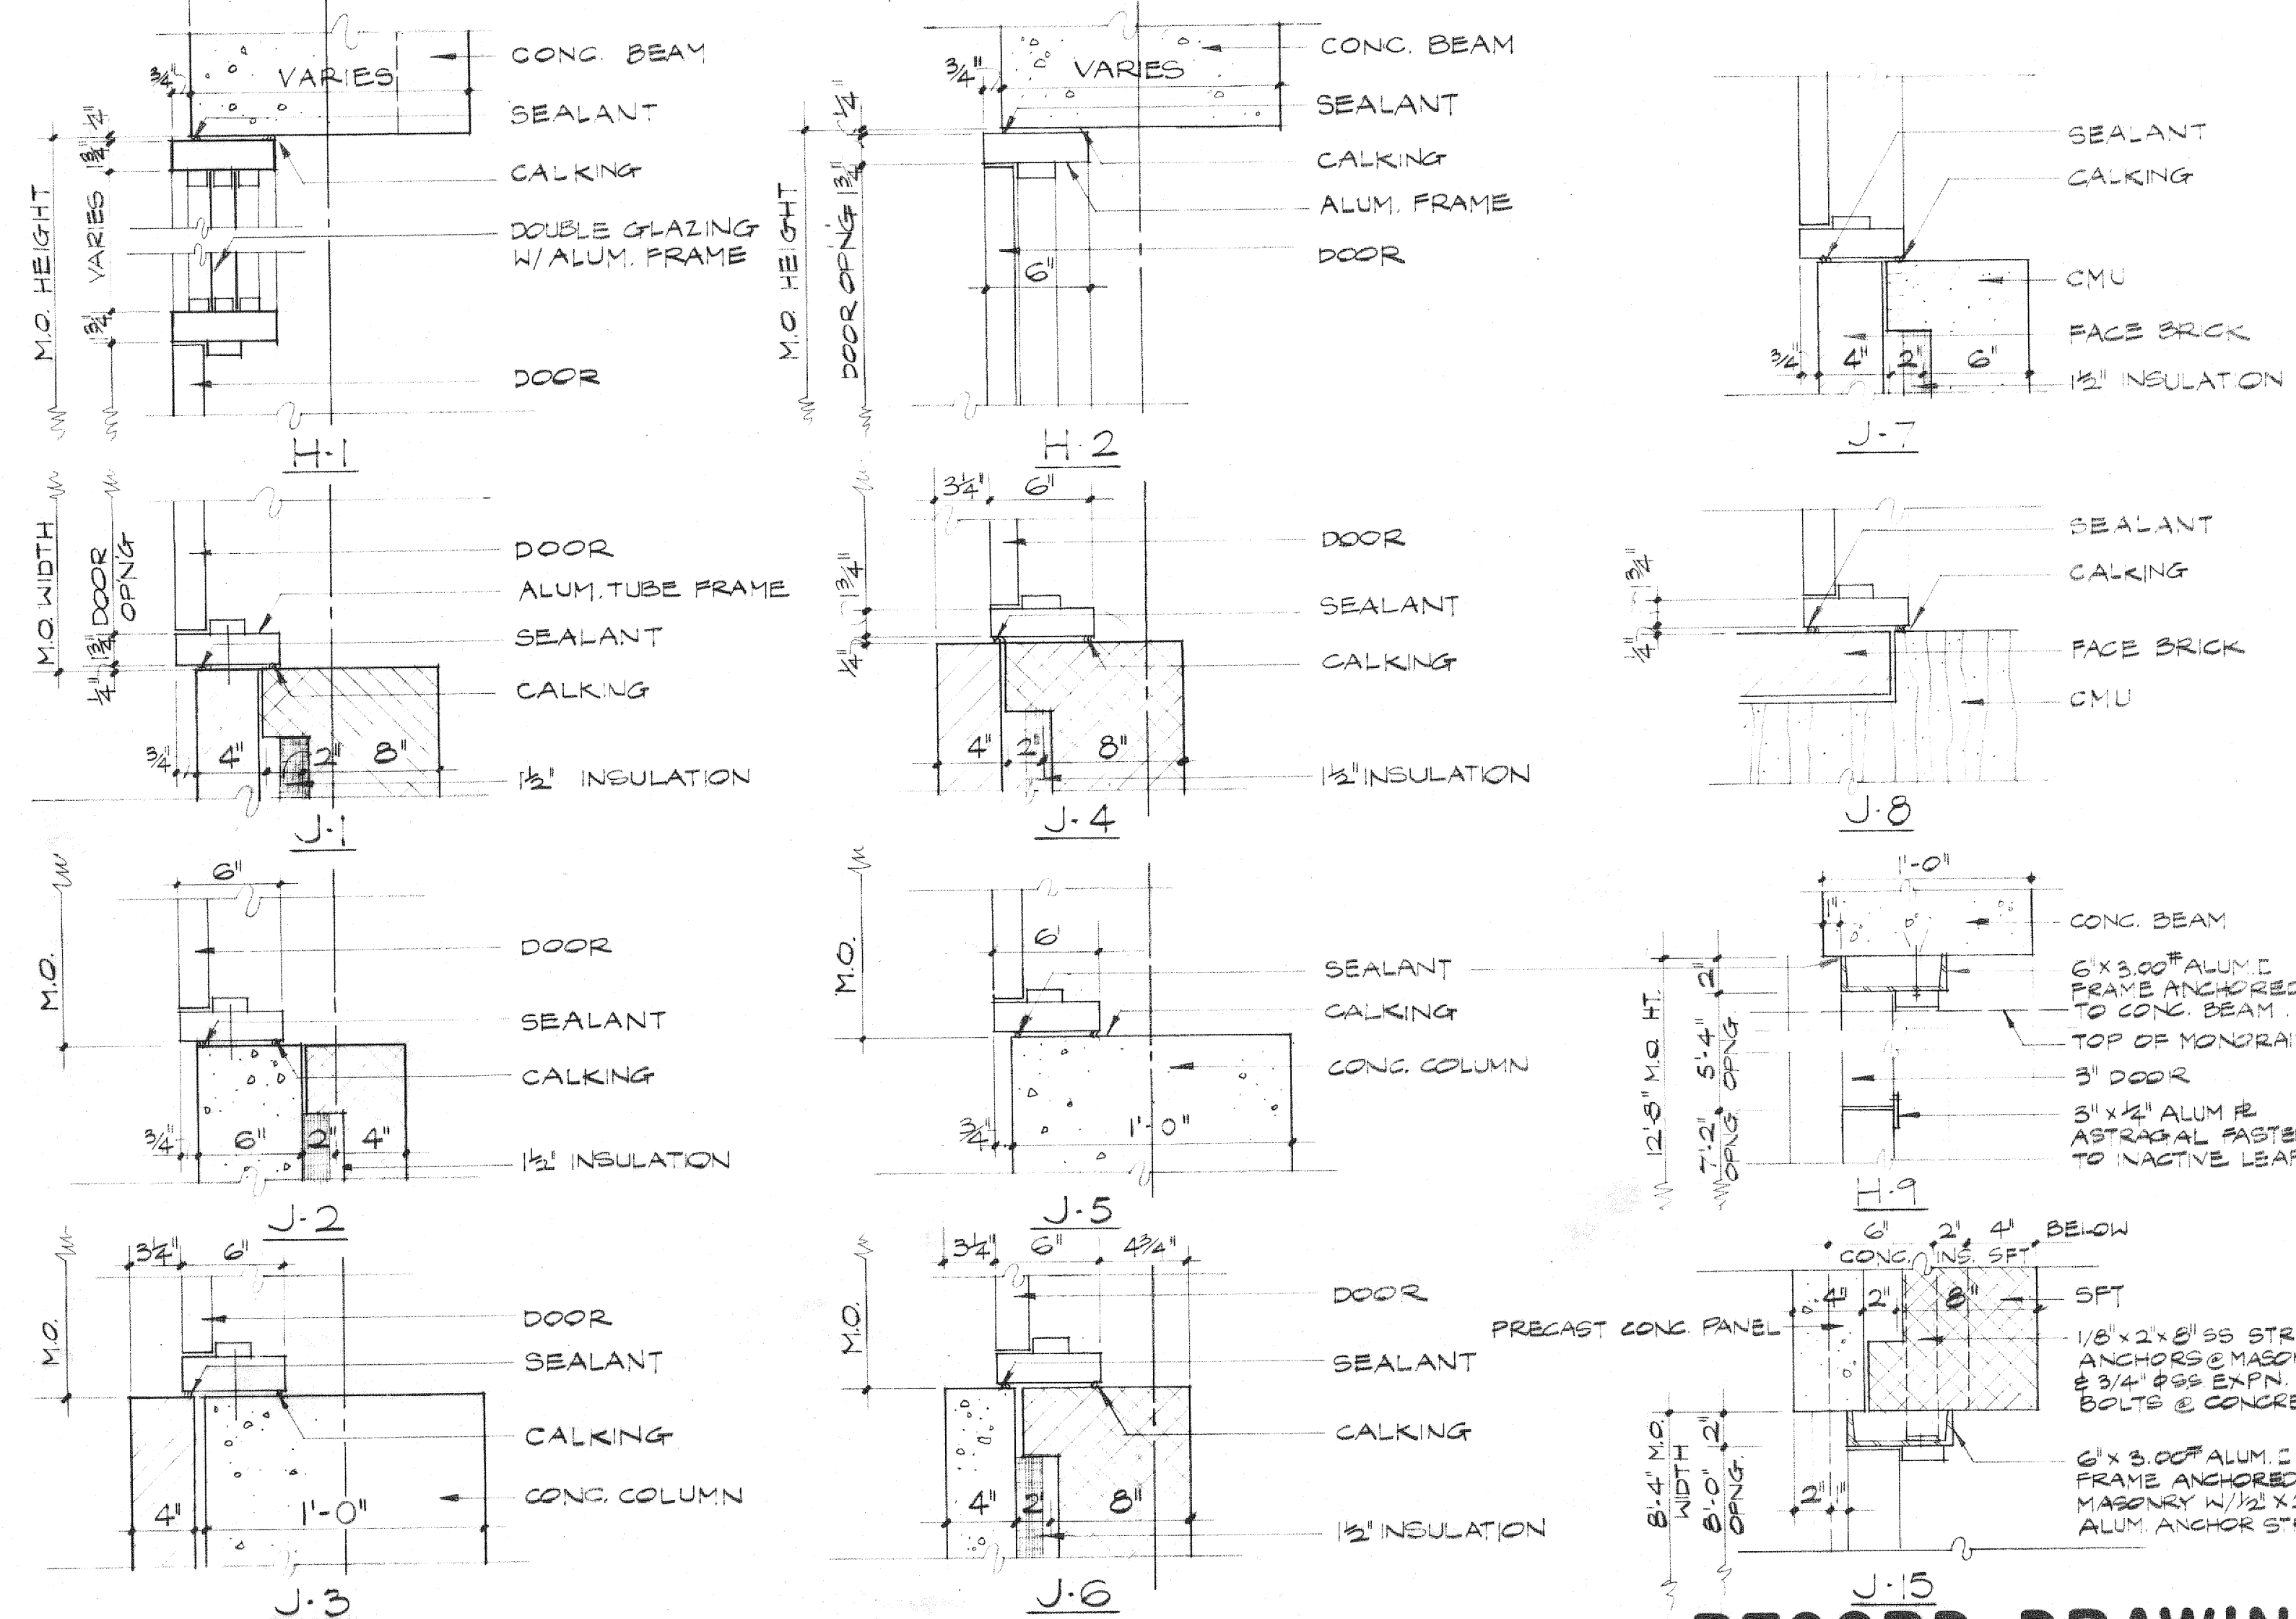


## DOOR SCHEDULE

BUILDING	FLOOR	LOCATION	DOOR NUMBER	DOOR OPENING	MATERIAL		DOOR TYPE	DETAILS			DOOR SWING	HARDWARE SET NUMBER	THRESHOLD	WEATHER STRIPPING	FIRE LABEL	REMARKS
					DOOR	FRAME		HEAD	JAMB	SILL						
D	FIRST FLOOR	LOBBY	1	PR. 3'-0" x 7'-0"	ALUMINUM	ALUMINUM TUBE	FG	*	*	S-1	LHR ACTIVE	-	●	●		*SEE ENTRANCE DETAILS FOR N-1 ON DRAWINGS A-16 & 17 WITH GLAZED TRANSOM
		STAIR NO. 3	2	3'-0" x 7'-2"	ALUMINUM	ALUMINUM TUBE	F	H-1	J-1	S-1	LHR	11	●	●		
		STAIR NO. 4	3	PR. 2'-6" x 9'-2"	ALUMINUM	ALUMINUM TUBE	V	H-2	J-1&4	S-2	LHR ACTIVE	12	●	●		
		CHLORINE SCALE ROOM	4	4'-0" x 12'-6"	ALUMINUM/3 IN.	STRUCTURAL ALUMINUM	SP	H-9	J-15	S-2	RHR ACTIVE	14				SPECIAL DOOR, SEE TYPE, WITH CUT-OUT FOR MONORAIL
		CHLORINATOR ROOM	5	3'-0" x 7'-2"	ALUMINUM	ALUMINUM TUBE	V	H-1	J-5&6	S-2	LHR	17				WITH LOUVERED TRANSOM
		SULPHUR DIOXIDE ROOM	6	3'-0" x 7'-2"	ALUMINUM	ALUMINUM TUBE	V	H-1	J-5&6	S-2	LHR	17				WITH LOUVERED TRANSOM
		CORRIDOR NO. 2	7	3'-0" x 7'-2"	ALUMINUM	ALUMINUM TUBE	V	H-1	J-5&6	S-1	RHR	11	●	●		WITH GLAZED TRANSOM
		LIME STORAGE ROOM	8	PR. 3'-0" x 7'-2"	ALUMINUM	ALUMINUM TUBE	V	H-2	J-5&6	S-2	LHR ACTIVE	13				WITH LOUVERED TRANSOM
		GARAGE AND MAINTENANCE	9	12'-0" x 12'-8"	STEEL SECTIONS	STEEL GUIDES	OH	H-3	J-9	-	-	-				OVERHEAD TYPE DOOR
		GARAGE AND MAINTENANCE	10	12'-0" x 12'-8"	STEEL SECTIONS	STEEL GUIDES	OH	H-3	J-9	-	-	-				OVERHEAD TYPE DOOR
		TRUCKWAY	11	12'-0" x 13'-4"	STEEL SECTIONS	STEEL GUIDES	OH	H-3	J-9	-	-	-				OVERHEAD TYPE DOOR
		STAIR NO. 1	12	3'-0" x 7'-2"	ALUMINUM	ALUMINUM TUBE	F	H-1	J-5&6	S-1	LHR	11	●	●		WITH GLAZED TRANSOM
		SUPERINTENDENT'S OFFICE	13	3'-0" x 7'-2"	WOOD	PRESSED METAL	F	H-5	J-11	S-4	RH	21				
		LABORATORY	14	3'-0" x 7'-2"	WOOD	PRESSED METAL	G	H-4	J-10	S-3	LH	21A				
		LABORATORY	15	3'-0" x 7'-2"	HOLLOW METAL	PRESSED METAL	V	H-4	J-10	S-3	LH	21A				
		STORAGE ROOM NO. 1	16	3'-0" x 7'-2"	HOLLOW METAL	PRESSED METAL	LL	H-4	J-10	-	LH	23A				WITH 24" x 12" TOP & BOTTOM LOUVERS
		STAIR NO. 3	17	3'-0" x 7'-2"	HOLLOW METAL	PRESSED METAL	V	H-4	J-10	S-3	RH	24A				
		CORRIDOR NO. 1	18	3'-0" x 7'-2"	WOOD	PRESSED METAL	V	H-4	J-10	S-3	LHR	24A				
		STAIR NO. 2	19	3'-0" x 7'-2"	WOOD	PRESSED METAL	V	H-4	J-10	S-3	RHR	24A				
		CORRIDOR NO. 3	20	3'-0" x 7'-2"	WOOD	PRESSED METAL	V	H-4	J-10	S-3	LH	24A				
		ELECTRICAL ROOM	21	3'-0" x 7'-2"	WOOD	PRESSED METAL	F	H-4	J-10	S-3	RH	23				
		GENERAL OFFICE	22	3'-0" x 7'-2"	WOOD	PRESSED METAL	F	H-5	J-11	S-4	LH	21A				
		CONFERENCE & TRAINING ROOM	23	PR. 2'-6" x 7'-2"	WOOD	PRESSED METAL	F	H-6	J-12	S-4	LHR ACTIVE	28A				
		SECRETARY'S OFFICE	24	2'-8" x 7'-2"	WOOD	PRESSED METAL	F	H-7	J-13	-	LH	25A				
		SECRETARY'S OFFICE	25	3'-0" x 7'-2"	WOOD	PRESSED METAL	F	H-5	J-11	S-4	LH	21				
		LUNCH ROOM	26	3'-0" x 7'-2"	HOLLOW METAL	PRESSED METAL	VL	H-4	J-10	-	LH	27				WITH 24"x12" BOTTOM LOUVER
		BOILER ROOM	27	3'-0" x 7'-2"	HOLLOW METAL	PRESSED METAL	F	H-4	J-10	S-3	LH	22	●	●		
		JANITOR'S ROOM NO. 1	28	2'-8" x 7'-2"	HOLLOW METAL	PRESSED METAL	L	H-5	J-11	S-3	LH	23	●	●		WITH 20"x12" BOTTOM LOUVER
		WOMEN'S TOILET ROOM	29	2'-8" x 7'-2"	HOLLOW METAL	PRESSED METAL	L	H-5	J-11	S-3	LH	26	●	●		WITH 20"x12" BOTTOM LOUVER
		MEN'S TOILET ROOM	30	2'-8" x 7'-2"	HOLLOW METAL	PRESSED METAL	L	H-5	J-11	S-3	LH	27A	●	●		WITH 20"x12" BOTTOM LOUVER
		GARAGE AND MAINTENANCE	31	3'-0" x 7'-2"	HOLLOW METAL	PRESSED METAL	V	H-4	J-10	S-3	RH	24	●	●		
		TRUCKWAY	32	3'-0" x 7'-2"	HOLLOW METAL	PRESSED METAL	V	H-4	J-10	S-3	RH	24A	●	●		
		STAIR NO. 1	33	3'-0" x 7'-2"	HOLLOW METAL	PRESSED METAL	V	H-4	J-10	S-3	LH	24A	●	●		
C	SECOND FLOOR	LOW ROOF	41	3'-0" x 7'-2"	ALUMINUM	ALUMINUM TUBE	F	H-1	J-6	S-1	LH	16	●	●		WITH GLAZED TRANSOM
		FILTER AREA	42	3'-0" x 7'-2"	HOLLOW METAL	PRESSED METAL	V	H-4	J-10	S-3	LHR	24A	●	●		
		MECHANICAL ROOM NO. 1	43	3'-0" x 7'-2"	HOLLOW METAL	PRESSED METAL	F	H-4	J-10	-	RH	25				
		MECHANICAL ROOM NO. 2	44	3'-0" x 7'-2"	HOLLOW METAL	PRESSED METAL	F	H-4	J-10	-	RH ACTIVE	31				
		JANITOR'S ROOM NO. 2	45	3'-0" x 7'-2"	HOLLOW METAL	PRESSED METAL	L	H-4	J-10	-	RH	23				WITH 24"x12" BOTTOM LOUVER
		STORAGE ROOM NO. 2	46	3'-0" x 7'-2"	HOLLOW METAL	PRESSED METAL	L	H-4	J-10	-	LH	23A				WITH 24"x12" BOTTOM LOUVER
		VACUUM ROOM	47	PR. 3'-0" x 7'-2"	HOLLOW METAL	PRESSED METAL	L	H-4	J-10	-	LHR ACTIVE	31				WITH 24"x12" BOTTOM LOUVER EACH DOOR
		STAIR NO. 1	48	3'-0" x 7'-2"	HOLLOW METAL	PRESSED METAL	V	H-4	J-10	S-3	RH	24A				
B	BASEMENT AND SUBBASEMENT	STAIR NO. 2	51	3'-0" x 7'-2"	HOLLOW METAL	PRESSED METAL	V	H-8	J-14	-	RH	24A				
		STAIR NO. 3	52	3'-0" x 7'-2"	HOLLOW METAL	PRESSED METAL	V	H-8	J-14	-	RH	24A				
		STAIR NO. 3	53	3'-0" x 7'-2"	HOLLOW METAL	PRESSED METAL	V	H-8	J-14	-	RH	24A				



## DOOR SCHEDULE (CONT.)

BUILDING	FLOOR	LOCATION	DOOR NUMBER	DOOR OPENING	MATERIAL		DOOR TYPE	DETAILS			DOOR SWING	HARDWARE SET NUMBER	THRESHOLD	WEATHER STRIPPING	FIRE LABEL	REMARKS
					DOOR	FRAME		HEAD	JAMB	SILL						
D	FIRST FLOOR	STAIR NO. 5	61	3'-0" x 7'-2"	ALUMINUM	ALUMINUM TUBE	V	H-1	J-7&9	S-1	LHR	11B	●	●		WITH GLAZED TRANSOM
		GENERATOR ROOM	62	PR. 2'-6" x 9'-2"	ALUMINUM	ALUMINUM TUBE	F	H-1	J-7	S-1	RHR ACTIVE	12	●	●		
		STAIR NO. 6	63	3'-0" x 7'-2"	ALUMINUM	ALUMINUM TUBE	V	H-1	J-7	S-1	RHR	11B	●	●		WITH GLAZED TRANSOM
		MCC ROOM	64	PR. 2'-6" x 9'-2"	ALUMINUM	ALUMINUM TUBE	F	H-1	J-7&9	S-1	LHR ACTIVE	12	●	●		
	BASEMENT	BLOWER ROOM	71	PR. 3'-0" x 7'-2"	HOLLOW METAL	PRESSED METAL	VL	H-8	J-14	-	RHR ACTIVE	31				W/24"x12" BOTTOM LOUVERS EA. DOOR

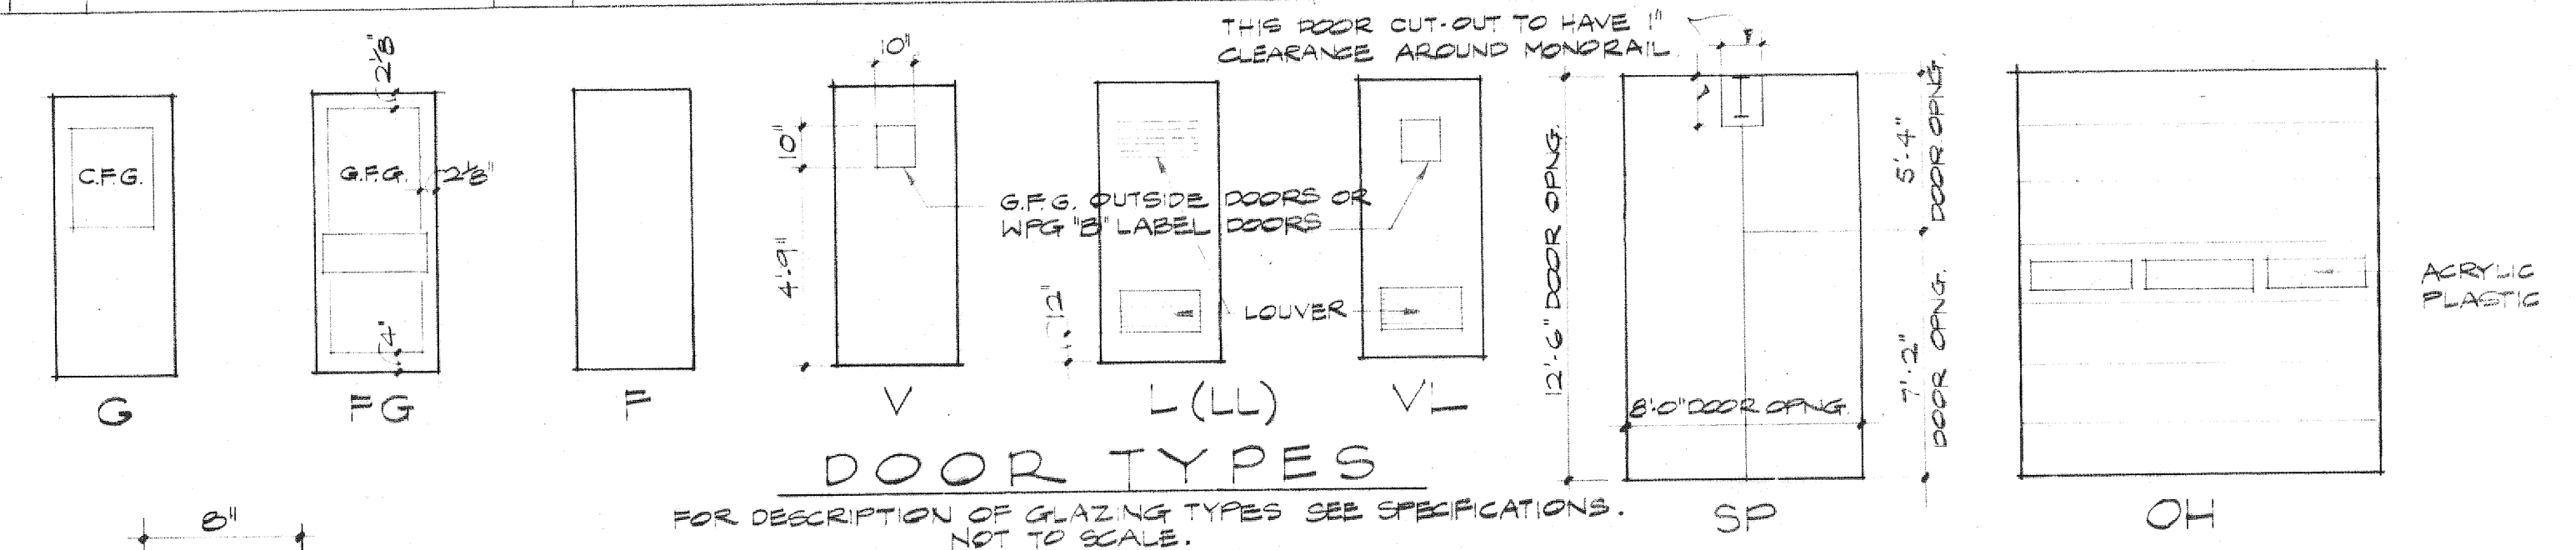

## DOOR DETAILS SCALE 1/2"=1'-0" RECORD DRAWING

DRAWN BY M. Schumann			
DEPT. CHECK M. Wilson			
PROJ. CHECK R. J. Marshall			
NUMBER	DATE	MADE BY	CHECKED BY
REVISIONS			
DESCRIPTION			

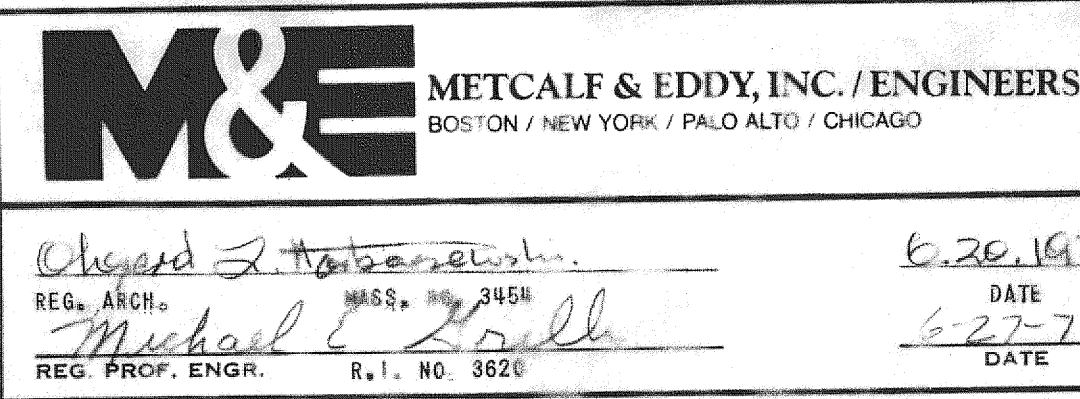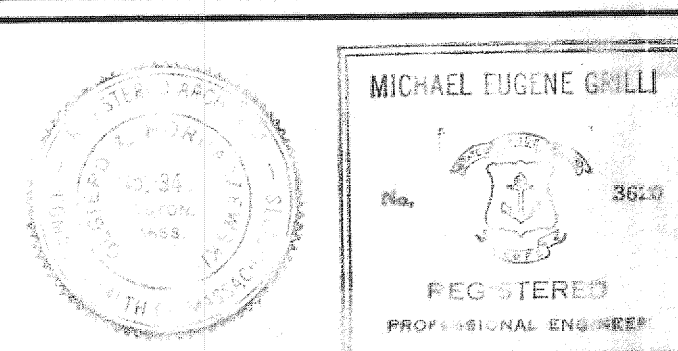

SCALE:  
AS SHOWN

TOWN OF BURRILLVILLE, RHODE ISLAND  
BOARD OF SEWER COMMISSIONERS  
WASTEWATER TREATMENT FACILITIES

DOOR SCHEDULE AND DETAILS

ARCHITECTURAL

JOB: 4868

FILE NO.: H-68983-1

SHEET: A-15