


# RECORD DRAWING

NUMBER	DATE	MADE BY	CHECKED BY	REVISIONS	DESCRIPTION

DRAWN BY  
DEPT. CHECK  
PROJ. CHECK

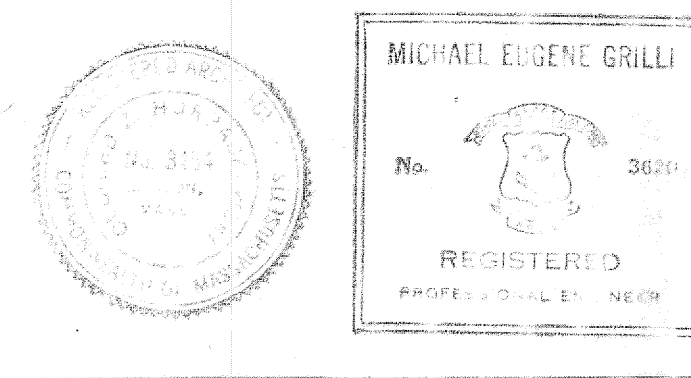

**M&E** METCALF & EDDY, INC. / ENGINEERS  
BOSTON / NEW YORK / PALO ALTO / CHICAGO

6-20-1977  
6-27-77

SCALE:  
1/8" = 1'-0"

TOWN OF BURRILLVILLE, RHODE ISLAND  
BOARD OF SEWER COMMISSIONERS  
WASTEWATER TREATMENT FACILITIES  
OPERATIONS BUILDING  
ELEVATIONS  
ARCHITECTURAL

JOB 4368  
FILE NO. H-68972-1  
SHEET A-4