





LABORATORY FURNITURE SCHEDULE					
ITEM	DESCRIPTION	CATALOG	NUMBER	QUANTITY	REMARKS
1	BOOKCASE	FISHER	91-880	2	W/91-893 DUST CAPS
2	WALL CASE	FISHER	91-481	2	W/91-882 DOORS AND 91-894 DUST CAPS
3	DRAWER UNIT	FISHER	90-150	1	
4	TABLE UNIT	FISHER	97-630	2	WITH BRACKETS
5	DRAWER/FILE UNIT	FISHER	90-180	2	
6	DRAWER/CUPBOARD UNIT	FISHER	90-370	2	
7	CUPBOARD UNIT	FISHER	90-320	1	
8	BALANCE TABLE	FISHER	97-640	1	WITH SET OF 90-605 LEGS
9	FUME HOOD	FISHER	93-660	1	COMPLETE SET
10	CUPBOARD UNIT	FISHER	97-230	1	
11	CUPBOARD UNIT	FISHER	97-220	1	
12	REFRIGERATOR	FISHER	XR-1704	1	
13	CORNER CUPBOARD/SINK UNIT	FISHER	97-790	2	W/91-507D BASIN
14	DRAWER UNIT	FISHER	97-260	2	
15	DRAWER/CUPBOARD UNIT	FISHER	97-425	1	
16	CUPBOARD UNIT	FISHER	97-430	1	
17	CORNER CUPBOARD UNIT	FISHER	97-790	2	
18	CUPBOARD/SINK UNIT	FISHER	97-490	1	W/91-500D BASIN
19	GLASS WASHER	FISHER	97-0800	1	
20	CUPBOARD UNIT	FISHER	97-220	1	
21	DRAWER UNIT	FISHER	97-485	1	
22	CUPBOARD UNIT	FISHER	97-420	1	
23	INCUBATOR	FISHER	97-990	1	
24	PEGBOARD	FISHER	91-160	2	
25	DESK CHAIR	FISHER	91-225	1	SWIVEL
26	LAB STOOL	FISHER	91-272	1	LOW, ADJUSTABLE
27	LAB STOOL	FISHER	91-273	1	HIGH, ADJUSTABLE
28	END CLOSERS	FISHER			AS REQUIRED

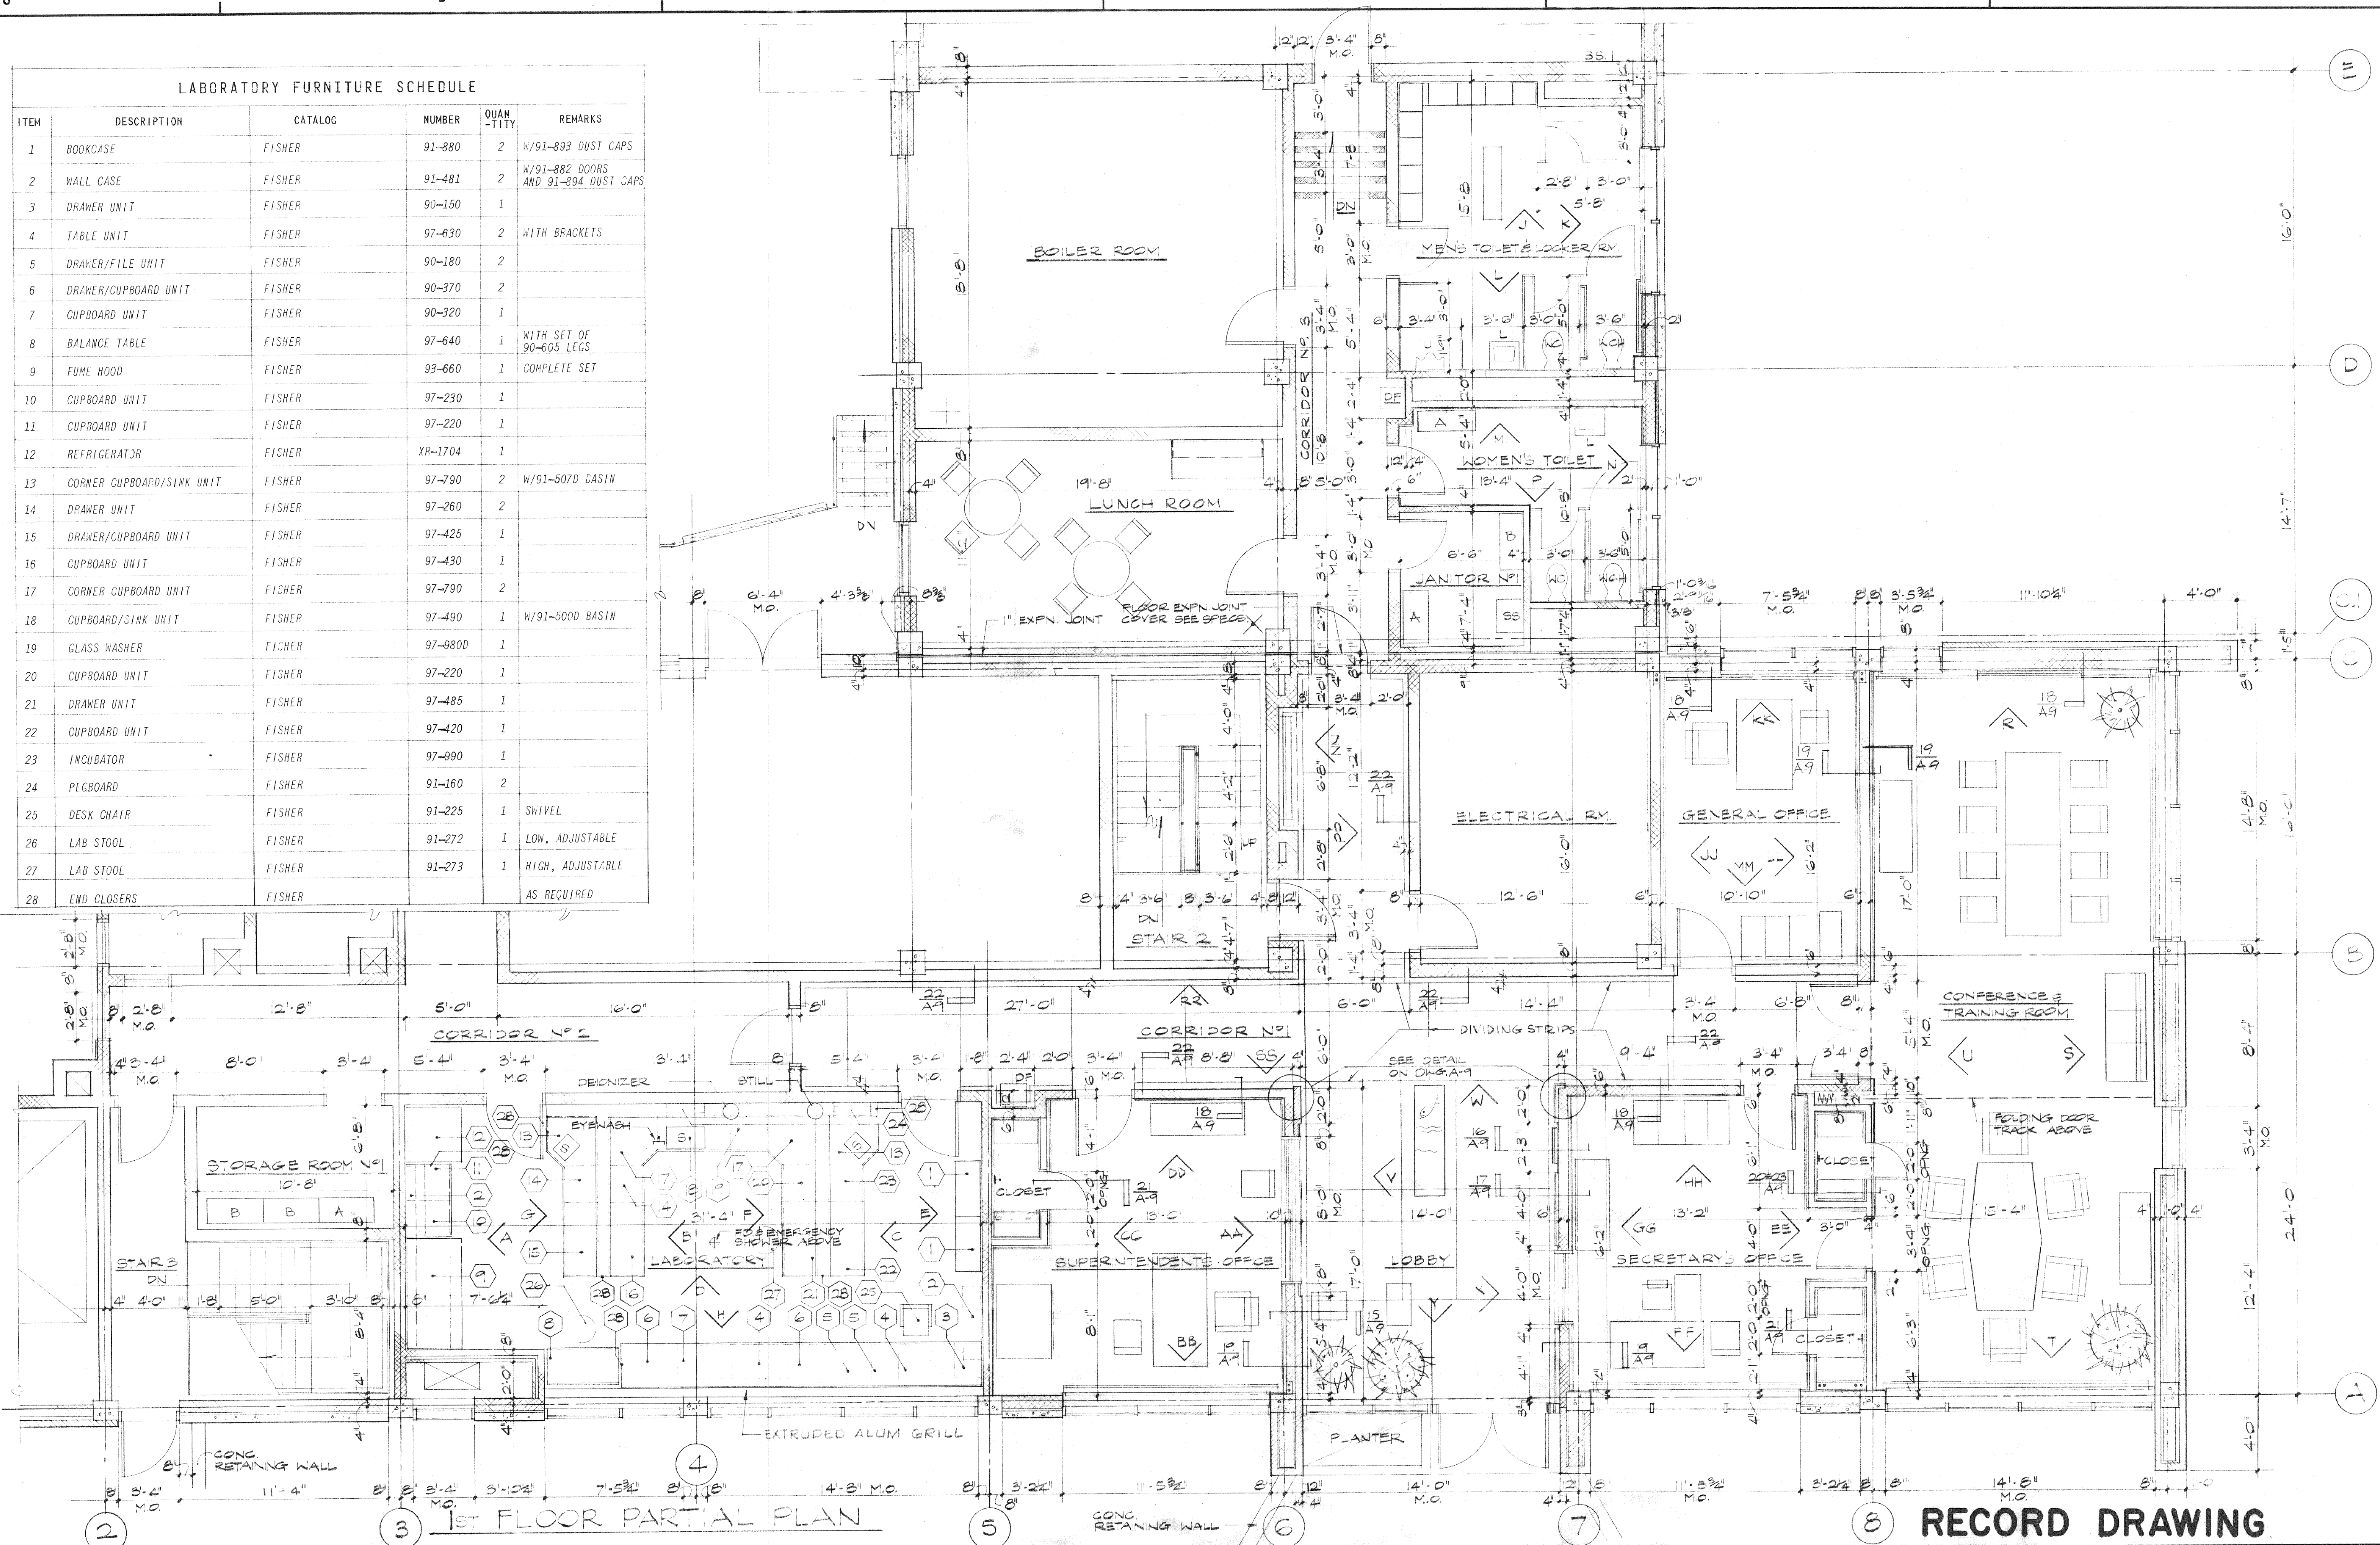

RECORD DRAWING

				DRAWN BY <i>M. J. ...</i>		 	 METCALF & EDDY, INC. / ENGINEERS BOSTON / NEW YORK / PALO ALTO / CHICAGO	SCALE: $1/4" = 1'-0"$	TOWN OF BURRILLVILLE, RHODE ISLAND BOARD OF SEWER COMMISSIONERS WASTEWATER TREATMENT FACILITIES	JOB 4868 FILE NO. H-69974-1				
				DEPT. CHECK <i>W. ...</i>							REG. ARCH. MASS. NO. 3456 <i>Michael E. Hord</i> REG. PROF. ENGR. R.I. NO. 3620	E 26-1977 DATE 6-27-77 DATE	OPERATIONS BUILDING PARTIAL PLAN ARCHITECTURAL	SHEET A-6
				PROJ. CHECK <i>A. J. ...</i>										
NUMBER	DATE	MADE BY	CHECKED BY	DESCRIPTION										