




ROOF PLAN

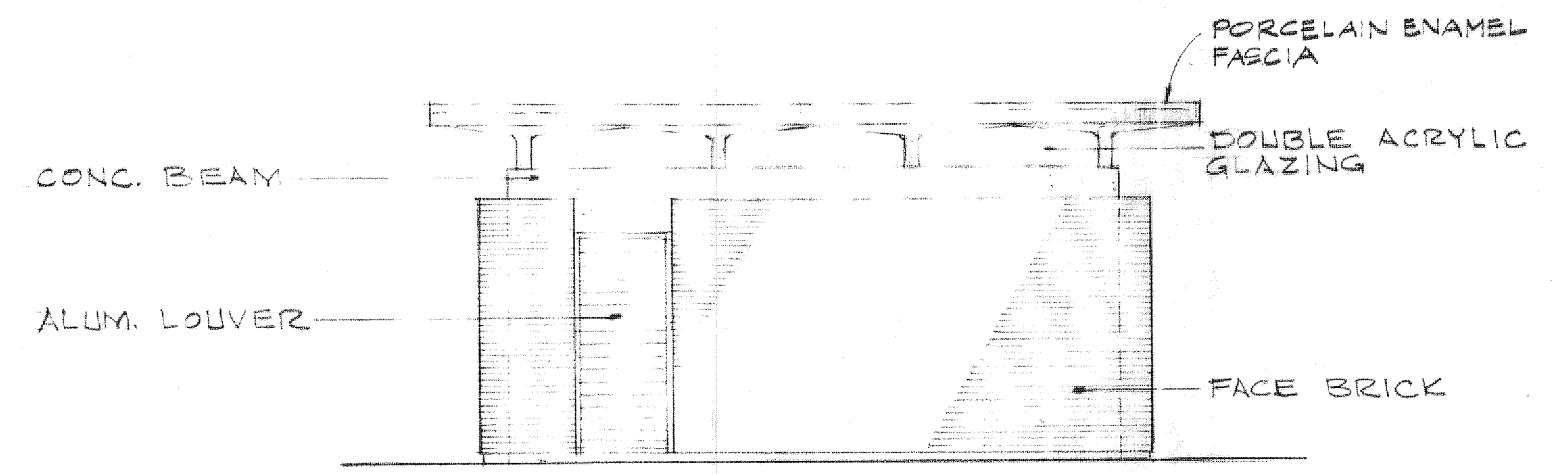


SOUTH ELEVATION
(NORTH ELEV. SIMILAR EXCEPT NO LOUVER)

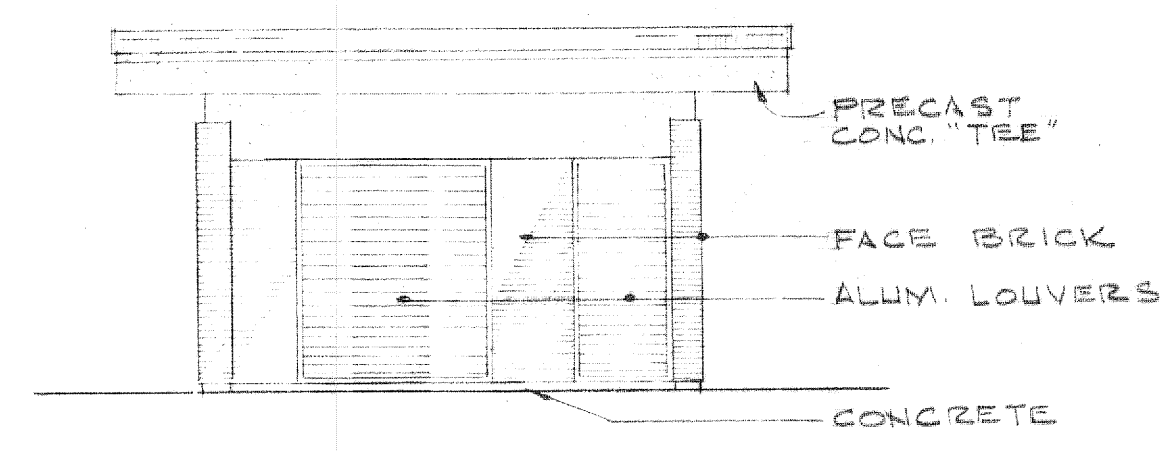


EAST ELEVATION

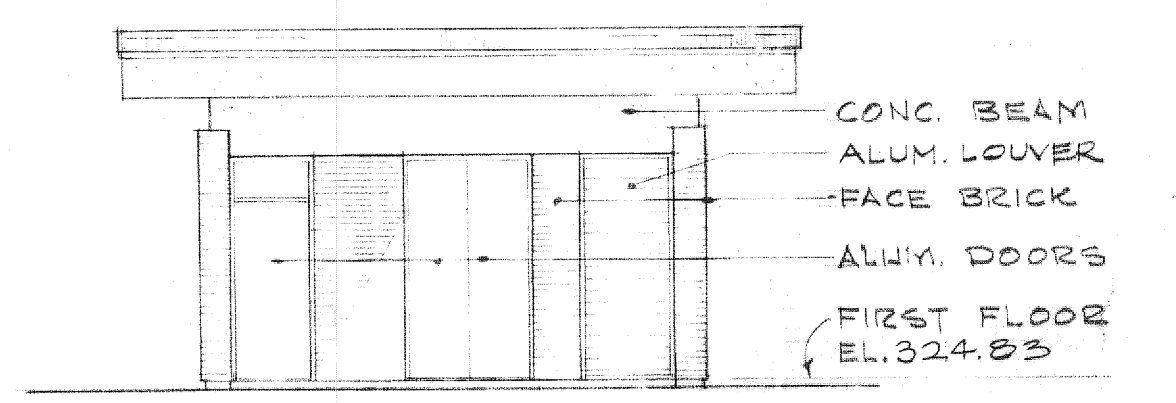


WEST ELEVATION

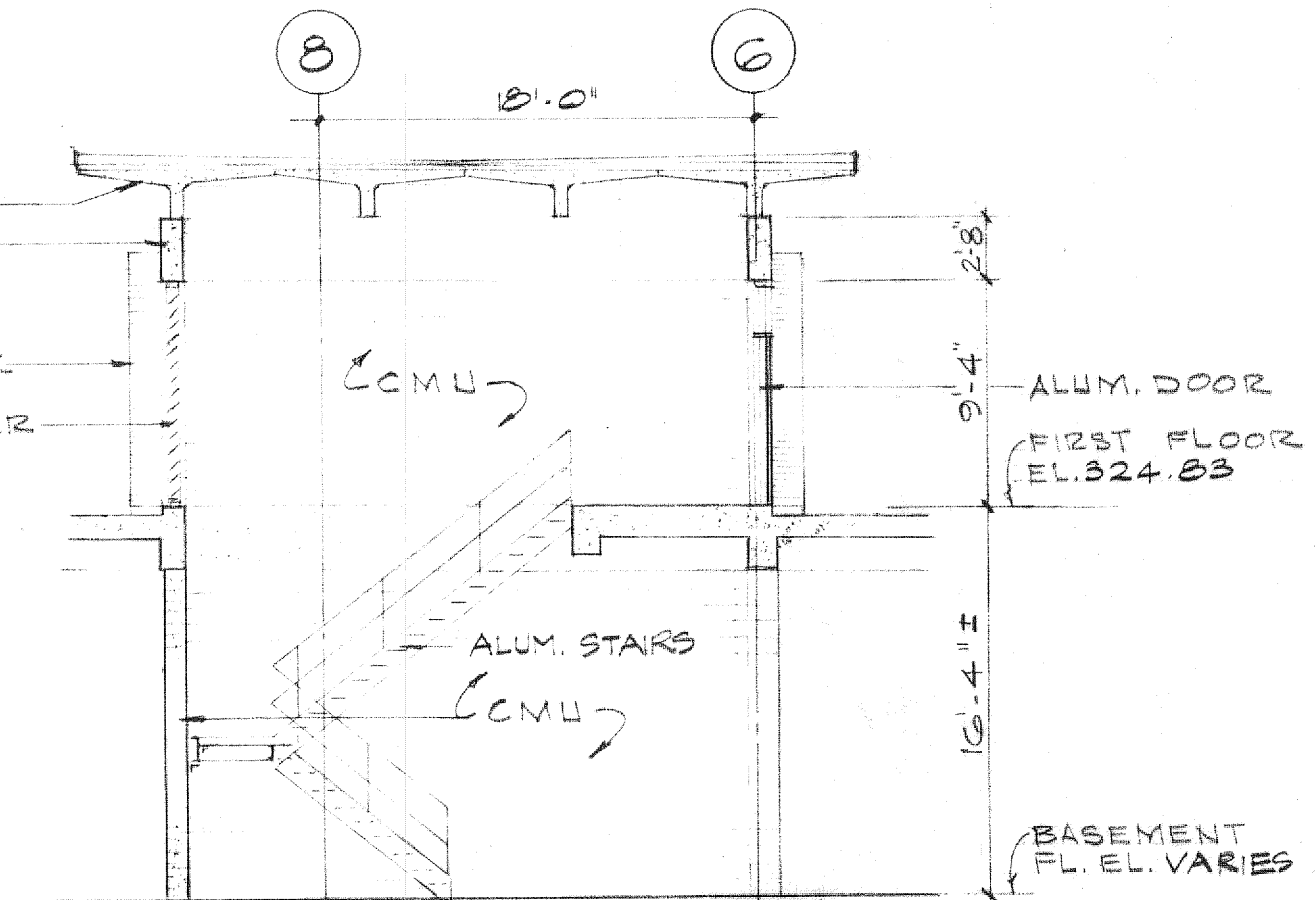


SECTION A-A

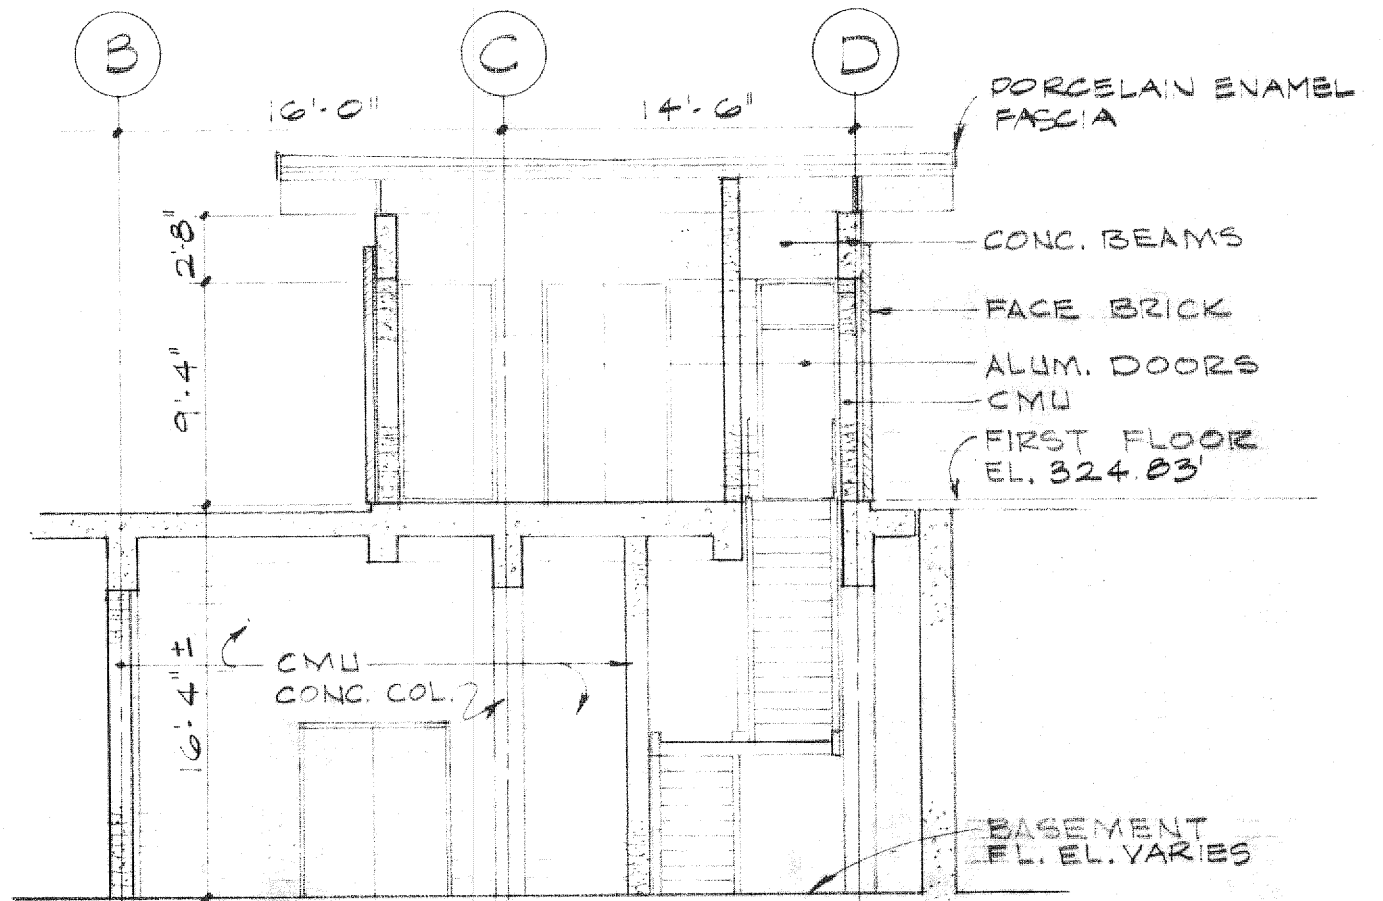

SECTION B-B

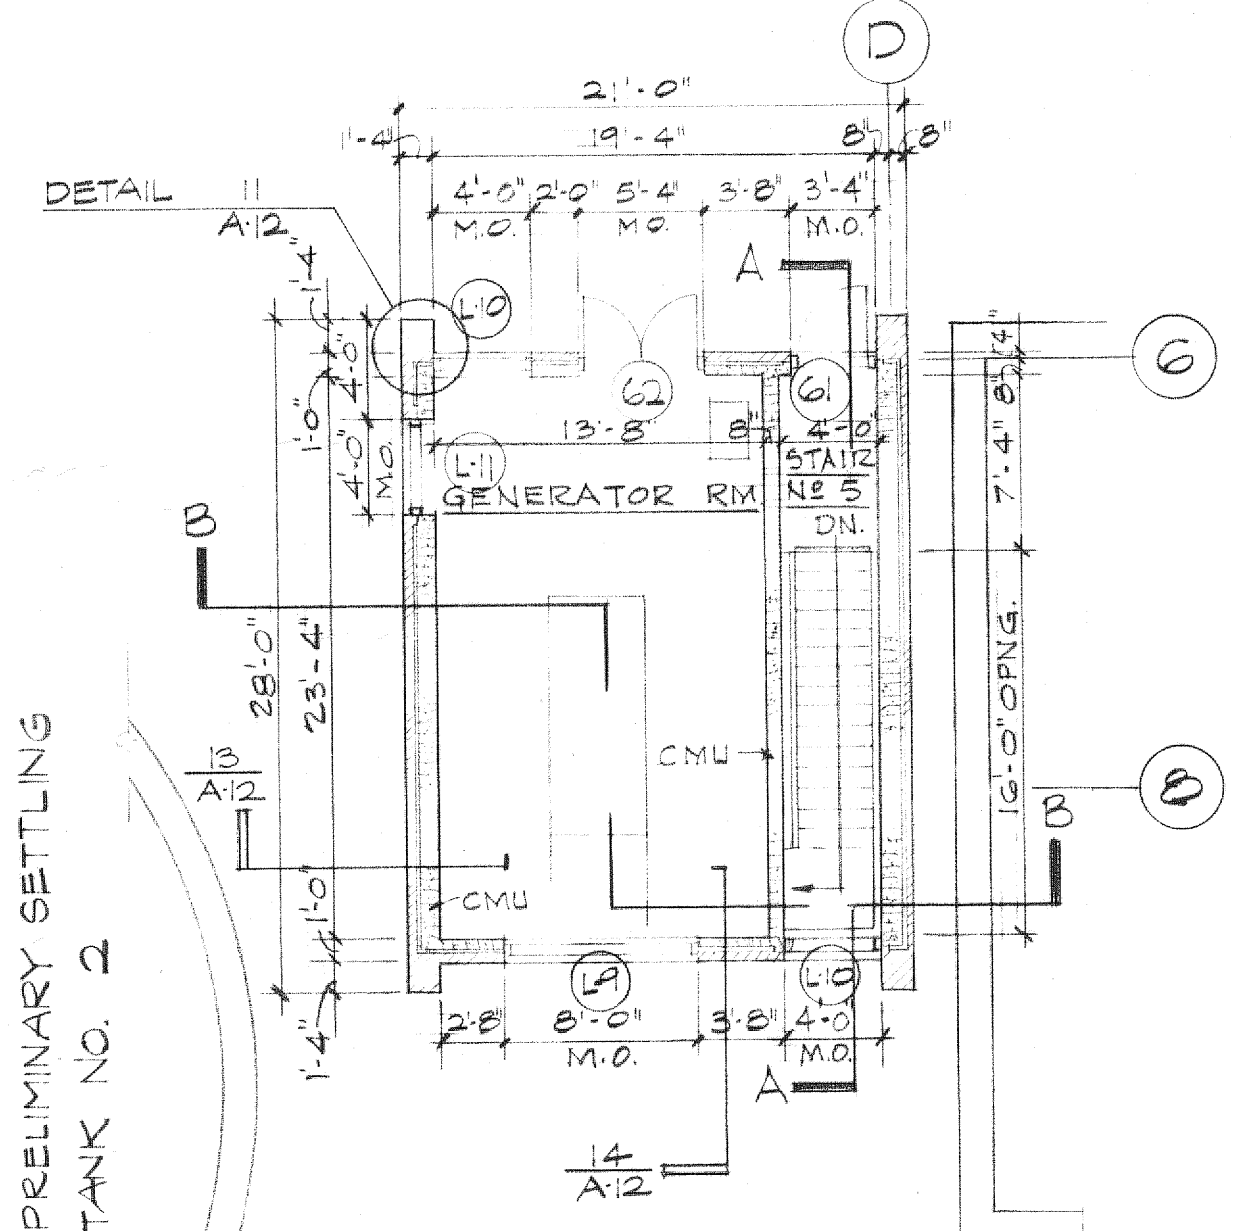


FIRST FLOOR PLAN

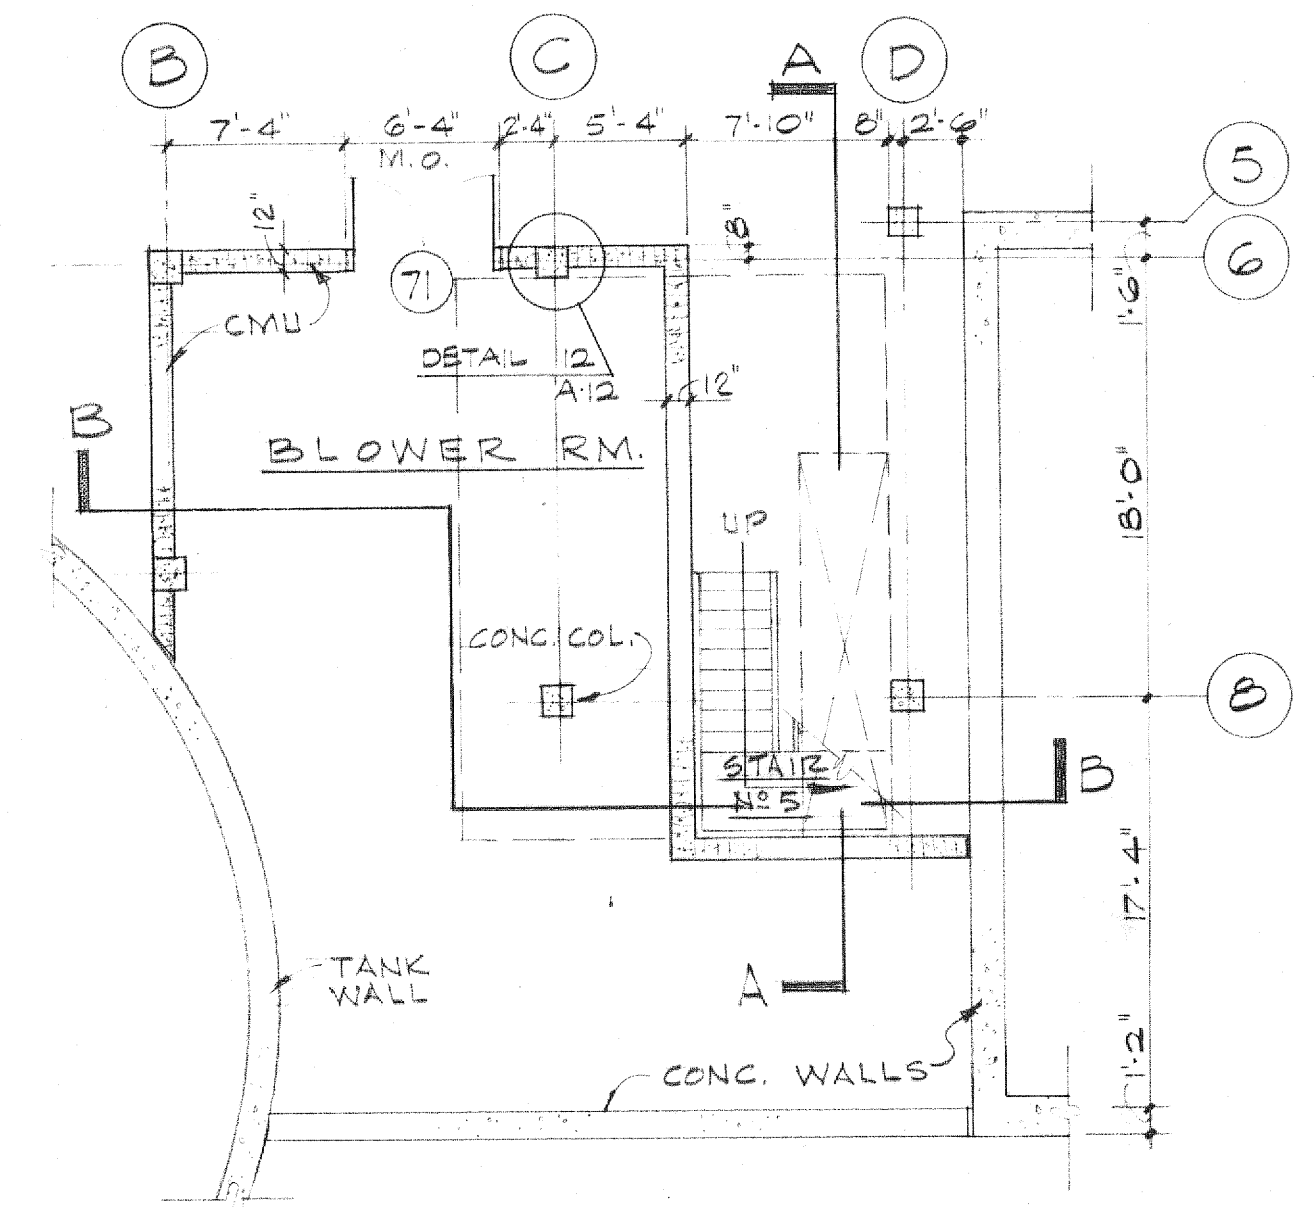


BASEMENT PLAN


STAIR BUILDING No. 1
SCALE: 1/8" = 1'-0"

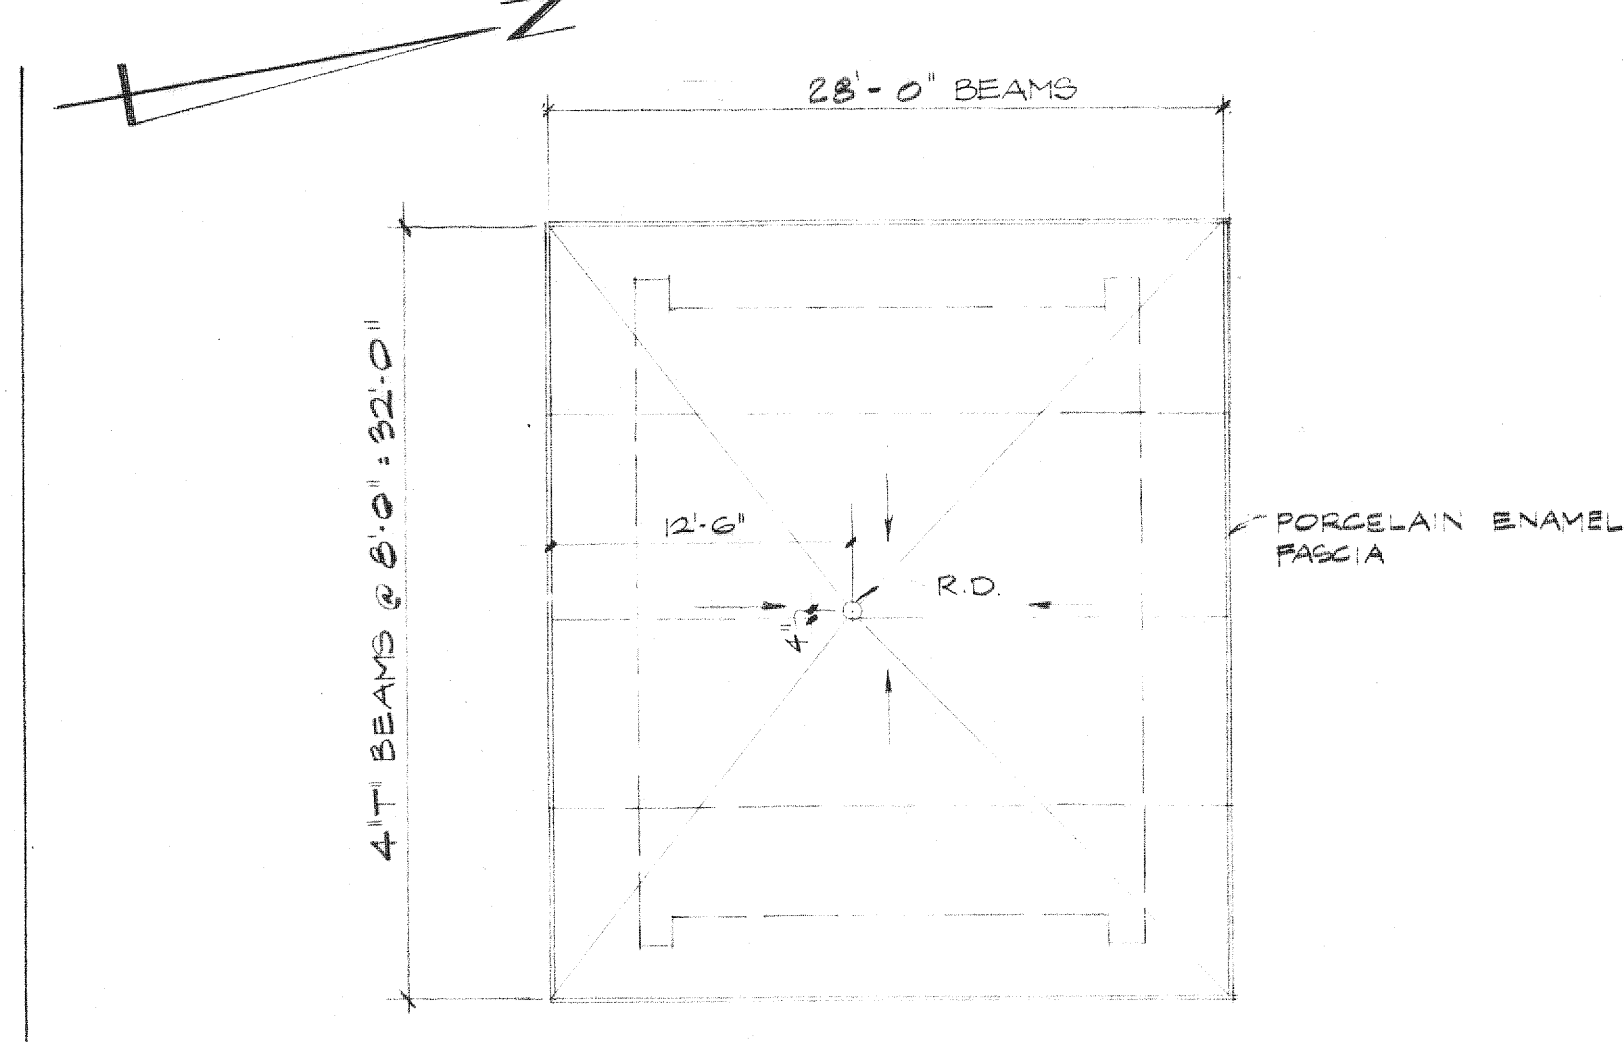

ROOF PLAN

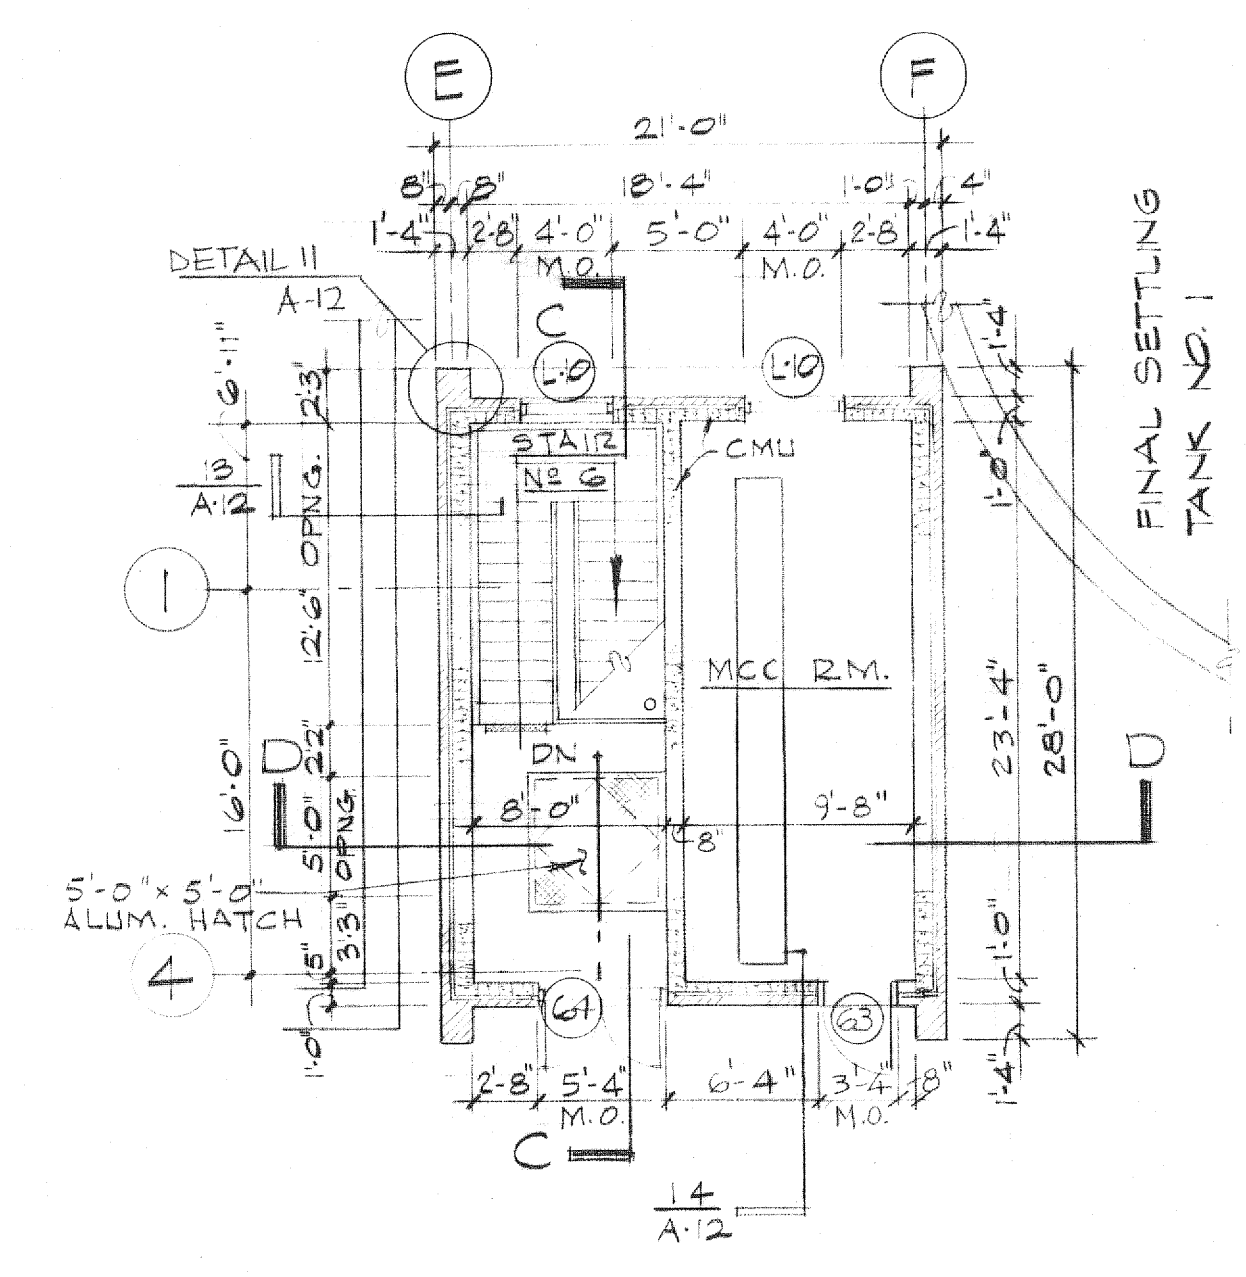


FIRST FLOOR PLAN

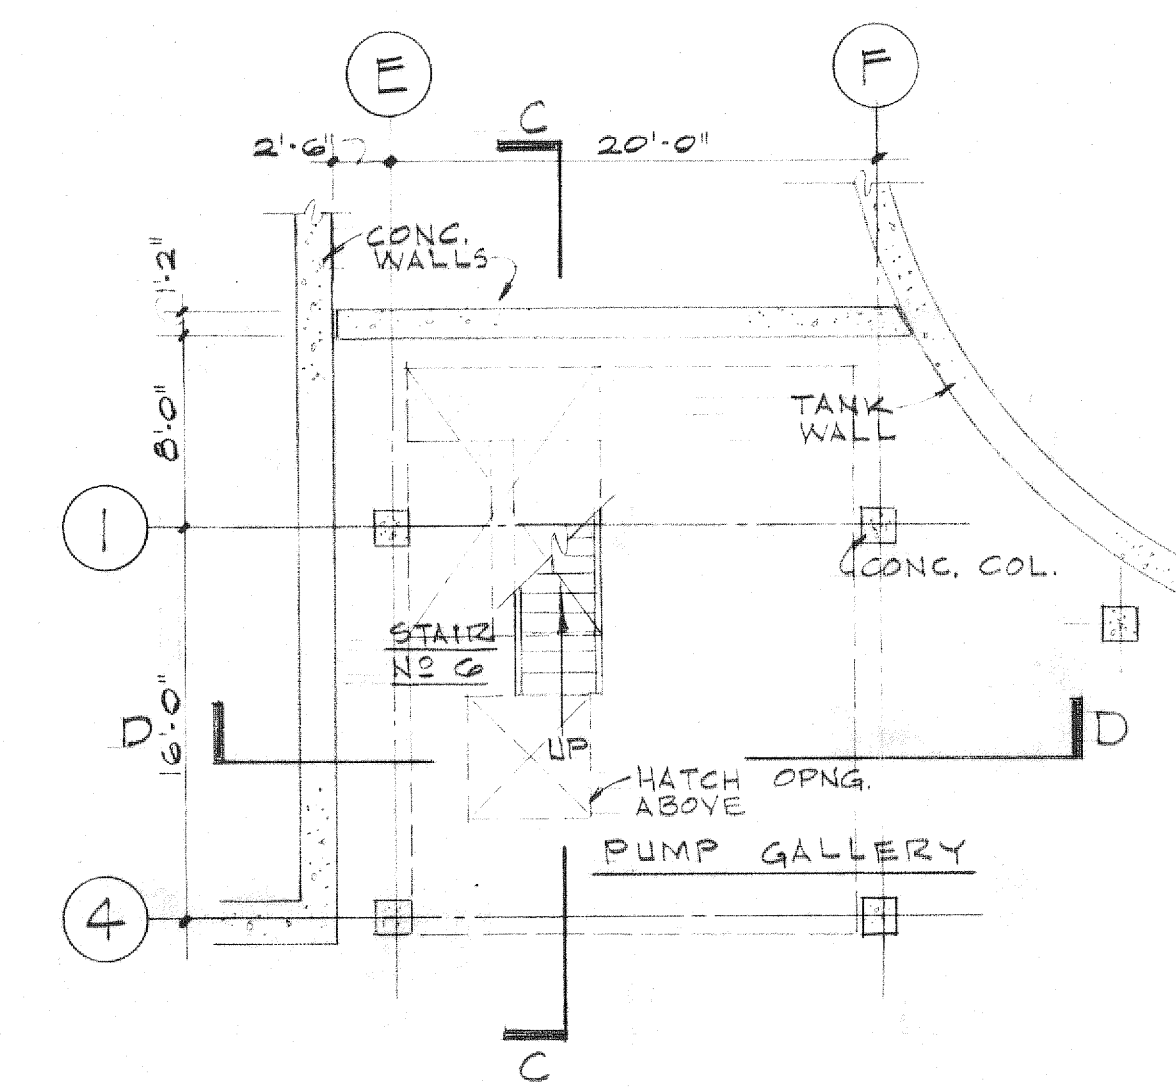


BASEMENT PLAN


STAIR BUILDING No. 2
SCALE: 1/8" = 1'-0"

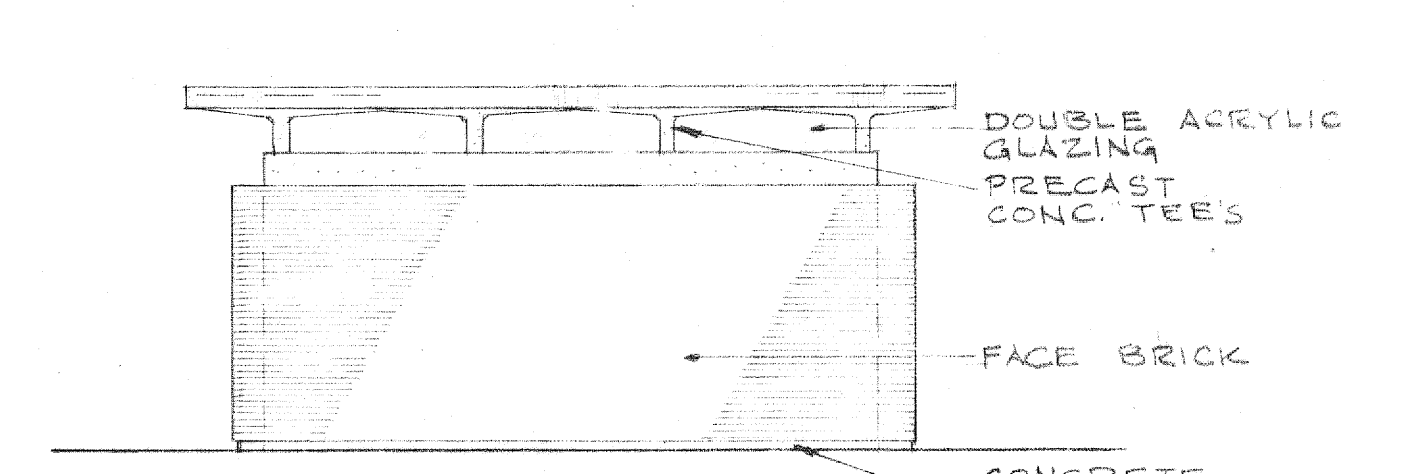


NORTH ELEVATION
(SOUTH ELEV. SIMILAR)

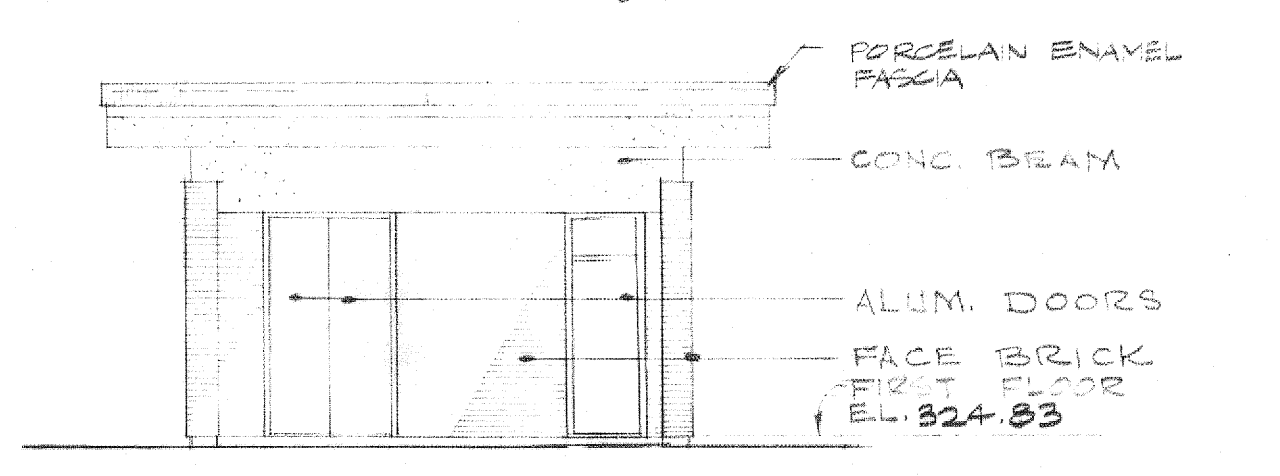


EAST ELEVATION

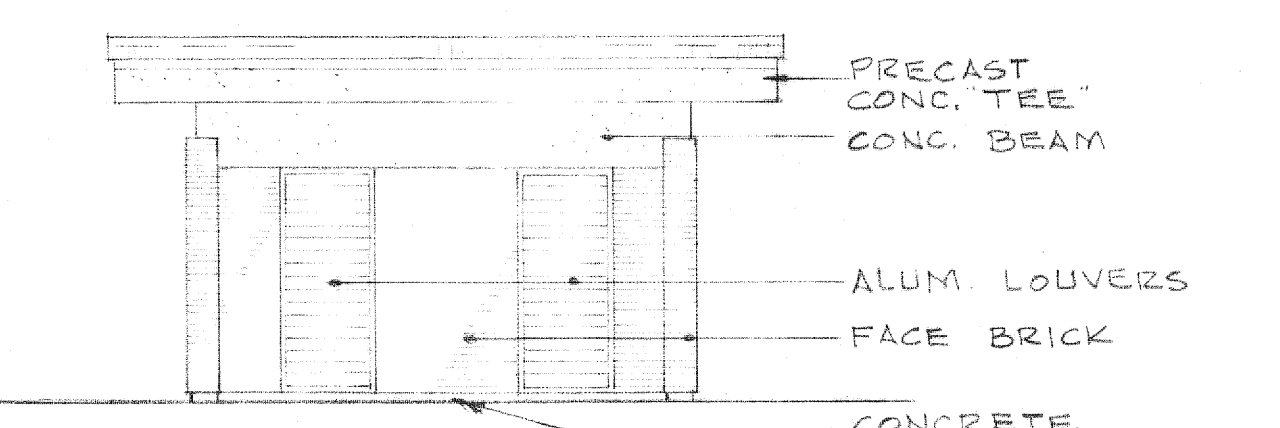

WEST ELEVATION

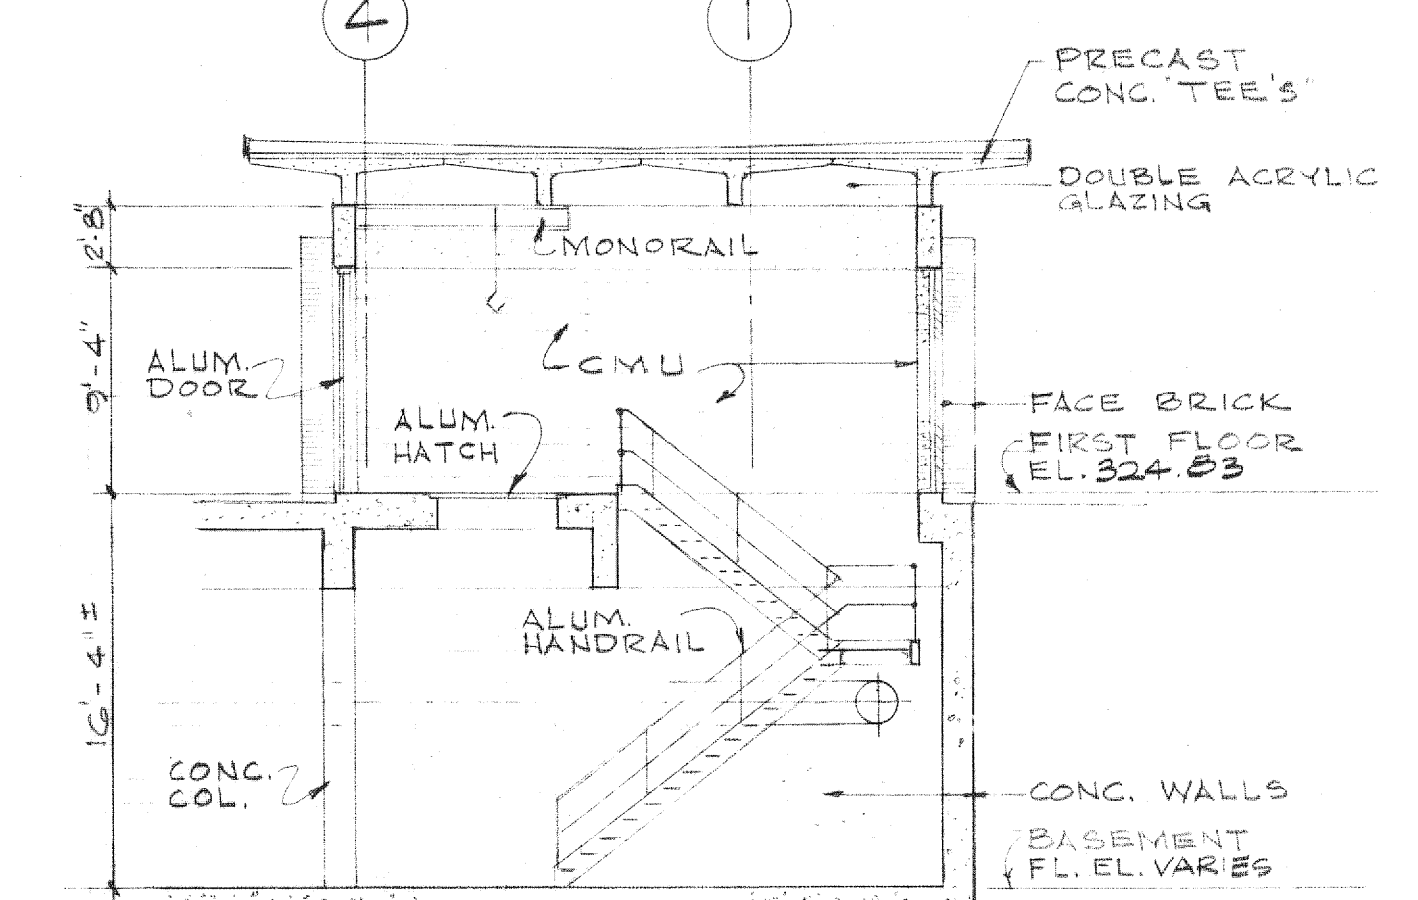

SECTION C-C

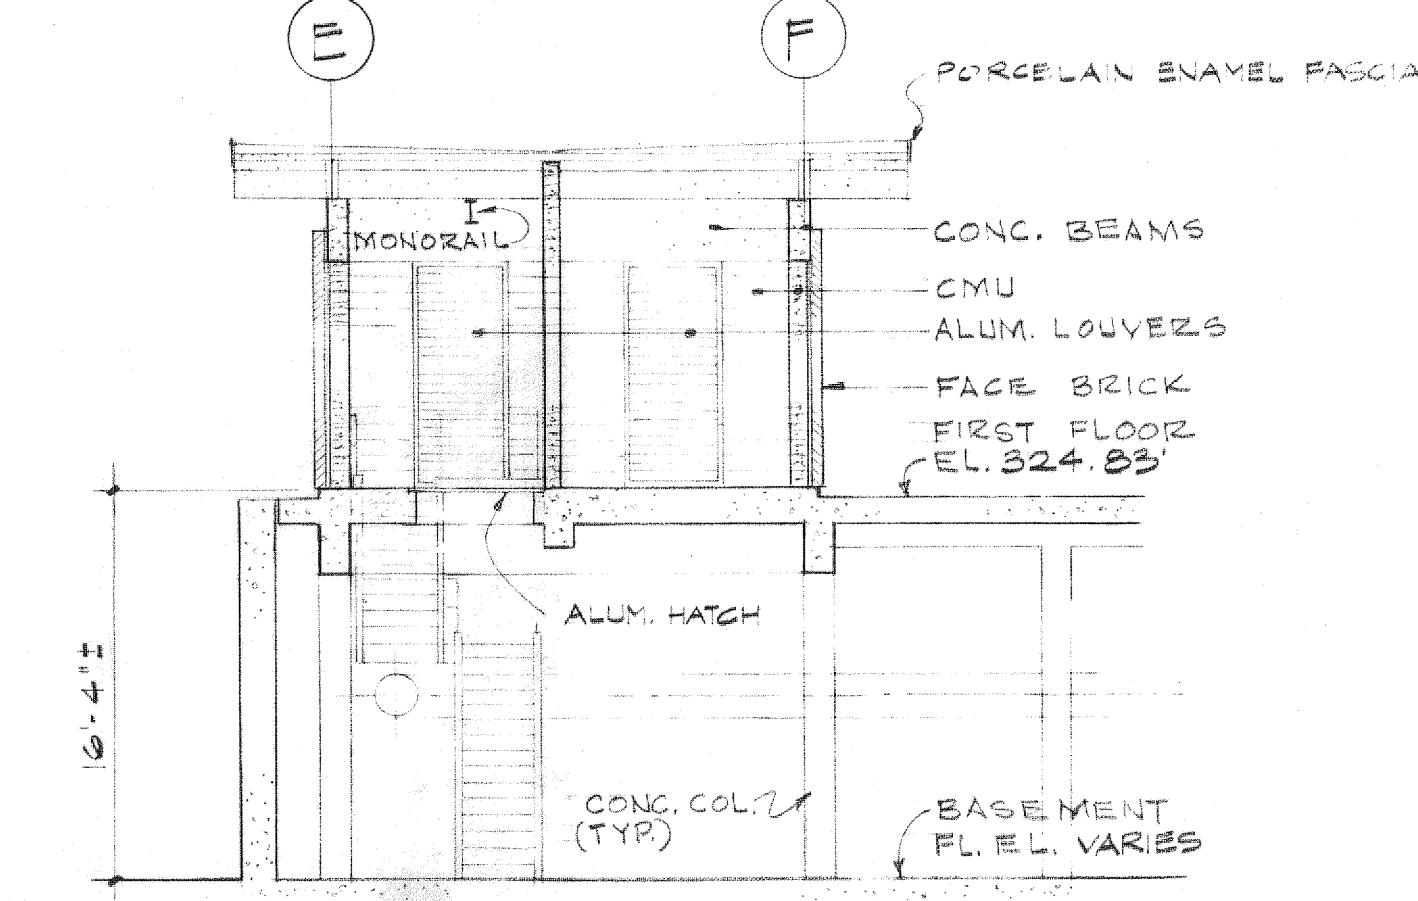


SECTION D-D

RECORD DRAWING

NUMBER	DATE	MADE BY	CHECKED BY	REVISIONS	DESCRIPTION

DRAWN BY
DEPT. CHECK
PROJ. CHECK

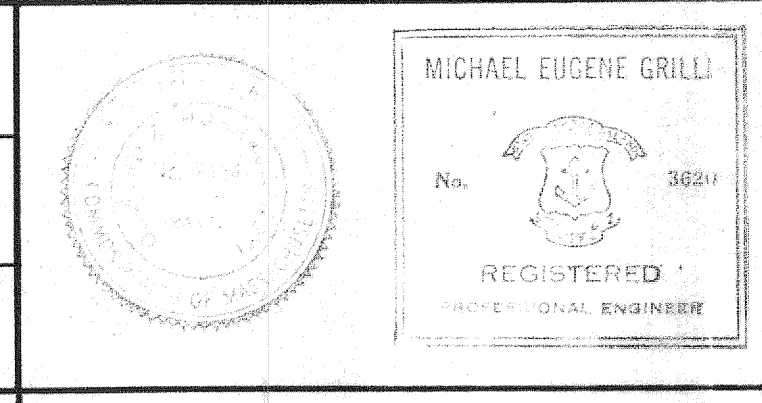

M&E METCALF & EDDY, INC. ENGINEERS
BOSTON / NEW YORK / PALO ALTO / CHICAGO
Michael E. Grillo
REG. ARCH. MASS. NO. 3454
REG. PROF. ENGR. R.I. NO. 3821

SCALE: 0 8 16 24
SCALE IN FEET
SCALE 1/8" = 1'-0"
UNLESS OTHERWISE NOTED OR CHANGED BY REPRODUCTION

TOWN OF BURRILLVILLE, RHODE ISLAND
BOARD OF SEWER COMMISSIONERS
WASTEWATER TREATMENT FACILITIES
STAIR BUILDINGS
PLANS, BUILDING SECTIONS AND ELEVATIONS
ARCHITECTURAL

JOB: 4868
FILE NO.: H-68973-1
SHEET: A-5