




DETAIL B
A-11

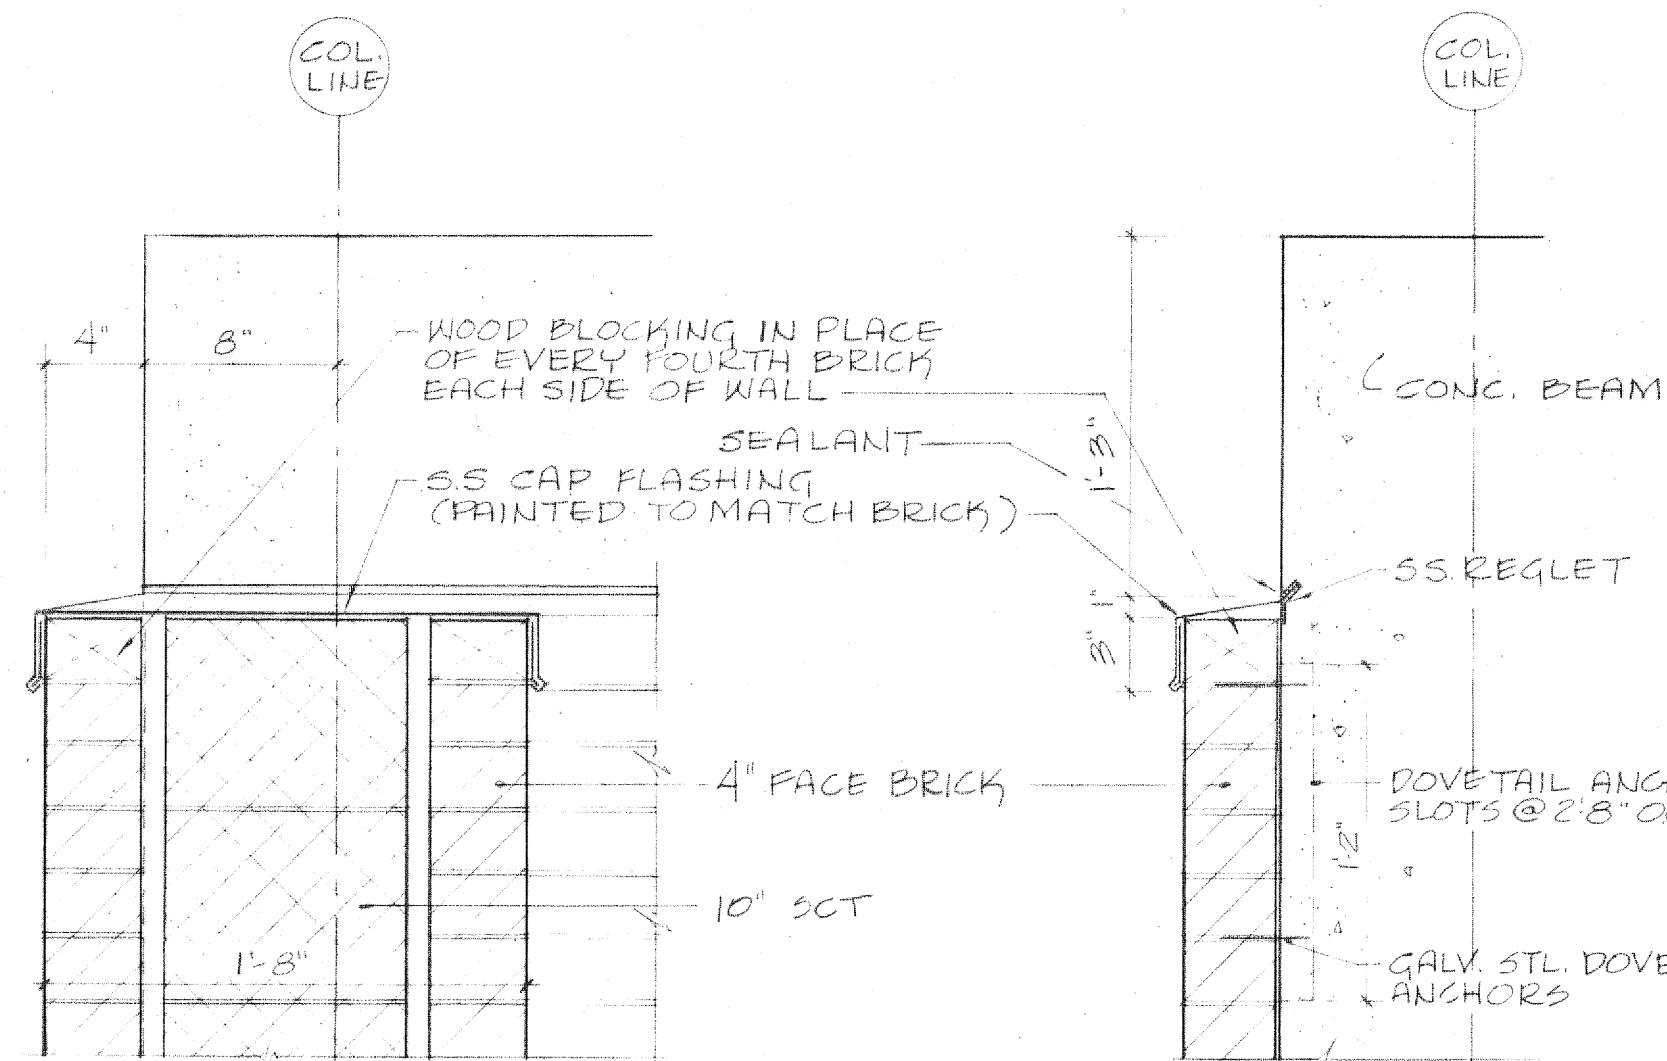

DETAIL D
A-10 & 12

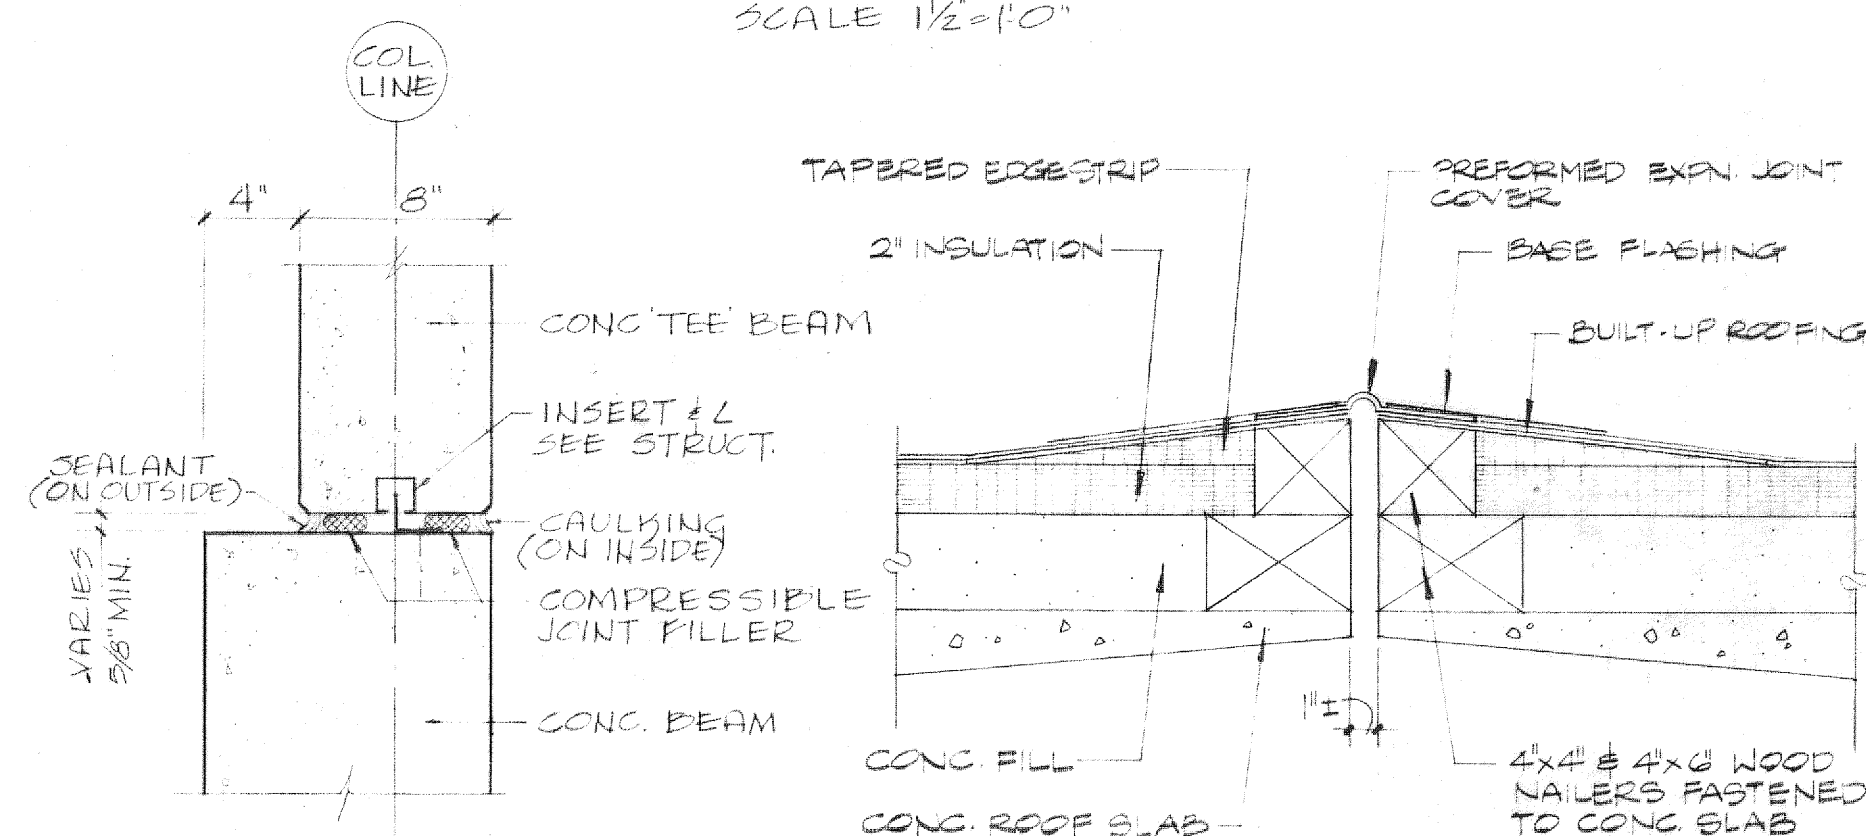



ROOF EXPANSION JOINT
SCALE 1/2" = 1'-0"

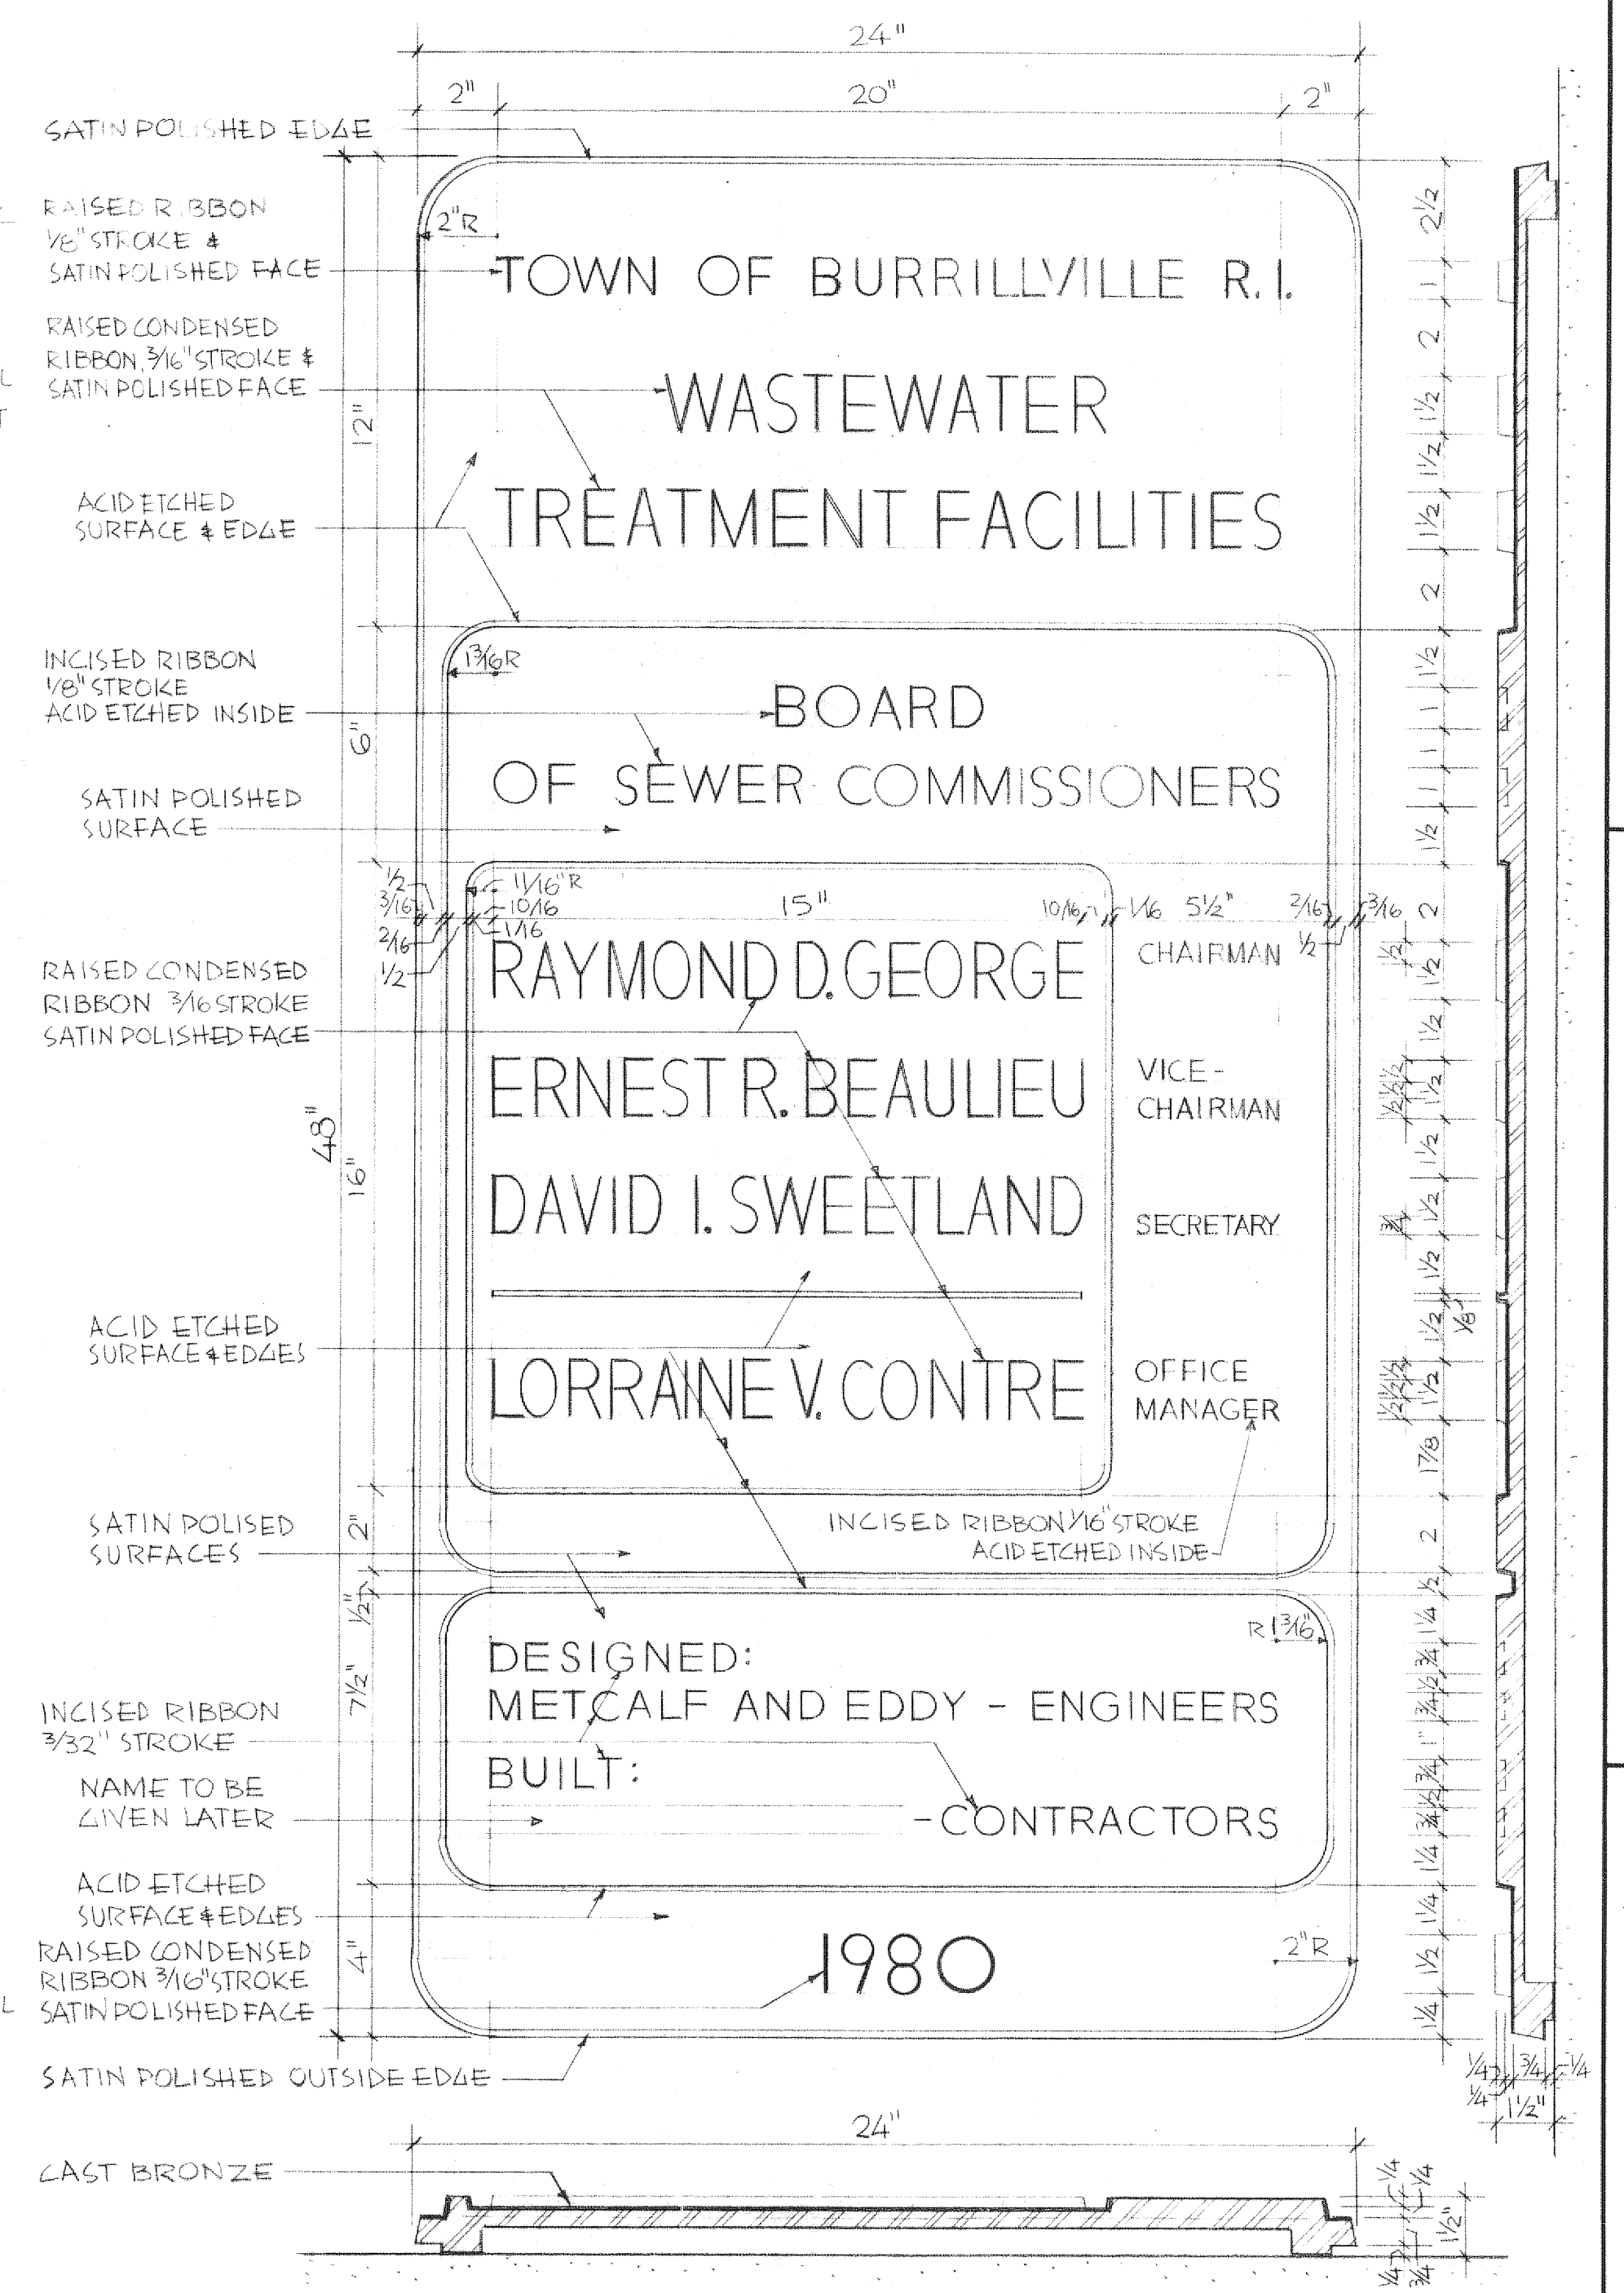

RECORD DRAWING

NUMBER	DATE	MADE BY	CHECKED BY	DESCRIPTION

DRAWN BY B. Titus
DEPT. CHECK M. Wilson
PROJ. CHECK R. J. Marshall

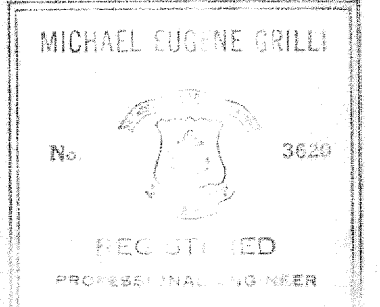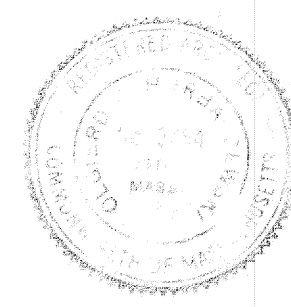

M&E METCALF & EDDY, INC. / ENGINEERS
BOSTON / NEW YORK / PALM BEACH / CHICAGO

REG. ARCH. MASS. No. 3620
REG. PROF. ENGR. R.I. No. 3620
DATE 6-27-77

SCALE:
AS SHOWN
UNLESS OTHERWISE NOTED OR CHANGED BY REPRODUCTION

TOWN OF BURRILLVILLE, RHODE ISLAND
BOARD OF SEWER COMMISSIONERS
WASTEWATER TREATMENT FACILITIES
MISCELLANEOUS DETAILS
ARCHITECTURAL

JOB 4868
FILE NO. H-68986-1
SHEET A-18