




SECTION A-A

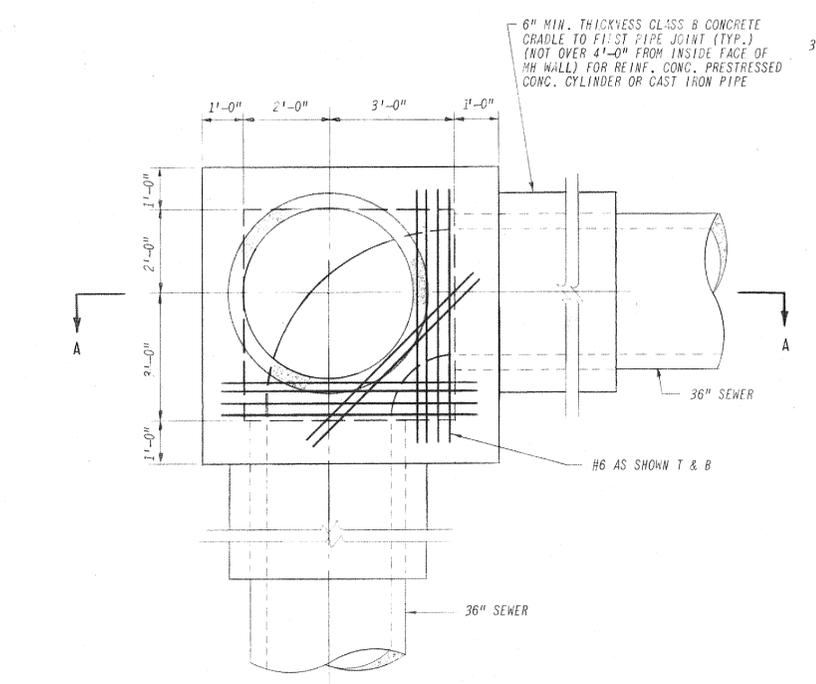


SECTIONAL PLAN
DETAIL OF MANHOLE NO. 1
NO SCALE

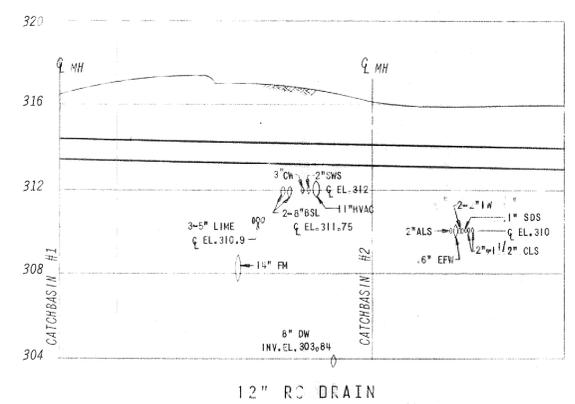


12" RC DRAIN

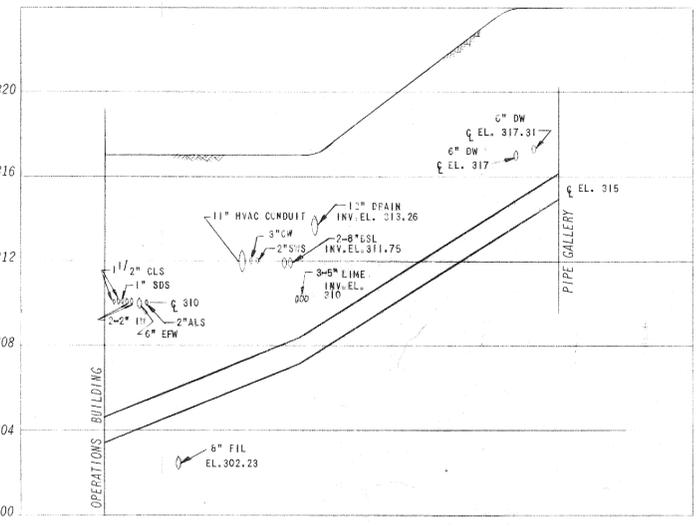

14" CI FORCE MAIN

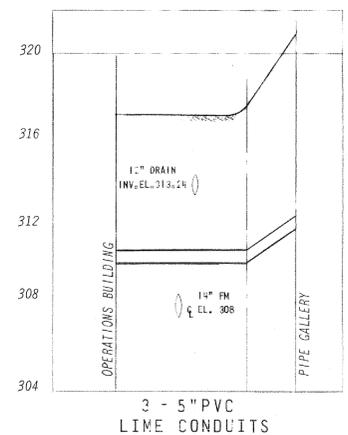

3-5" PVC LIME CONDUITS

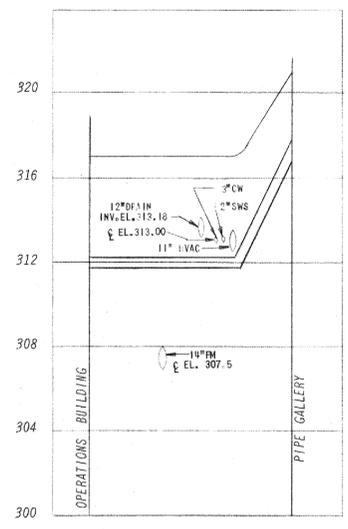


2-8" CI 30L LINES


PROFILES

SCALE: HORZ. 1" = 40'
VERT. 1" = 4'


NO LEDGE OR UNEXCAVATED MATERIAL SHALL PROJECT BEYOND THIS LINE

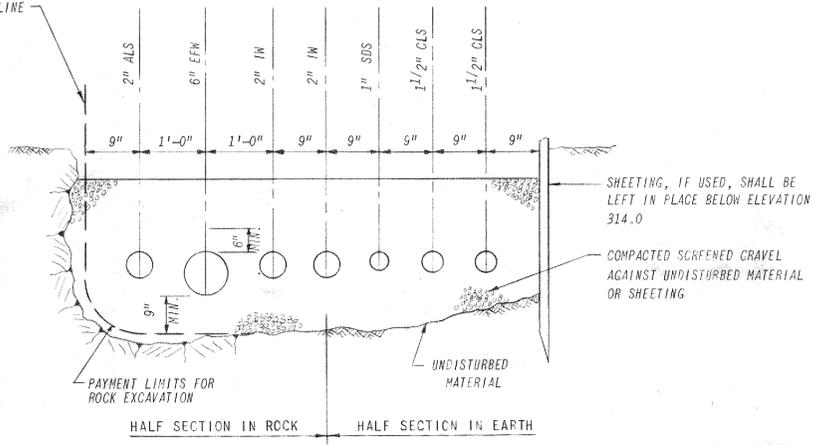

COMMON TRENCH SECTION
NO SCALE

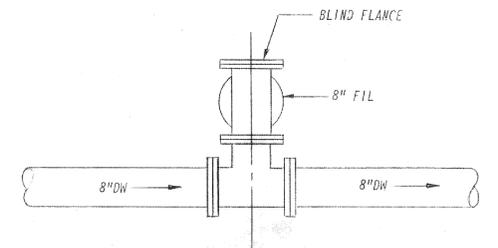

SECTION B-B

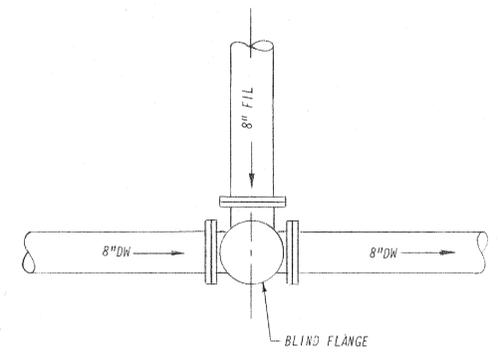

PLAN

DETAIL OF CONNECTION IN MANHOLE NO. 2
NO SCALE

RECORD DRAWING

NUMBER	DATE	MADE BY	CHECKED BY	DESCRIPTION
REVISIONS				

DRAWN BY
W. Whitman

DEPT. CHECK
A.J. Marshall

PROJ. CHECK
A.J. Marshall

CHARLES V. HITCHCOCK, JR.
No. 1354
REGISTERED PROFESSIONAL ENGINEER

MICHAEL EUSCHÉ GRILLI
No. 3670
REGISTERED PROFESSIONAL ENGINEER

M&E METCALF & EDDY, INC./ENGINEERS
BOSTON / NEW YORK / PALM ALTO / CHICAGO

Charles V. Hitchcock, Jr.
REG. PROF. ENGR. R.I. NO. 1354
DATE 6/27/77

Michael E. Grilli
REG. PROF. ENGR. R.I. NO. 3670
DATE 6-22-77

SCALE:
AS SHOWN

UNLESS OTHERWISE NOTED OR CHANGED BY REPRODUCTION

TOWN OF BURRILLVILLE, RHODE ISLAND
BOARD OF SEWER COMMISSIONERS

WASTEWATER TREATMENT FACILITIES

YARD DETAILS
CIVIL

JOB 4868

FILE NO. H-68968-1

SHEET C-8