


ROAD PROFILE
 SCALE: HOR. 1"=30'
 VERT. 1"=3'

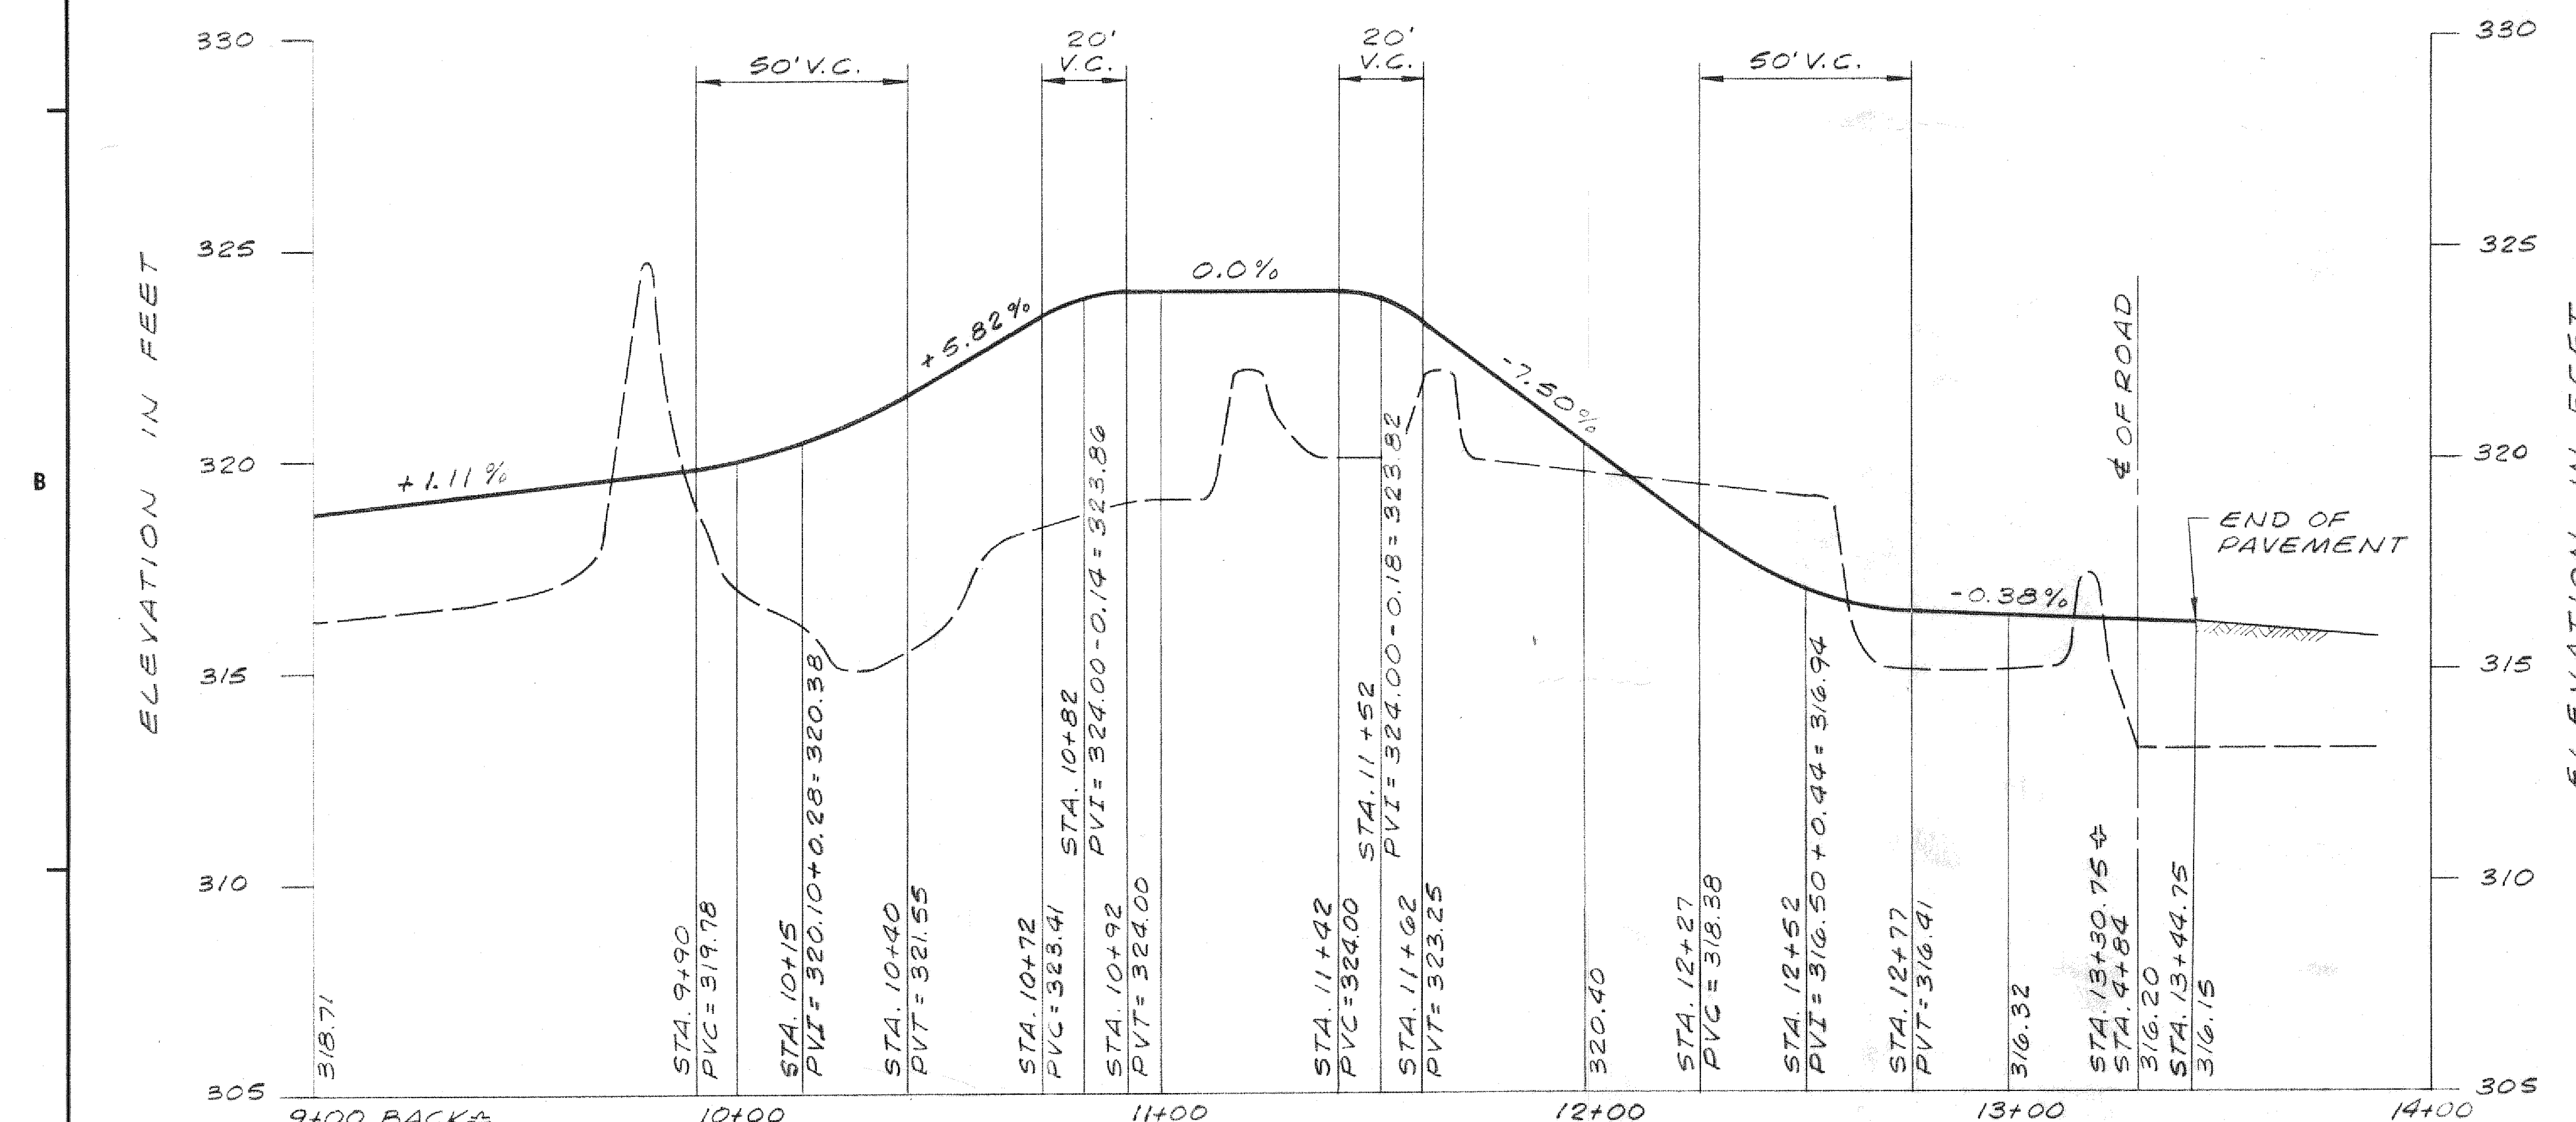

ROAD PROFILE
 SCALE: HOR. 1"=30'
 VERT. 1"=3'

RECORD DRAWING

<table border="1" style="width:100%; border-collapse: collapse;"> <tr><td> </td><td> </td><td> </td><td> </td></tr> <tr><td> </td><td> </td><td> </td><td> </td></tr> <tr><td> </td><td> </td><td> </td><td> </td></tr> <tr><td> </td><td> </td><td> </td><td> </td></tr> <tr> <th>NUMBER</th><th>DATE</th><th>MADE BY</th><th>CHECKED BY</th></tr> <tr> <td colspan="4"> </td></tr> <tr> <th colspan="2">REVISIONS</th><th colspan="2">DESCRIPTION</th></tr> <tr> <td colspan="2"> </td><td colspan="2"> </td></tr> </table>																				NUMBER	DATE	MADE BY	CHECKED BY					REVISIONS		DESCRIPTION						DRAWN BY <i>A. Restana</i> DEPT. CHECK <i>R. J. Marshall</i> PROJ. CHECK <i>R. J. Marshall</i>		<div style="display: flex; justify-content: space-around;"> <div style="text-align: center;"> </div> <div style="text-align: center;"> </div> </div> <div style="text-align: center;"> </div> <div style="display: flex; justify-content: space-between;"> <div> Charles Y. Hitchcock, Jr. REG. PROF. ENGR. R.I. NO. 1,154 Michael Eugene Grilli REG. PROF. ENGR. R.I. NO. 3620 </div> <div> 6/2/77 DATE 6-22-77 DATE </div> </div>		SCALE: AS SHOWN		TOWN OF BURRILLVILLE, RHODE ISLAND BOARD OF SEWER COMMISSIONERS WASTEWATER TREATMENT FACILITIES ROAD PROFILE CIVIL		JOB 4868 FILE NO. H-68956-1 CONTRACT 76-1 SHEET C-0	
NUMBER	DATE	MADE BY	CHECKED BY																																										
REVISIONS		DESCRIPTION																																											