





GRIT CHAMBER PLAN
SCALE 1/4"=1'-0"

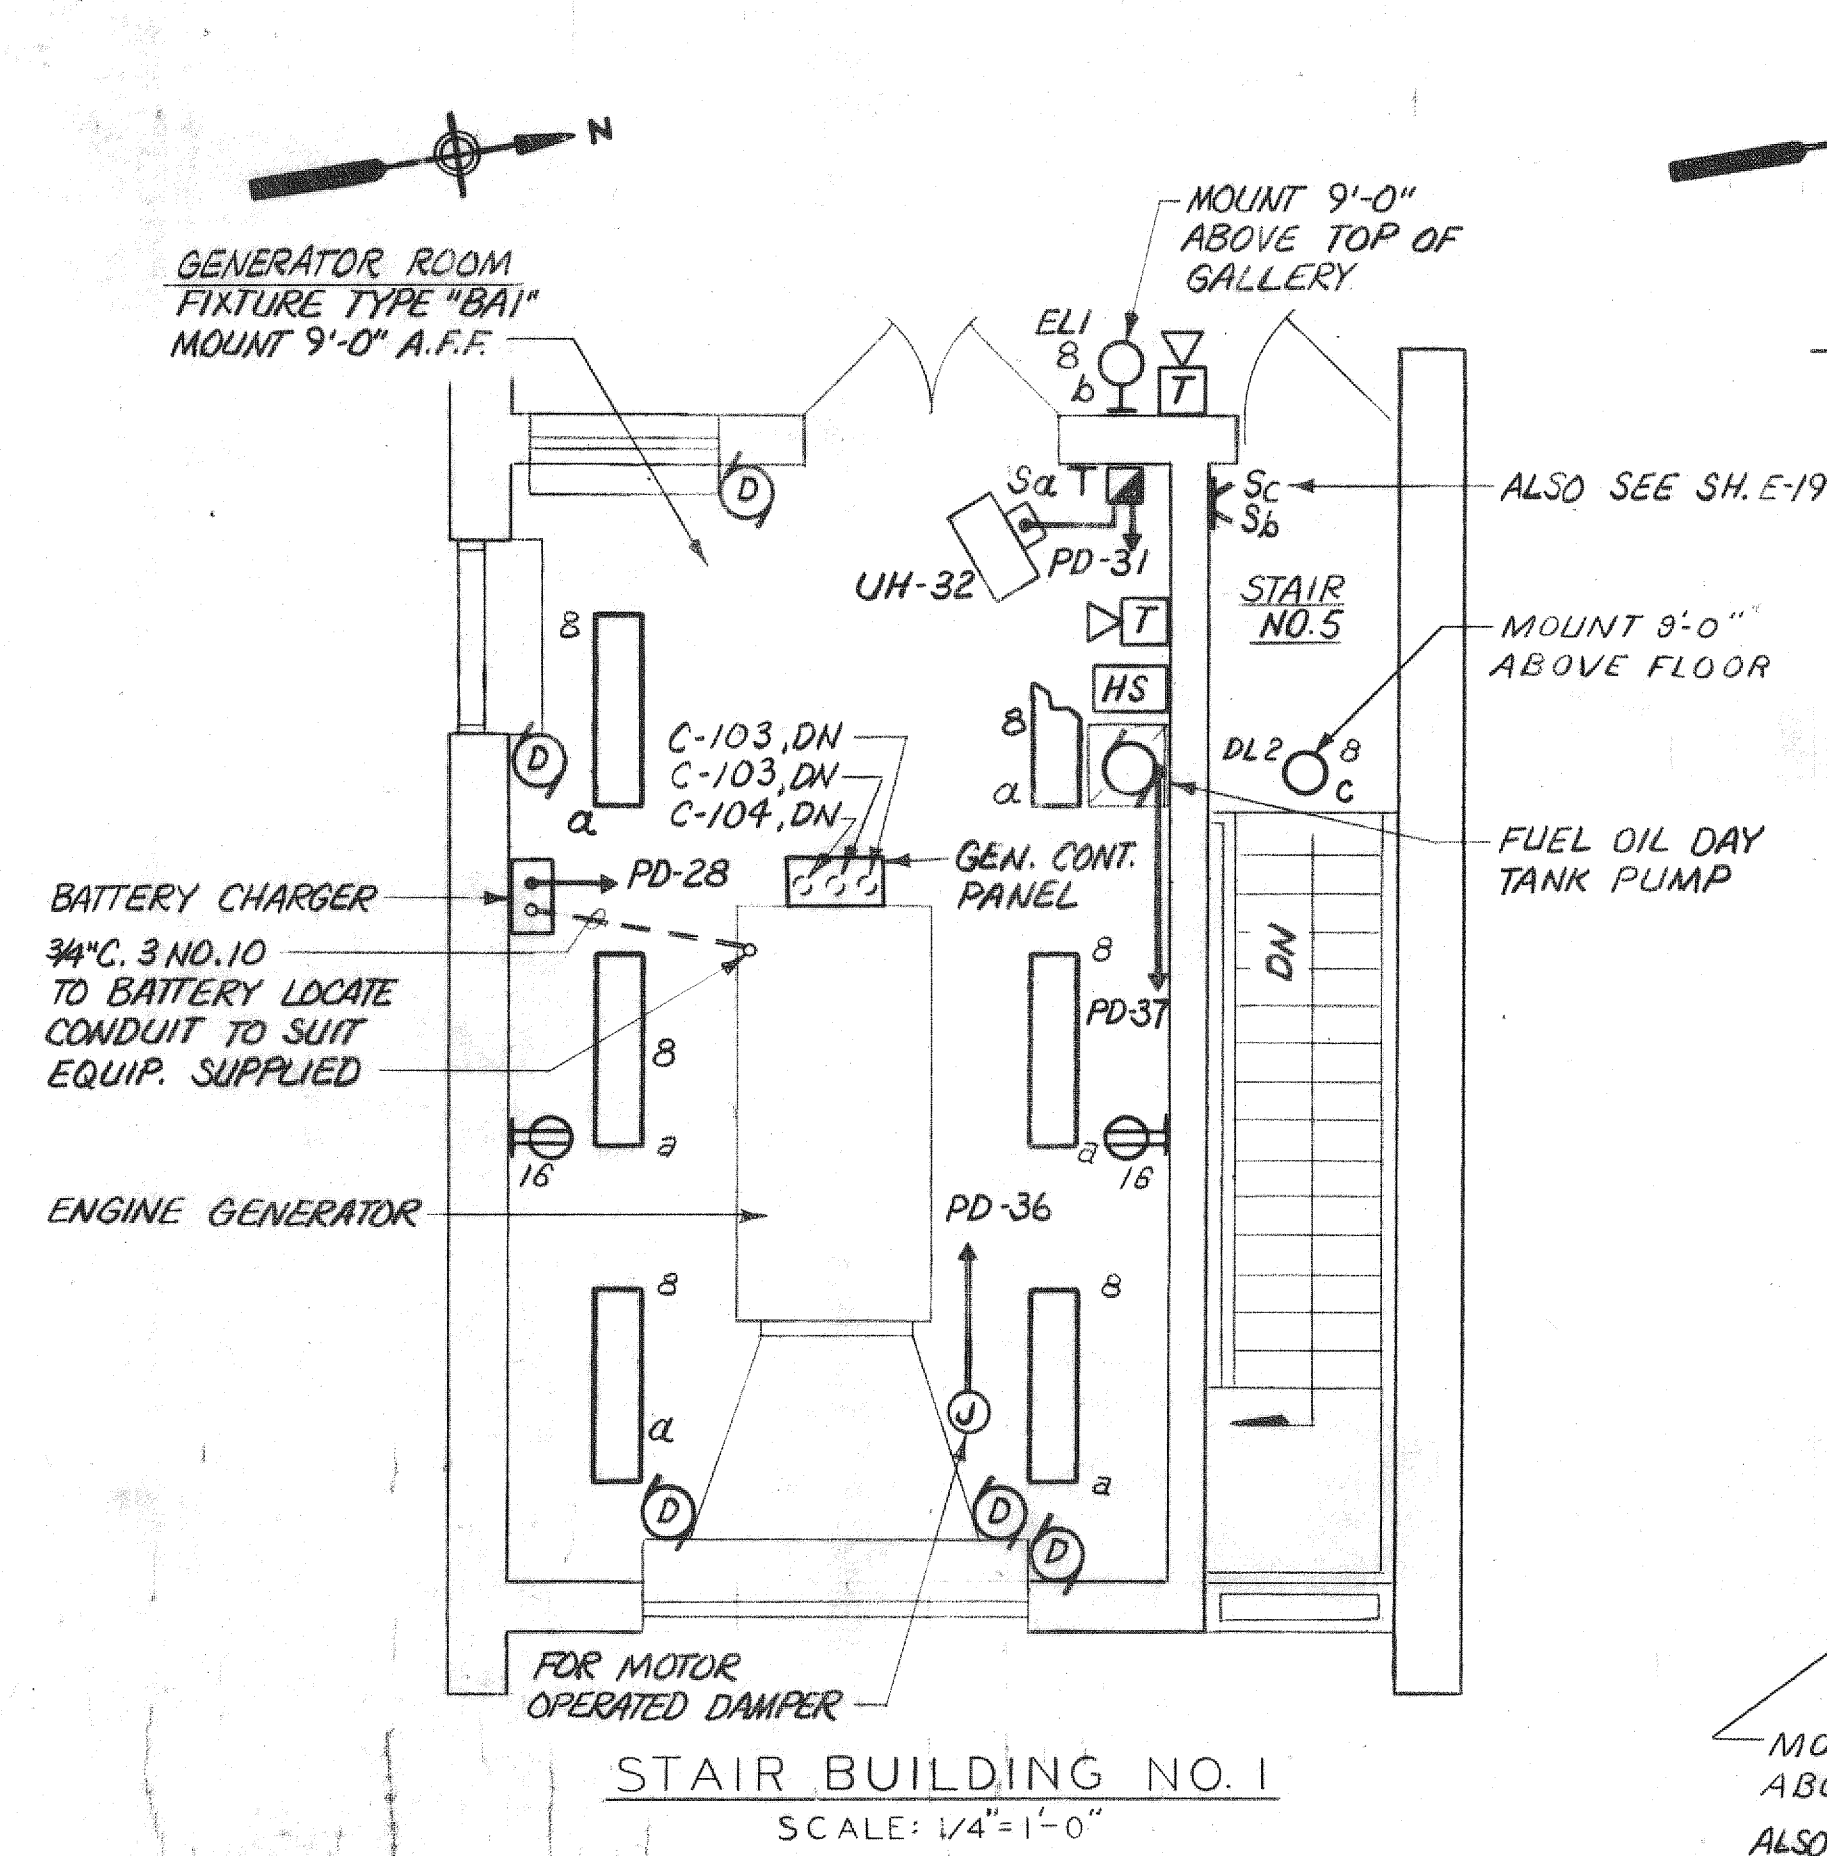


STAIR BUILDING NO. 1
SCALE: 1/4"=1'-0"

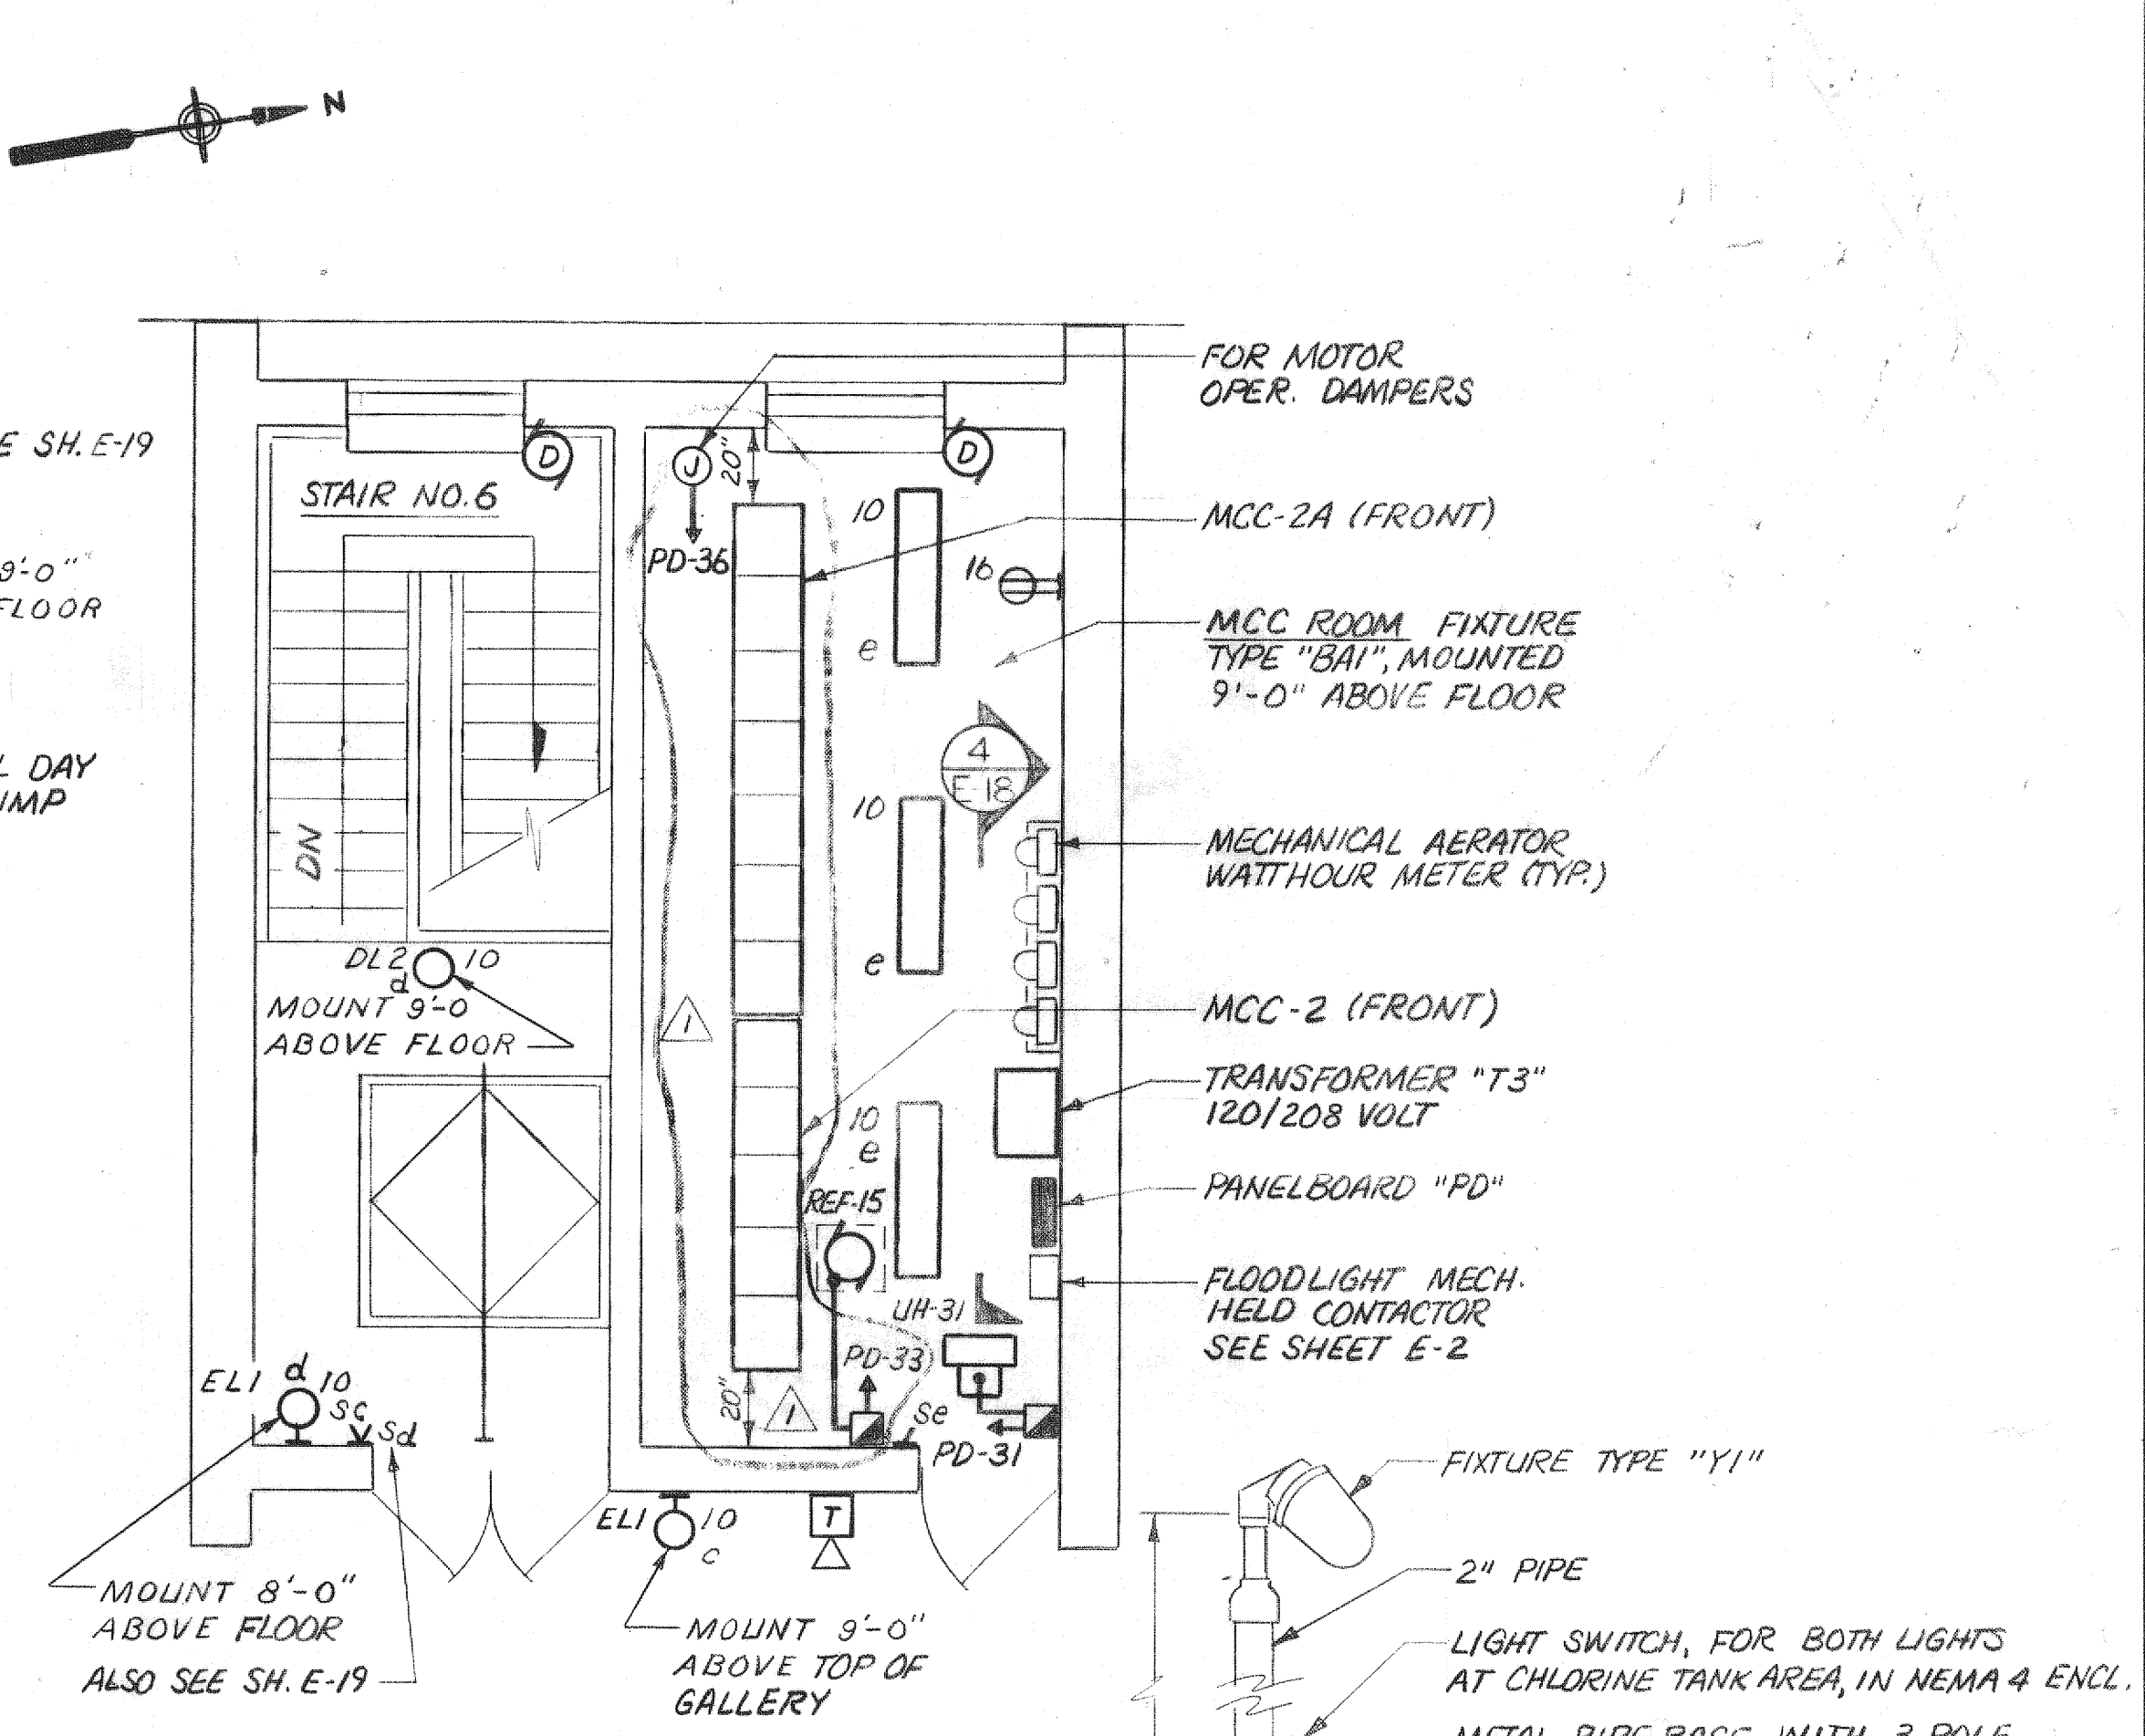

STAIR BUILDING NO. 2
SCALE: 1/4"=1'-0"

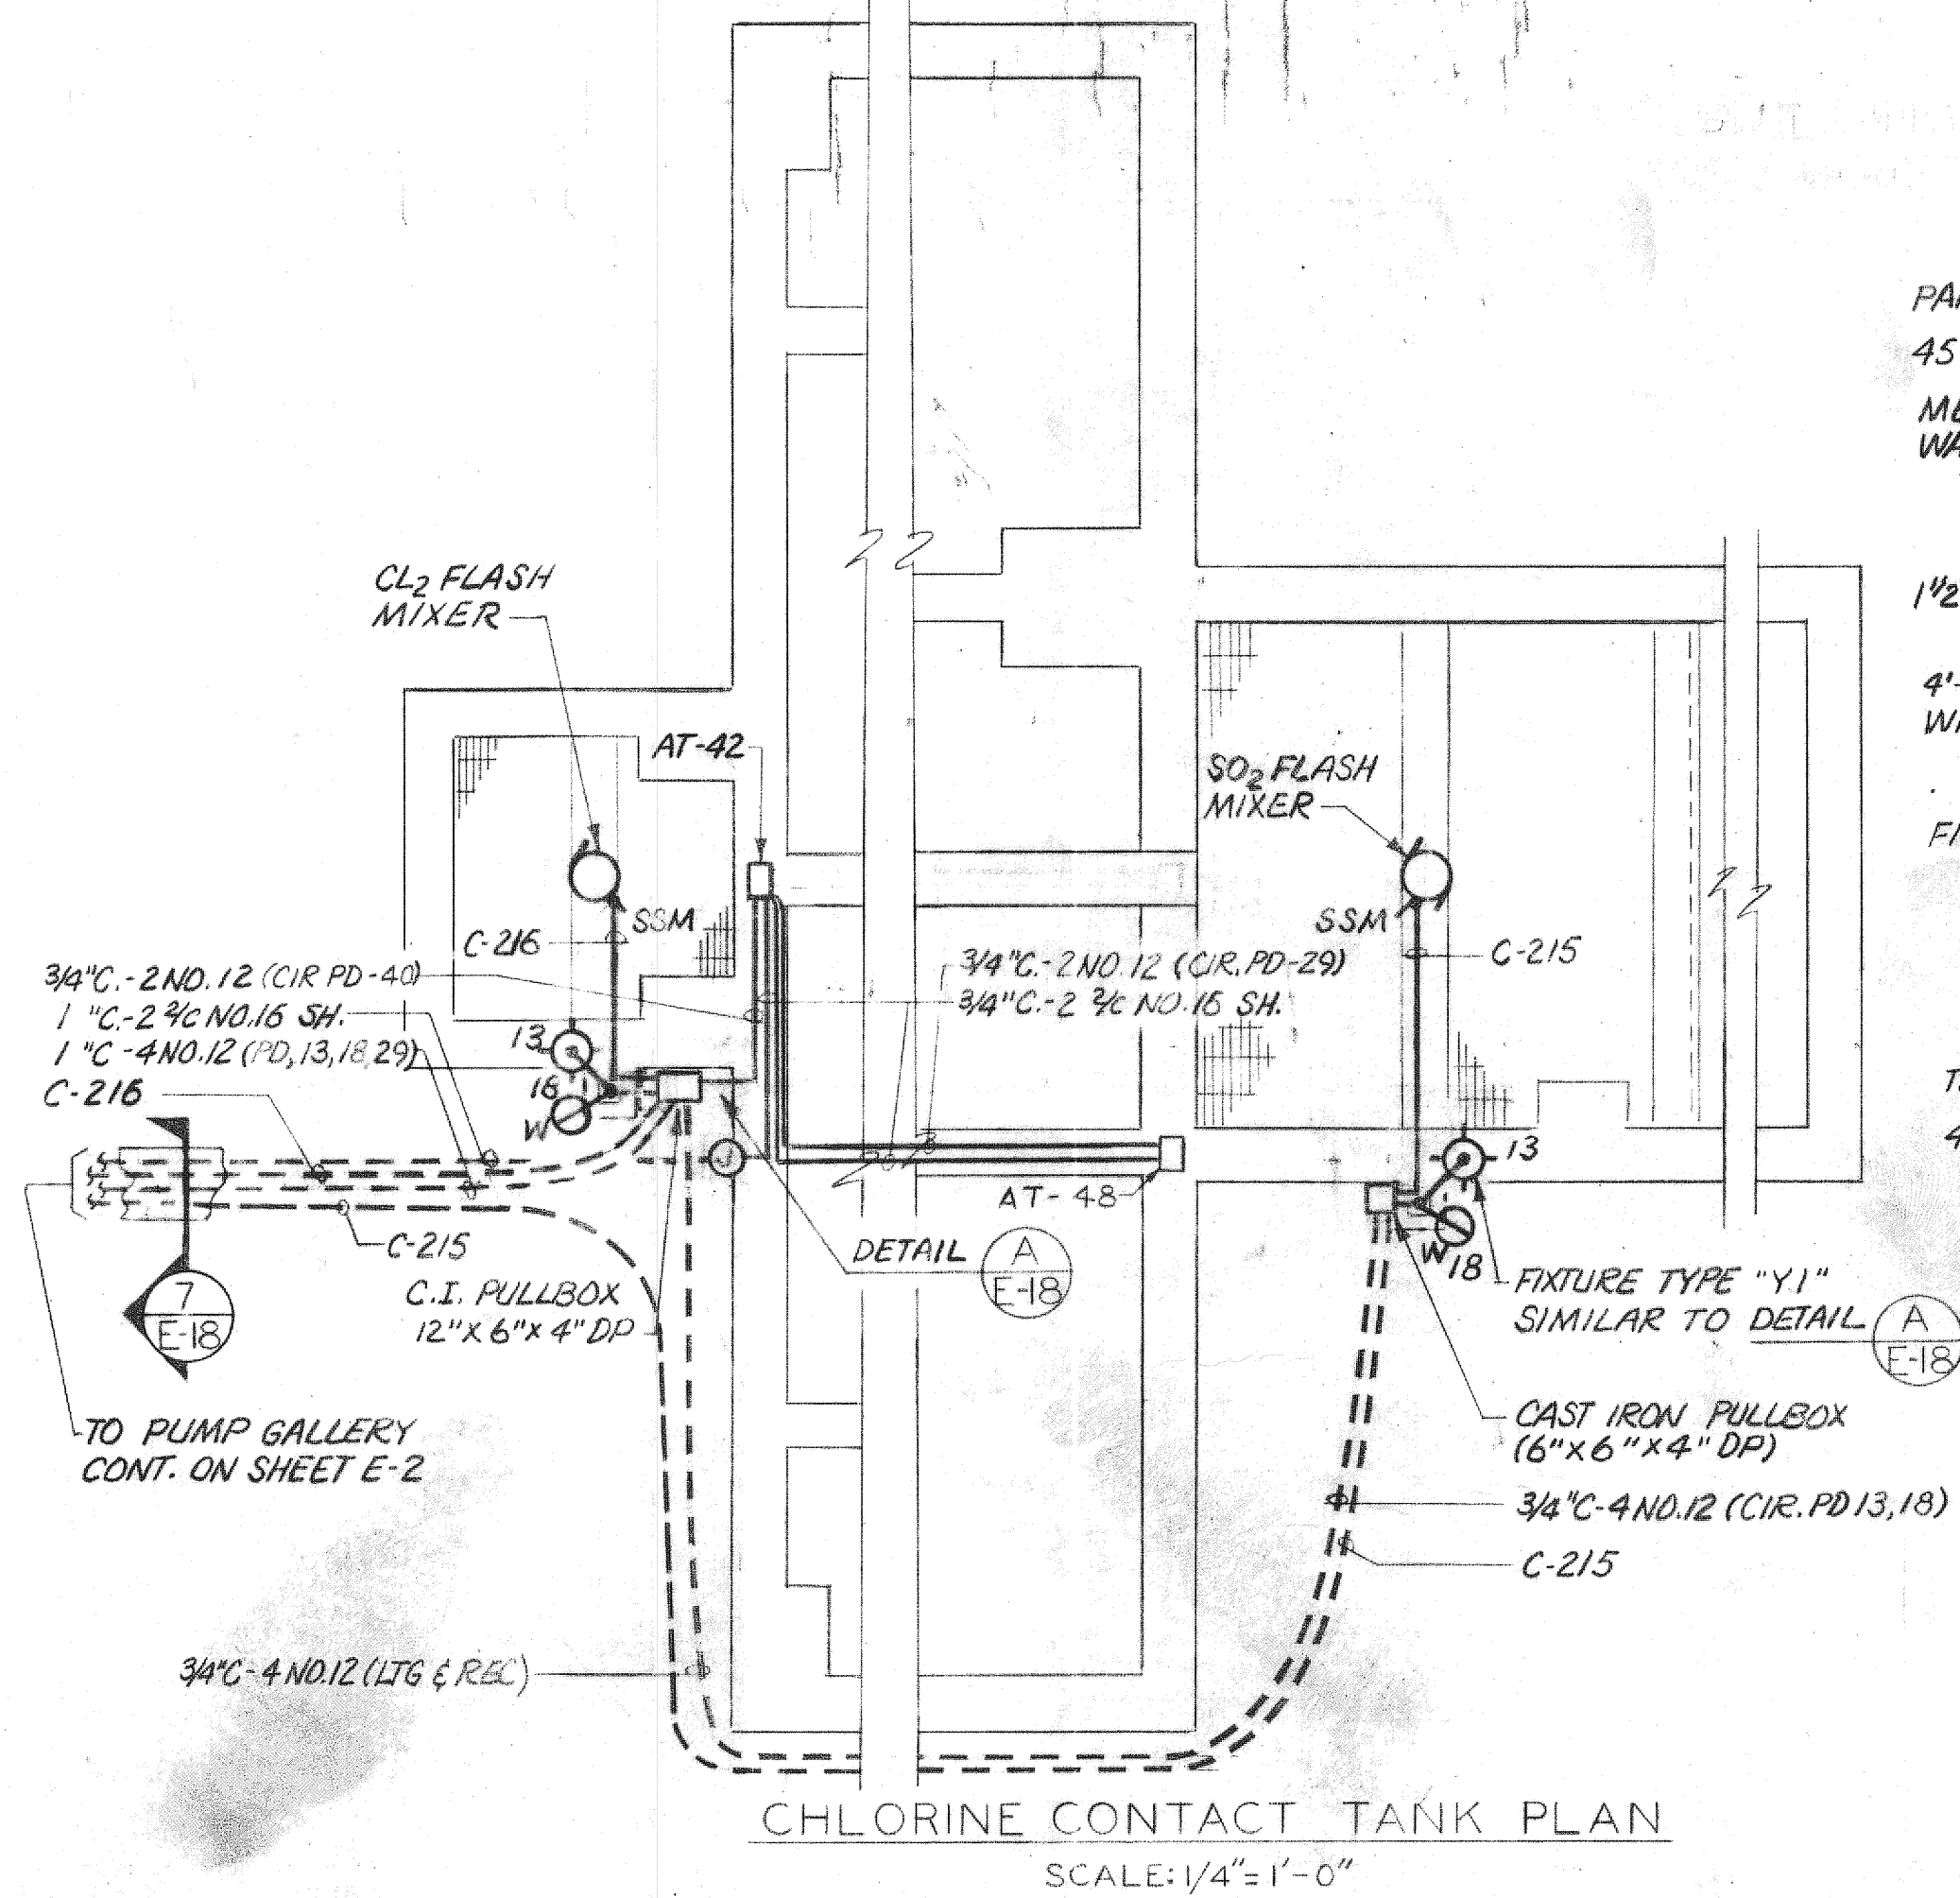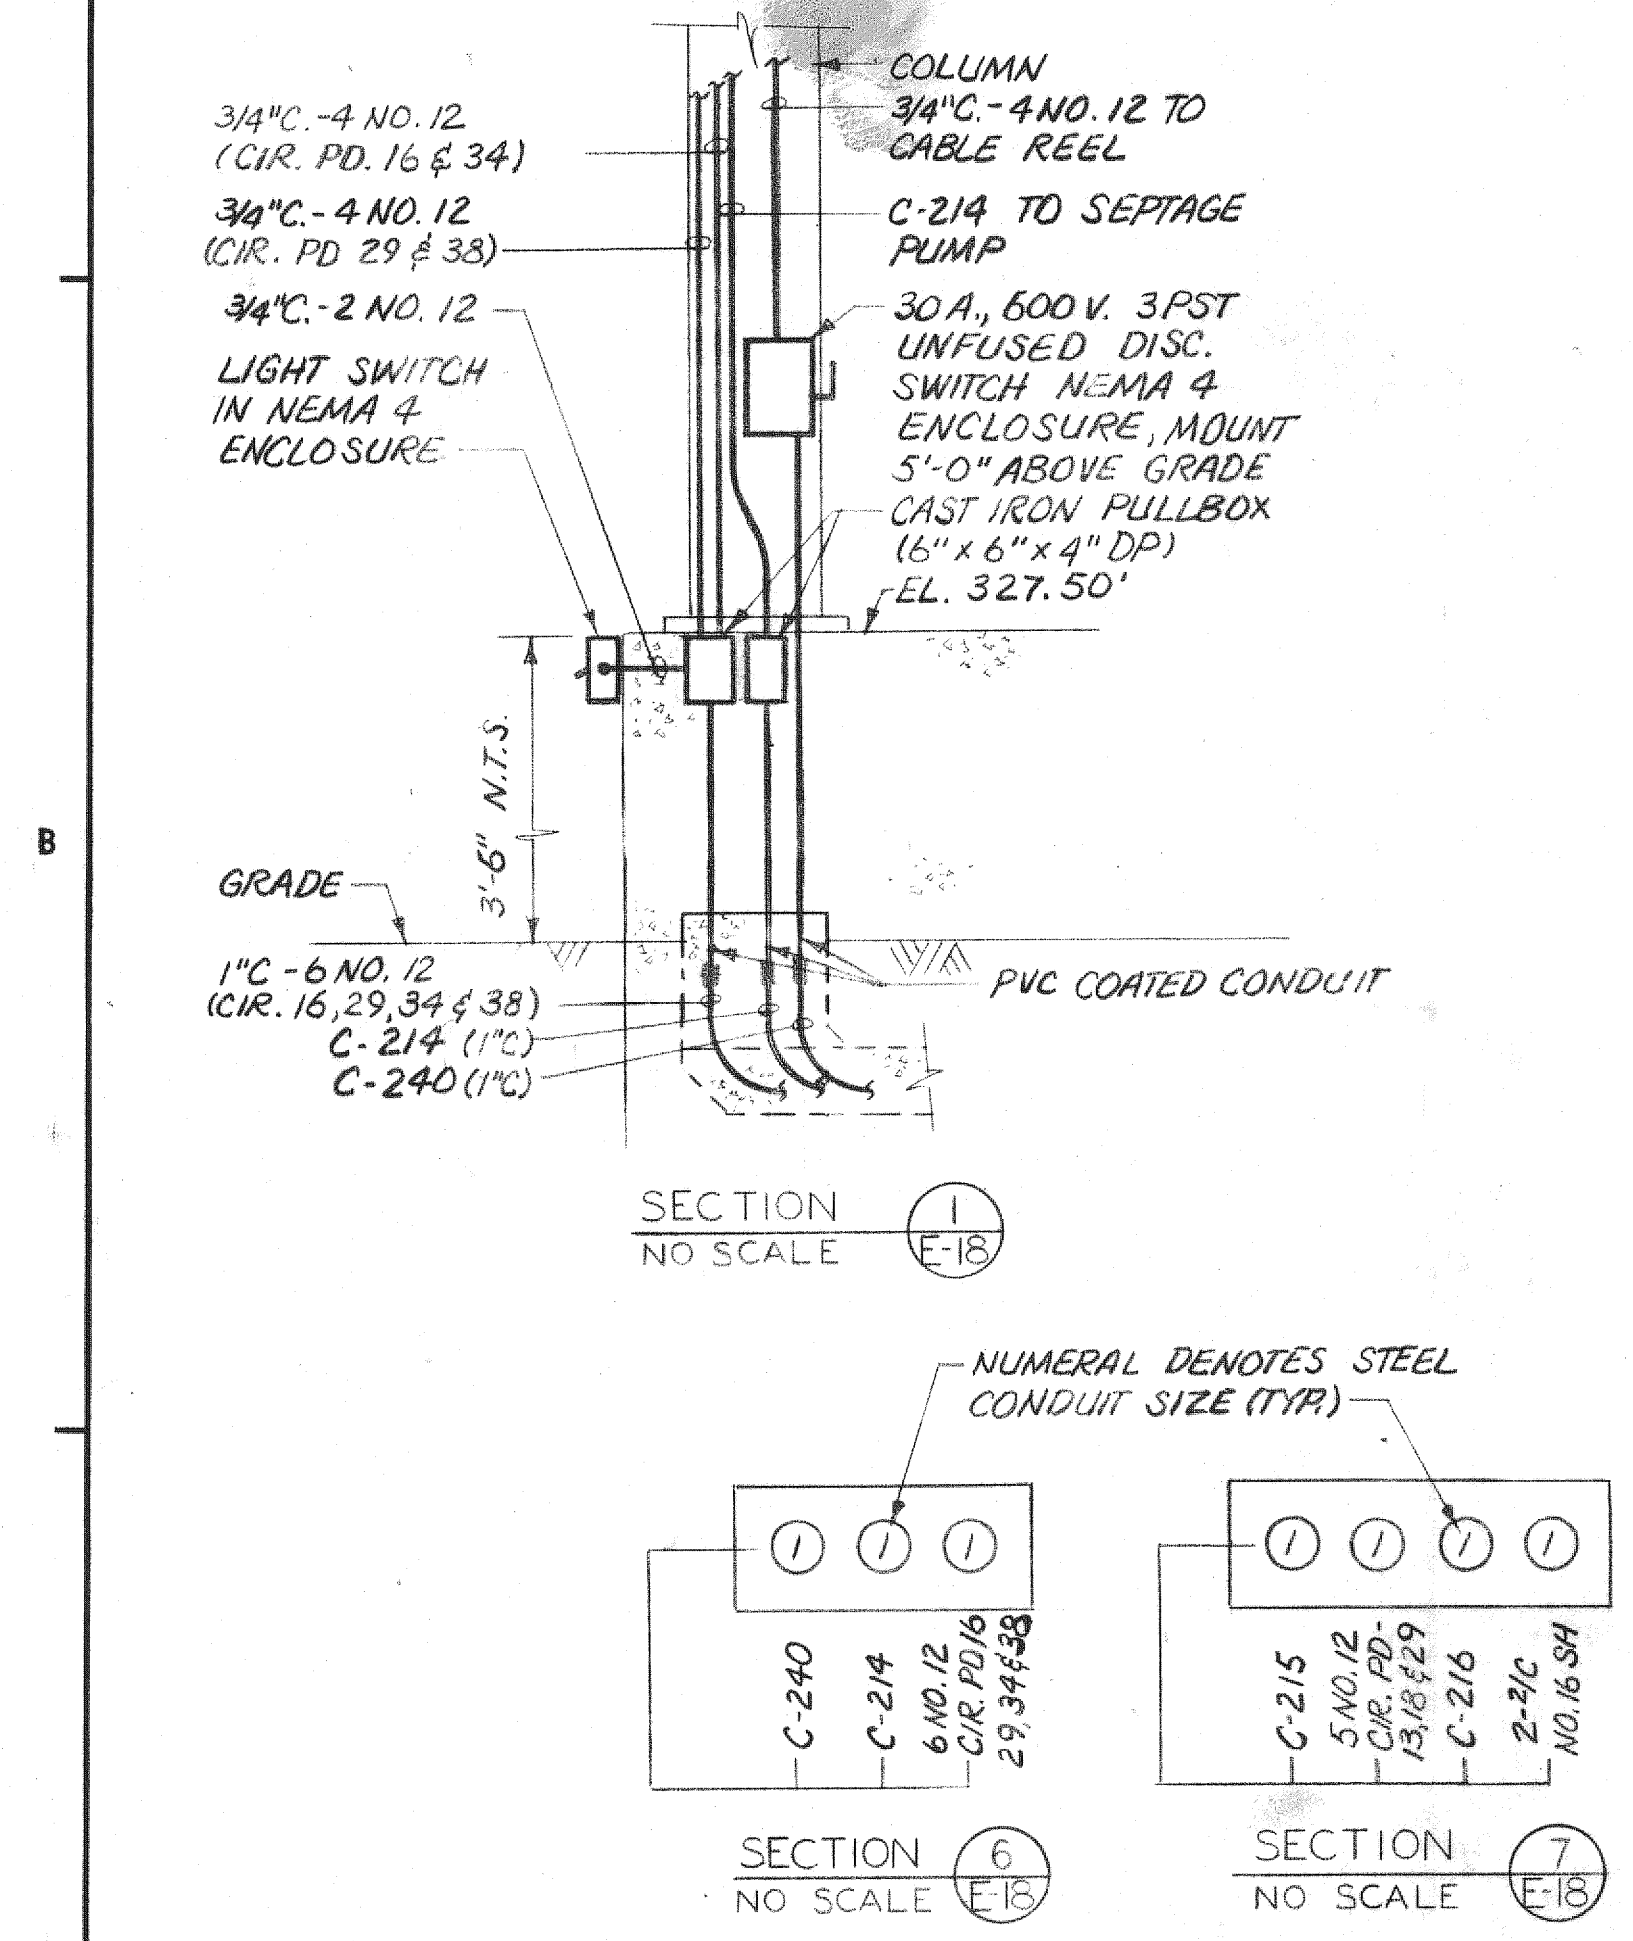

CHLORINE CONTACT TANK PLAN
SCALE: 1/4"=1'-0"

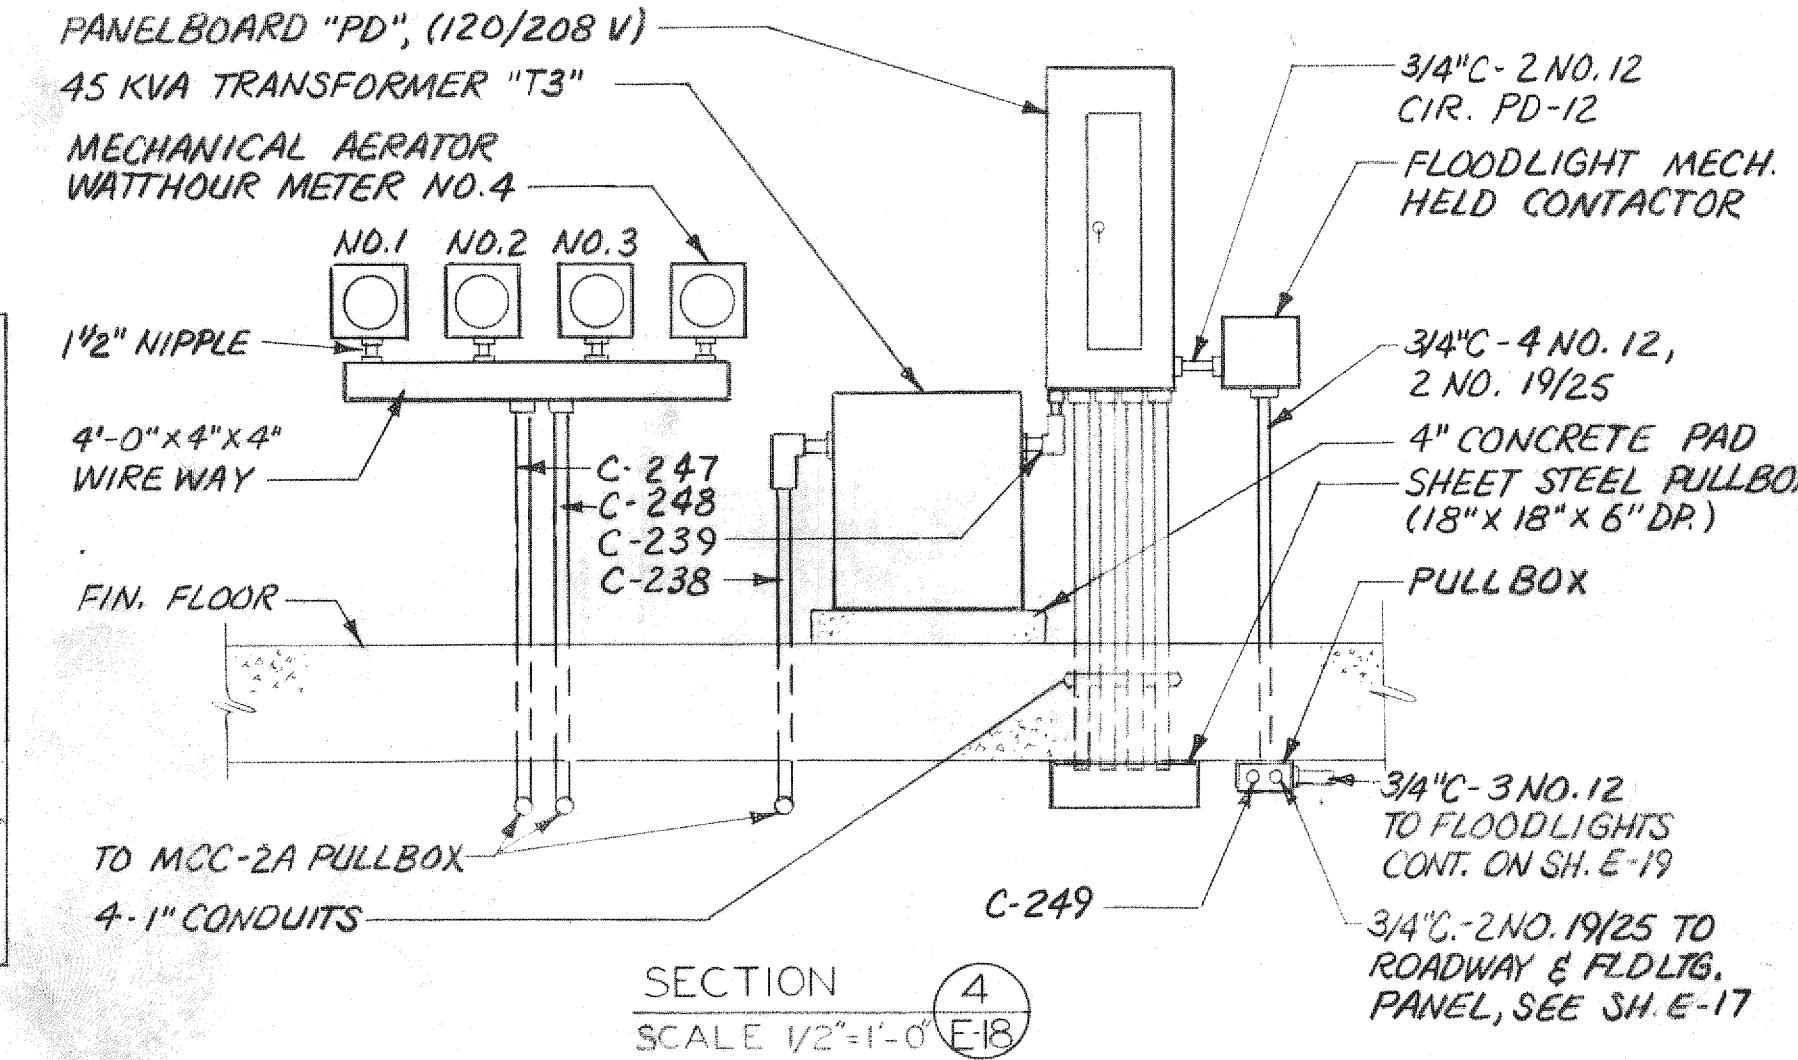

- NOTES:
- FOR SYMBOLS AND GENERAL NOTES SEE SHEET E-1.
 - OUTLET, SWITCH, JUNCTION, PULL AND TERMINAL BOXES SHALL BE PROVIDED AS INDICATED ON THE EQUIPMENT ENCLOSURE SCHEDULES. ALL EXPOSED OUTDOOR CONDUIT, CONDUIT RACKS, CONDUIT FITTINGS AND CLAMPS SHALL BE PVC COATED. FASTENERS SHALL BE STAINLESS STEEL.
 - FOR CONDUIT AND WIRE SCHEDULES SEE SHEET E-20.
 - FOR LIGHTING FIXTURE TYPE AND DETAILS SEE APPENDIX "B" OF THE SPECIFICATIONS.
 - FOR PANELBOARD "PD" SCHEDULE SEE SHEET E-20.
 - FOR INTERCOM RISER DIAGRAM SEE SHEET E-14.
 - FOR CONDUIT AND WIRE SCHEDULES SEE SHEET E-20 AND E-21.
 - FOR EQUIPMENT ENCLOSURE SCHEDULE SEE SHEET E-20.
 - SEPTAGE PUMP ENCLOSURE TO BE HEATED WITH 2 KW BLOWER TYPE ELECTRIC UNIT HEATER. HEATER SHALL HAVE A BUILT-IN LOW AMBIENT THERMOSTAT, AUTOMATIC RESET OVER-TEMPERATURE DEVICE AND FAN-DELAY SWITCH. THE ENCLOSURE SHALL BE HEAVY GAUGE STEEL BAKED ENAMEL FINISH FOR RUST-PROOF SERVICE AND HAVE ADJUSTABLE LOUVERS.

RECORD DRAWING

<p>12/7/77 D. WALKER H. B. B. H. ADDED SECTION TO MCC-2, RELOCATED MCC'S</p>				<p>DRAWN BY D. Walker W. Kenter</p>	<p>DEPT. CHECK H. B. B. H.</p>	<p>PROJ. CHECK R. J. Marshall</p>	<p>DAVID W. PAULSON No. 18107 REGISTERED PROFESSIONAL ENGINEER</p>	<p>METCALF & EDDY, INC. / ENGINEERS BOSTON / NEW YORK / PALO ALTO / CHICAGO</p>	<p>6/1/77 DATE 6-27-77 DATE</p>	<p>SCALE: 0 4 8 12 SCALE IN FEET SCALE 1/4" = 1'-0"</p>	<p>TOWN OF BURRILLVILLE, RHODE ISLAND BOARD OF SEWER COMMISSIONERS</p>	<p>WASTEWATER TREATMENT FACILITIES AERATION AND SETTLING TANKS STAIR BUILDINGS, GRIT CHAMBERS, CHLORINE CONTACT TANK, POWER AND LIGHTING</p>	<p>JOB 4862 FILE NO. H-69965-1 SHEET E-18</p>
------------------------------------------------------------------------------	--	--	--	---------------------------------------------	------------------------------------	---------------------------------------	----------------------------------------------------------------------------	-----------------------------------------------------------------------------------------	---------------------------------------------	---------------------------------------------------------------------	----------------------------------------------------------------------------	----------------------------------------------------------------------------------------------------------------------------------------------------------	-------------------------------------------------------