


FIRST FLOOR PLAN
SCALE: 1/4" = 1'-0"

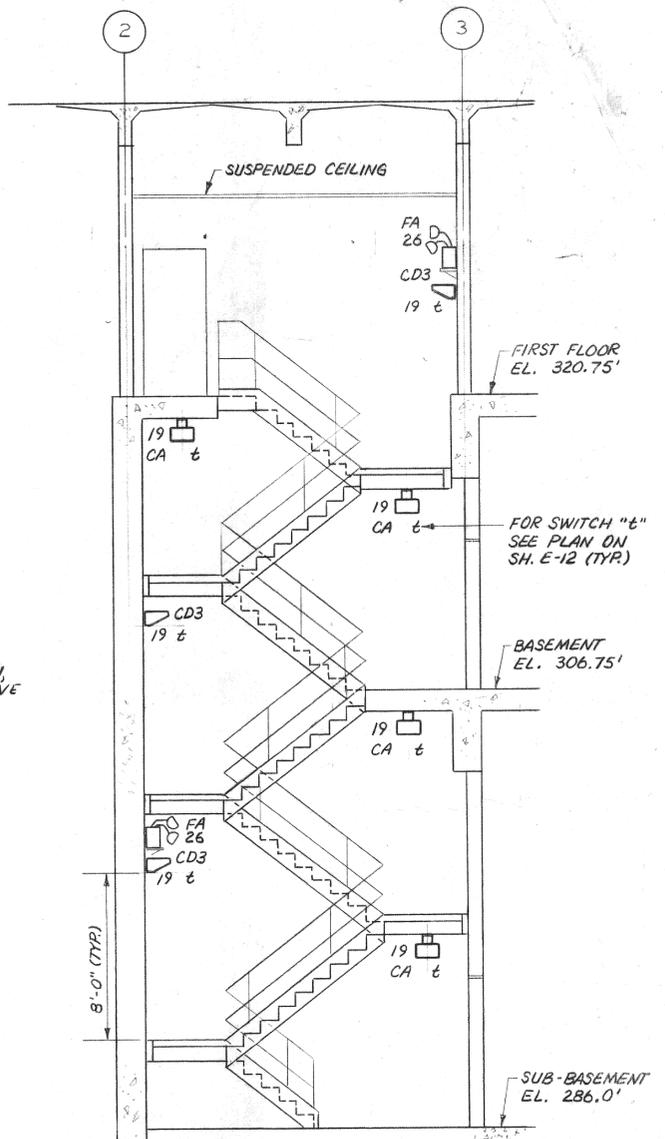

ALSO SEE SHEETS E-11 AND E-12
ELEVATION
STAIR NO. 3
SCALE: 1/4" = 1'-0"

- NOTES:
- FOR SYMBOLS AND GENERAL NOTES SEE SHEET E-1.
 - FOR INTERCOM RISER DIAGRAM SEE SHEET E-14.
 - FOR PANELBOARD SCHEDULE OF "PA", "PB" AND "PC" SEE SHEET E-20 AND E-21.
 - OUTLET, SWITCH, JUNCTION, PULL AND TERMINAL BOXES SHALL BE PROVIDED AS INDICATED ON EQUIPMENT ENCLOSURE SCHEDULE ON SHEET E-20.
 - FOR LIGHTING FIXTURE TYPE AND DETAILS SEE APPENDIX "B" OF THE SPECIFICATIONS.
 - ALL CONDUITS TO LIGHTING FIXTURES IN AREAS WITH HUNG CEILINGS SHALL BE RUN CONCEALED ABOVE HUNG CEILINGS, CONDUIT RUNS TO RECEPTACLES AND SWITCHES SHALL BE CONCEALED IN FLOOR OR WALL SLABS.
 - ALL RECEPTACLES IN THIS WING SHALL BE CONNECTED TO PANEL "PB".

RECORD DRAWING

NUMBER	DATE	MADE BY	CHECKED BY	REVISIONS	DESCRIPTION

DRAWN BY
B. Walker

DEPT. CHECK
H. Benedict

PROJ. CHECK
R. J. Marshall


STATE OF RHODE ISLAND
DAVID W. PAULSON
REGISTERED PROFESSIONAL ENGINEER

MICHAEL EUGENE GRILLI
No. 3620
REGISTERED PROFESSIONAL ENGINEER

M&E METCALF & EDDY, INC. / ENGINEERS
BOSTON / NEW YORK / PALO ALTO / CHICAGO

David W. Paulson
REG. PROF. ENGR. MASS. NO. 18107
DATE 6/17/77

Michael E. Grillo
REG. PROF. ENGR. R.I. NO. 3620
DATE 6-27-77

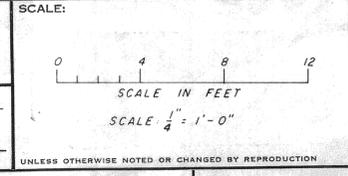

TOWN OF BURRILLVILLE, RHODE ISLAND
BOARD OF SEWER COMMISSIONERS

WASTEWATER TREATMENT FACILITIES
OPERATIONS BUILDING
FIRST FLOOR
PART II LIGHTING
ELECTRICAL

JOB 4868
FILE NO. H-69060-1
SHEET E-13