




AERATION AND SETTLING TANKS TOP PLAN
SCALE: 1/8" = 1'-0"

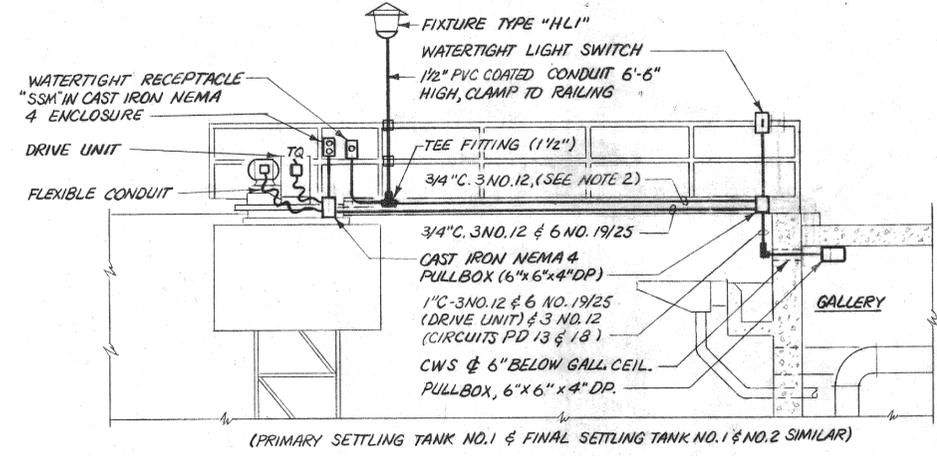

SECTION 1
NO SCALE E-15

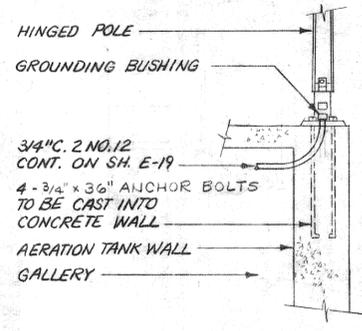

DETAIL A
NO SCALE E-15

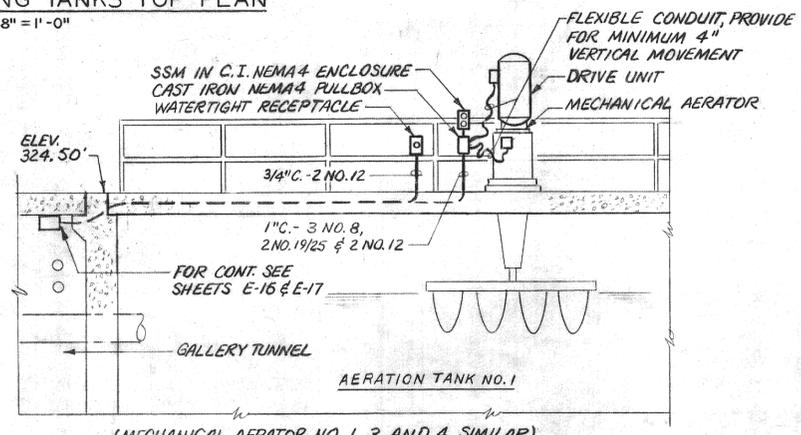

SECTION 2
NO SCALE E-15

- NOTES:**
1. FOR SYMBOLS AND GENERAL NOTES SEE SHEET E-1.
 2. OUTLET, SWITCH, JUNCTION, PULL AND TERMINAL BOXES SHALL BE PROVIDED AS INDICATED ON THE EQUIPMENT ENCLOSURE SCHEDULES. ALL EXPOSED OUTDOOR CONDUIT, CONDUIT RACKS, CONDUIT FITTINGS AND CLAMPS SHALL BE PVC COATED. FASTENERS SHALL BE STAINLESS STEEL.
 3. FOR CONDUIT AND WIRE SCHEDULE SEE SHEET E-20.
 4. FOR EQUIPMENT ENCLOSURE SCHEDULES SEE SHEET E-20.
 5. FOR LIGHTING FIXTURE TYPE AND DETAILS SEE APPENDIX "B" OF THE SPECIFICATIONS.
 6. FOR ROADWAY AND FLOODLIGHTING WIRING DIAGRAM SEE SHEET E-2.
 7. ALL CONDUIT EMERGING FROM CONCRETE TO OUTDOOR SHALL BE PVC COATED.

RECORD DRAWING

DRAWN BY <i>R. Marshall</i>				
DEPT. CHECK <i>A. J. Bennett</i>				
PROJ. CHECK <i>R. J. Marshall</i>				
REVISIONS				
NUMBER	DATE	MADE BY	CHECKED BY	DESCRIPTION


MICHAEL EDWIN GRILLI
REG. PROF. ENGR. No. 3620

M&E METCALF & EDDY, INC. / ENGINEERS
BOSTON / NEW YORK / PALO ALTO / CHICAGO

David W. Paulson
REG. PROF. ENGR. No. 18107

Michael E. Grillo
REG. PROF. ENGR. No. 3620

DATE: 6/27/77

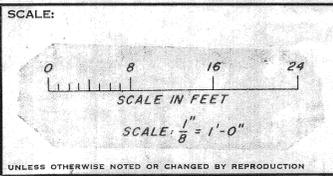

TOWN OF BURRILLVILLE, RHODE ISLAND
BOARD OF SEWER COMMISSIONERS

WASTEWATER TREATMENT FACILITIES
AERATION AND SETTLING TANKS
TOP PLAN
POWER AND LIGHTING ELECTRICAL

JOB: 4868
FILE NO.: H-69062-1
SHEET: E-15