


- NOTES:**
1. FOR SYMBOLS AND GENERAL NOTES SEE SHEET E-1.
 2. FOR LOCATION OF MCC-2 AND 2A SEE SHEET E-2, E-17 AND E-18.
 3. FOR SCHEMATIC WIRING DIAGRAMS SEE SHEET E-5 AND E-6.
 4. FOR CONDUIT AND WIRE SCHEDULE SEE SHEET E-20 AND E-21.

- LEGEND**
- 1 LOCATED AT MCC
 - 2 FURNISHED WITH BLOWER CONTROL PANEL
 - 3 LOCATED AT VACUUM FILTER PANEL P3
 - 4 MOISTURE DETECTOR LOCATED NEAR PUMPS
 - 5 DUPLEX SUMP PUMP CONTROL PANEL
 - 6 LOCATED AT FINAL SCUM WELL
 - 7 LOCATED AT PRIMARY SCUM WELL
 - 8 LOCATED AT OR NEAR MOTOR
 - 9 INTERLOCK AND POWER SUPPLY FOR SPEED CONTROL
 - 10 LOCATED AT SLUDGE CONTROL PANEL P2
 - 11 I N.O. CONTACT FOR INDICATING LIGHT ON GRAPHIC PANEL G1
 - 12 LOCATED AT PRIMARY SLUDGE PUMPS
 - 13 LOCATED AT TANK
 - 14 LOCATED IN MCC ROOM STAIR BUILDING NO. 2
 - 15 CONTROLS LOCATED IN ROADWAY AND FLOODLIGHTING CONTROL PANEL
 - 16 CONTROLS FURNISHED AND INSTALLED IN HYDRO-PNEUMATIC CONTROL PANEL

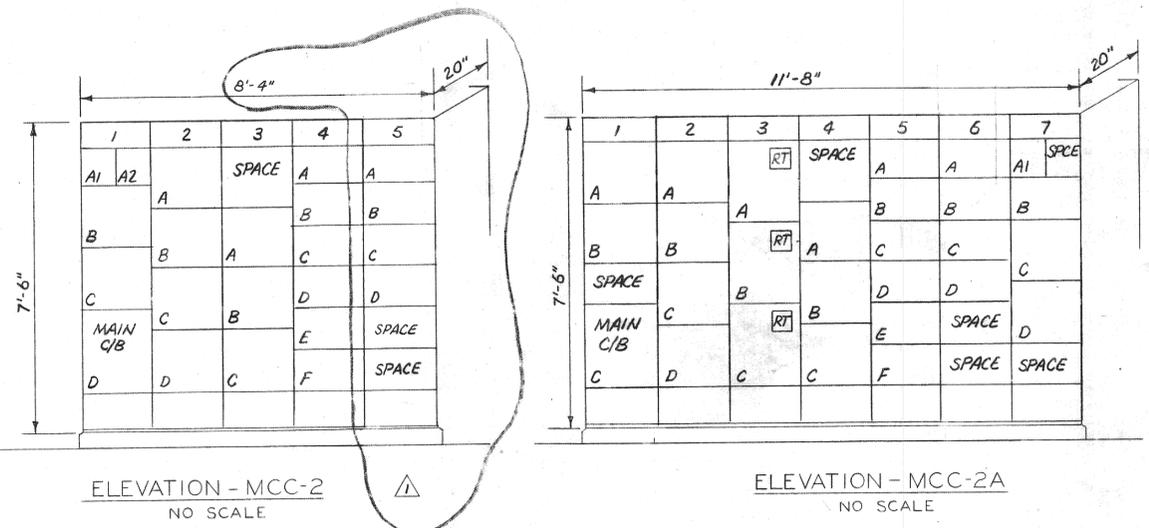

RECORD DRAWING

DRAWN BY <i>B. Walker</i>					SCALE: NONE	TOWN OF BURRILLVILLE, RHODE ISLAND BOARD OF SEWER COMMISSIONERS. WASTEWATER TREATMENT FACILITIES SINGLE LINE DIAGRAM II ELECTRICAL	JOB: 4868 FILE NO.: H-69956-1 SHEET: E-8
DEPT. CHECK <i>H.F. Bm. L.H.</i>							
PROJ. CHECK <i>R.J. Marshall</i>		12/6/77 D. WALKER H.F. Bm. L.H. ADDED BOOSTER PPS, AIR COMPRESSORS AND REVISED MCC-2		6/2/77 DATE 6-27-77 DATE		UNLESS OTHERWISE NOTED OR CHANGED BY REPRODUCTION	