
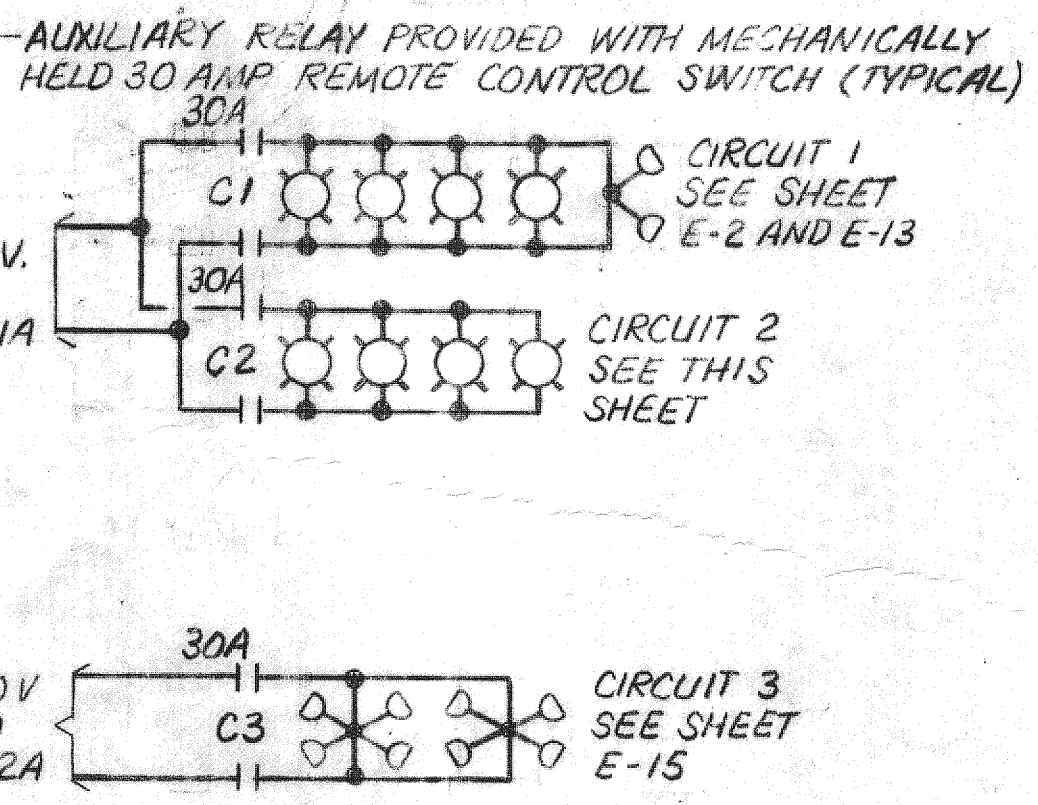


- NAMEPLATES**
- N1 1" x 4" ROADWAY & FLOODLIGHTING CONTROL PANEL
  - N2 1" x 3" MASTER SELECTOR SWITCH
  - N3 1" x 3" ROADWAY LIGHTING CIRCUIT NO. 1
  - N4 1" x 3" ROADWAY LIGHTING CIRCUIT NO. 2
  - N5 1" x 3" AERATION TANK FLOODLIGHTING CIRCUIT NO. 3
- NUMERAL INDICATES CONDUIT SIZE (TYP)**
- SECTION 2 NO SCALE E-2**
- SECTION 1 NO SCALE E-2**
- NOTES:**
- THE CONTRACTOR, WITH THE ENGINEER, SHALL MEET WITH BLACKSTONE VALLEY ELECTRIC COMPANY AND OBTAIN SPECIFICATIONS AND REQUIREMENTS FOR CONSTRUCTION OF THE TRANSFORMER PAD. THE CONTRACTOR SHALL INSTALL THE TRANSFORMER PAD IN ACCORDANCE WITH B.V.E. COMPANY SPECIFICATIONS, THE TRANSFORMER WILL BE PROVIDED AND PLACED BY BLACKSTONE VALLEY ELECTRIC COMPANY.
  - THE CONTRACTOR SHALL INSTALL ALL PRIMARY SERVICE CONDUIT AND ACCESSORIES FROM THE TRANSFORMER TO AND UP THE RISER POLE IN ACCORDANCE WITH BLACKSTONE VALLEY ELECTRIC COMPANY SPECIFICATION AND REQUIREMENTS.
  - FOR SYMBOLS AND GENERAL NOTES SEE SHEET E-1.
  - FOR LIGHTING FIXTURE TYPE AND DETAILS SEE APPENDIX "B" OF THE SPECIFICATIONS AND SHEET E-1 FOR SCHEDULE.
  - FOR EQUIPMENT ENCLOSURE SCHEDULES SEE SHEET E-20.
  - FOR CONDUIT AND WIRE SCHEDULE SEE SHEETS E-20 AND E-21.
  - FOR LOCATION OF OIL AND DIESEL FUEL TANKS SEE DRAWING SHEET C-4.

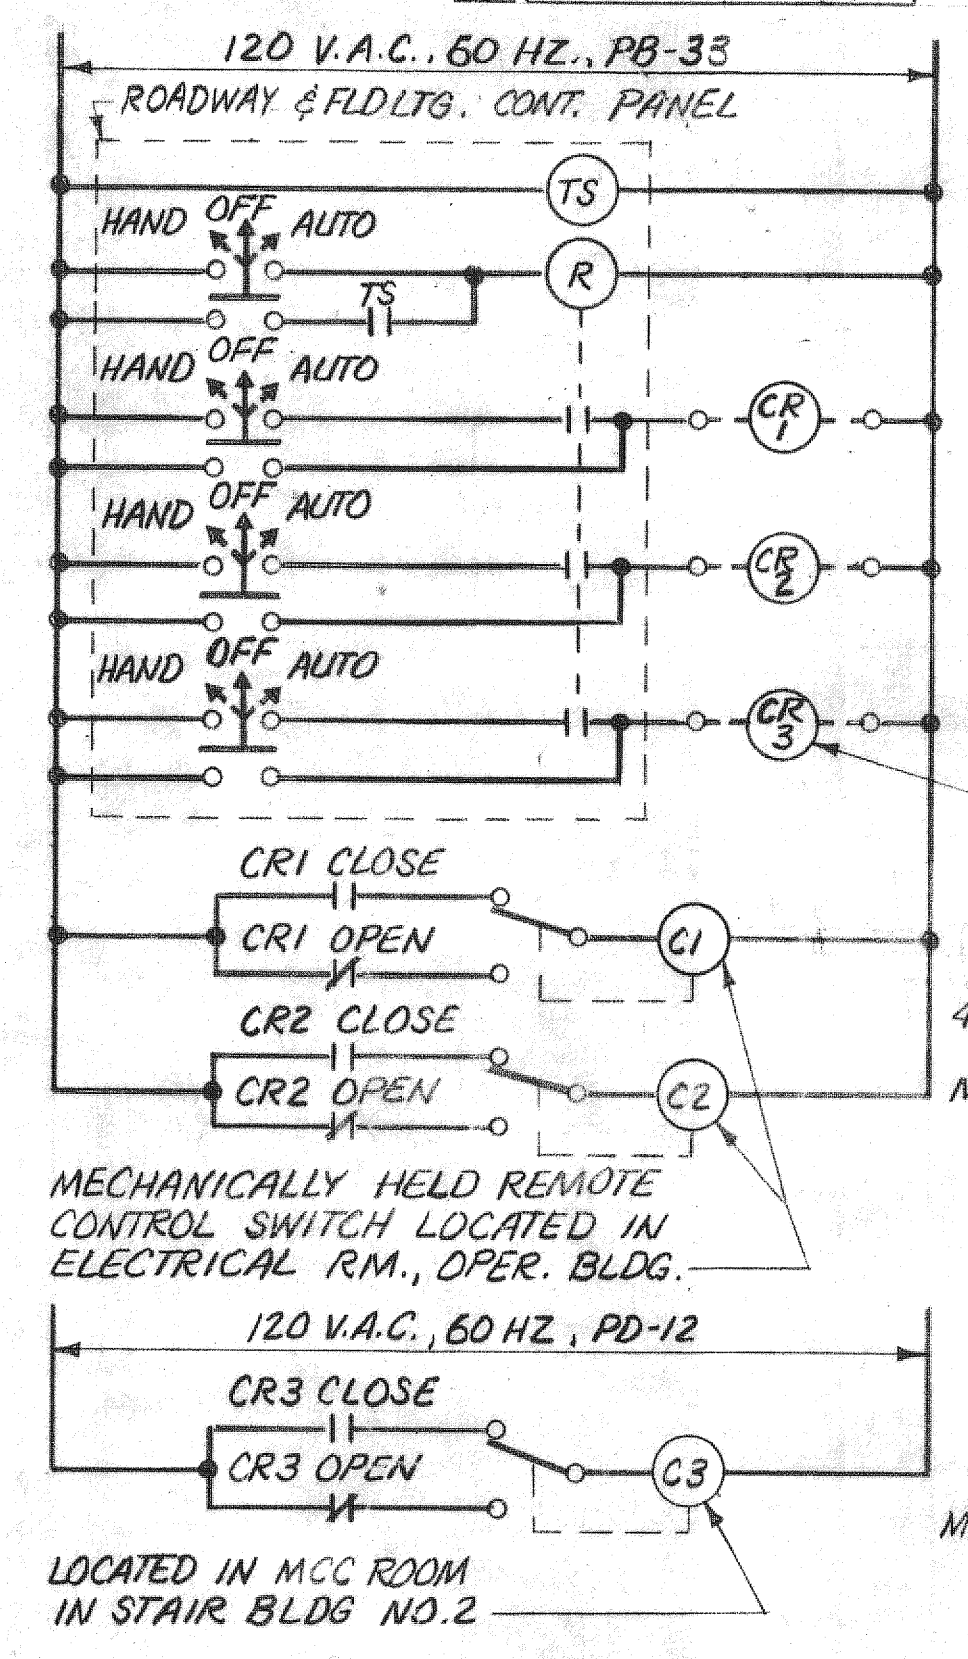

# RECORD DRAWING

DRAWN BY D. Walker				DEPT. CHECK H. Brundeth				PROJ. CHECK R. Marshall				MICHAEL EUGENE GRILLI REGISTERED PROFESSIONAL ENGINEER No. 3620				M&E METCALF & EDDY, INC. / ENGINEERS BOSTON / NEW YORK / PALO ALTO / CHICAGO David W. Paulson REG. PROF. ENGR. No. 11107 Michael E. Brundeth REG. PROF. ENGR. No. 3620				SCALE: AS SHOWN UNLESS OTHERWISE NOTED OR CHANGED BY REPRODUCTION				TOWN OF BURRILLVILLE, RHODE ISLAND BOARD OF SEWER COMMISSIONERS WASTEWATER TREATMENT FACILITIES SITE PLAN - POWER AND LIGHTING ELECTRICAL				JOB 4868 FILE NO. W-59955-1 SHEET E-2			
RELOCATED MCC'S AND ASSOC. CONDUITS, ADDED GND. SYSTEM																															