


RECORD DRAWING

NUMBER	DATE	MADE BY	CHECKED BY	DESCRIPTION
1	12/7/77	DWALKER	WFB	ADDED CONDUIT & WIRE FOR WATER SYSTEM


DRAWN BY D. Walker
DEPT. CHECK A.F. Bonadelli
PROJ. CHECK R. J. Marshall

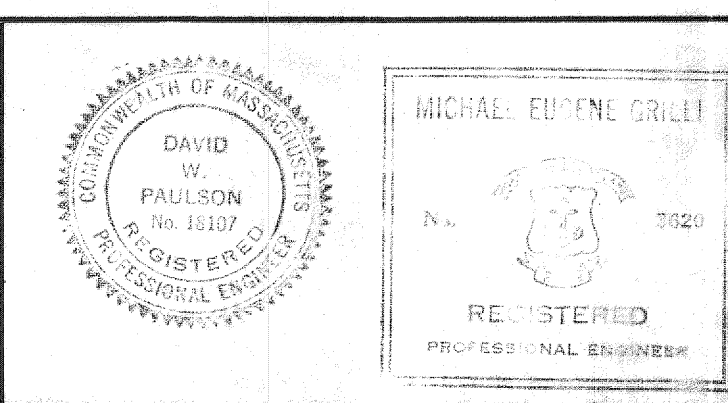

M&E METCALF & EDDY, INC. / ENGINEERS
BOSTON / NEW YORK / PALO ALTO / CHICAGO

David W. Paulson
REG. PROF. ENGR. MASS. NO. 13107
Michael E. Eddy
REG. PROF. ENGR. E.I. NO. 3620

DATE: 6/7/77
DATE: 6-27-77

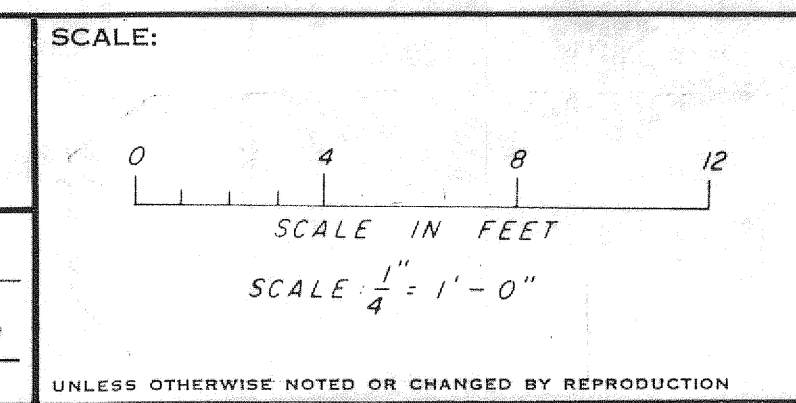

TOWN OF BURRILLVILLE, RHODE ISLAND BOARD OF SEWER COMMISSIONERS WASTEWATER TREATMENT FACILITIES AERATION AND SETTLING TANKS PUMP GALLERY LOWER PLAN II - POWER ELECTRICAL	JOB: 4868 FILE NO.: H-69964-1 SHEET: E-17
---	---