

D

C

B


A

D

C

B

A

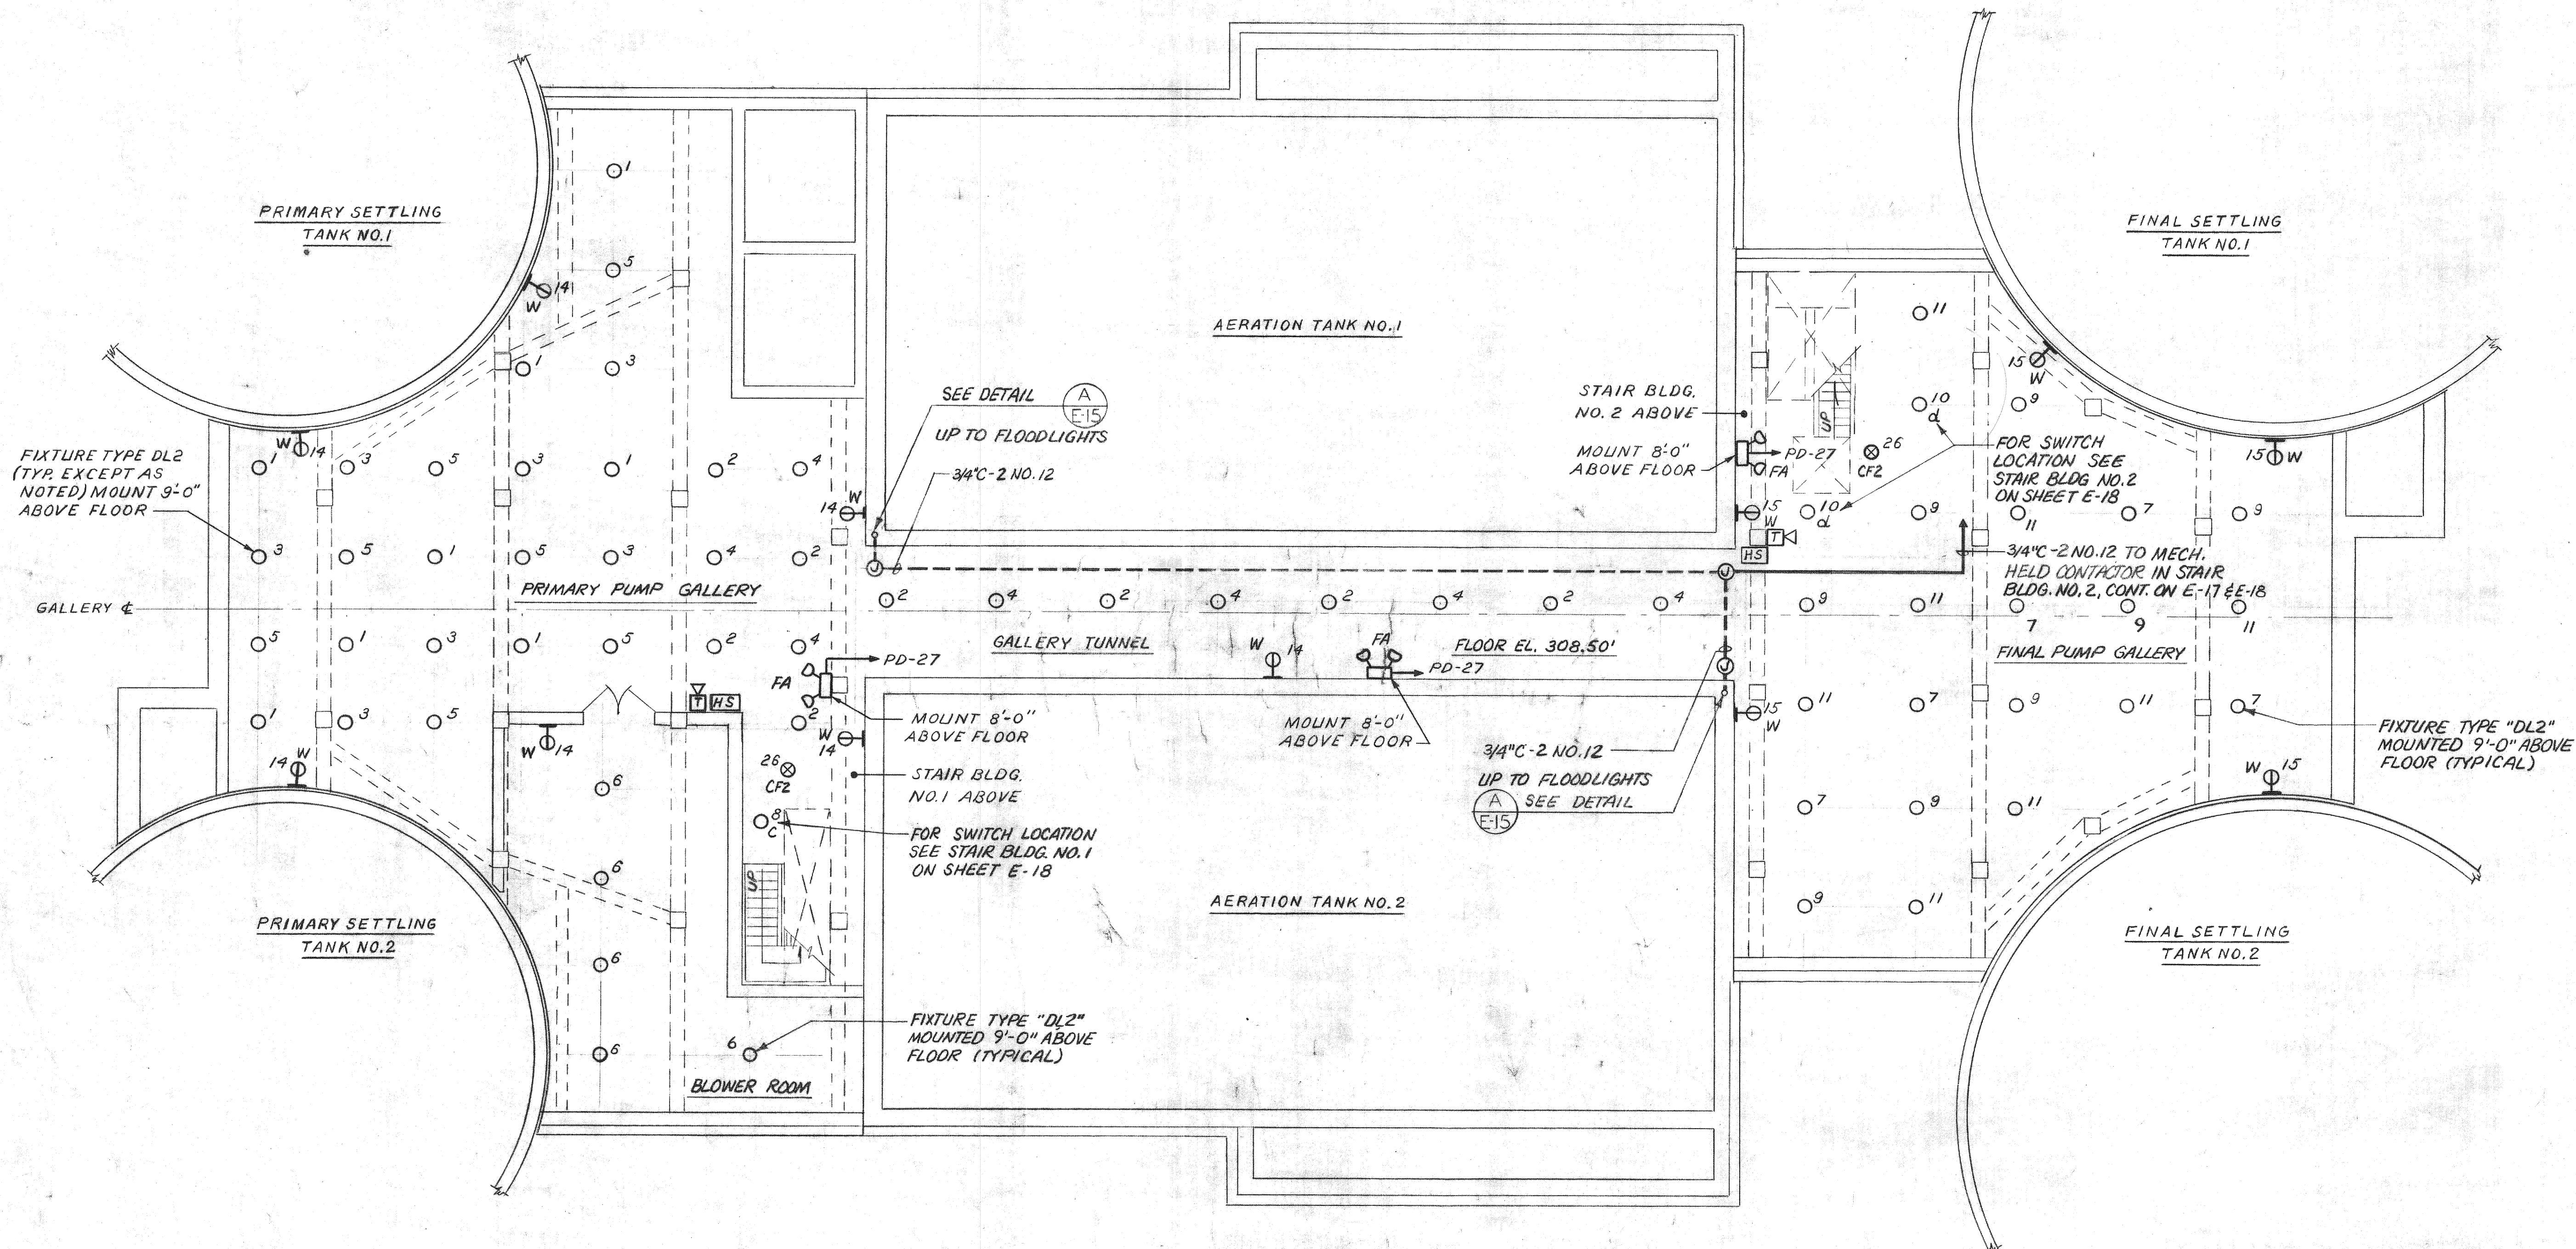

PLAN
PRIMARY & FINAL SETTLING
TANK GALLERY
SCALE: 1/8"=1'-0"



NOTES:

1. FOR SYMBOLS AND GENERAL NOTES, SEE SHEET E-1.
2. FOR POWER LOWER PLAN 1 AND 11 SEE SHEET E-15 AND E-16.
3. FOR TOP PLAN POWER AND LIGHTING SEE SHEET E-14.
4. SWITCHING OF LIGHTS IN GALLERY SHALL BE DONE IN PANELBOARD, PD, LOCATED IN MCC ROOM, IN STAIR BUILDING NO. 2. SEE SHEETS E-18 AND E-20.
5. FOR INTERROOM RISER DIAGRAM SEE SHEET E-14.
6. OUTLET, SWITCH, JUNCTION, PULL AND TERMINAL BOXES SHALL BE PROVIDED AS INDICATED ON THE EQUIPMENT ENCLOSURE SCHEDULE ON SHEET E-20.
7. FOR LIGHTING FIXTURE TYPE AND DETAILS SEE APPENDIX "B" OF THE SPECIFICATIONS, AND FIXTURE SCHEDULE ON SHEET E-1.

RECORD DRAWING

NUMBER	DATE	MADE BY	CHECKED BY	DESCRIPTION

DRAWN BY <i>B. Weather</i>
DEPT. CHECK <i>H.A. Benedetti</i>
PROJ. CHECK <i>R.J. Marshall</i>

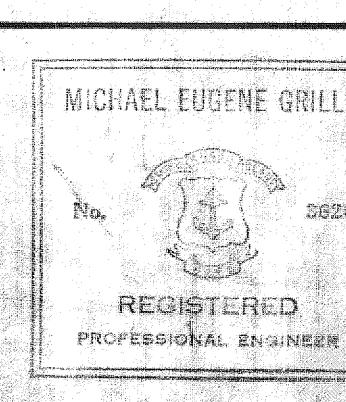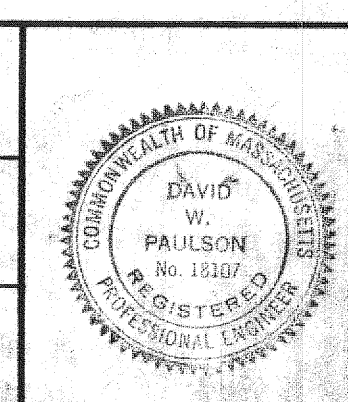

M&E METCALF & EDDY, INC. / ENGINEERS
BOSTON / NEW YORK / PALO ALTO / CHICAGO

David W. Paulson
REG. PROF. ENGR. MASS. No. 12107
DATE 6-27-77

Michael E. Grillo
REG. PROF. ENGR. MASS. No. 3020
DATE 6-27-77

SCALE:
0 8 16 24
SCALE IN FEET
SCALE: 1"=1'-0"

UNLESS OTHERWISE NOTED OR CHANGED BY REPRODUCTION

TOWN OF BURRILLVILLE, RHODE ISLAND BOARD OF SEWER COMMISSIONERS WASTEWATER TREATMENT FACILITIES AERATION AND SETTLING TANKS PUMP GALLERY LOWER PLAN - LIGHTING ELECTRICAL	JOB 4868 FILE NO. H-69056-1 SHEET E-19
---	--