


TO SHEET I-2
TO WET WELL

FROM SHEET I-4
FROM EFF PUMPS

FROM SHEET I-3
WASTE SLUDGE
FROM SHEET I-3
PRIMARY SLUDGE
PRIMARY SLUDGE
FROM SHEET I-3

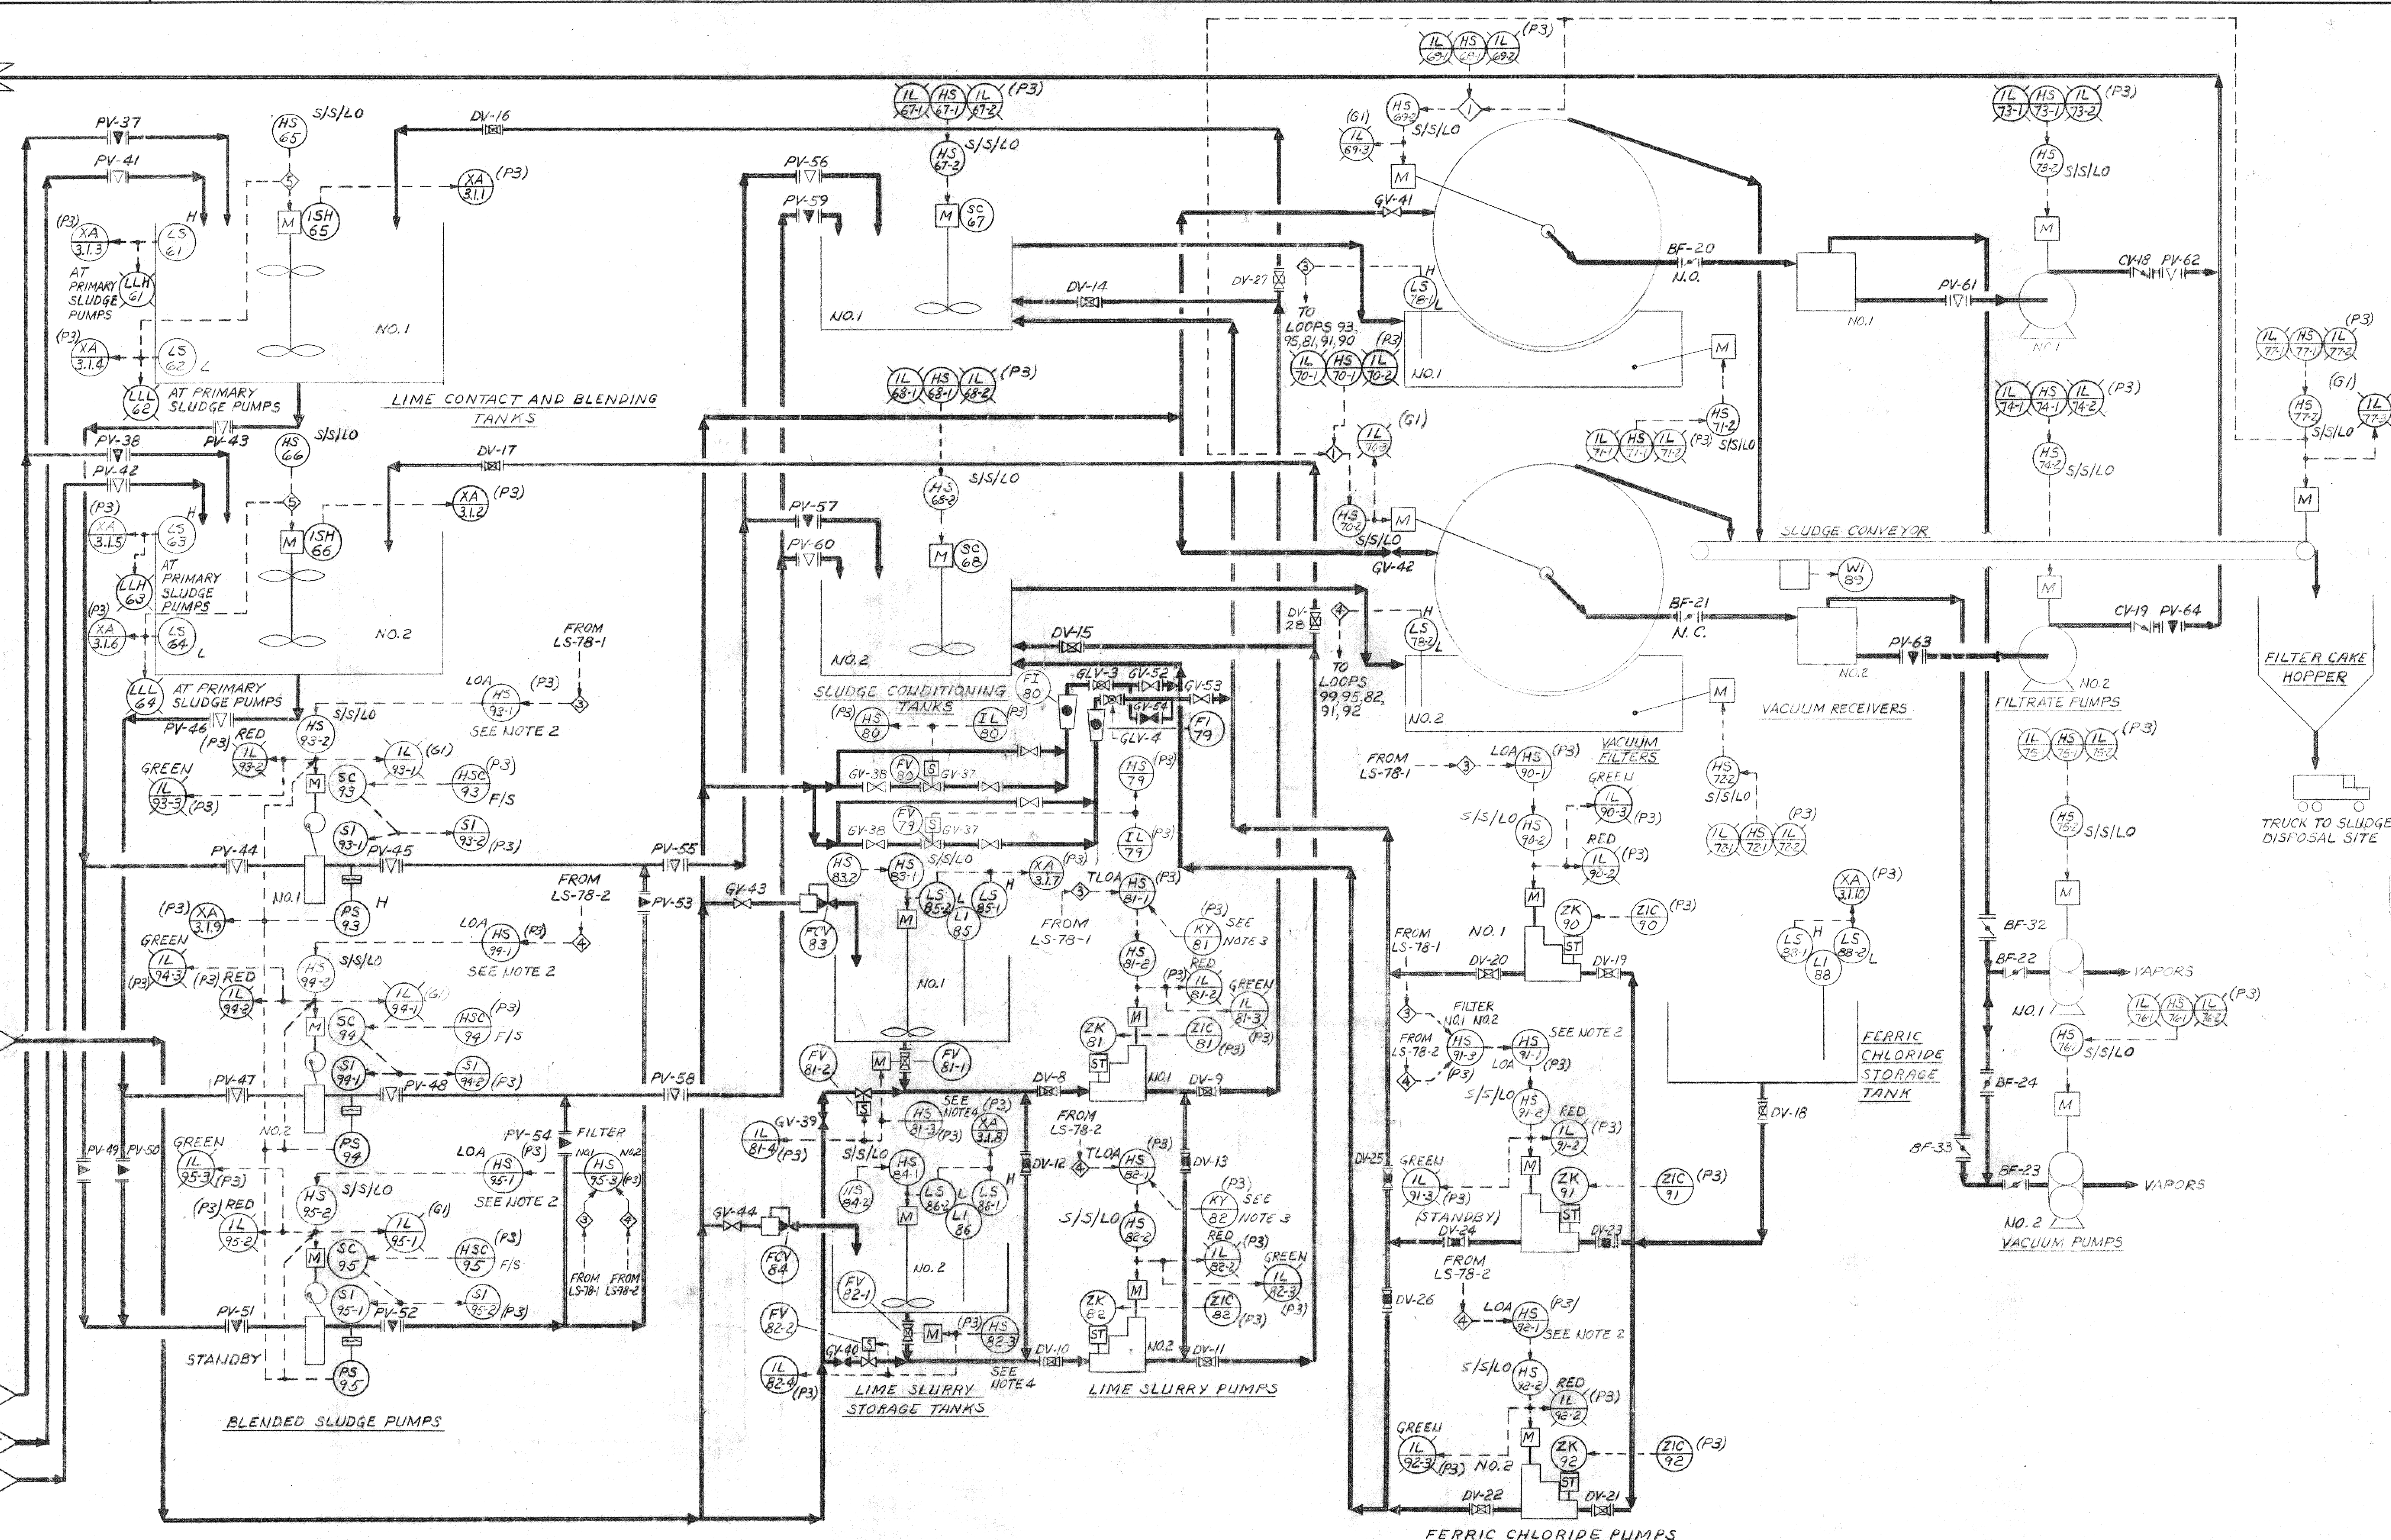

RECORD DRAWING

DRAWN BY <i>[Signature]</i>				DEPT. CHECK <i>[Signature]</i>		PROJ. CHECK <i>[Signature]</i>		REGISTERED PROFESSIONAL ENGINEER No. CS292 STATE OF CALIFORNIA		MICHAEL EUGENE GRILLI No. 3620 REGISTERED PROFESSIONAL ENGINEER STATE OF CALIFORNIA		M&E METCALF & EDDY, INC. / ENGINEERS BOSTON / NEW YORK / PALO ALTO / CHICAGO REG. PROF. ENGR. CALIF. NO. 292 REG. PROF. ENGR. R.I. NO. 3620 DATE 6/22/77 DATE 6-27-77		SCALE: NONE		TOWN OF BURRILLVILLE, RHODE ISLAND BOARD OF SEWER COMMISSIONERS WASTEWATER TREATMENT FACILITIES PROCESS & INSTRUMENTATION DIAGRAM INSTRUMENTATION		JOB: 4863 FILE NO. H-69044-1 SHEET 1-5	
NUMBER	DATE	MADE BY	CHECKED BY	REVISIONS		DESCRIPTION													