


BASEMENT PLAN


# RECORD DRAWING

NUMBER	DATE	MADE BY	CHECKED BY	DESCRIPTION
11-29-77	D.B.	R.L. Collet		ADDED 3/4" EFW

DRAWN BY  
DEPT. CHECK  
PROJ. CHECK

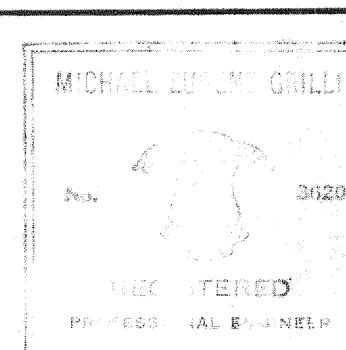

**M&E** METCALF & EDDY, INC. / ENGINEERS  
BOSTON / NEW YORK / PALO ALTO / CHICAGO  
REG. PROF. ENGR. MASS. NO. 6681  
REG. PROF. ENGR. R.I. NO. 3620

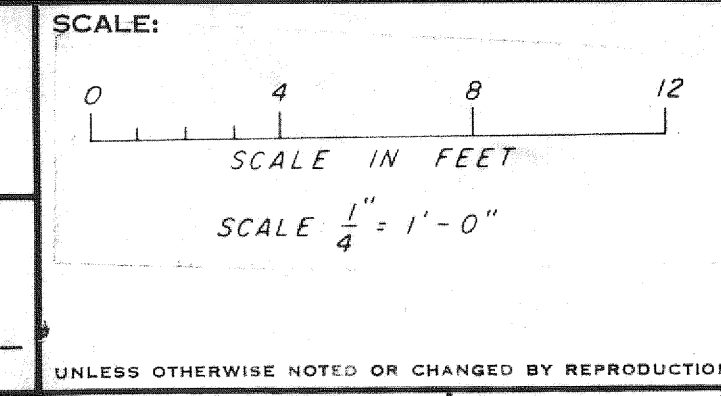

TOWN OF BURRILLVILLE, RHODE ISLAND  
BOARD OF SEWER COMMISSIONERS  
WASTEWATER TREATMENT FACILITIES  
OPERATIONS BUILDING - BASEMENT PLAN  
MECHANICAL

JOB 11868  
FILE NO. H-69944-1  
SHEET M-2