



- NOTES:
1. PROVIDE MECHANICAL JOINTS AT 2'-0" INTERVALS AS INDICATED TO ALLOW FOR DIFFERENTIAL SETTLEMENT BETWEEN TANKS AND GALLERY.
  2. 2'-0" BELOW AND ABOVE PIPE WITH SCREENED GRAVEL.

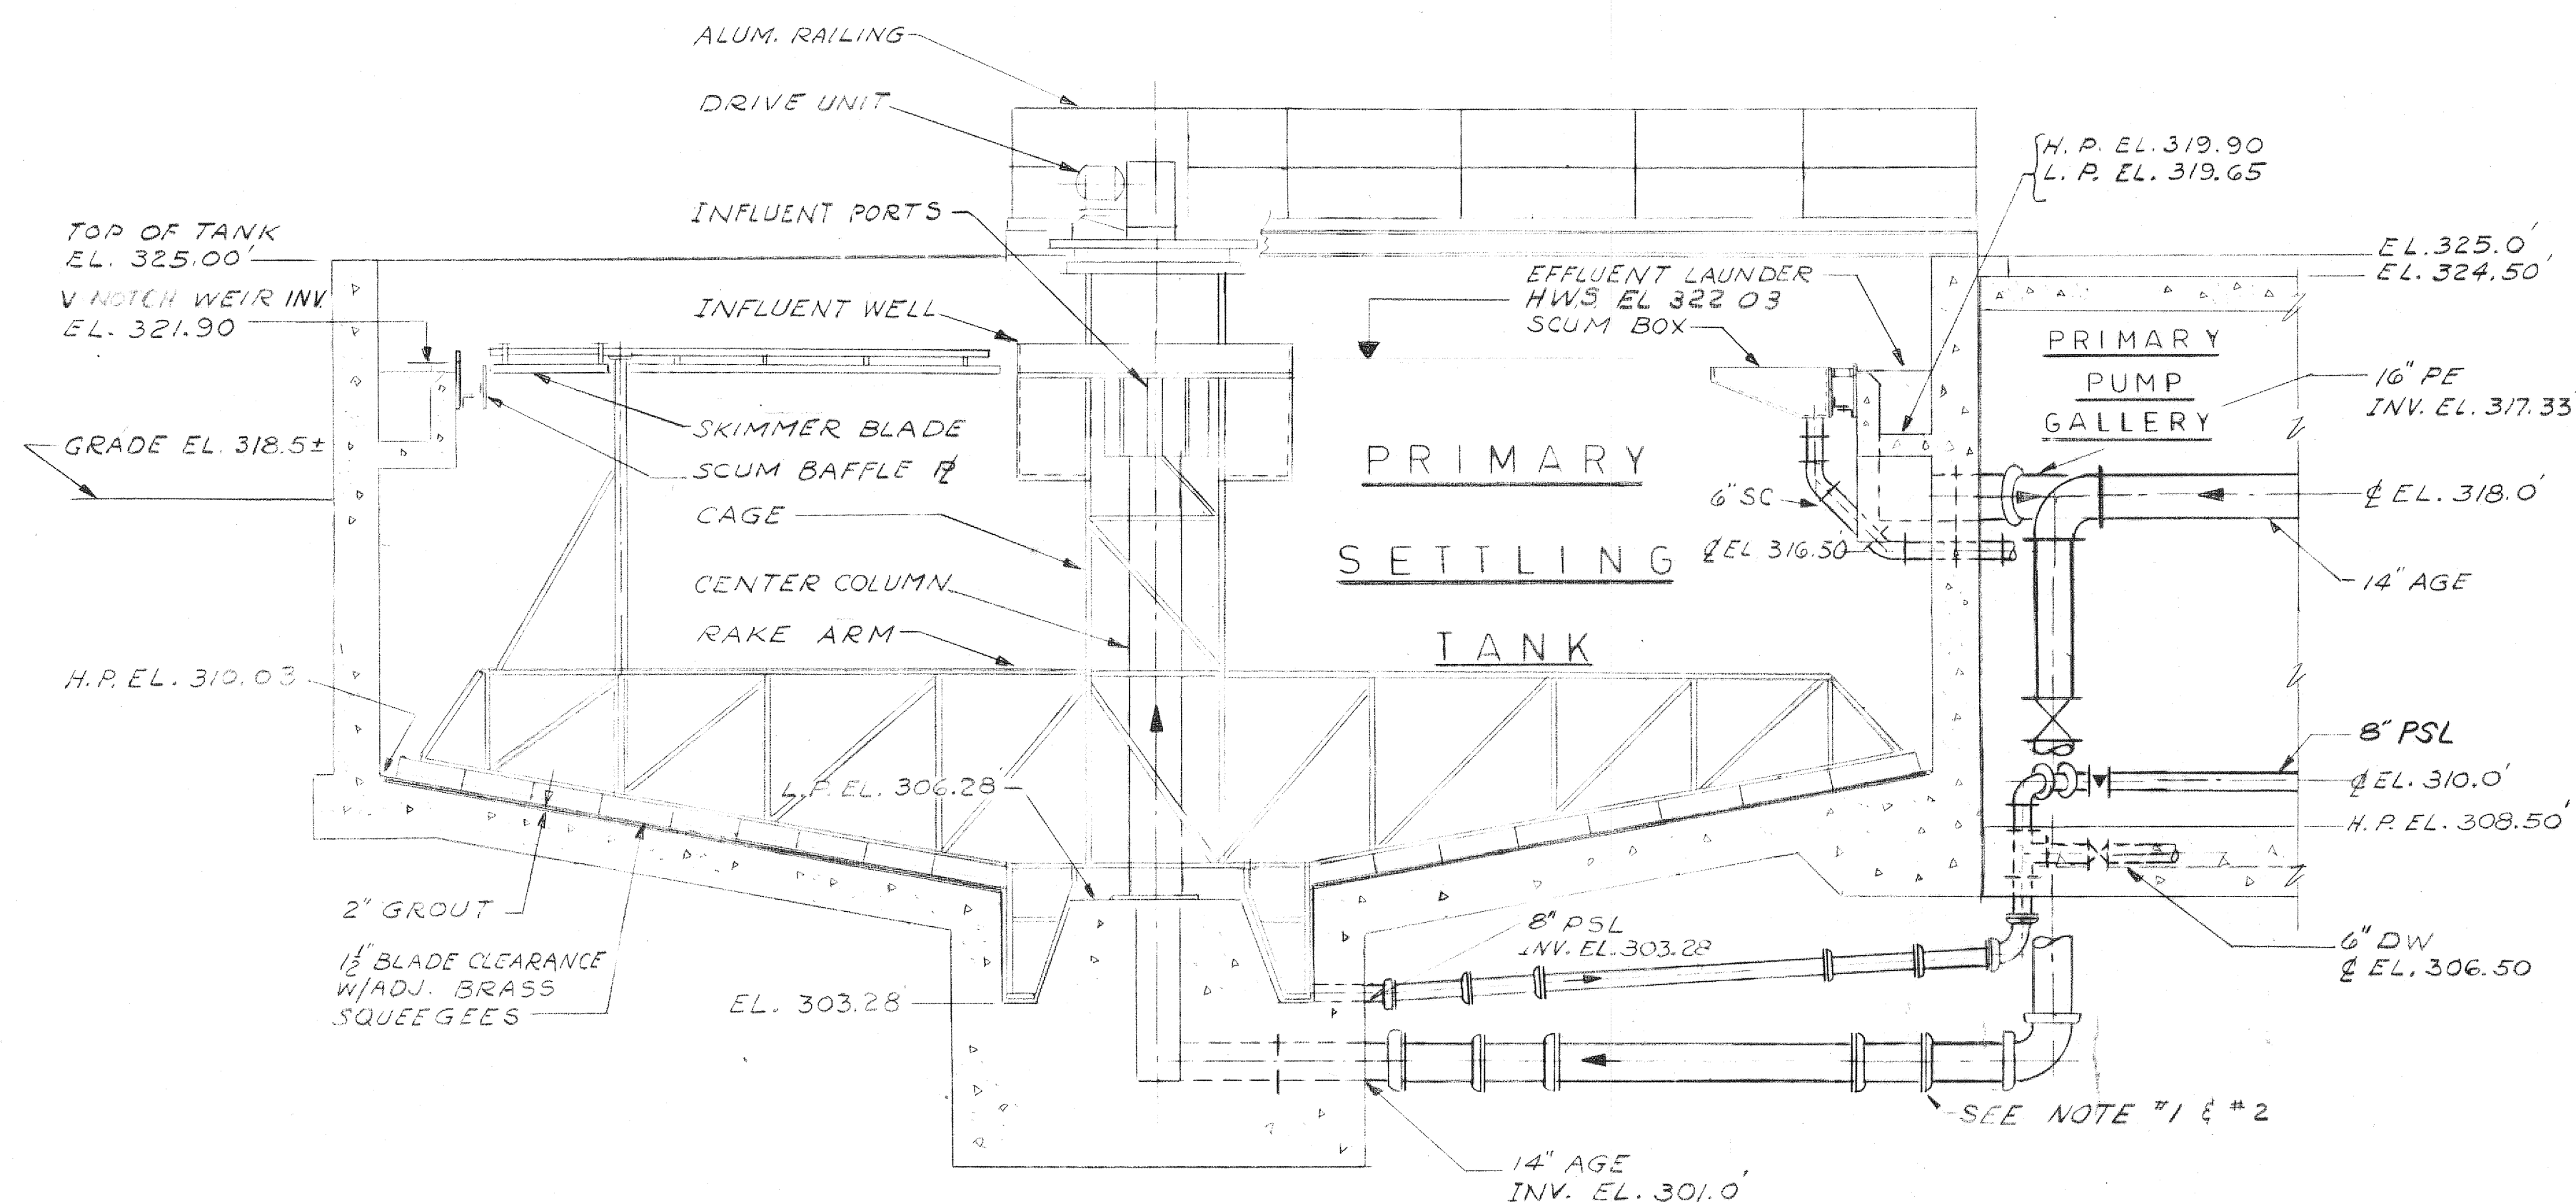

SECTION 1  
M10

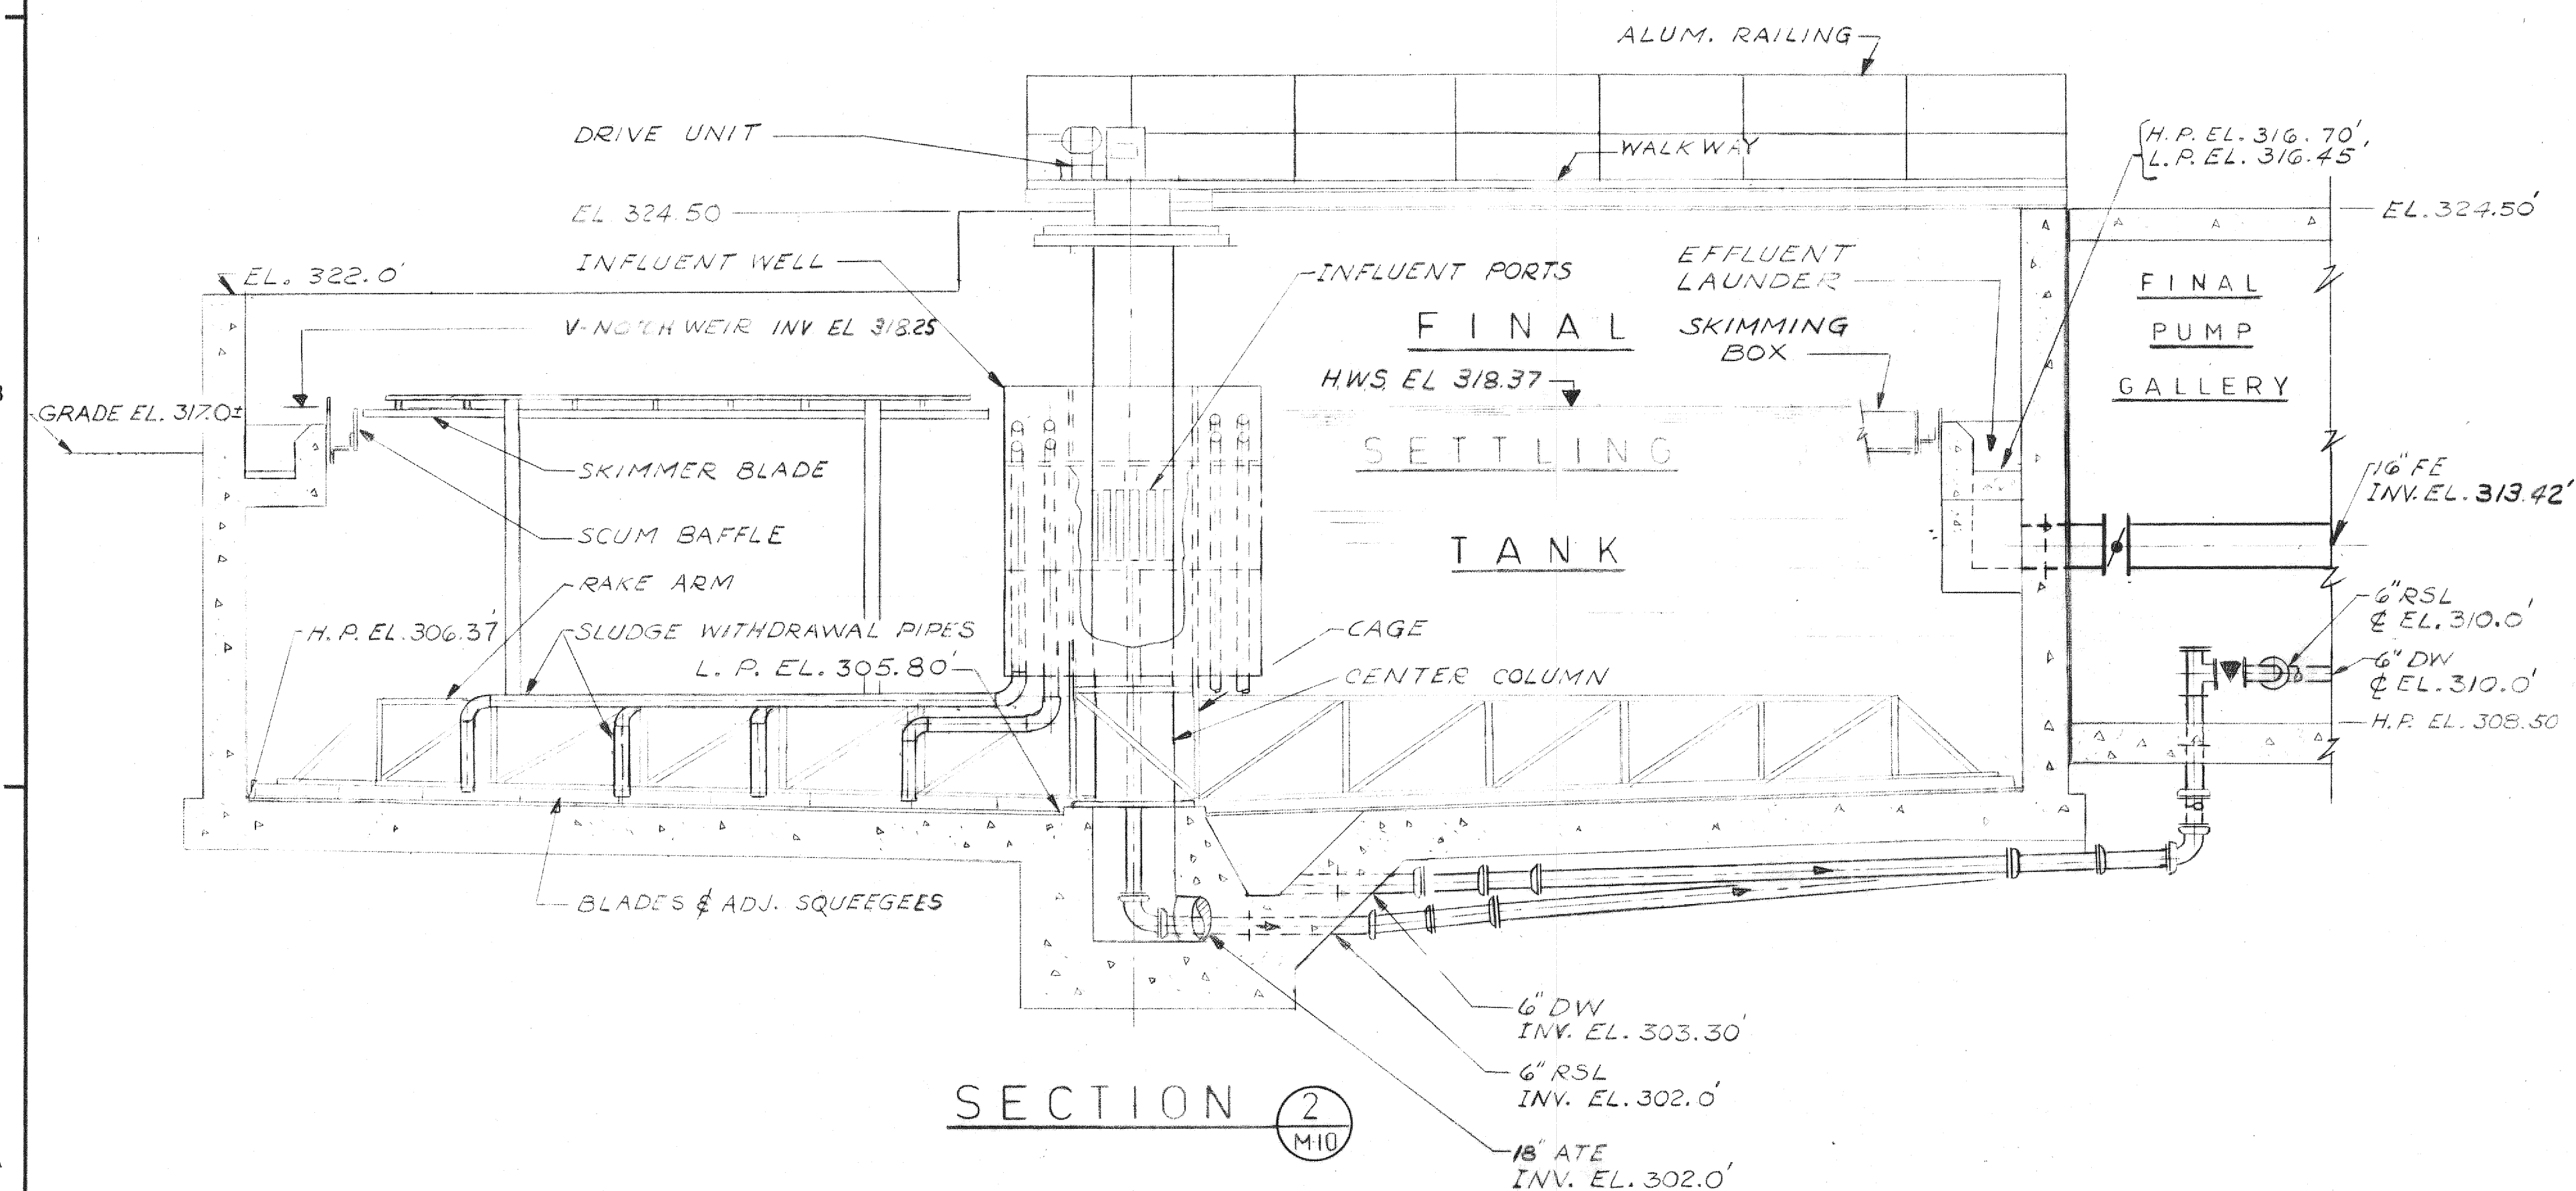


SECTION 2  
M10

## RECORD DRAWING

NUMBER	DATE	MADE BY	CHECKED BY	DESCRIPTION


DRAWN BY <i>J. F. Dineen</i>
DEPT. CHECK <i>Wayne M. Rellin</i>
PROJ. CHECK <i>R. J. Marshall</i>

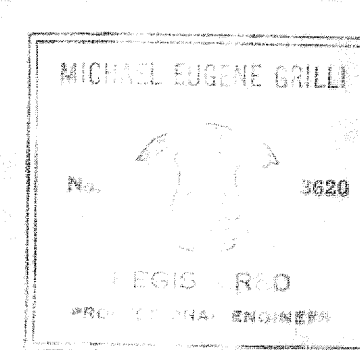

**M&E** METCALF & EDDY, INC. / ENGINEERS  
BOSTON / NEW YORK / PALO ALTO / CHICAGO

*Lawrence E. Tarkenton* 6/13/77  
REG. PROF. ENGR. 1465, 12, 9681 DATE

*Michael E. Tarkenton* 6-27-77  
REG. PROF. ENGR. R.I. NO. 3620 DATE

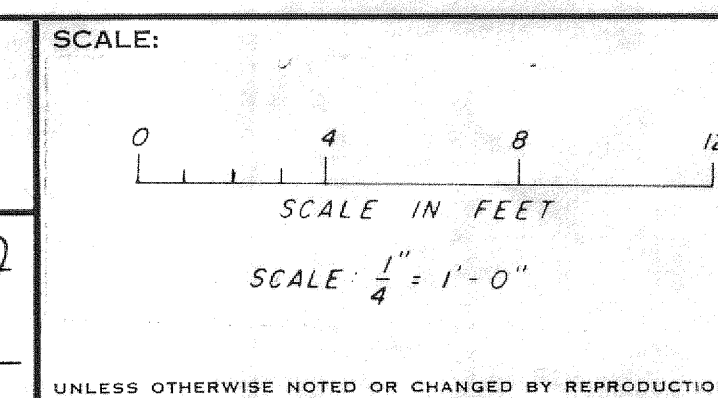

TOWN OF BURRILLVILLE, RHODE ISLAND  
BOARD OF SEWER COMMISSIONERS

WASTEWATER TREATMENT FACILITIES  
SETTLING TANKS - SECTIONS

MECHANICAL

JOB	4868
FILE NO.	H-69022-1
SHEET	M-13