


**SANITARY, WASTE, VENT & ACID RESISTANT  
WASTE & VENT RISER DIAGRAM**  
NO SCALE

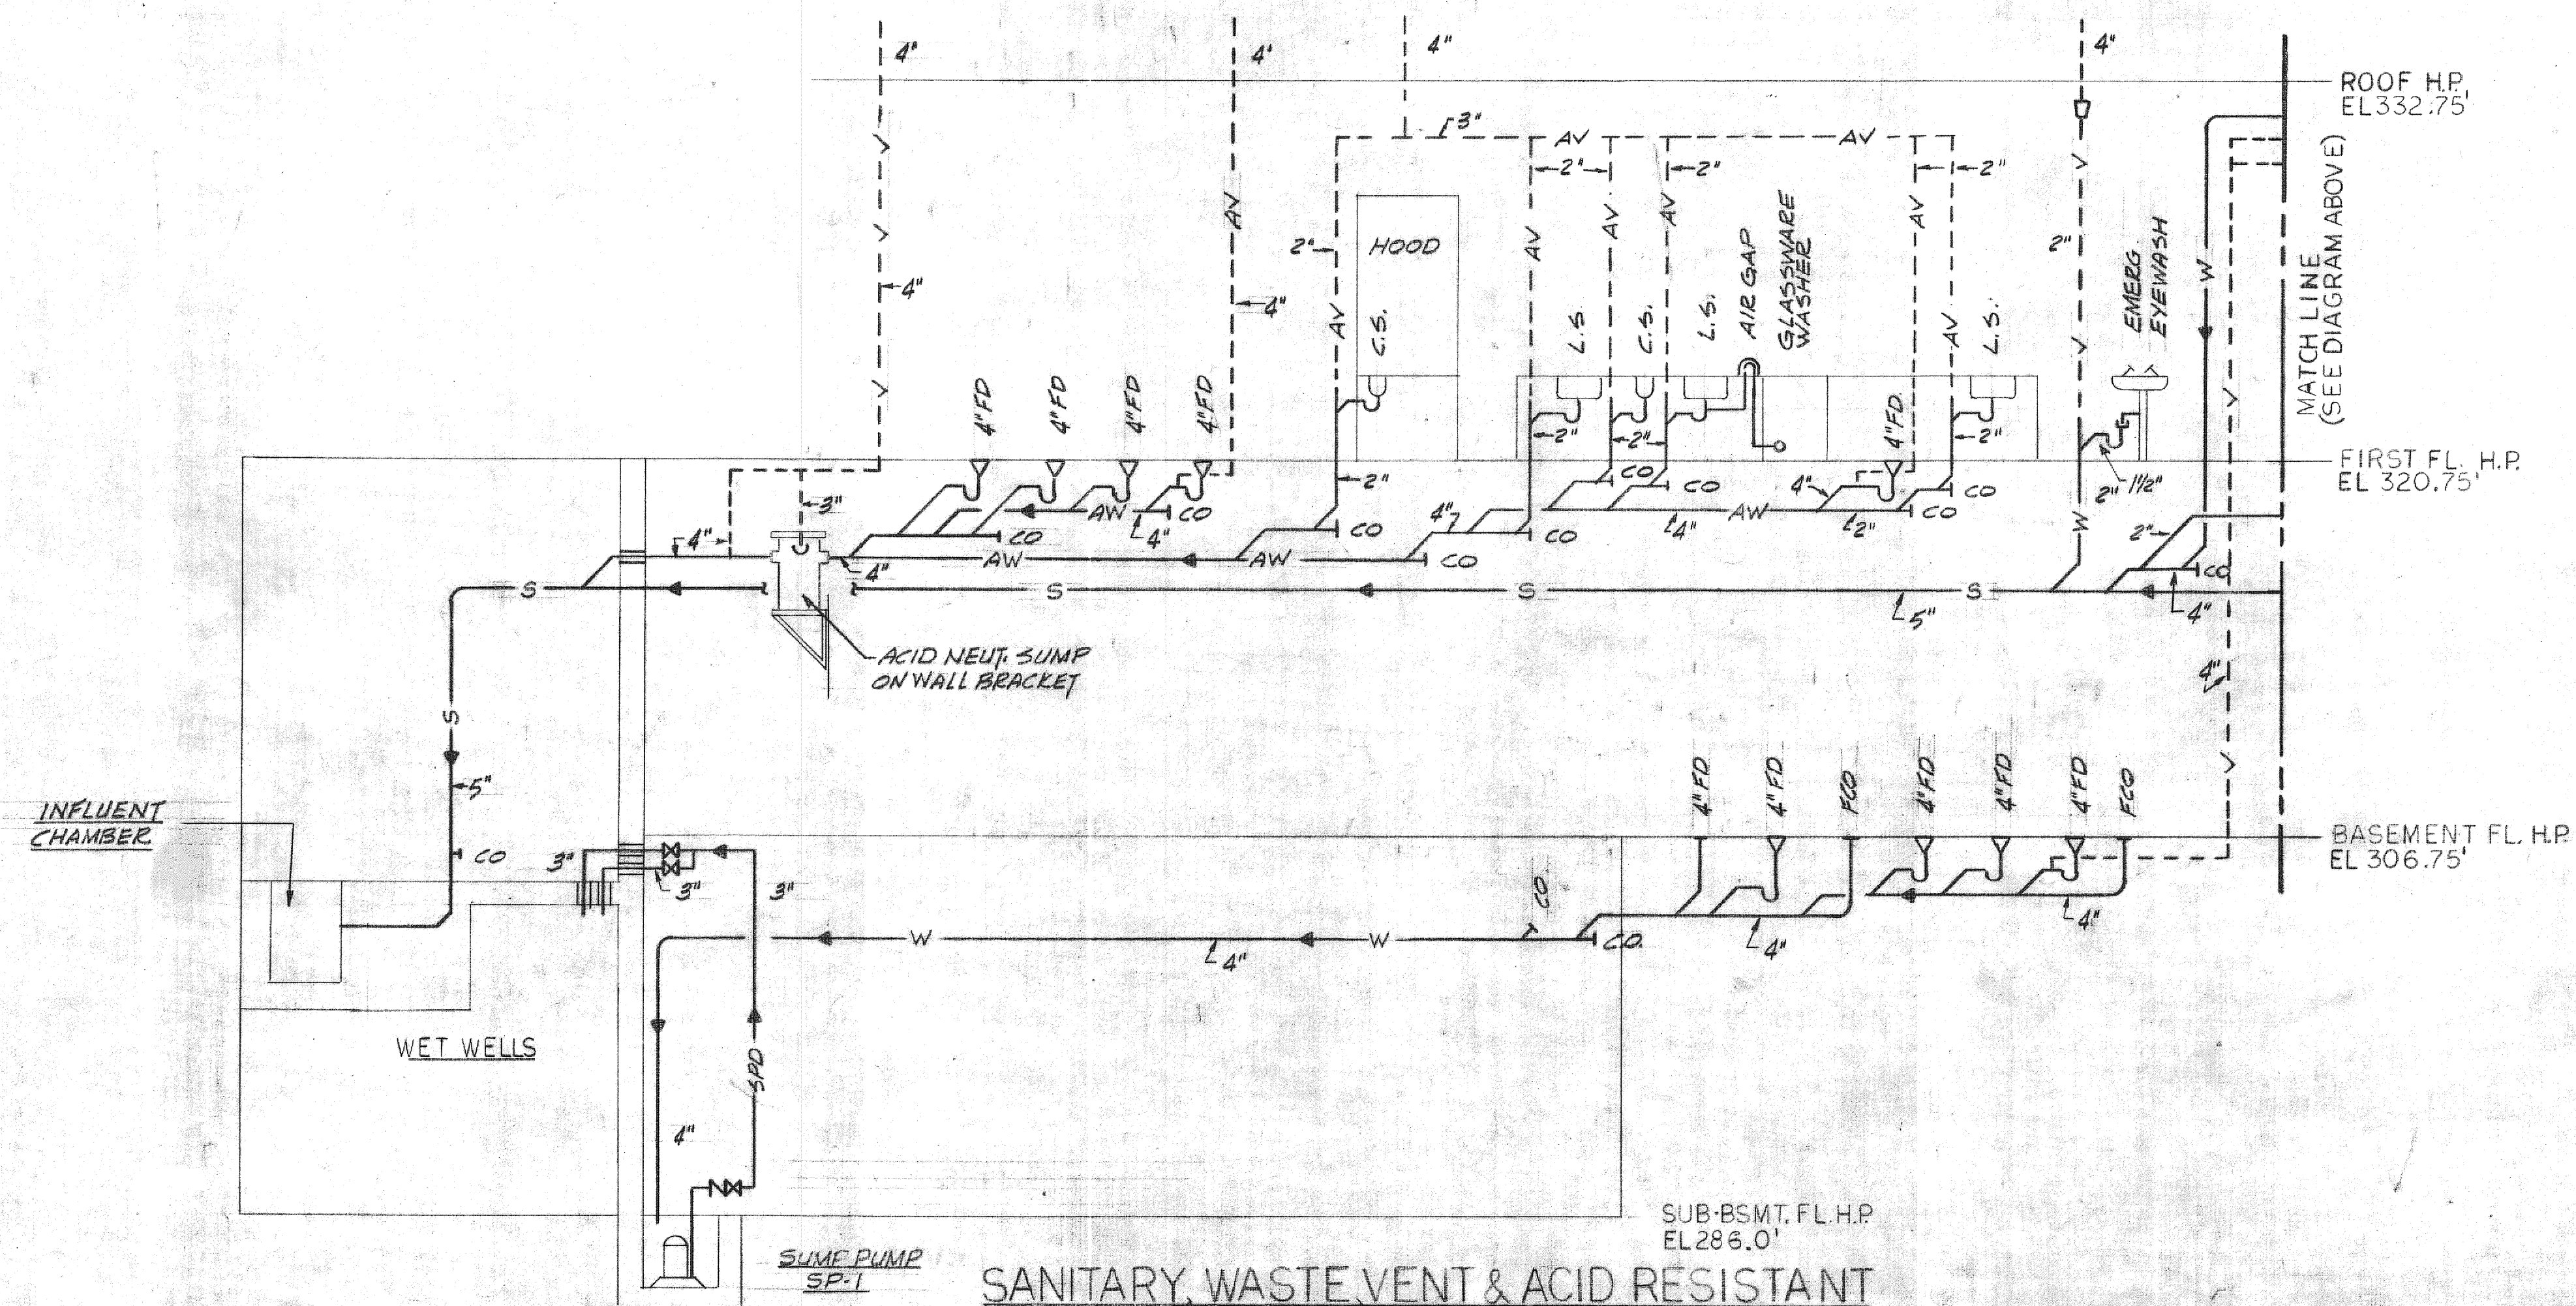

**SANITARY, WASTE, VENT & ACID RESISTANT  
WASTE & VENT RISER DIAGRAM**  
NO SCALE

## RECORD DRAWING

NUMBER	DATE	MADE BY	CHECKED BY	DESCRIPTION

DRAWN BY  
*R. J. Marshall*  
DEPT. CHECK  
*R. J. Marshall*  
PROJ. CHECK  
*R. J. Marshall*



**M&E** METCALF & EDDY, INC. / ENGINEERS  
BOSTON / NEW YORK / PALO ALTO / CHICAGO  
Michael E. Grilli  
REG. PROF. ENGR. NO. 3620

SCALE:  
NONE  
DATE  
6-27-77  
DATE  
6-27-77

UNLESS OTHERWISE NOTED OR CHANGED BY REPRODUCTION

TOWN OF BURRILLVILLE, RHODE ISLAND  
BOARD OF SEWER COMMISSIONERS  
WASTEWATER TREATMENT FACILITIES  
RISER DIAGRAM I  
H.V.A.C. & PLUMBING

JOB 4868  
FILE NO. H-69034-1  
SHEET M-25