


SECTION 2
M-2, M-3, M-4

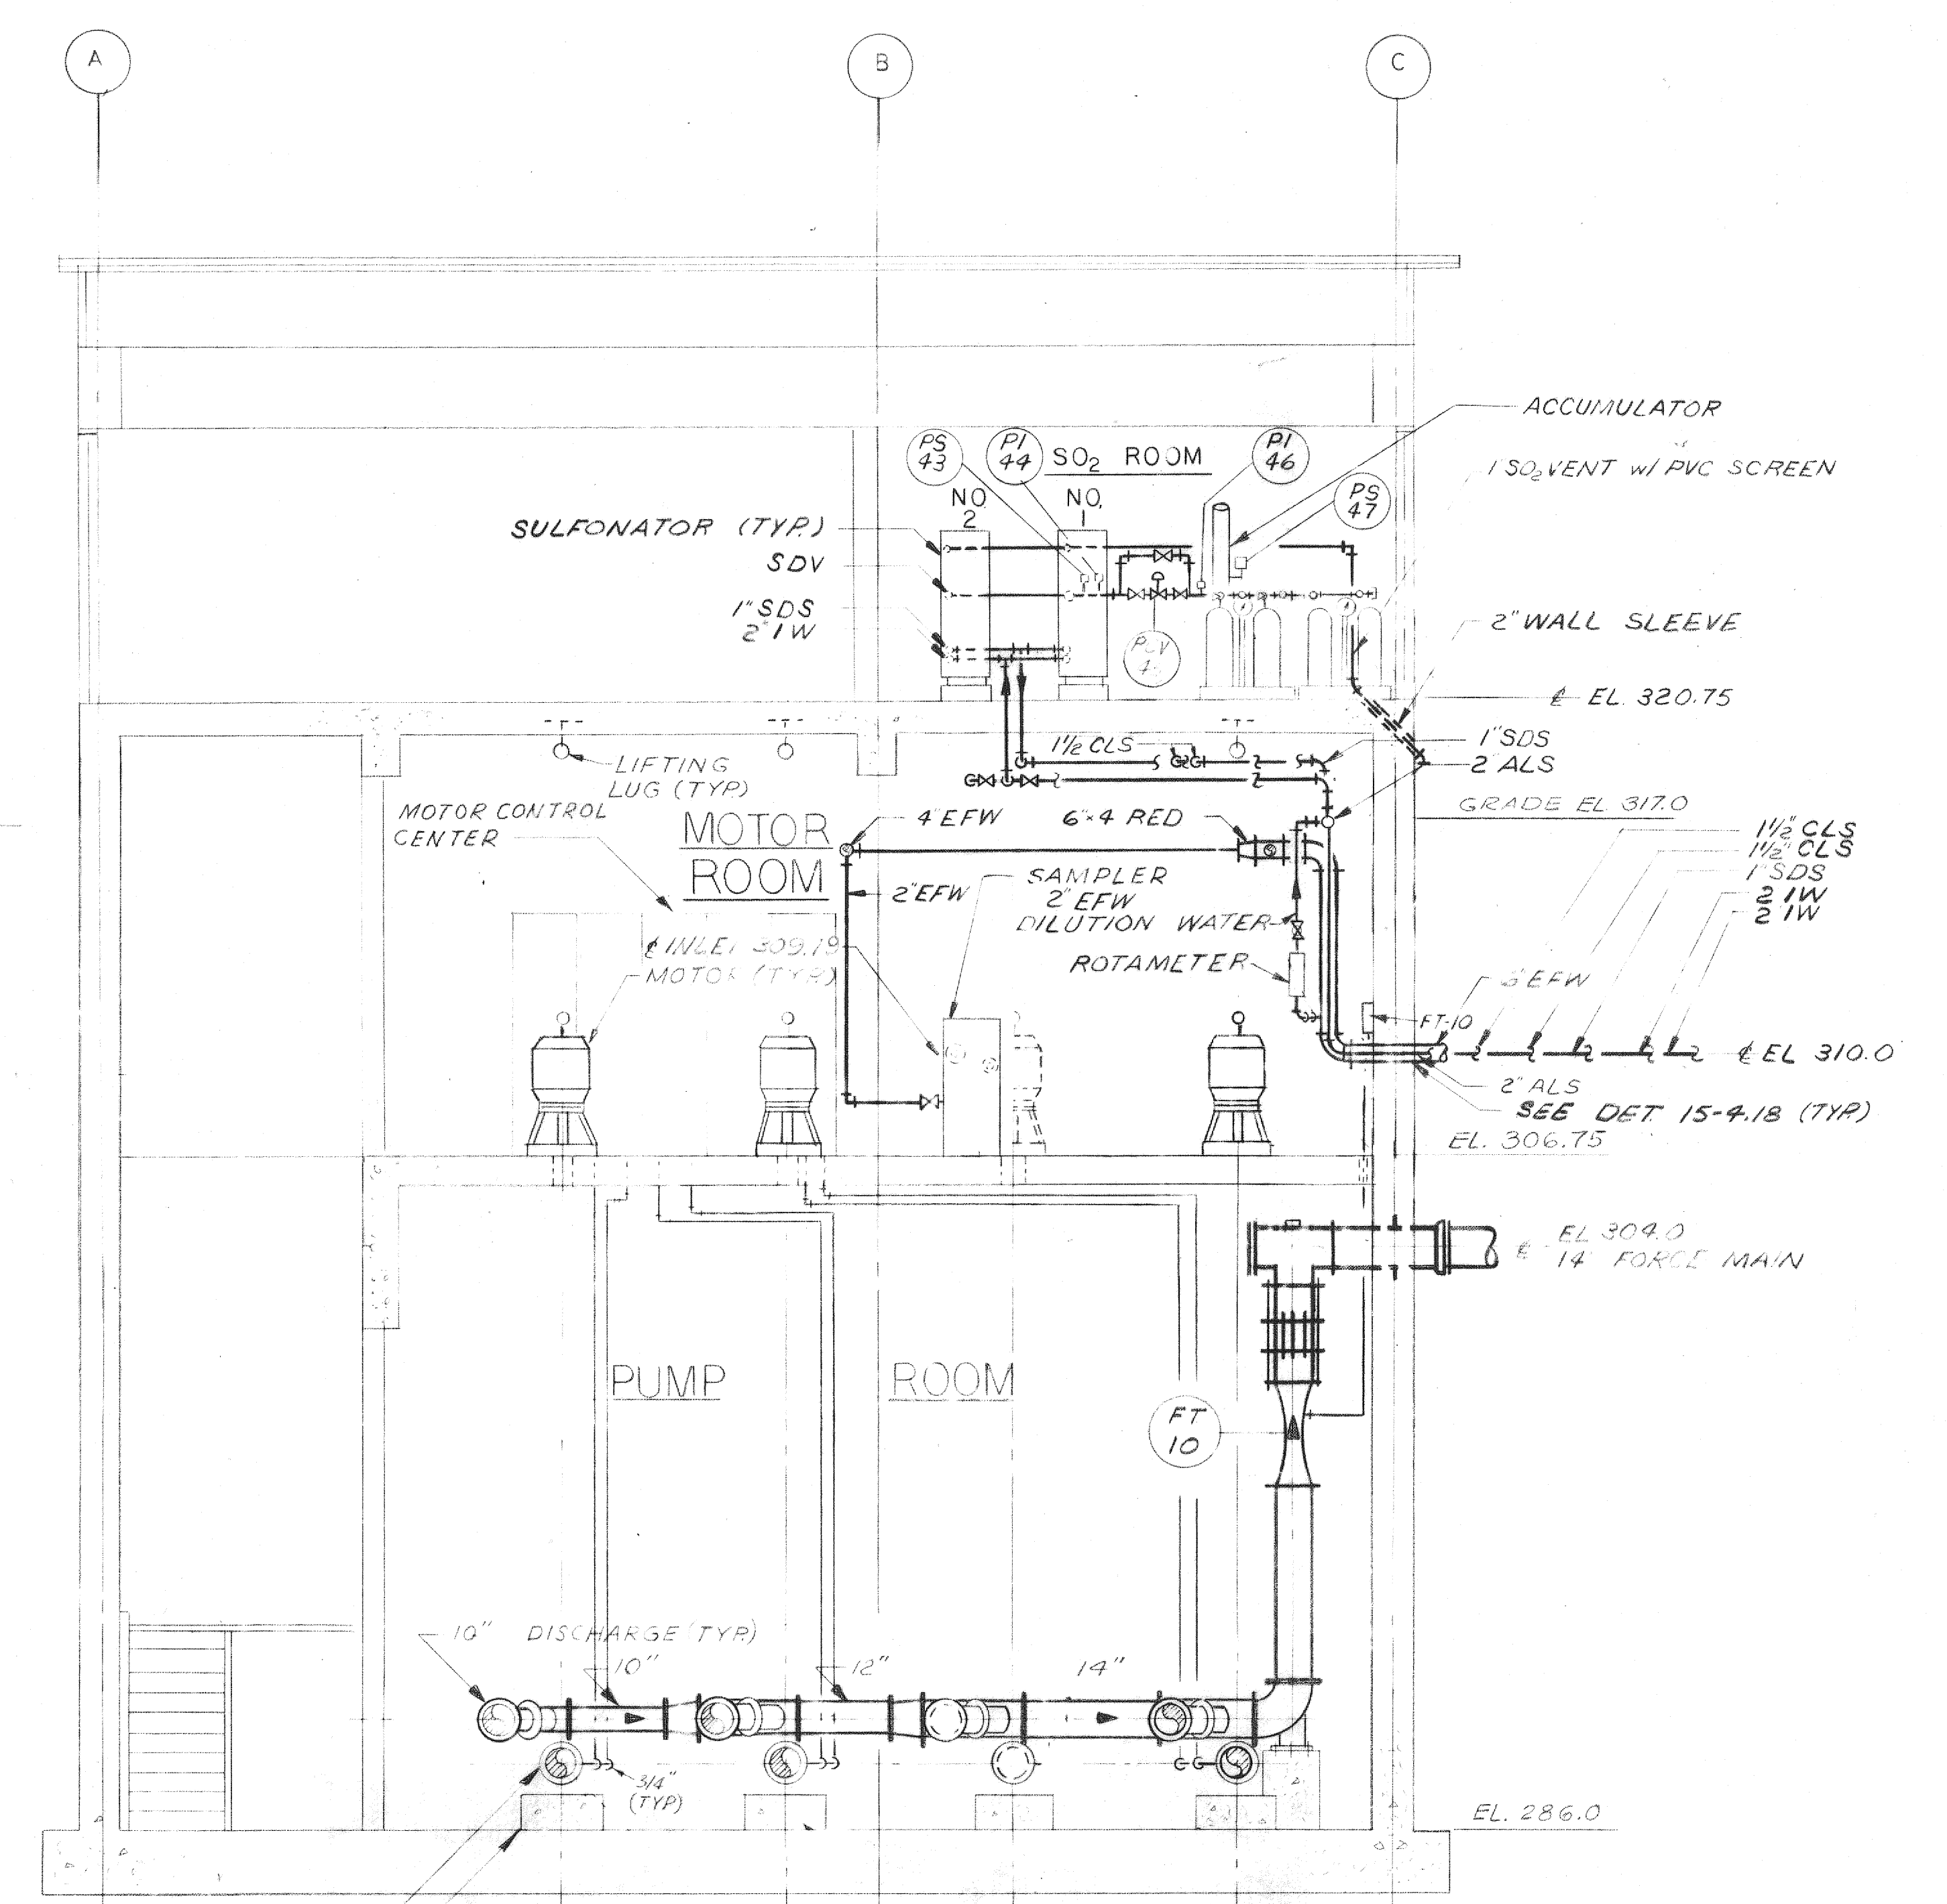

SECTION 3
M-2, M-3, M-4

NOTES:
1. FOR CONTINUATION OF PIPING SEE SHEET C-4.

RECORD DRAWING

DRAWN BY Eric S. Sourris DEPT. CHECK PROJ. CHECK R. J. Marshall					M&E METCALF & EDDY, INC. / ENGINEERS BOSTON / NEW YORK / PALO ALTO / CHICAGO REG. PROF. ENGR. M.F.S. NO. 5611 REG. PROF. ENGR. R.I. NO. 3620		SCALE: 0 4 8 12 SCALE IN FEET SCALE 1" = 1'-0"		TOWN OF BURRILLVILLE, RHODE ISLAND BOARD OF SEWER COMMISSIONERS WASTEWATER TREATMENT FACILITIES OPERATIONS BUILDING - SECTIONS II MECHANICAL		JOB NO. 8800 FILE NO. H-59C17-1- SHEET 14-2	
NUMBER	DATE	MADE BY	CHECKED BY	REVISIONS	DESCRIPTION							