



PLAN

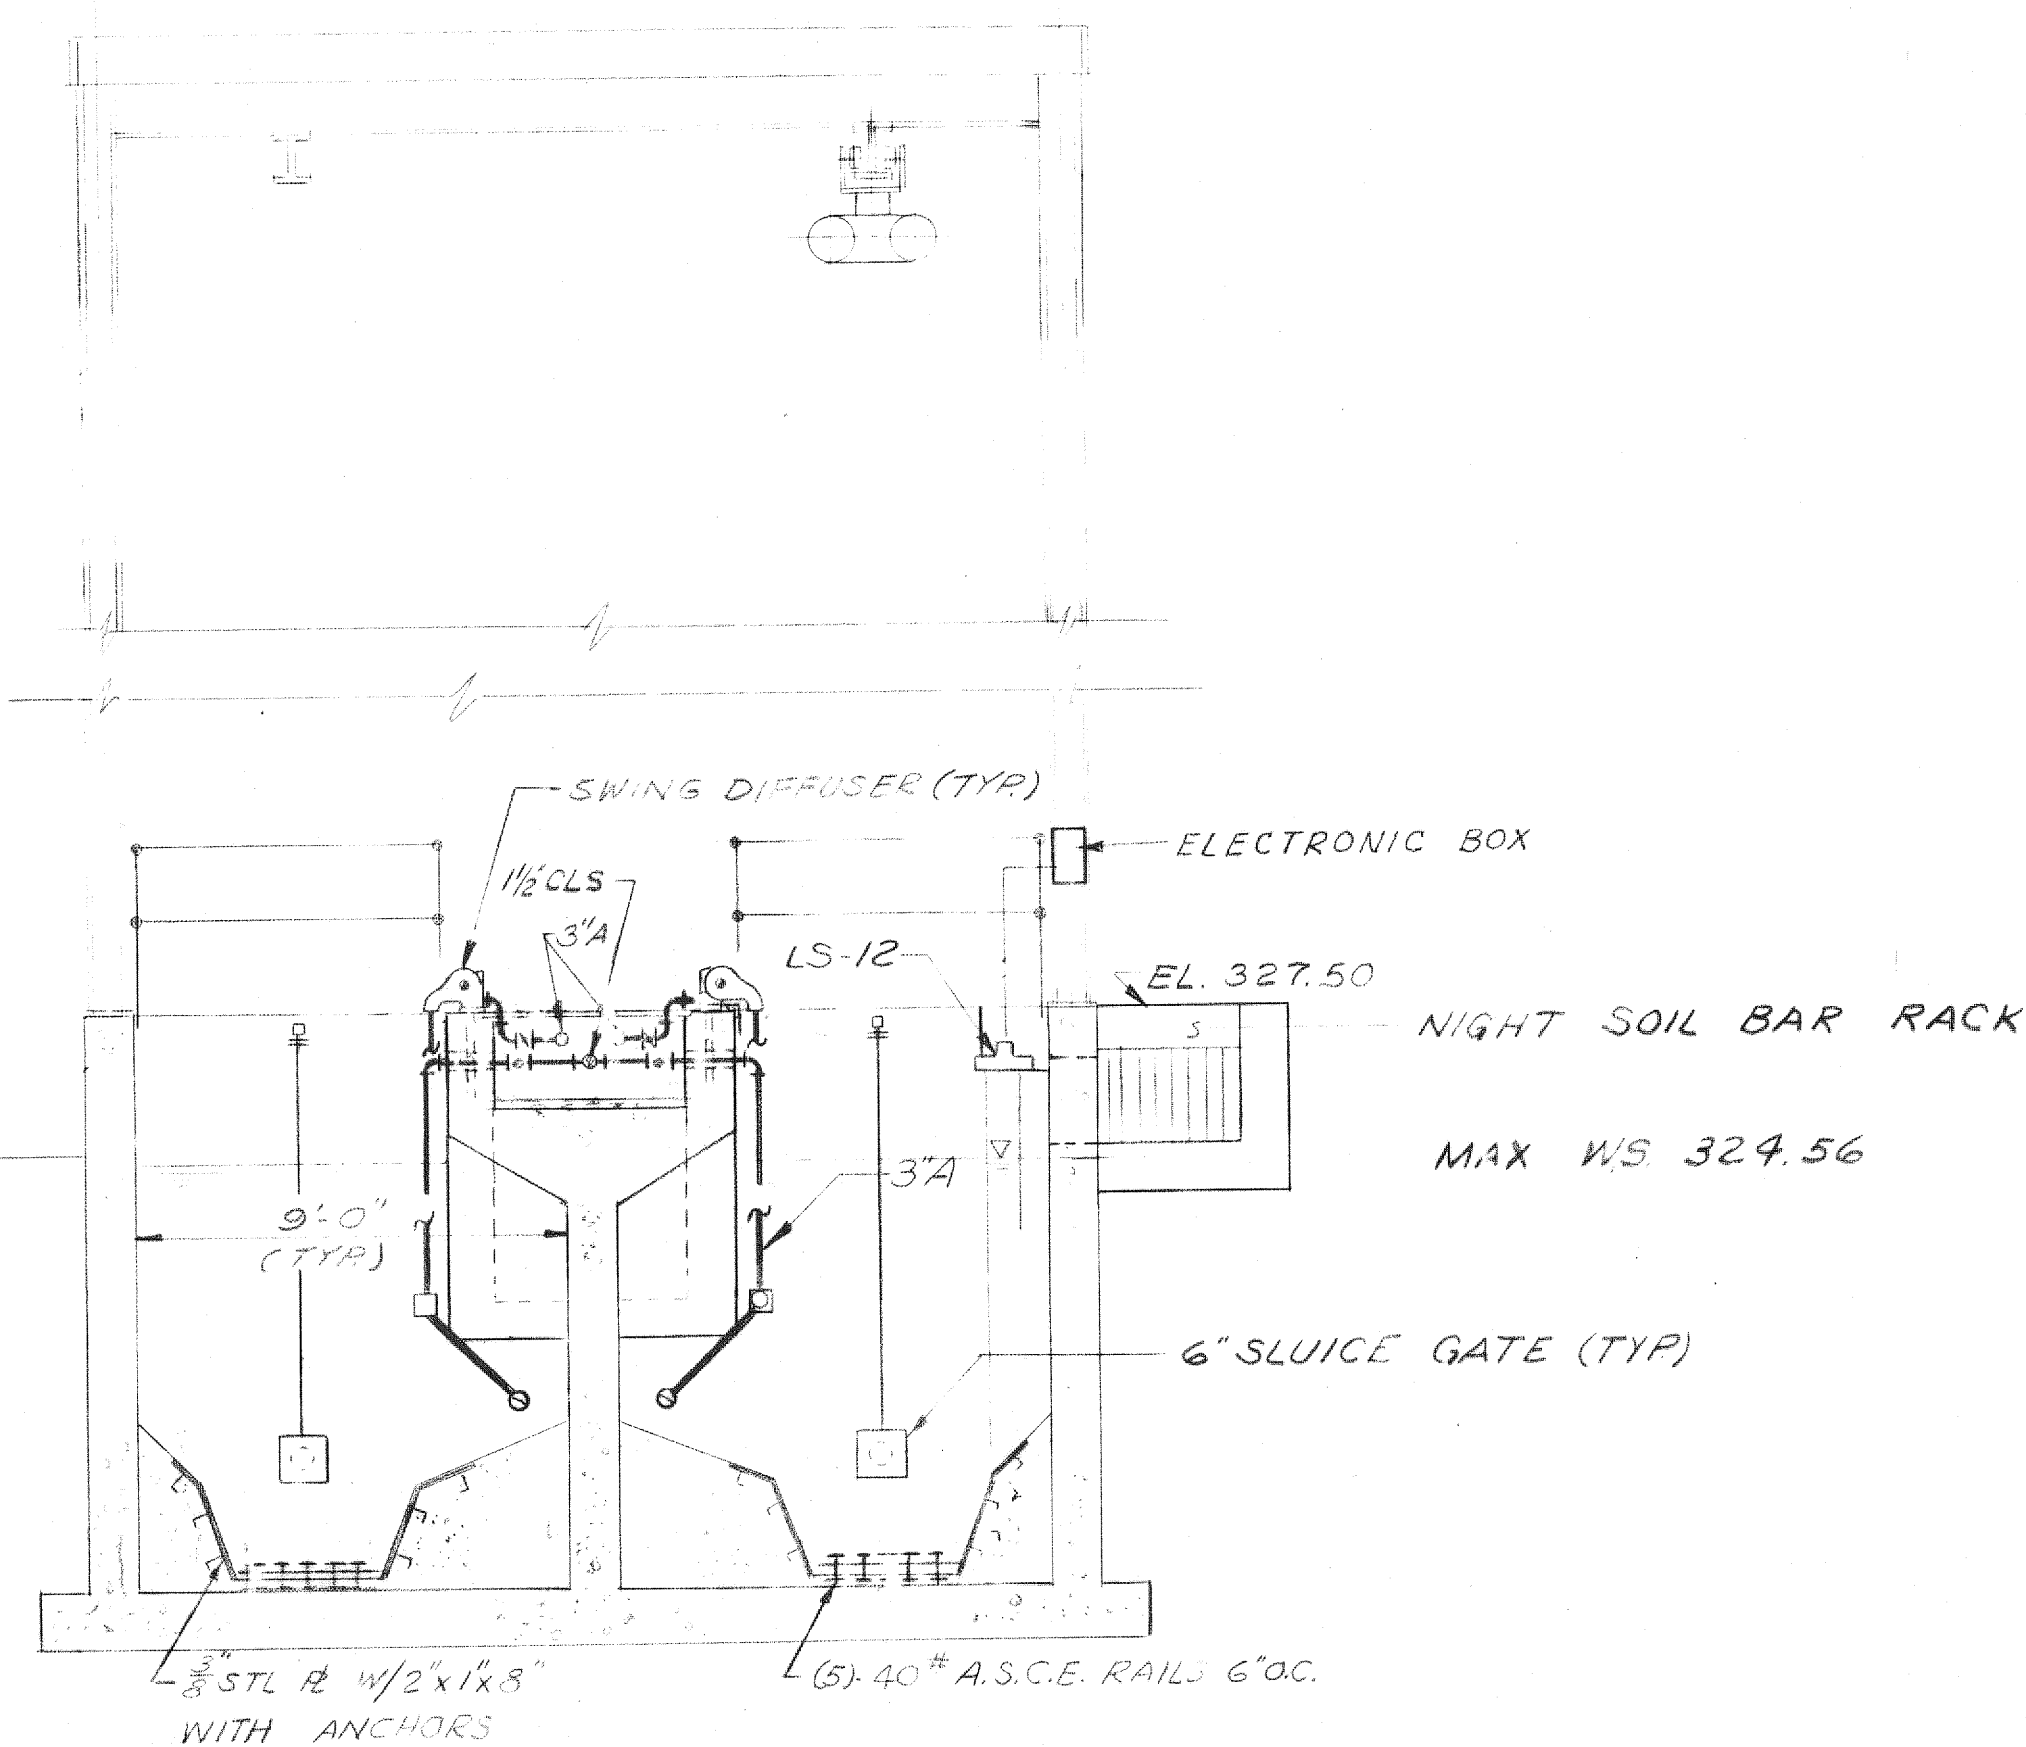

SECTION 2

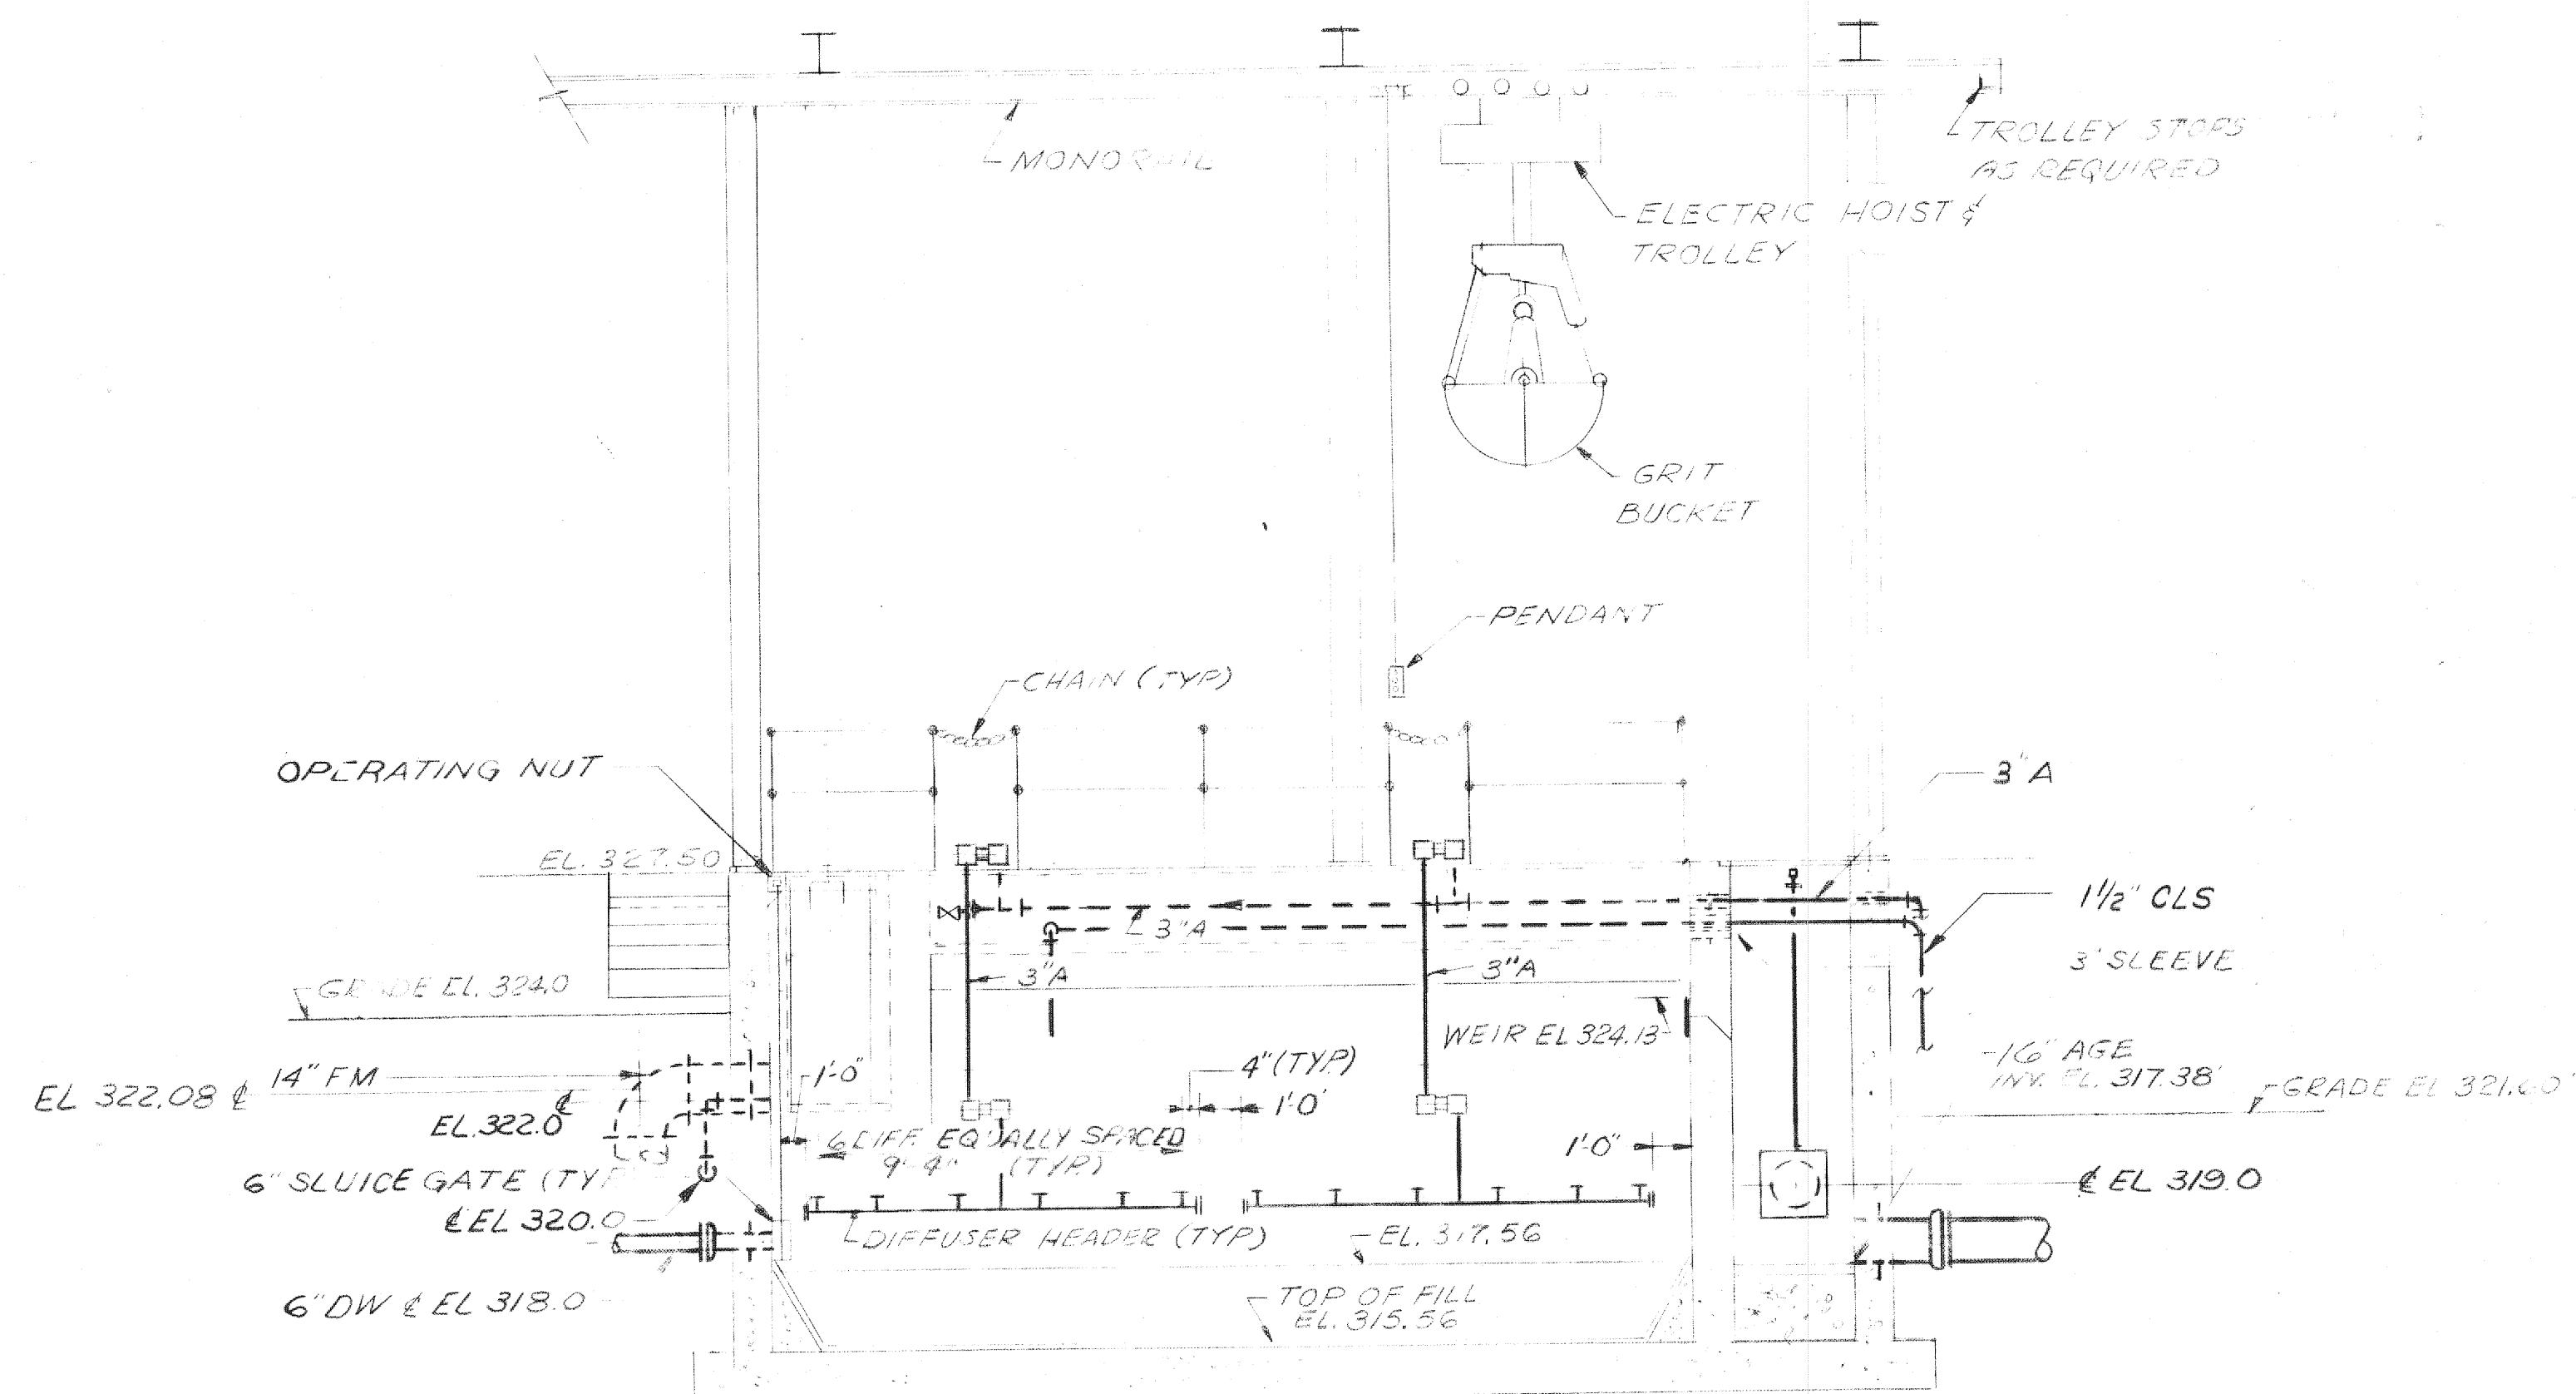

SECTION 1

- NOTES:
1. FOR CONTINUATION OF PIPING SEE SHEET C-4.
  2. AIR DIFFUSERS SHALL HAVE A CAPACITY OF 8.5 SCFM EA. WITH A MAXIMUM HEAD LOSS OF 13-IN. OF WATER.


# RECORD DRAWING

NUMBER	DATE	MADE BY	CHECKED BY	DESCRIPTION

DRAWN BY  
M. J. JONES

DEPT. CHECK  
Wayne M. Rollins

PROJ. CHECK  
R. J. Marshall

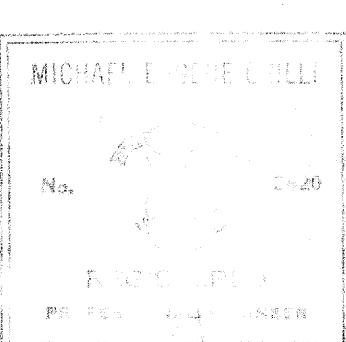


**M&E** METCALF & EDDY, INC. / ENGINEERS  
BOSTON NEW YORK PALO ALTO CHICAGO

Lawrence E. Tash  
REG. PROF. ENGR. MASS. NO. 6481

Michael E. Eddy  
REG. PROF. ENGR. R.I. NO. 4863

6/23/77  
DATE

6-27-77  
DATE

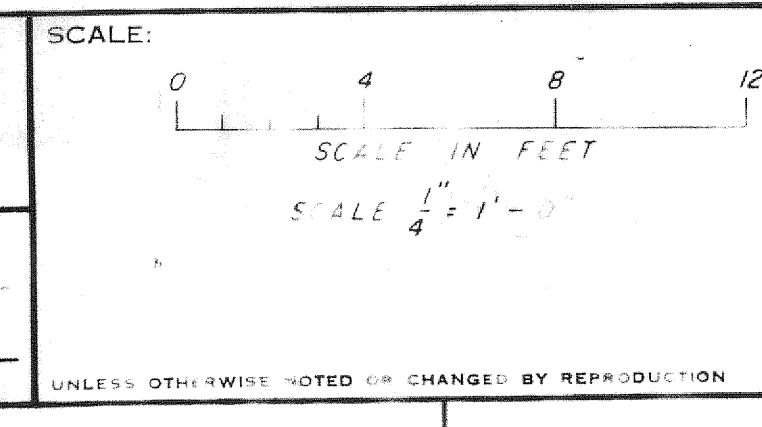

TOWN OF BURRILLVILLE, RHODE ISLAND BOARD OF SEWER COMMISSIONERS	JOB 4863
WASTEWATER TREATMENT FACILITIES	FILE NO. H-69027-1
GRIT CHAMBER - PLAN AND SECTIONS	SHEET M-18
MECHANICAL	