

- NOTES:
1. INTERIOR WALLS AND FLOOR PENETRATIONS SHALL BE CAULKED GAS TIGHT.
 2. FOR CONTINUATION OF PIPING SEE SHEET C-4.


RECORD DRAWING

NUMBER	DATE	MADE BY	CHECKED BY	REVISIONS	DESCRIPTION
1	11-29-77	D.B.	R.F. F. 6/1	ADDED 3/4" EFW	

DRAWN BY
D. B. F.

DEPT. CHECK
W. M. R.


PROJ. CHECK
R. J. Marshall

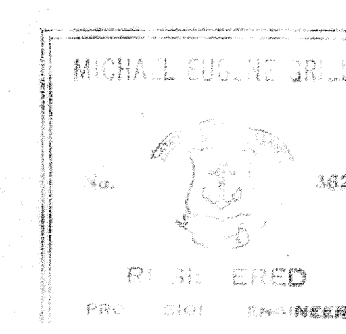

M&E METCALF & EDDY, INC. / ENGINEERS
BOSTON / NEW YORK / PALO ALTO / CHICAGO

Lawrence E. Taylor 6/23/77
REG. PROF. ENGR. MASS. NO. 6661 DATE

Michael E. Eddy 6-27-77
REG. PROF. ENGR. R.I. NO. 3620 DATE

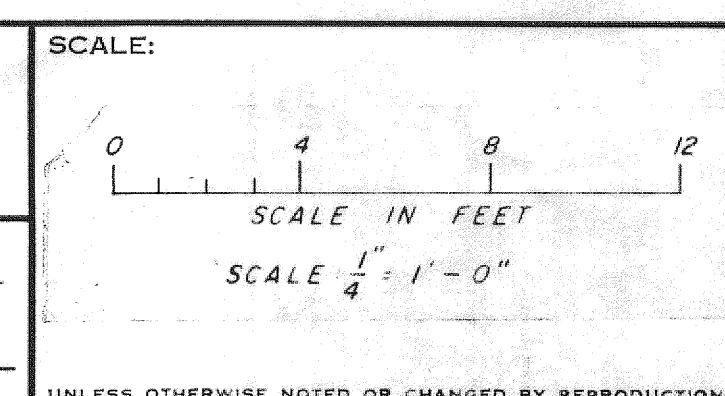

TOWN OF BURRILLVILLE, RHODE ISLAND
BOARD OF SEWER COMMISSIONERS

WASTEWATER TREATMENT FACILITIES

OPERATIONS BUILDING - FIRST FLOOR PLAN I

JOB 4868

FILE NO. H-59945-1

SHEET 1-4