


RECORD DRAWING

NUMBER	DATE	MADE BY	CHECKED BY	DESCRIPTION
12-7-77	C. DONOVAN	R. E. FARRER	R. E. FARRER	CHANGED DUCTS TO ACCOMMODATE MOVED MCC'S
				DELETED SWS & BACKFLOW PREVENTER

DRAWN BY
n.a. chin

DEPT. CHECK
R. E. Farrer


PROJ. CHECK
R. J. Marshall

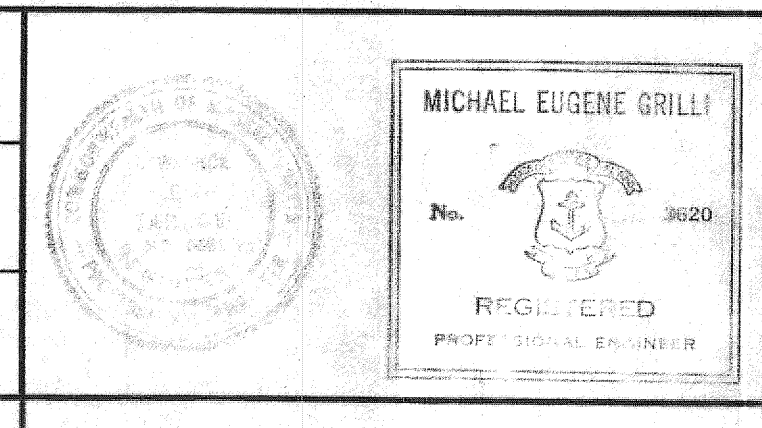

M&E METCALF & EDDY, INC. / ENGINEERS
BOSTON / NEW YORK / PALO ALTO / CHICAGO

Lawrence E. Tarlow
FED. PROF. ENGR. MASS. NO. 5651
DATE 6/23/77

Michael E. Hark
REG. PROF. ENGR. MASS. NO. 3620
DATE 6-27-77

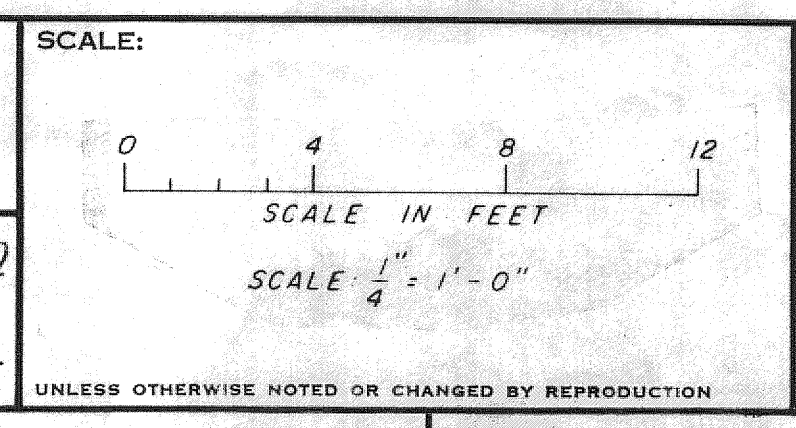

TOWN OF BURRILLVILLE, RHODE ISLAND
BOARD OF SEWER COMMISSIONERS

WASTEWATER TREATMENT FACILITIES
OPERATIONS BUILDING
SECTIONS AND DETAILS

H.V.A.C. & PLUMBING

JOB 4868
FILE NO. H-69951-1
SHEET M-24