



TOP PLAN


- NOTES:**
1. PROVIDE REMOVABLE ALUM. COVER PL AND FRAMES OVER ALL COMMUNUTOR CHANNELS. EXTENT TO SUIT EQUIPMENT. REFER TO MECH. DWGS. FOR EQUIPMENT LOCATIONS.
  2. REMOVABLE ALUM. PL COVERS AND FRAME, SEE DETS. 5-2.24 & 5-2.26.
  3. HINGED ALUM. PL COVER. SEE DETAIL 5-2.25.

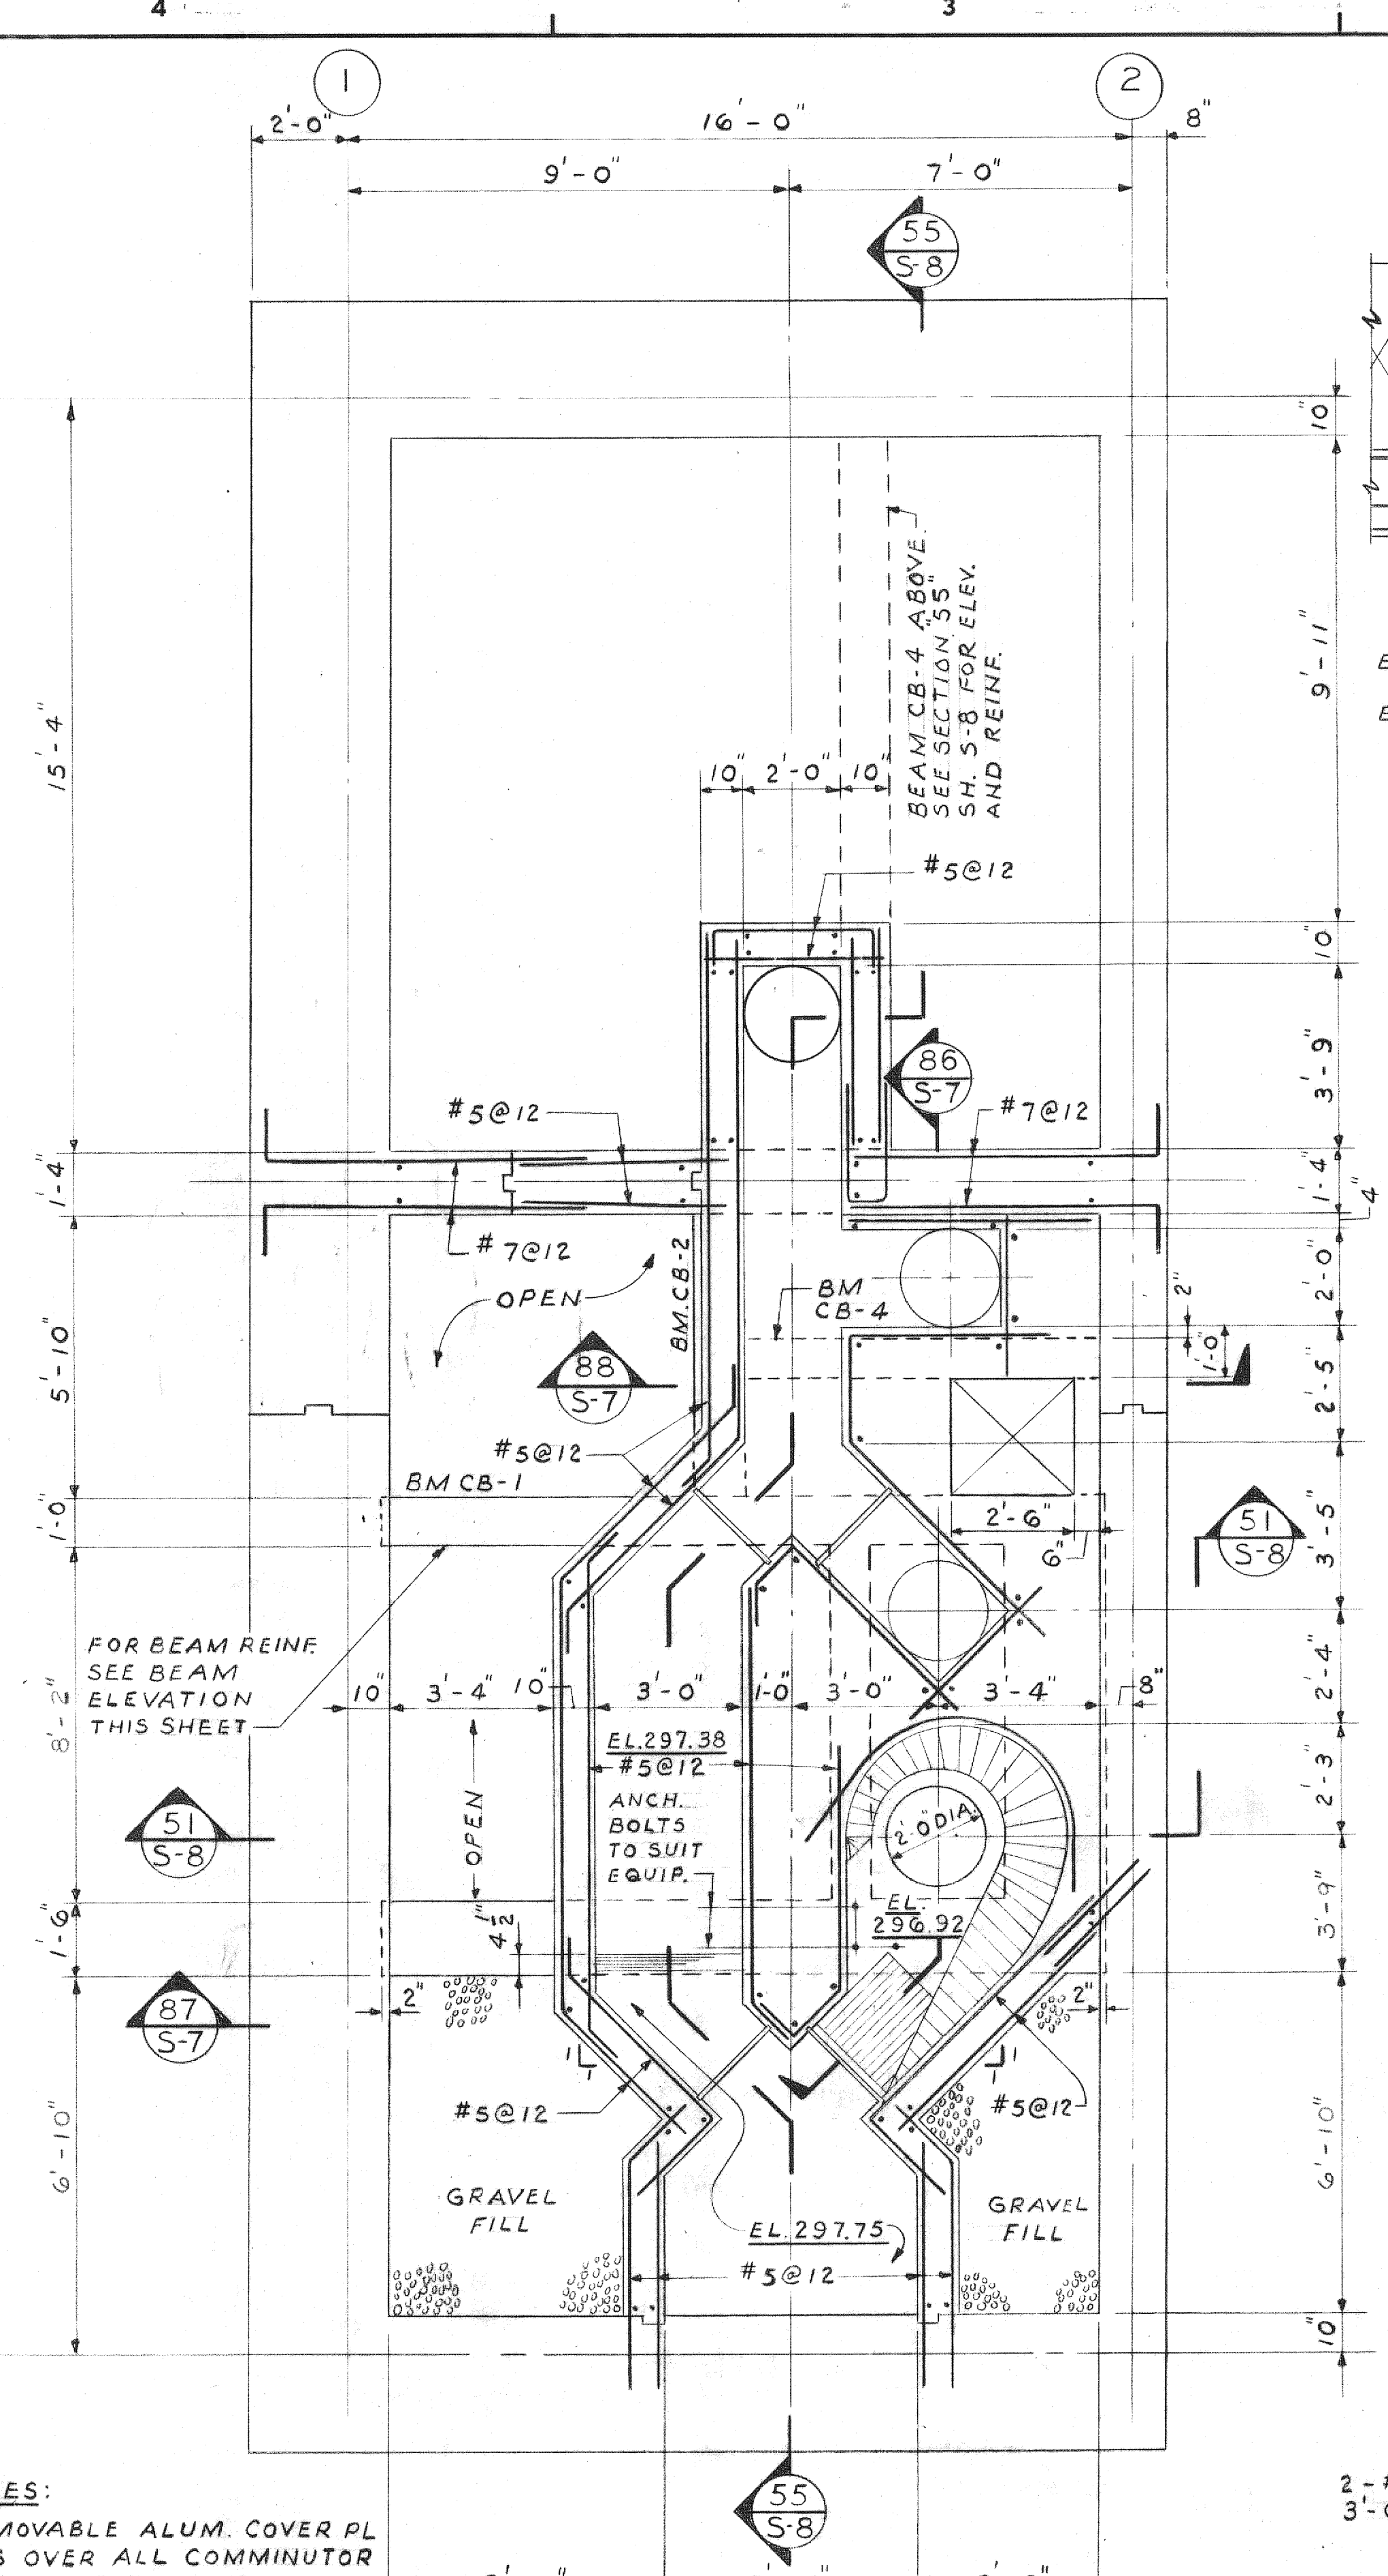


PLAN SECTION

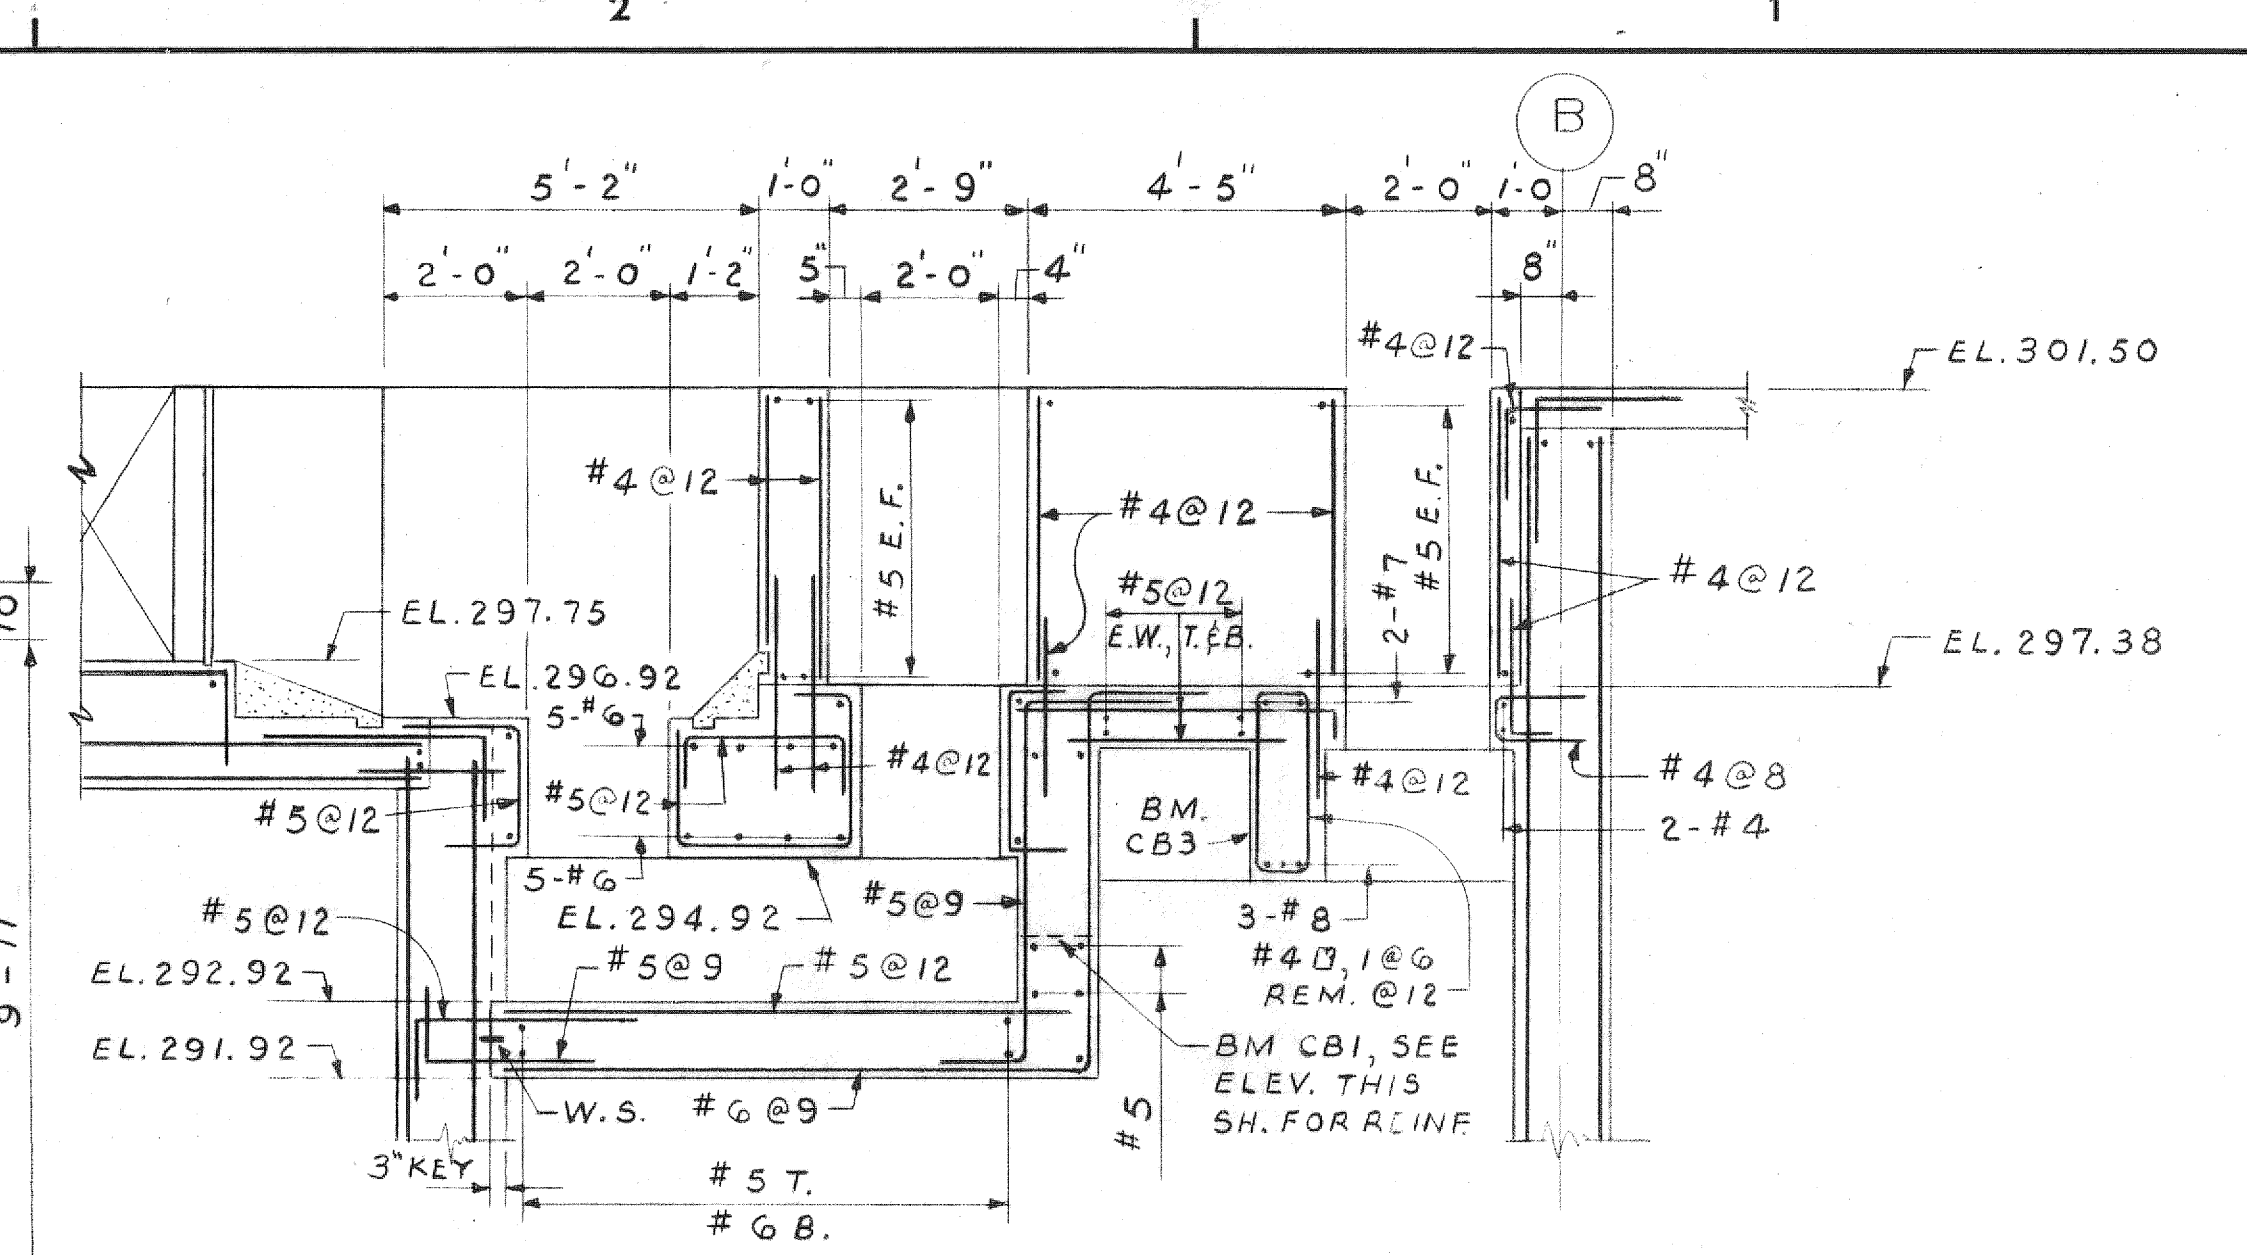


SECTION 86  
SCALE: 3/8" = 1'-0"

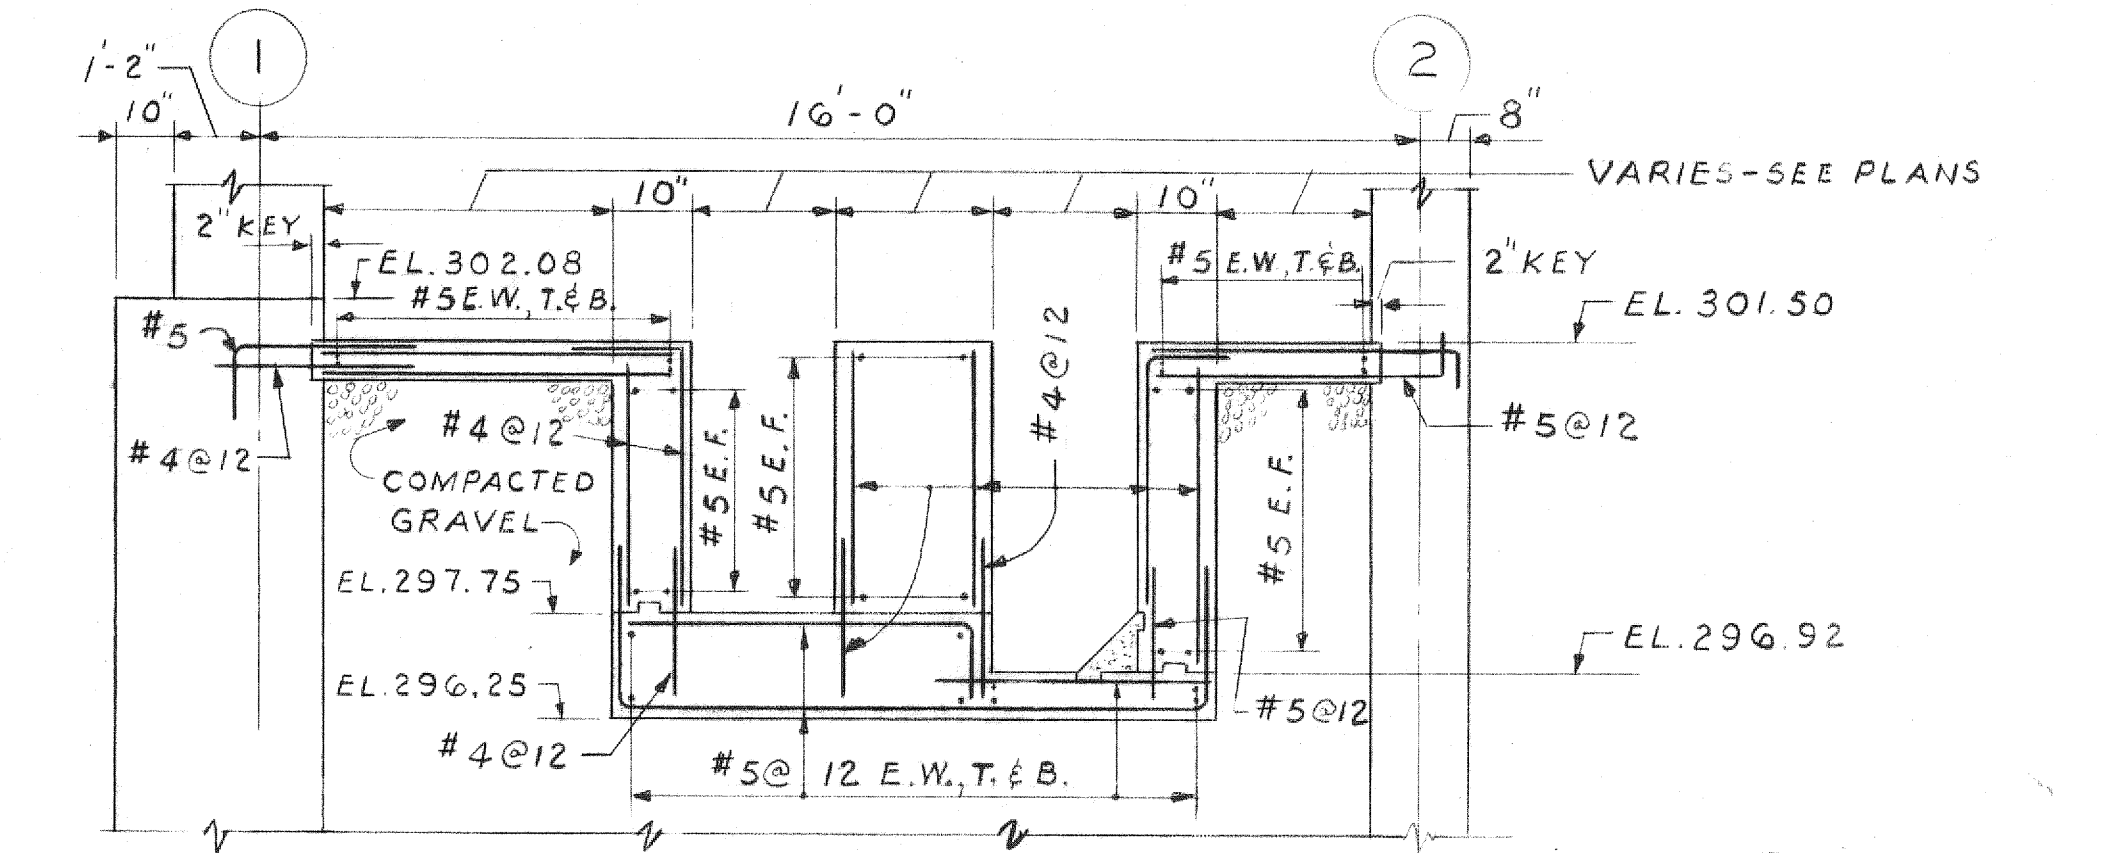

SECTION 87  
SCALE: 3/8" = 1'-0"

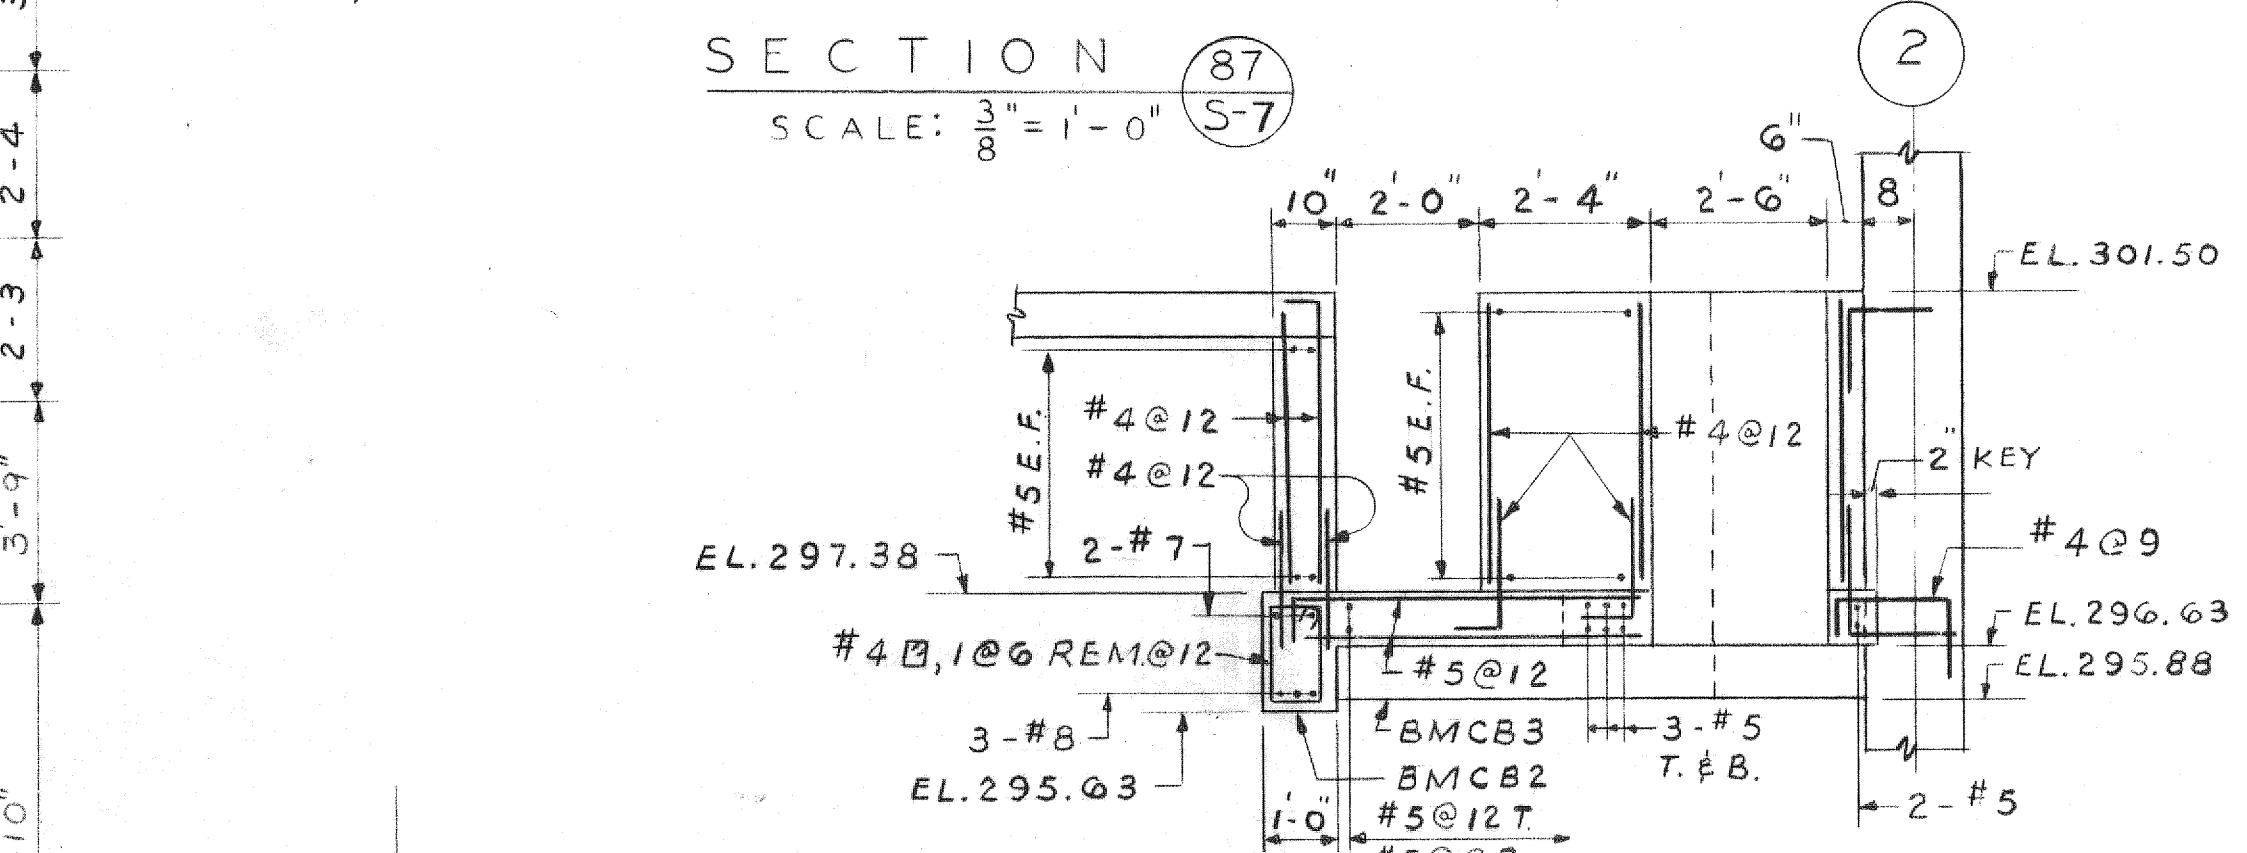

SECTION 88  
SCALE: 3/8" = 1'-0"

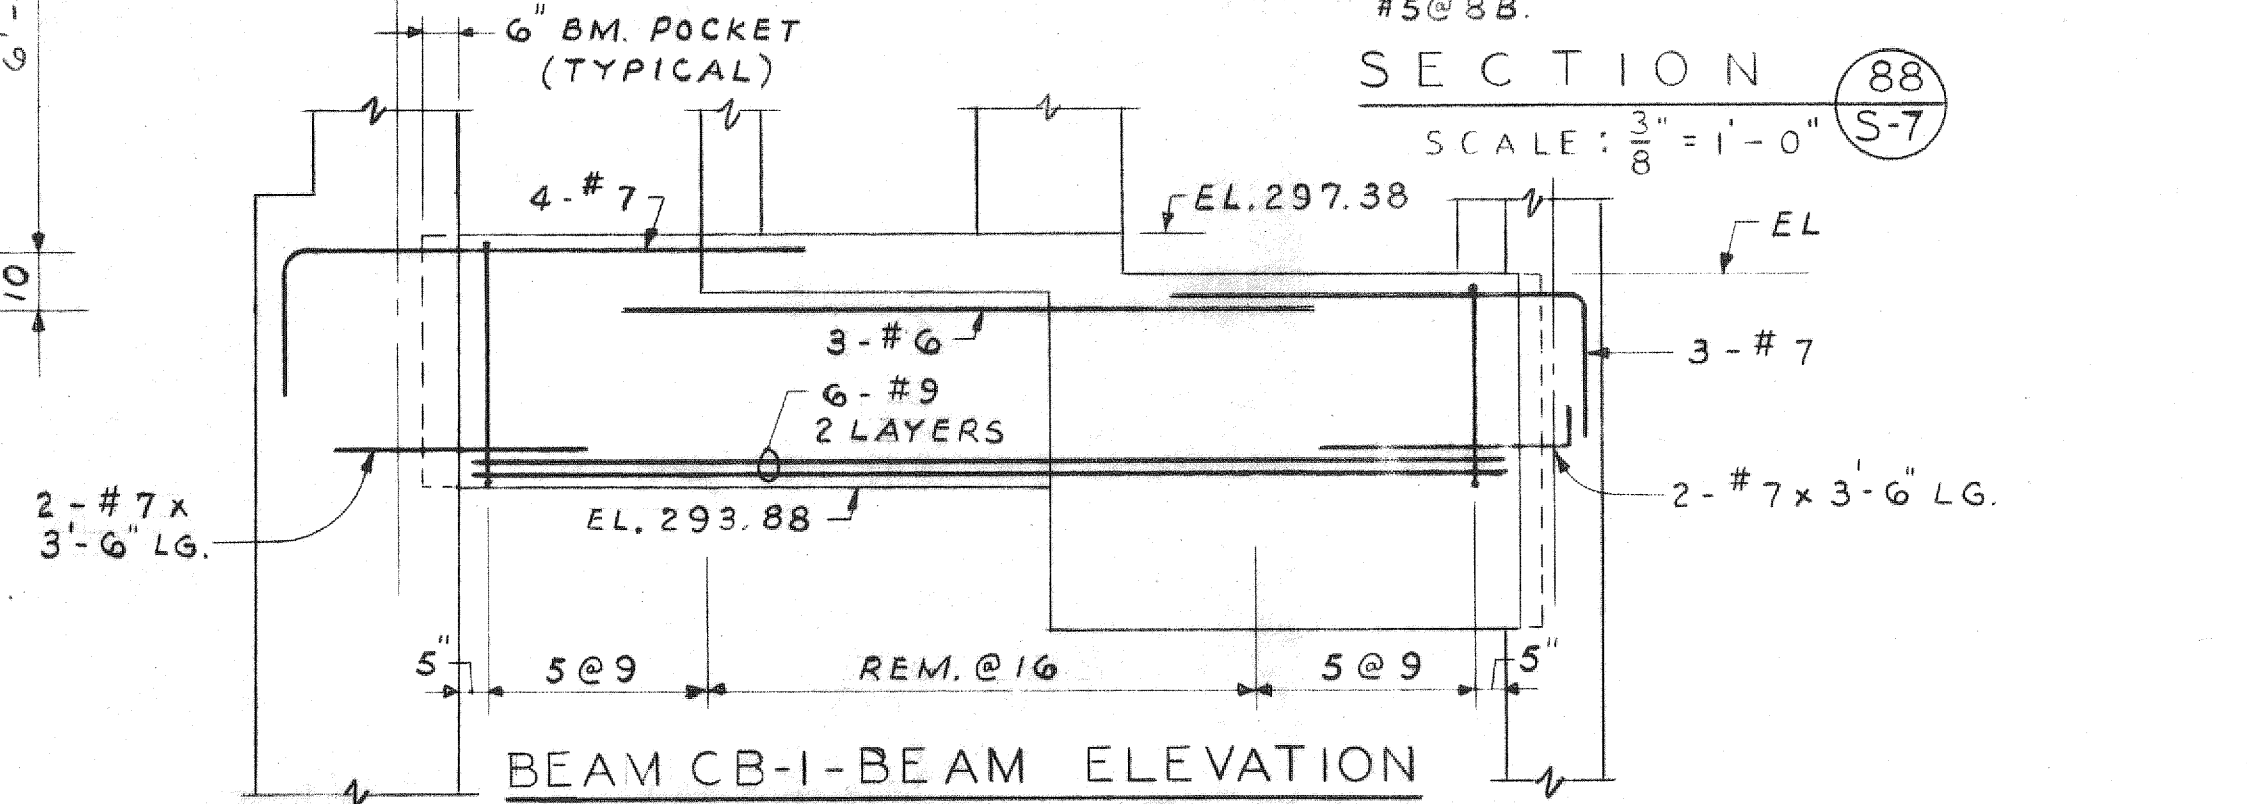

BEAM CB-1-BEAM ELEVATION

12" x VARIES  
SCALE: 3/8" = 1'-0"


**RECORD DRAWING**

NUMBER	DATE	MADE BY	CHECKED BY	DESCRIPTION

DRAWN BY  
*R. Hough*

DEPT. CHECK  
*Donal J. Bonadina*

PROJ. CHECK  
*J. Marshall*

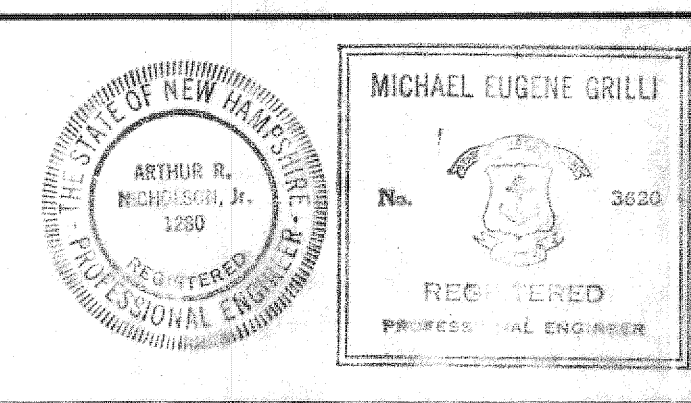

**M&E** METCALF & EDDY, INC. / ENGINEERS  
BOSTON / NEW YORK / PALO ALTO / CHICAGO

REG. PROF. ENGR. N.H. No. 1280  
*Michael E. Grillo*  
DATE 6-27-77

SCALE:  
3/8" = 1'-0"

UNLESS OTHERWISE NOTED OR CHANGED BY REPRODUCTION

TOWN OF BURRILLVILLE, RHODE ISLAND  
BOARD OF SEWER COMMISSIONERS

WASTEWATER TREATMENT FACILITIES

OPERATIONS BUILDING  
PLAN OF COMMUNUTOR ROOM AND DETAILS

STRUCTURAL

JOB: 4868

FILE NO.: H-68995-1

SHEET: S-7