


PILE LOCATION PLAN  
SCALE: 1/8" = 1'-0"

- NOTES
1. ALL PILES HAVE P.C.O. ELEVATION 306.00 UNLESS OTHERWISE NOTED IN SCHEDULE BELOW.
  2. FOR LOCATION OF SECTIONS DRAWN ON THIS SHT. SEE SHT. S-14
  3. FOR GRATING SIZE & DETAILS, SEE DETAIL S-2.1
  4. FOR CHKD. R. THICKNESS & DETAILS, SEE DETS. S-2.25 & S-2.26


PILE SCHEDULE (PILES OTHER THAN THOSE HAVING P.C.O. = 306.00)	
PILE NUMBER	P.C.O. ELEV.
143	300.67
10, 11, 12	301.00
158, 159, 164, 165, 166, 187, 271, 272	301.67
100, 101, 102, 263, 264, 265	303.17
1, 2, 3, 4, 5, 6, 7	304.67
13, 14, 15, 22, 23, 30, 31, 37, 38, 39, 51, 52, 53, 62, 77, 78, 83, 85, 86, 87, 90, 91, 92, 95, 96, 97, 105, 106, 107, 108, 109, 110, 111, 112, 113, 114, 115, 116, 117, 134, 135, 136	303.50
137, 138, 151, 166, 98, 99, 103, 104	308.17
255, 256, 257	301.83
16, 17, 18	

TOTAL NO. OF PILES = 276


- NOTES:
1. FOR ESTIMATING PURPOSES ASSUME PILE TIP AT ELEV. 286.00. PILE TIP ELEV. MAY BE ADJUSTED AFTER EVALUATION OF PILE TESTS.
  2. FOR TYP. PILE DETL. SEE SHT. S-16

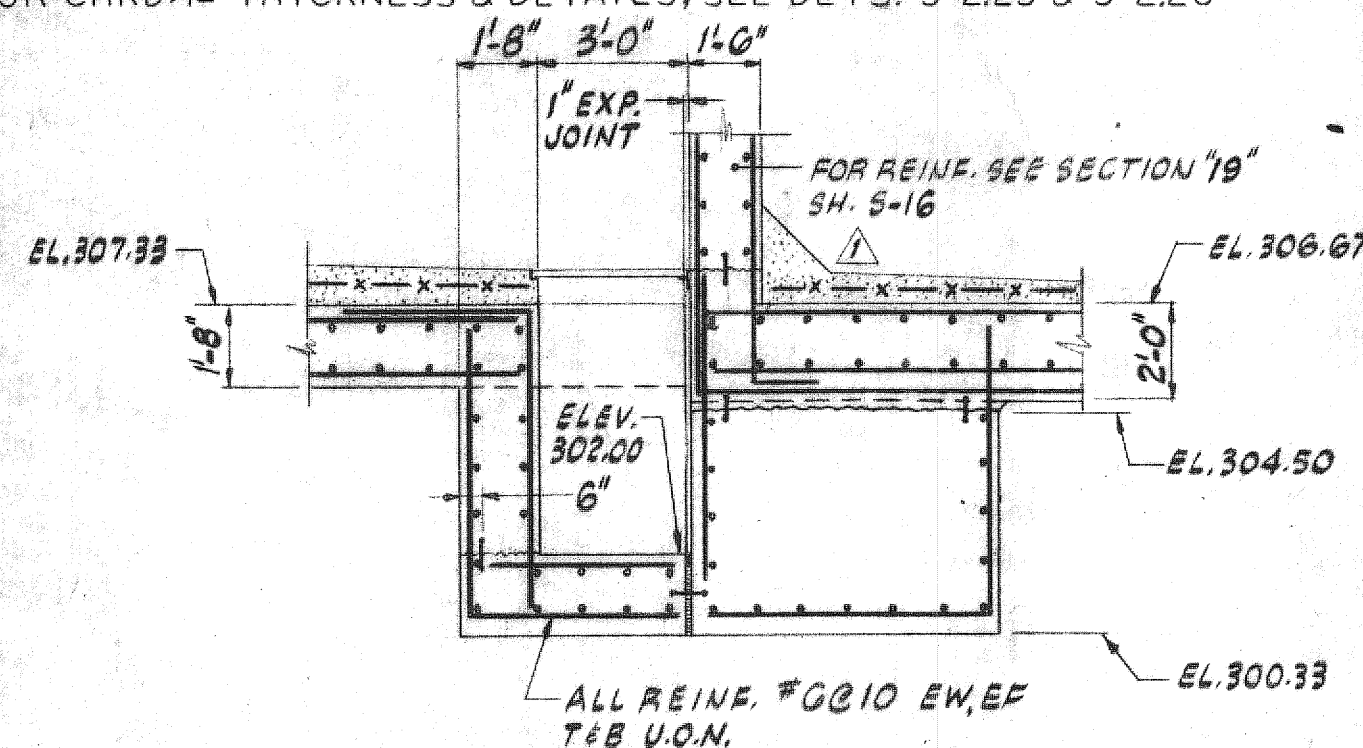


SECTION 12  
SCALE: 1/4" = 1'-0"

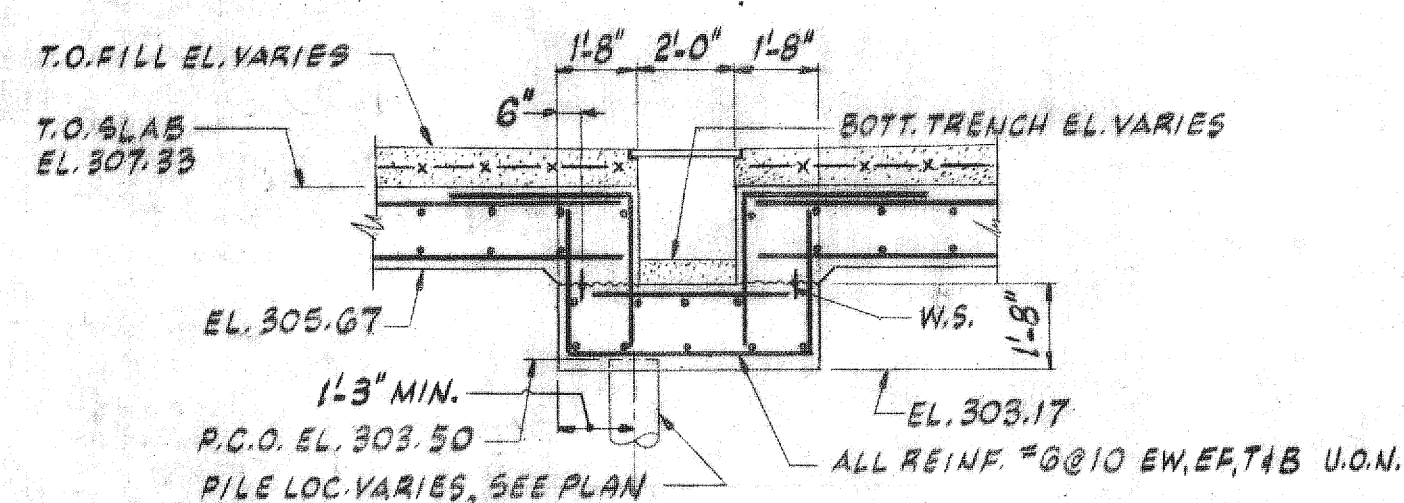


SECTION 8  
SCALE: 1/4" = 1'-0"

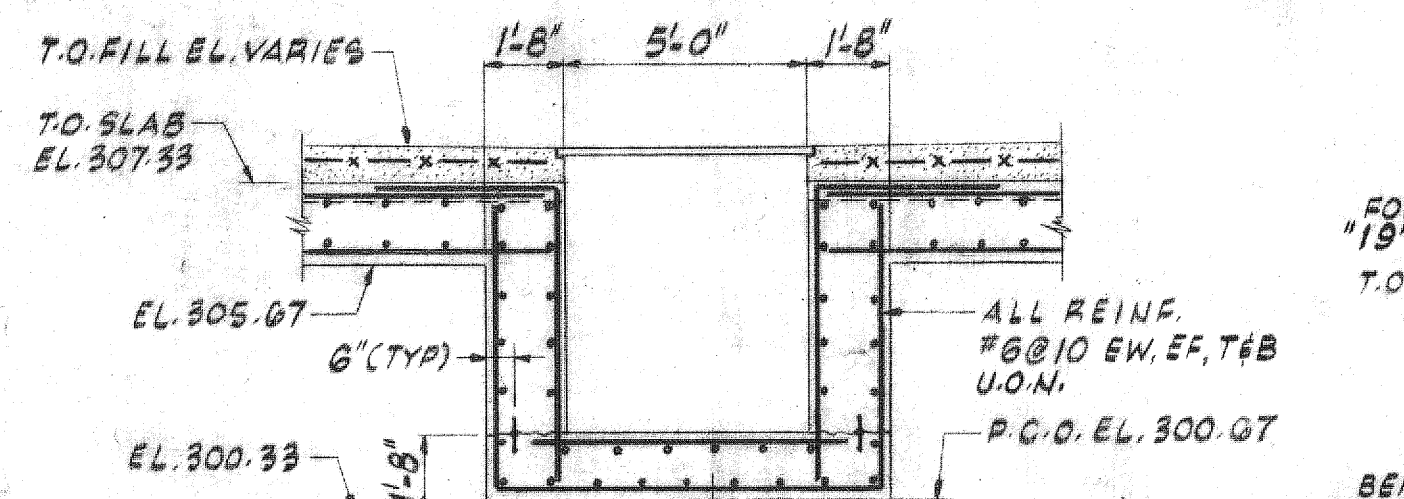


SECTION 13  
SCALE: 1/4" = 1'-0"

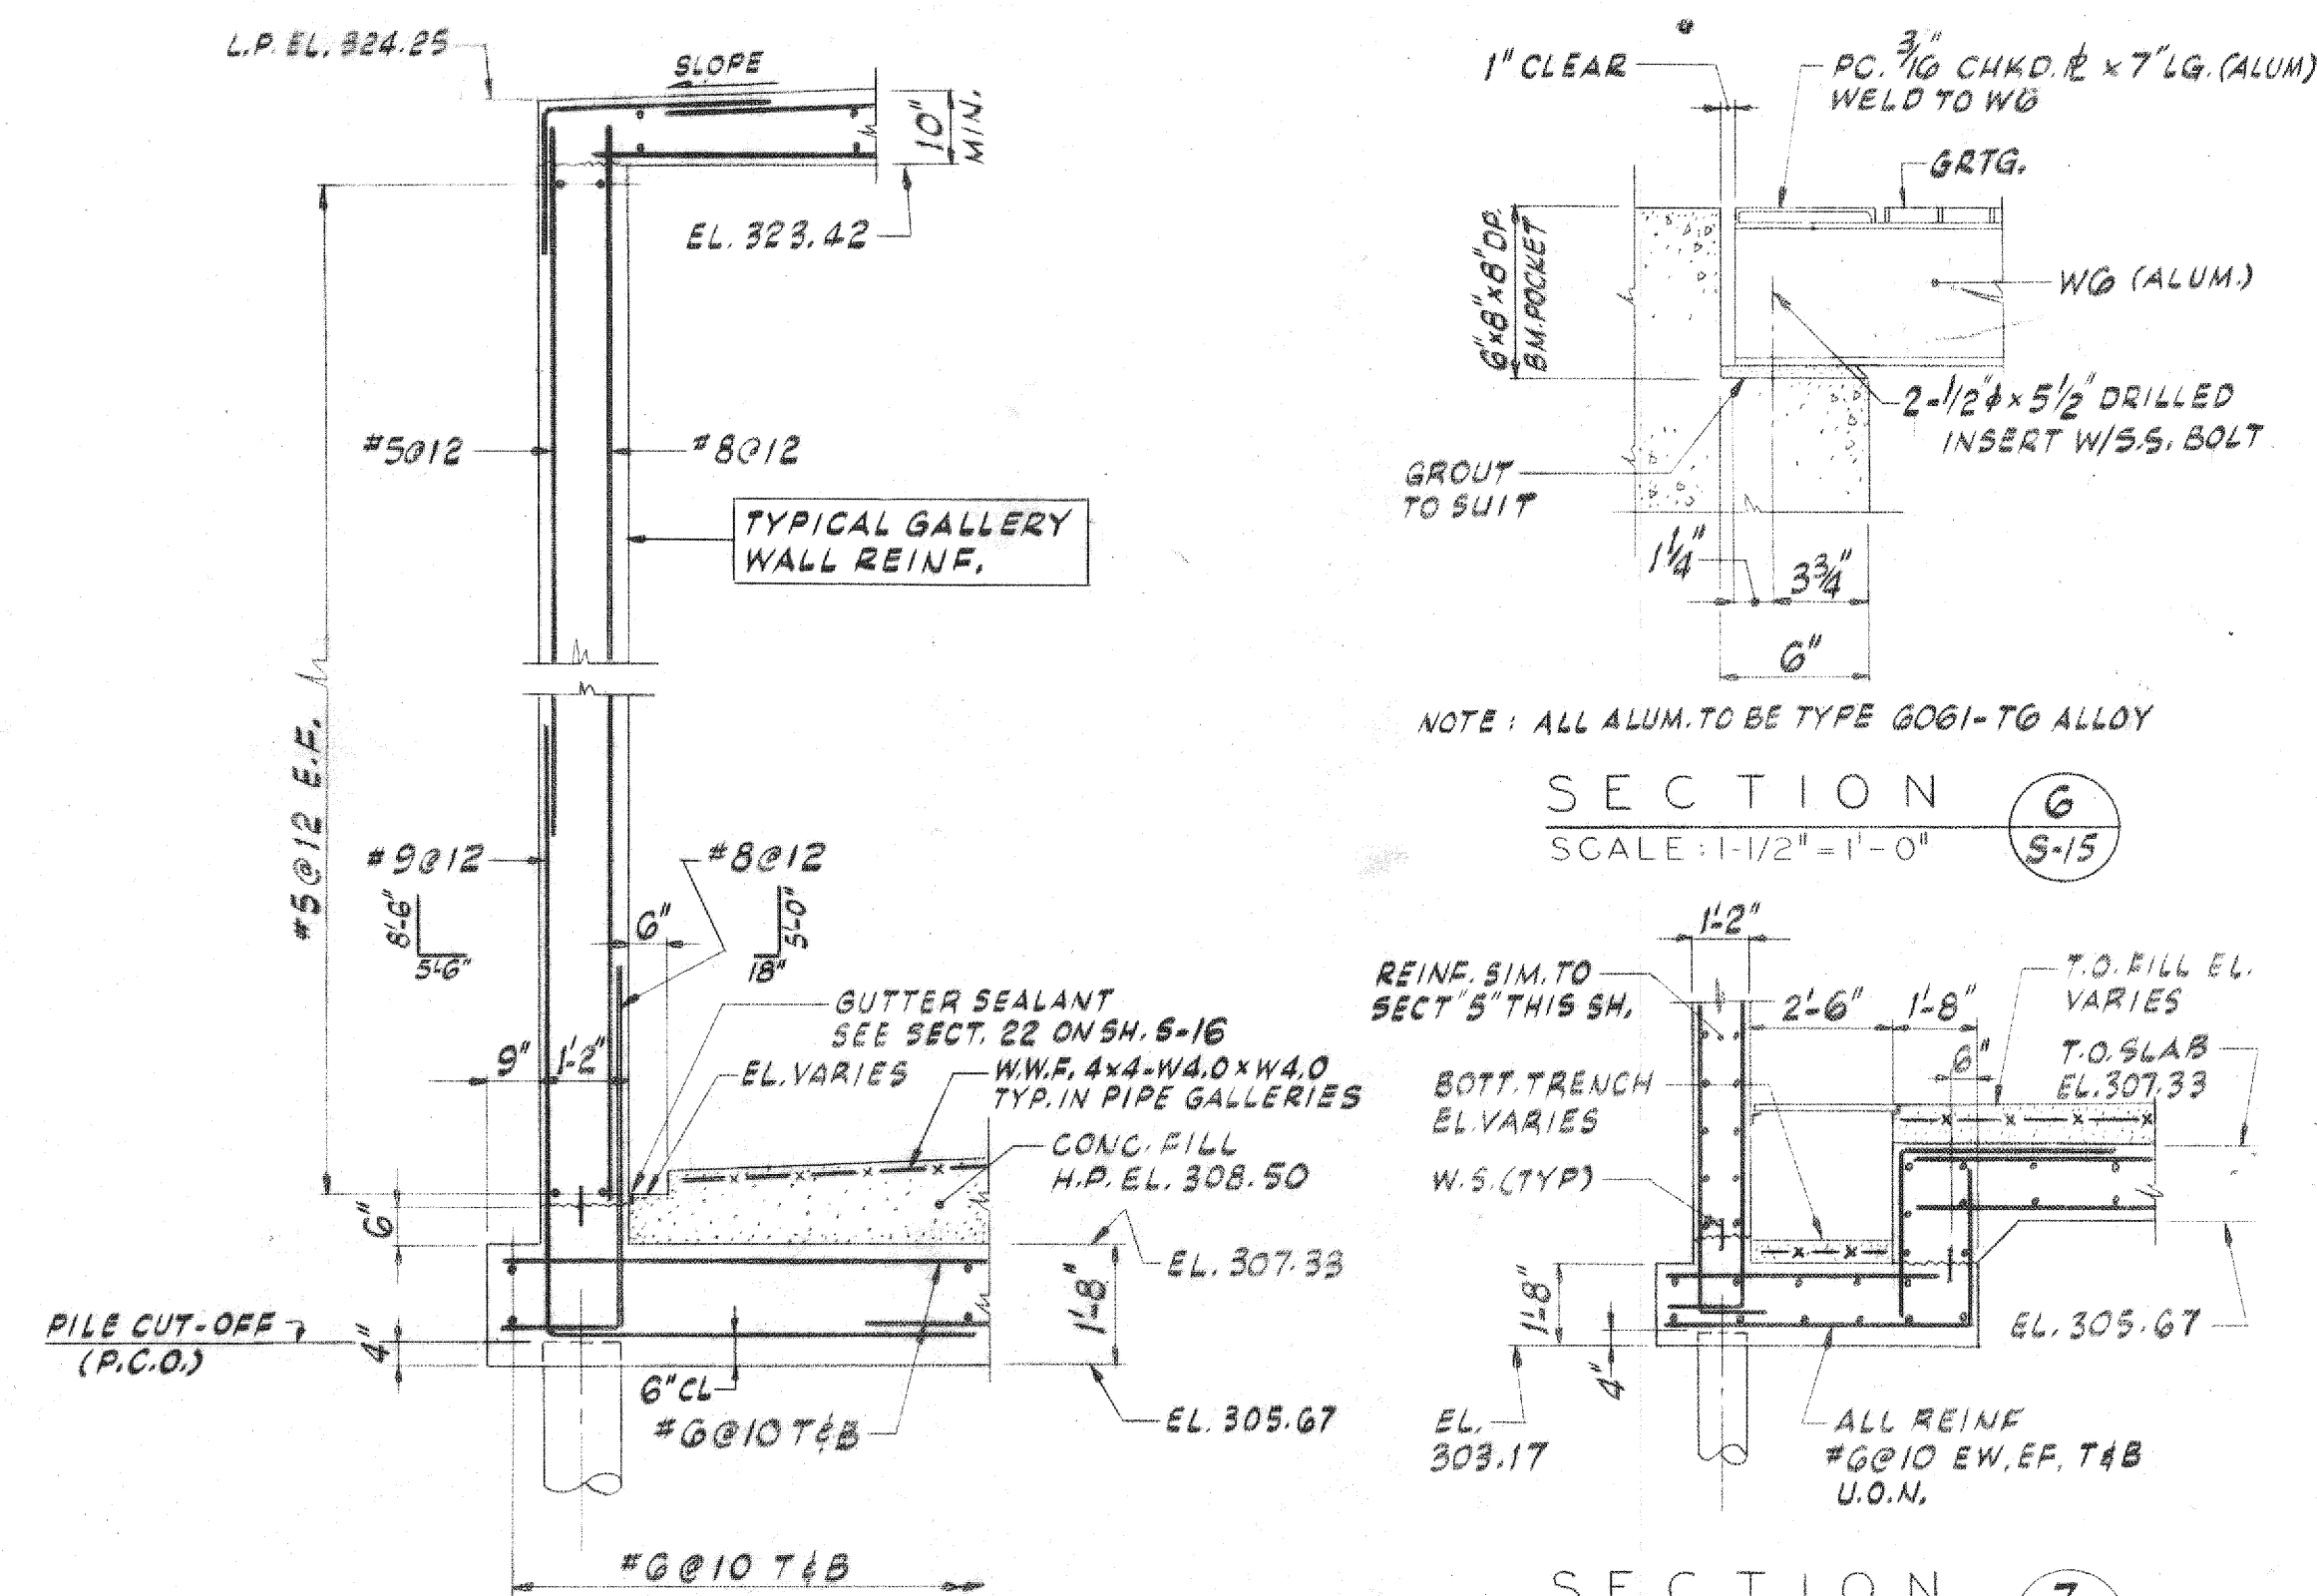


SECTION 6  
SCALE: 3/8" = 1'-0"

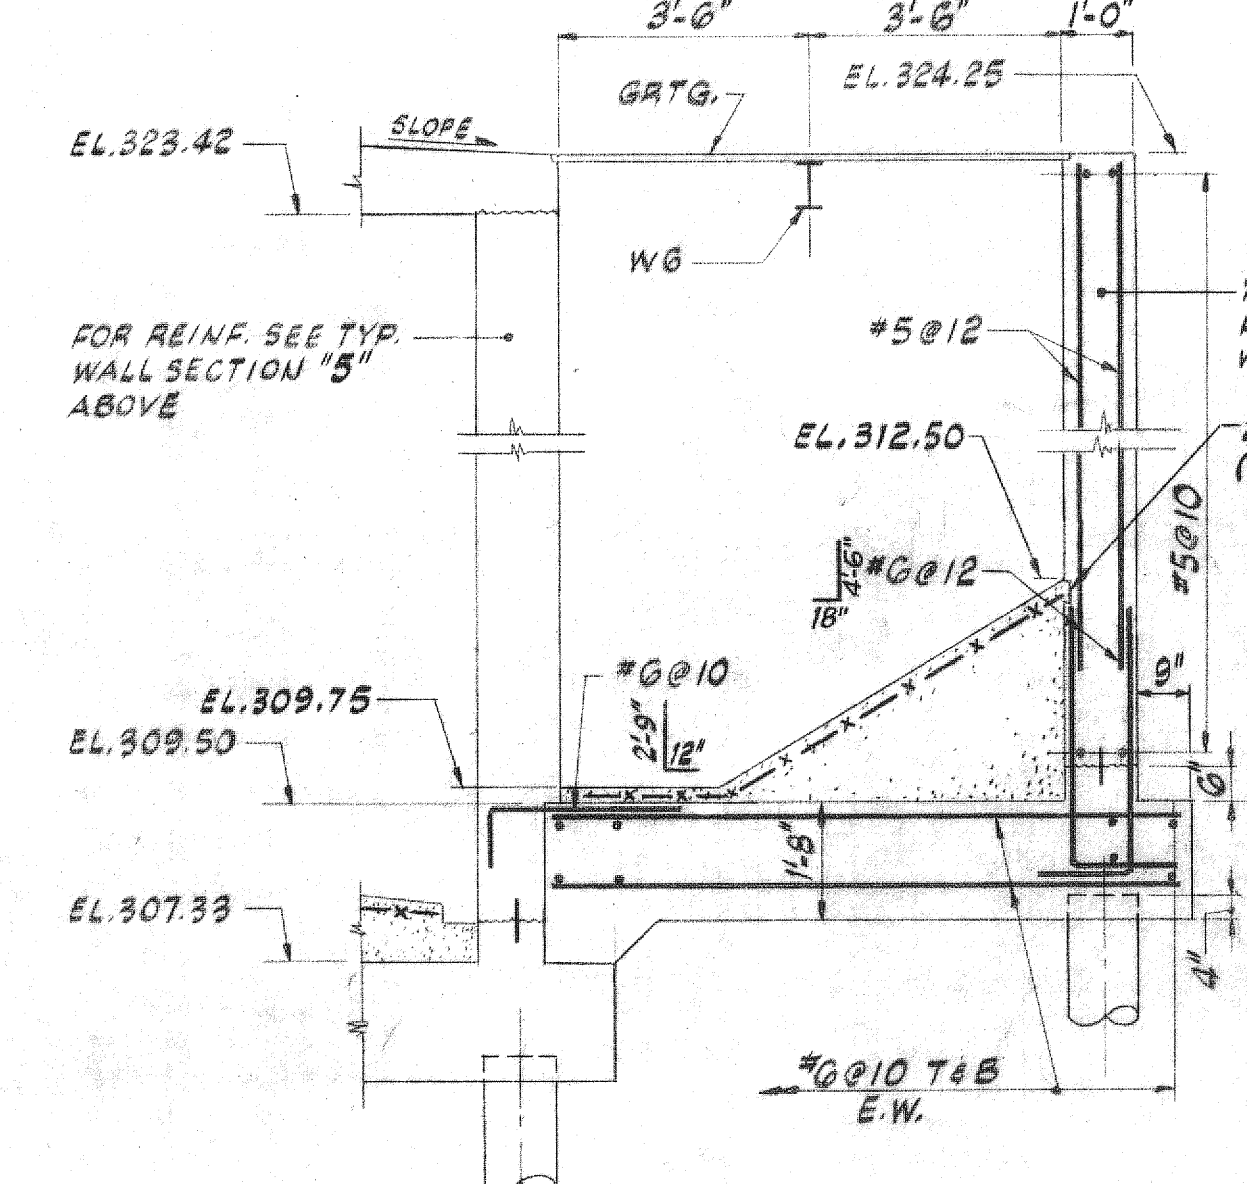


SECTION 5  
SCALE: 3/8" = 1'-0"

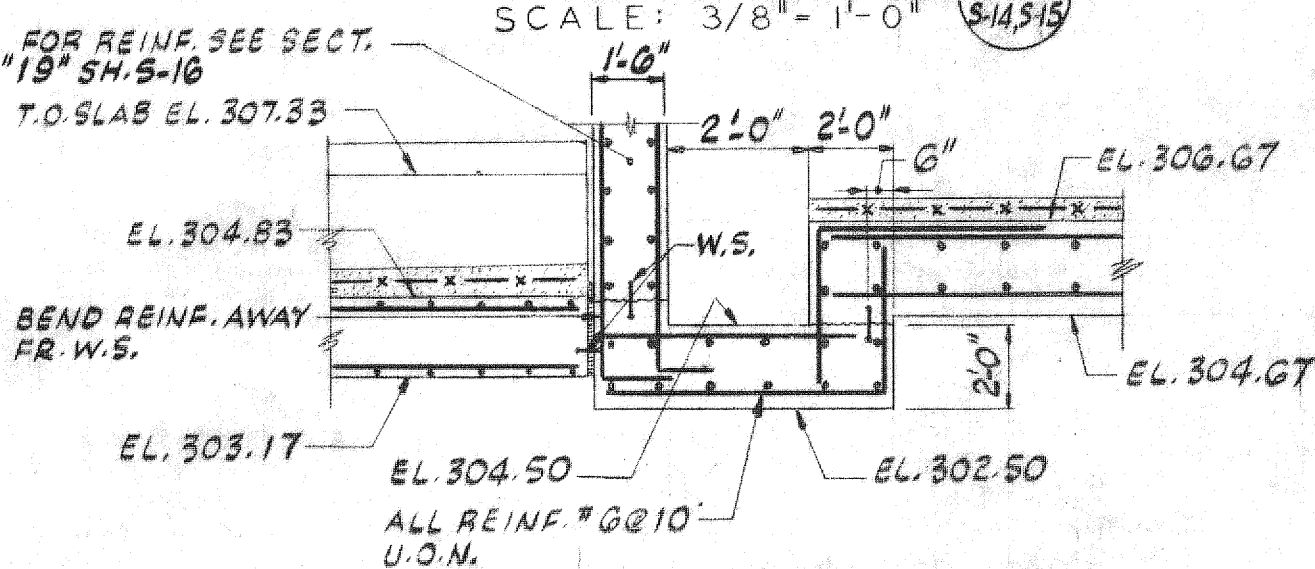


SECTION 9  
SCALE: 1/4" = 1'-0"

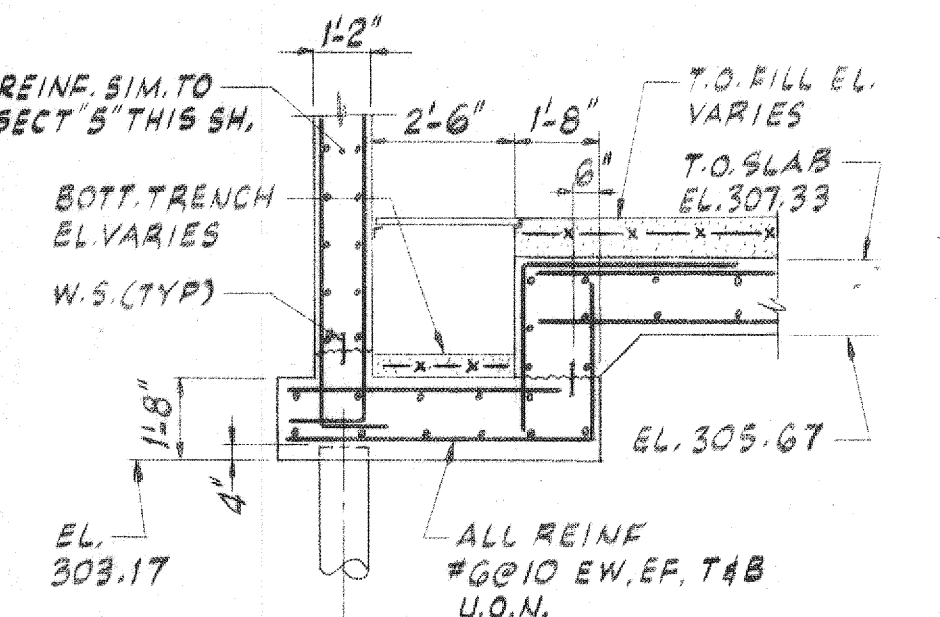

SECTION 7  
SCALE: 1/4" = 1'-0"

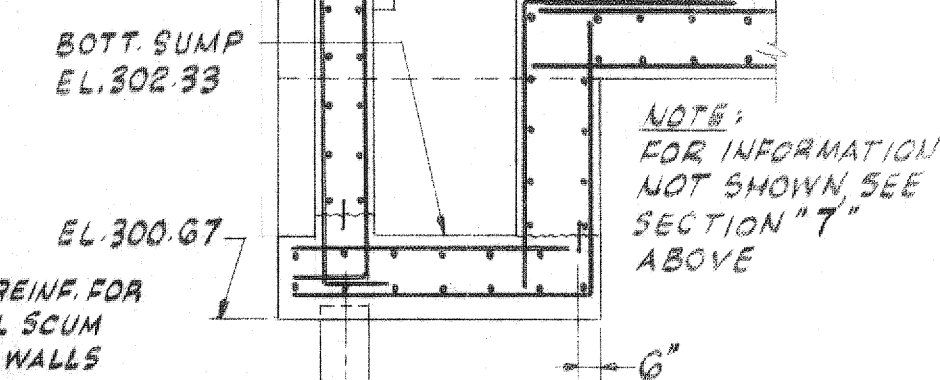

SECTION 10  
SCALE: 1/4" = 1'-0"

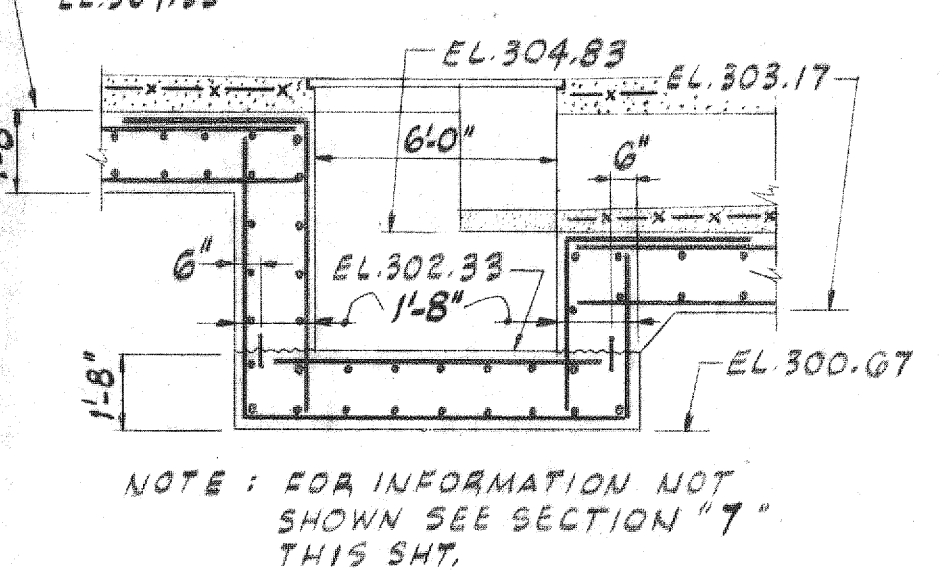

SECTION 11  
SCALE: 1/4" = 1'-0"

# RECORD DRAWING

DRAWN BY P. Wilson DEPT. CHECK Ronald F. Bondman PROJ. CHECK R. J. Marshall				MICHAEL EUGENE GRILLI ARTHUR R. NICHOLSON, JR. REGISTERED PROFESSIONAL ENGINEER No. 3620				M&E METCALF & EDDY, INC. / ENGINEERS BOSTON / NEW YORK / PALO ALTO / CHICAGO REG. PROF. ENGR. No. 1290 Michael E. Grilli REG. PROF. ENGR. No. 3620				SCALE: AS SHOWN TOWN OF BURRILLVILLE, RHODE ISLAND BOARD OF SEWER COMMISSIONERS WASTEWATER TREATMENT FACILITIES PIPE GALLERIES PILE LOCATION PLAN STRUCTURAL				JOB: 4868 FILE NO. H-69001-1 SHEET S-13			
--	--	--	--	---	--	--	--	--	--	--	--	---	--	--	--	---	--	--	--