

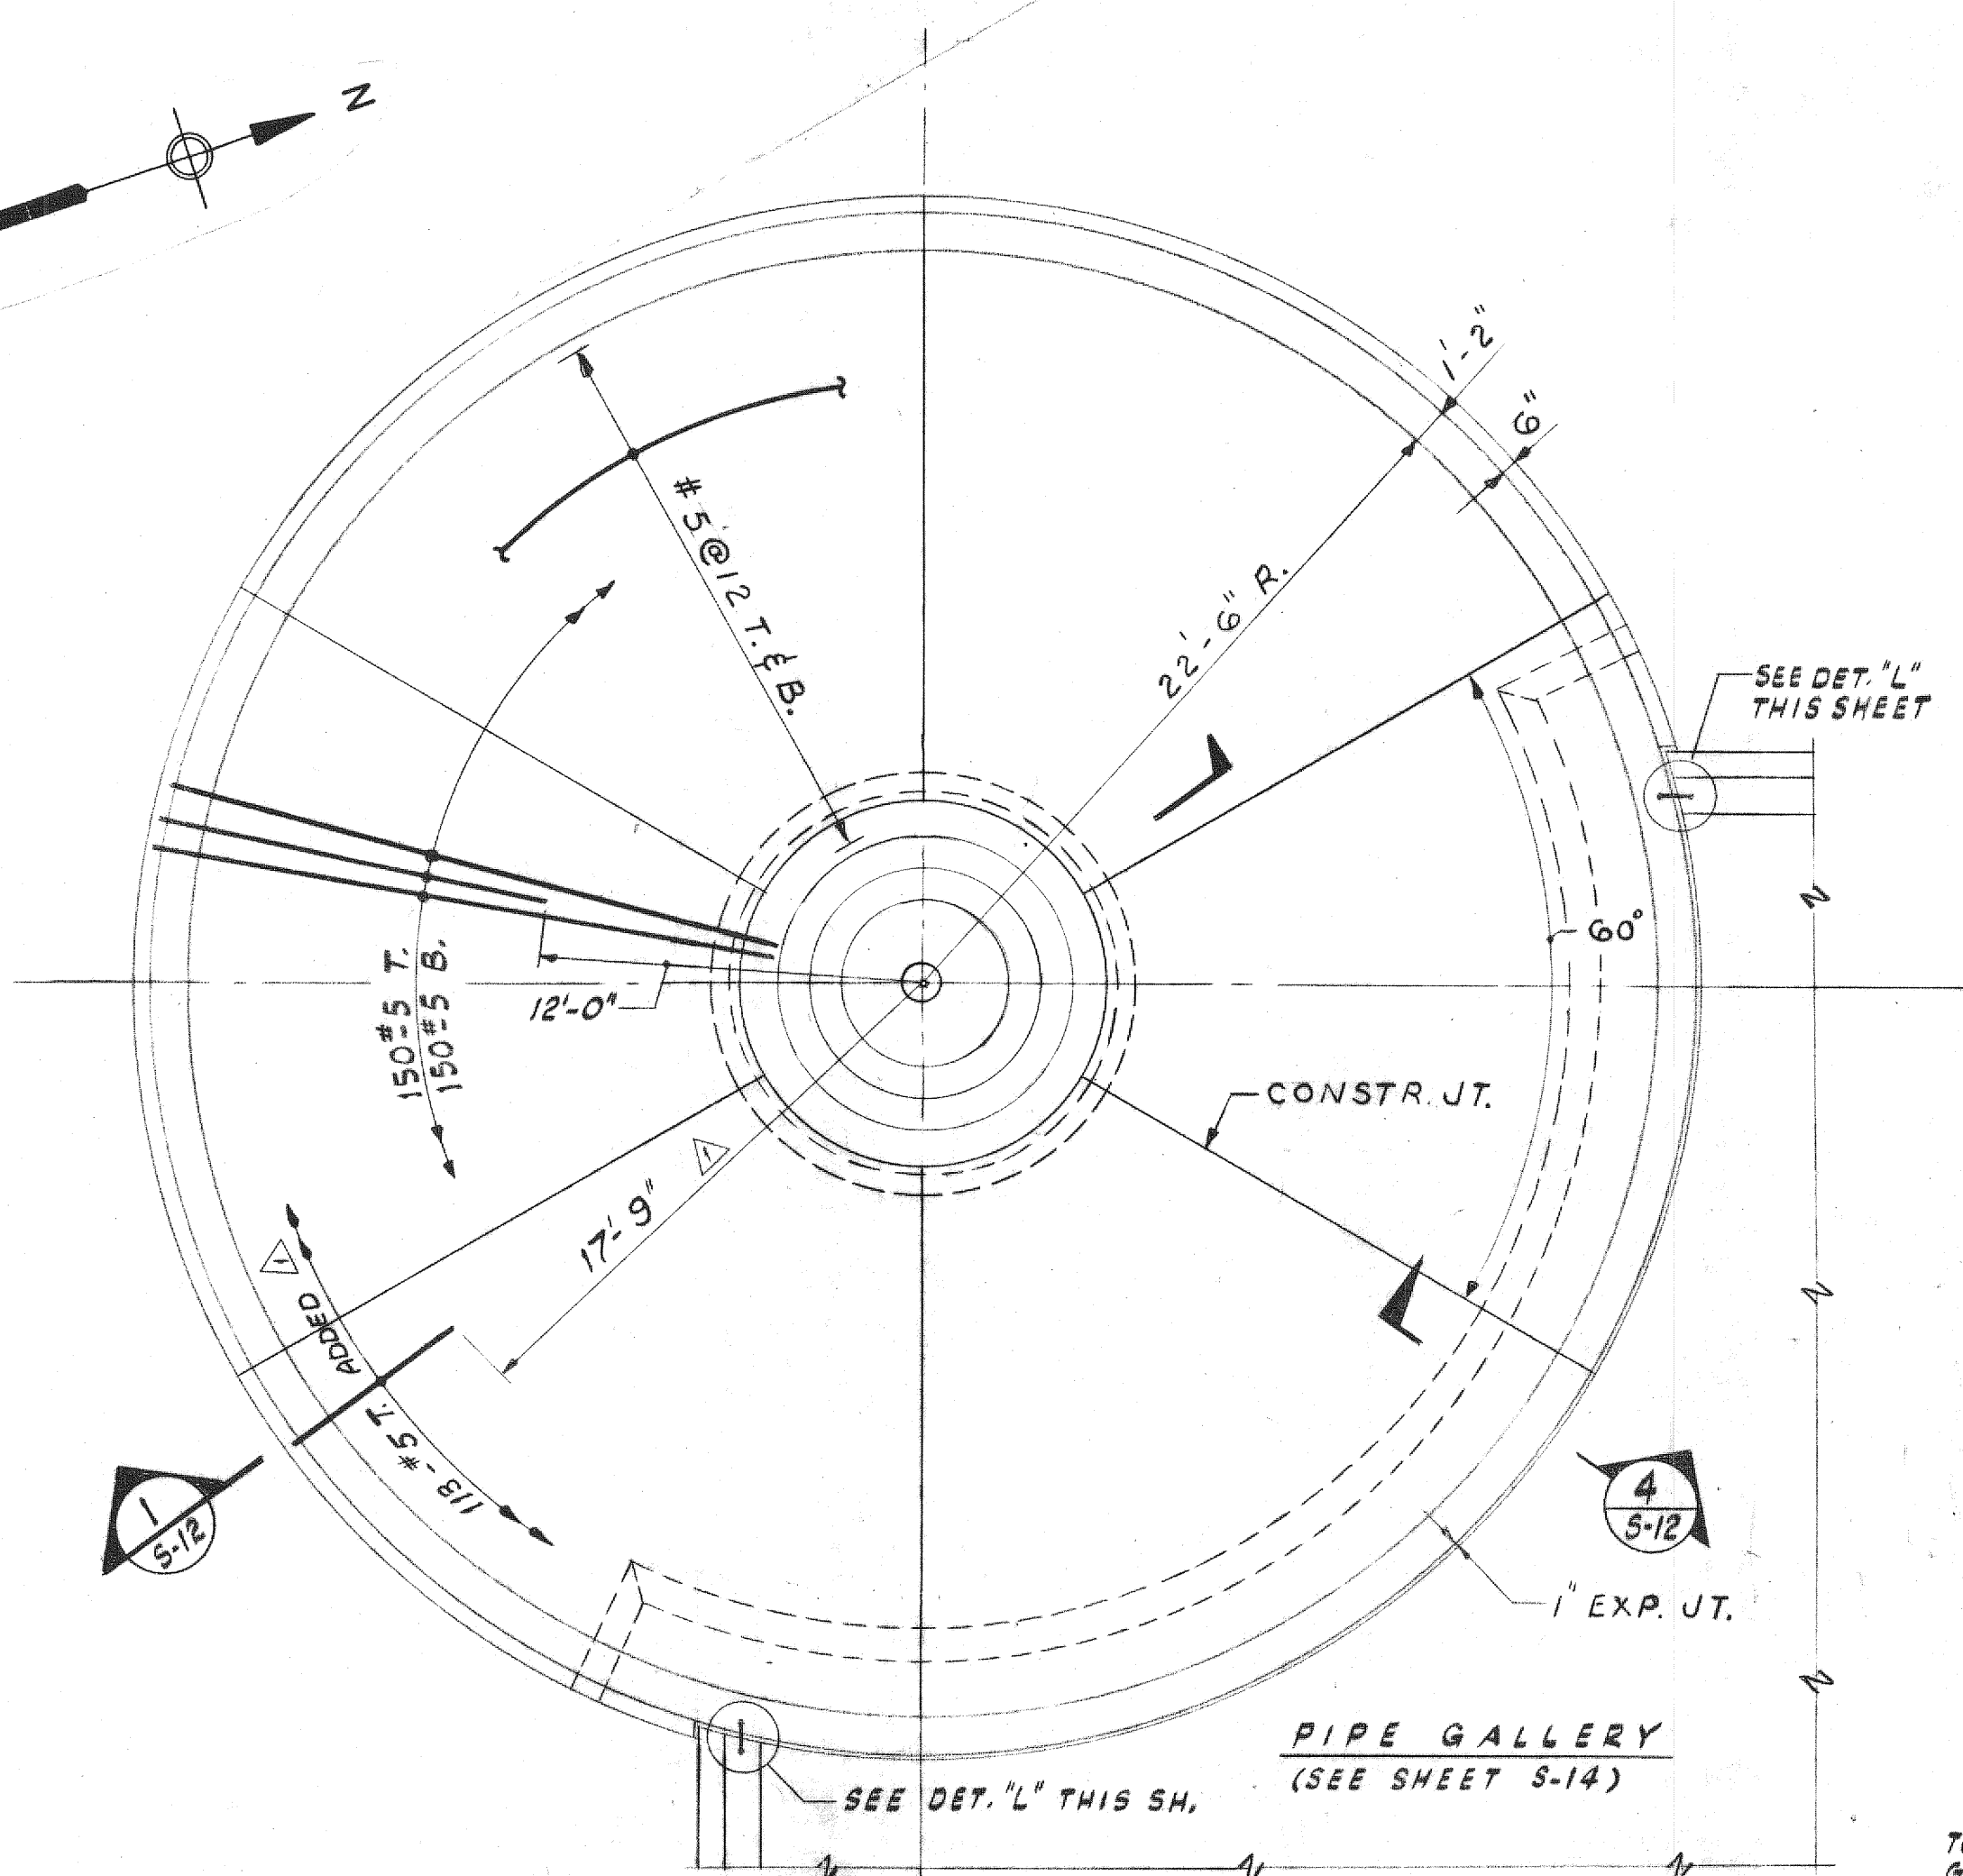
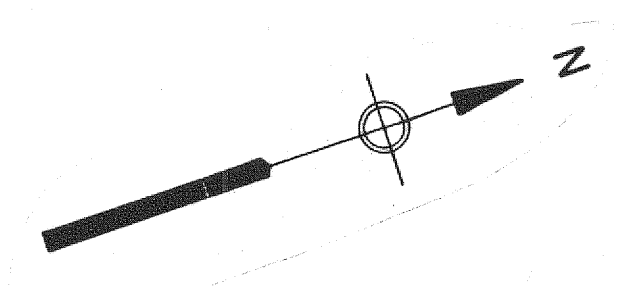


D  
C  
B  
A

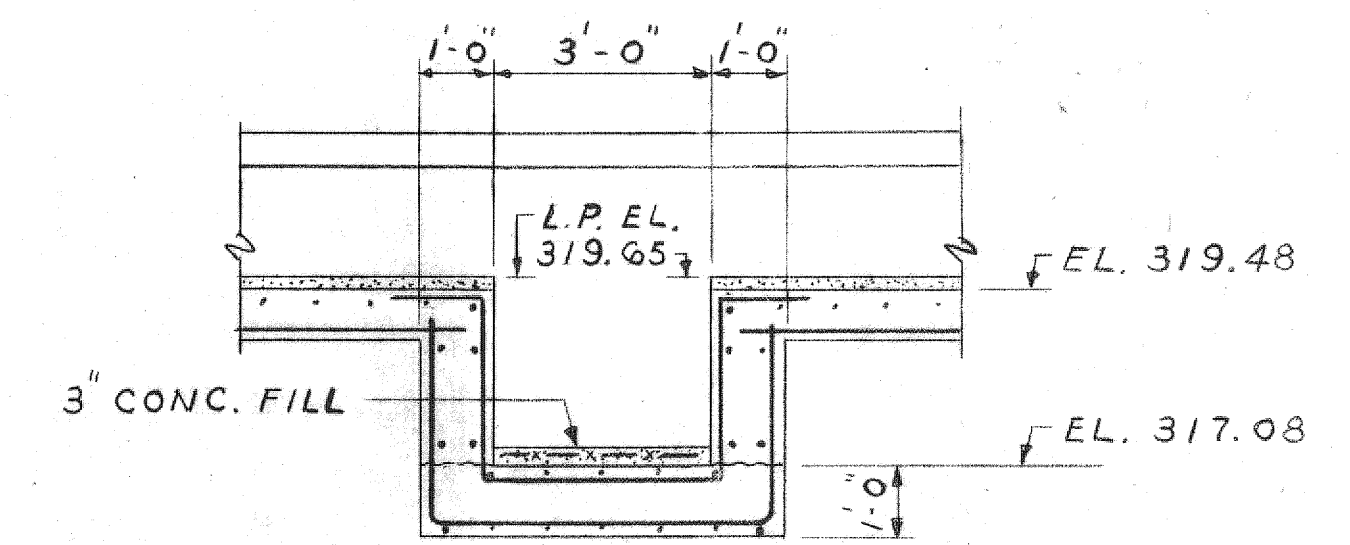


PRIMARY SETTLING TANK NO. 1 AS SHOWN  
PRIMARY SETTLING TANK NO. 2 OPP. HAND

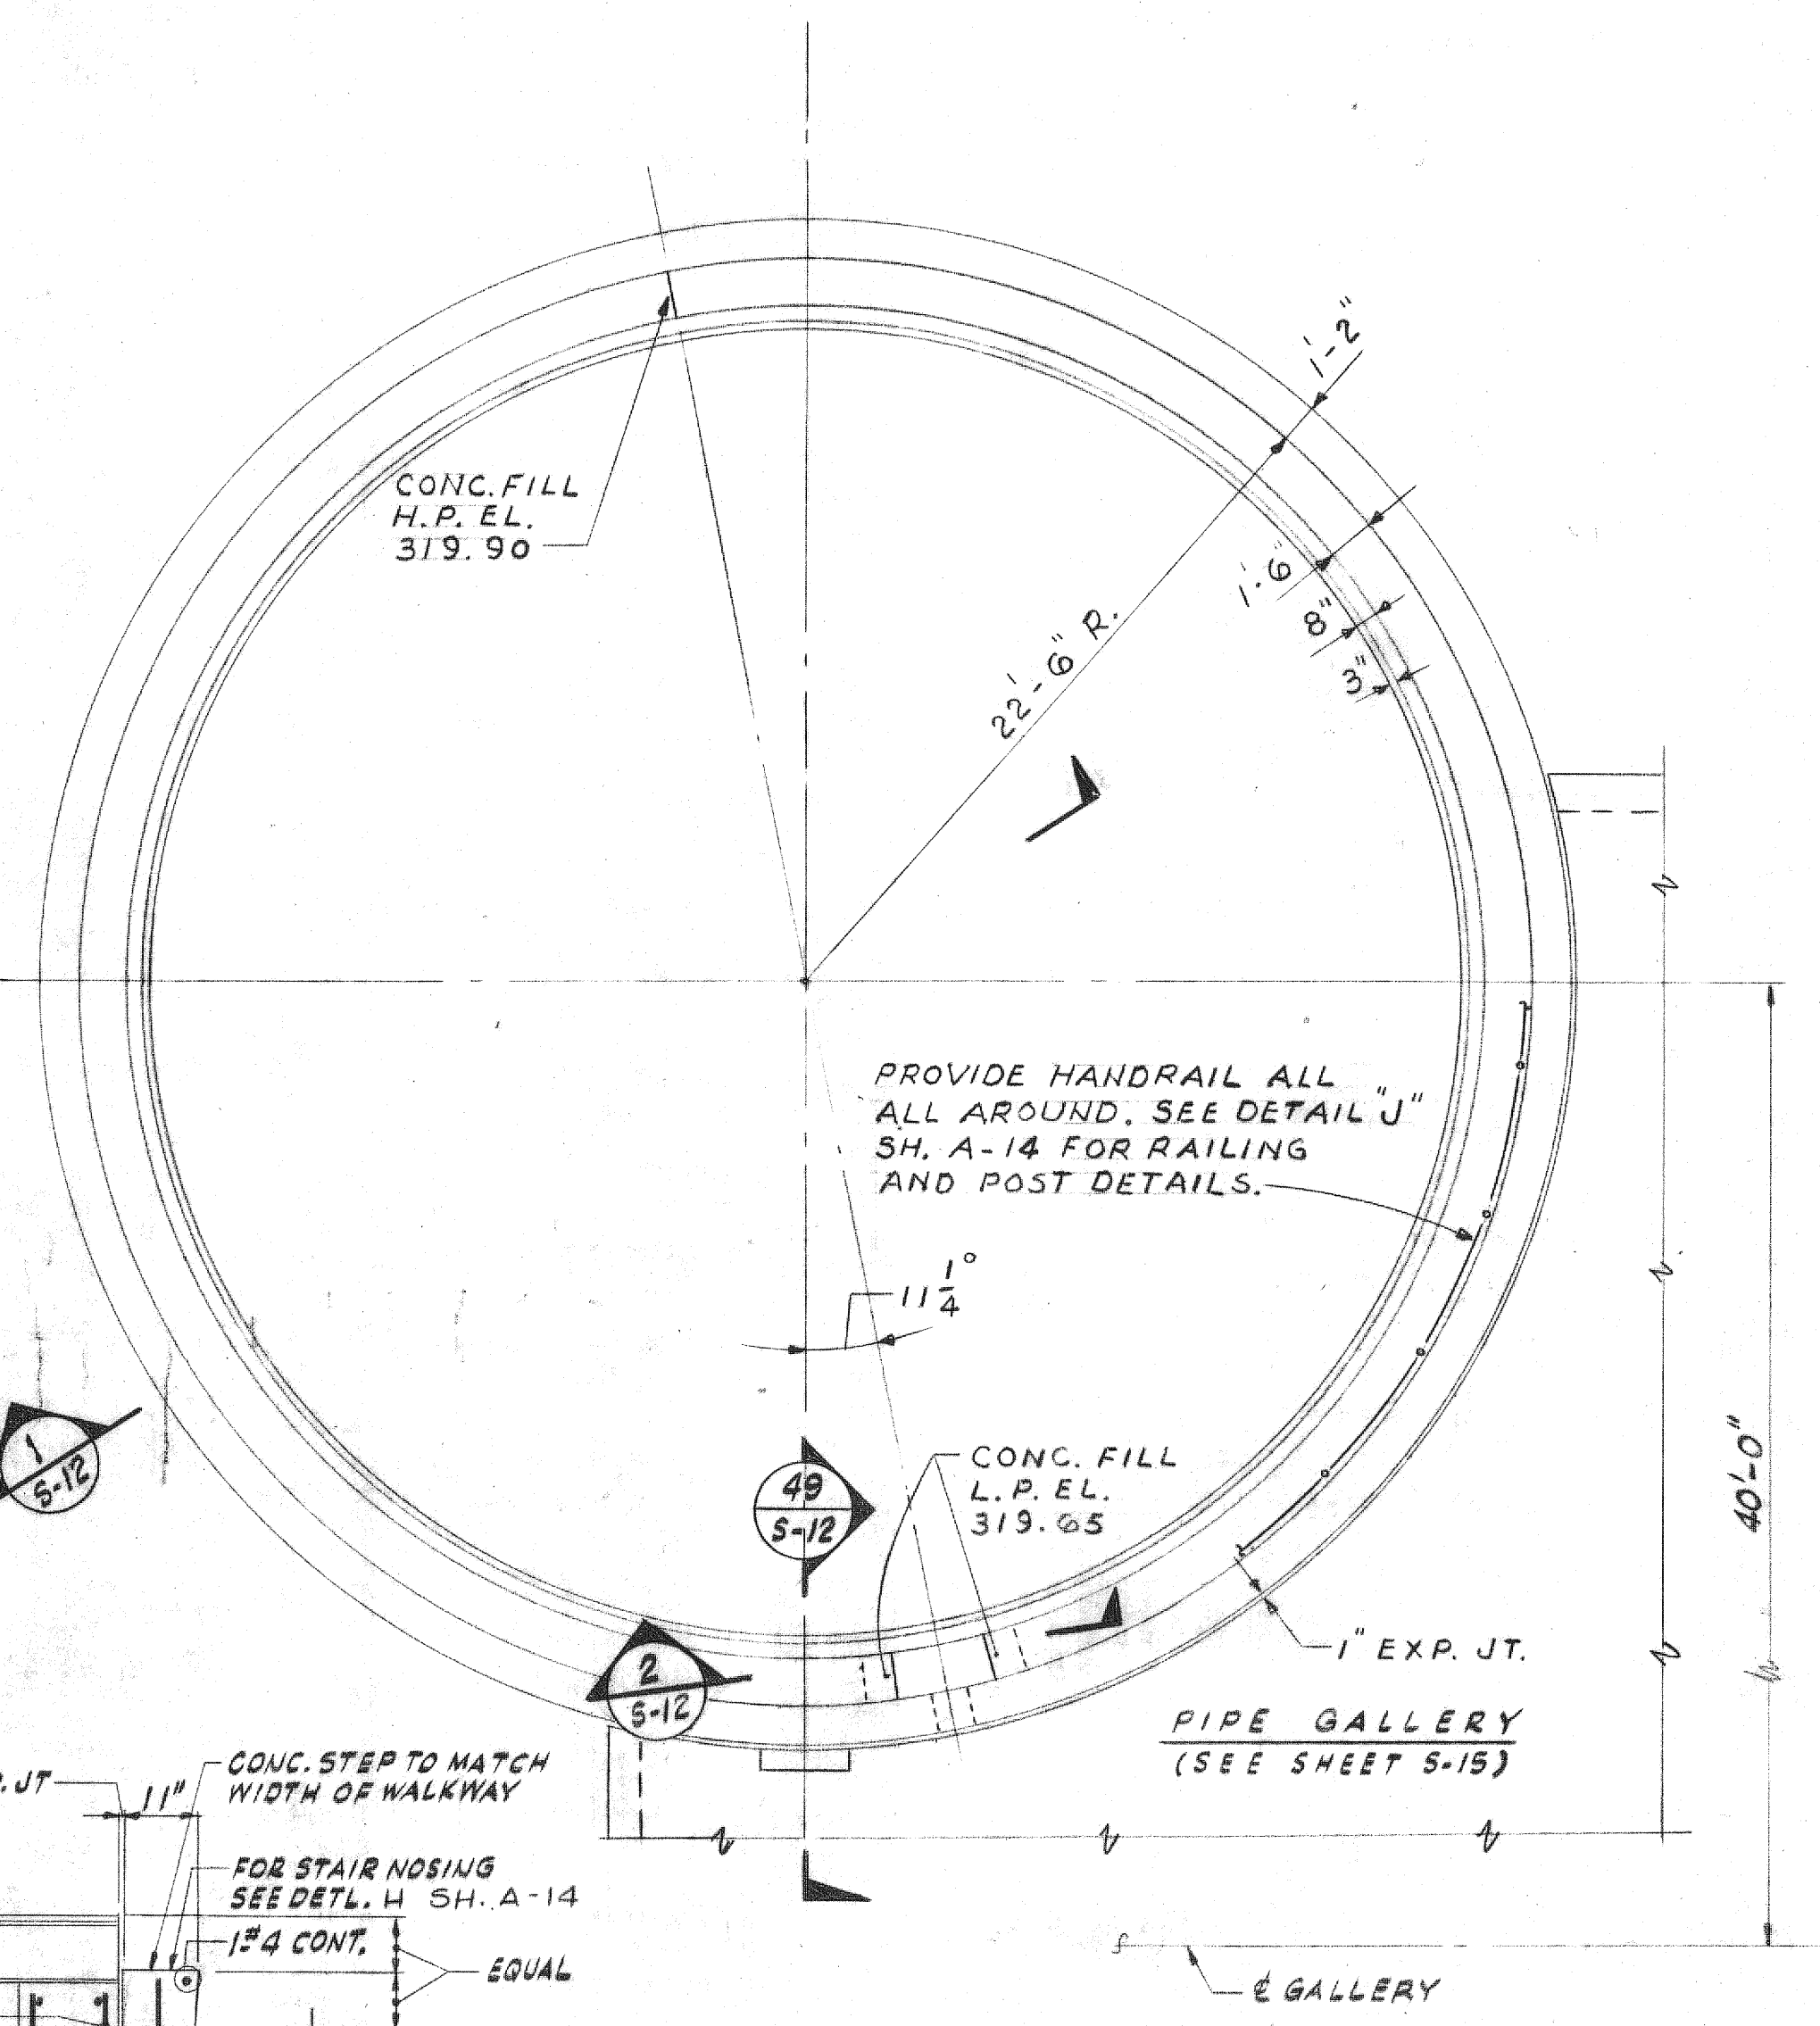


NOTE:  
ALL REINF. #4 @ 9 E.W., T & B.  
UNLESS OTHERWISE NOTED,  
DWL INTO TANK WALL.

SECTION 2  
SCALE: 3/8" = 1'-0"

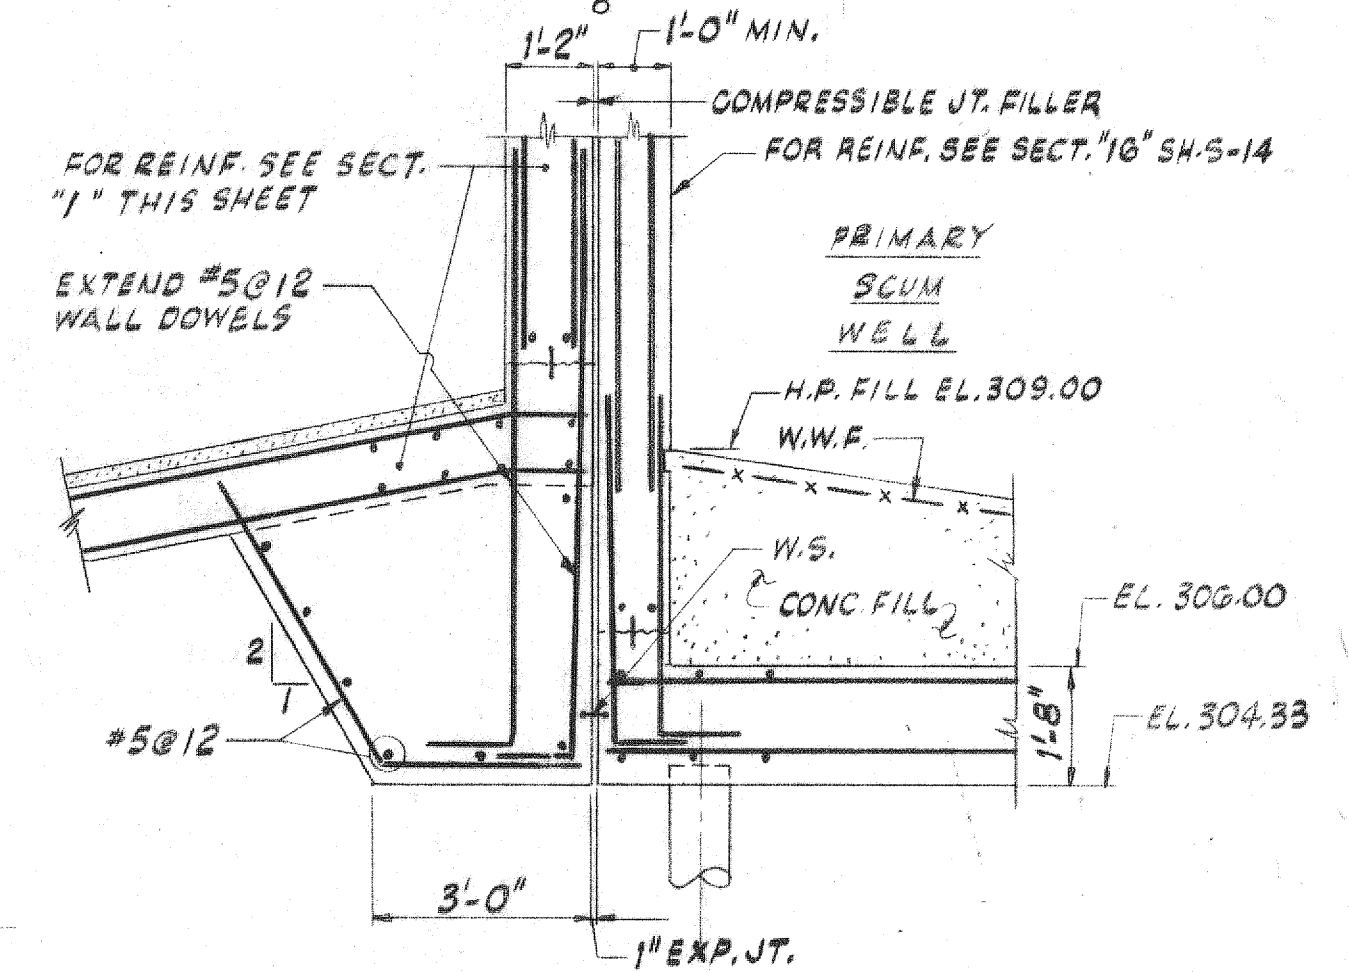


SECTION 3  
SCALE: 3/8" = 1'-0"

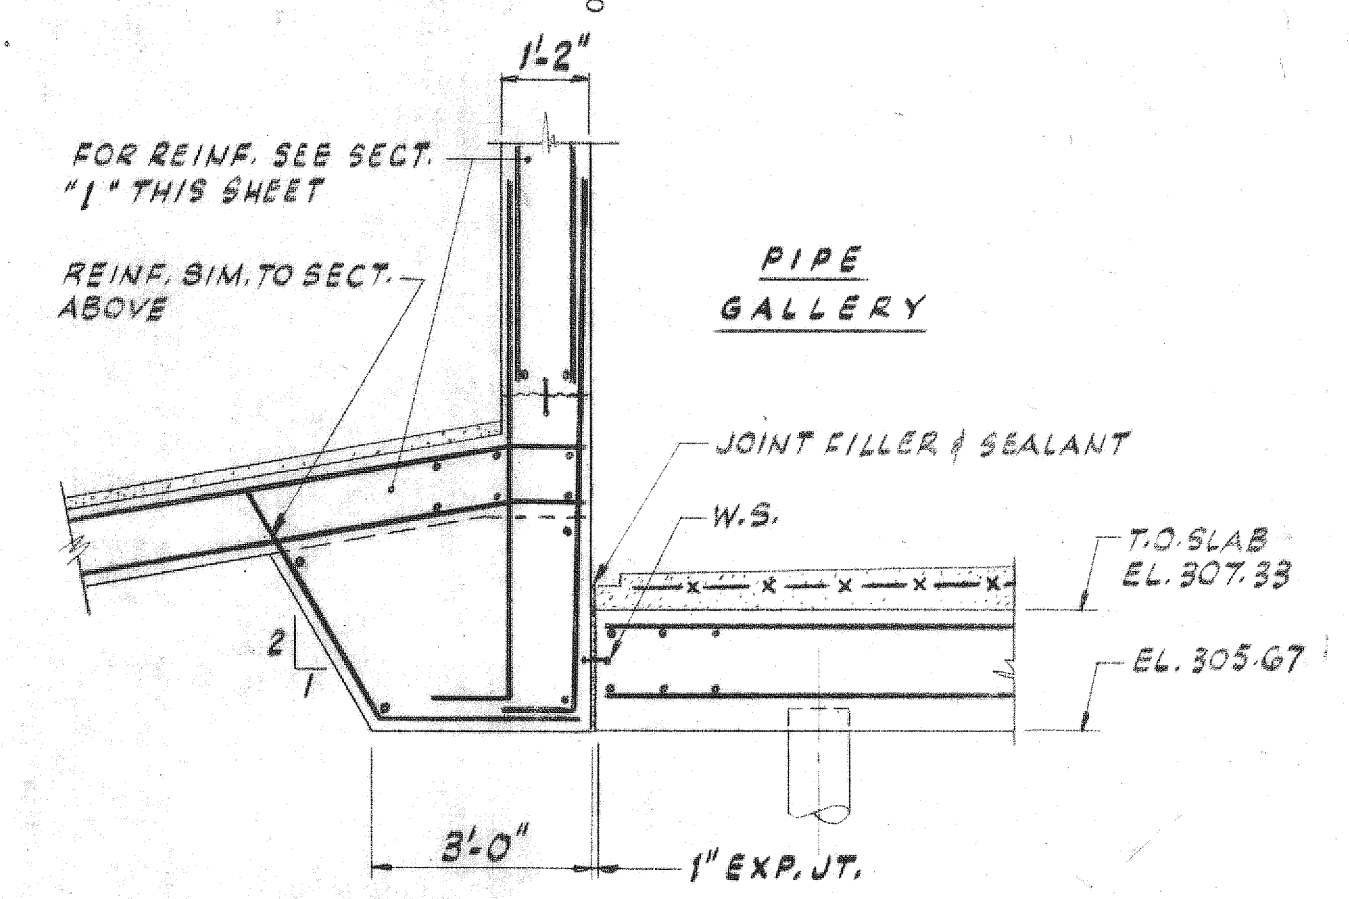


SECTION 4  
SCALE: 3/8" = 1'-0"

BOTTOM PLAN  
SCALE: 3/16" = 1'-0"

NOTE: VERT. CONST. JTS. NOT  
PERMITTED IN TANK WALLS.

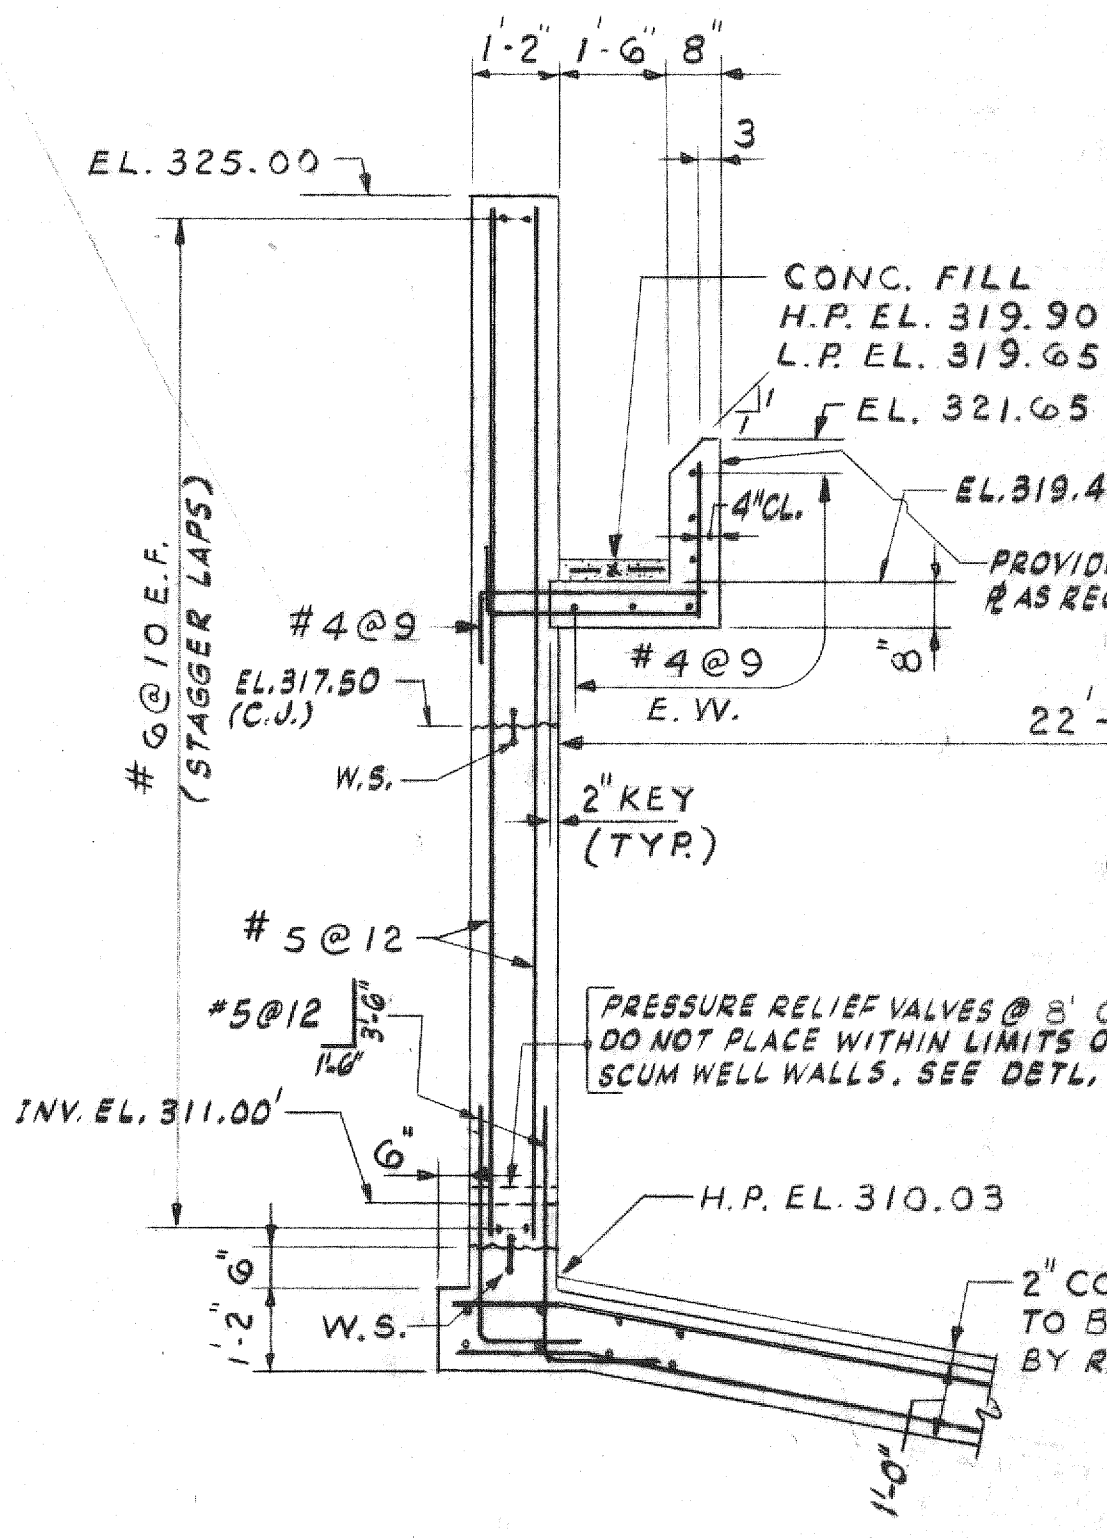


SECTION 1  
SCALE: 3/8" = 1'-0"

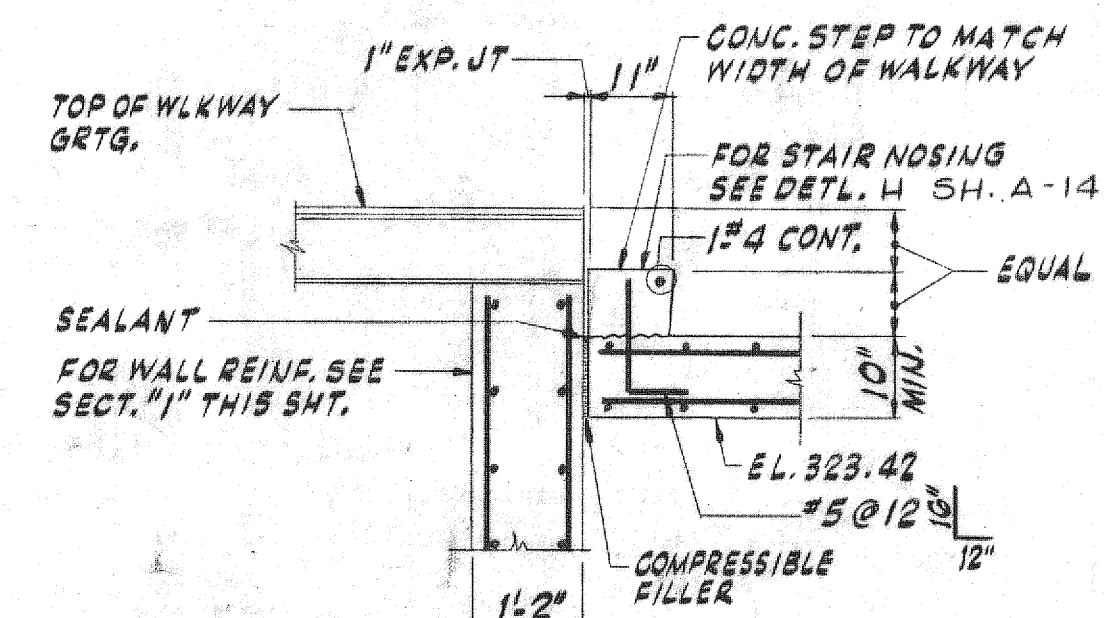

SECTION 49  
SCALE: 1/2" = 1'-0"

TOP PLAN  
SCALE: 3/16" = 1'-0"

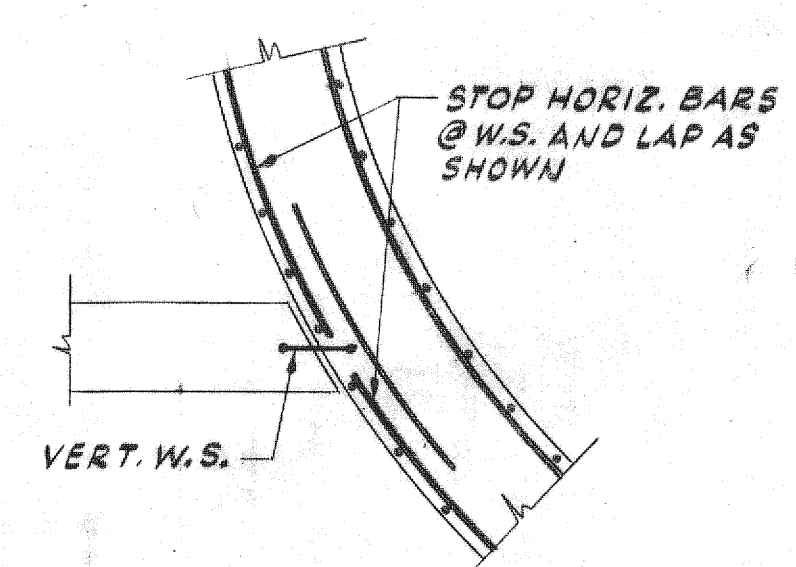


DETAIL L  
NO SCALE

# RECORD DRAWING

NUMBER	DATE	MADE BY	CHECKED BY	REVISIONS	DESCRIPTION
5-12-78	Revised			GENERAL REVISIONS	

DRAWN BY  
R. Gough  
DEPT. CHECK  
Ronald J. Brundage  
PROJ. CHECK  
G. J. Marshall

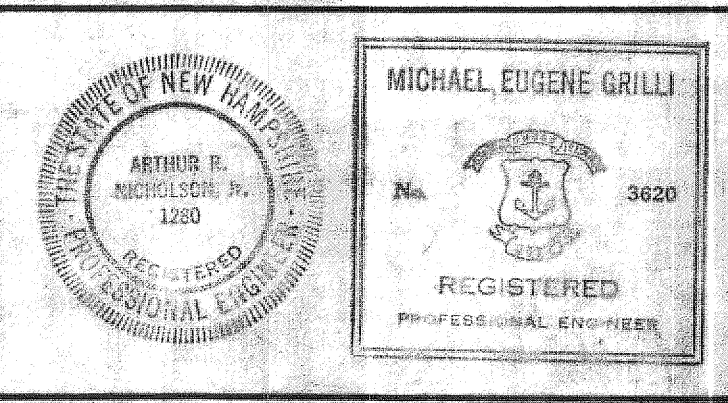

**M&E** METCALF & EDDY, INC. / ENGINEERS  
BOSTON / NEW YORK / PALO ALTO / CHICAGO  
REG. PROF. ENGR. No. 1280  
Michael E. Grillo  
REG. PROF. ENGR. No. 3820

SCALE:  
AS SHOWN  
UNLESS OTHERWISE NOTED OR CHANGED BY REPRODUCTION.

TOWN OF BURRILLVILLE, RHODE ISLAND  
BOARD OF SEWER COMMISSIONERS  
WASTEWATER TREATMENT FACILITIES  
PRIMARY SETTLING TANKS  
STRUCTURAL

JOB 4968  
FILE NO. H-69000-1  
SHEET S-12