
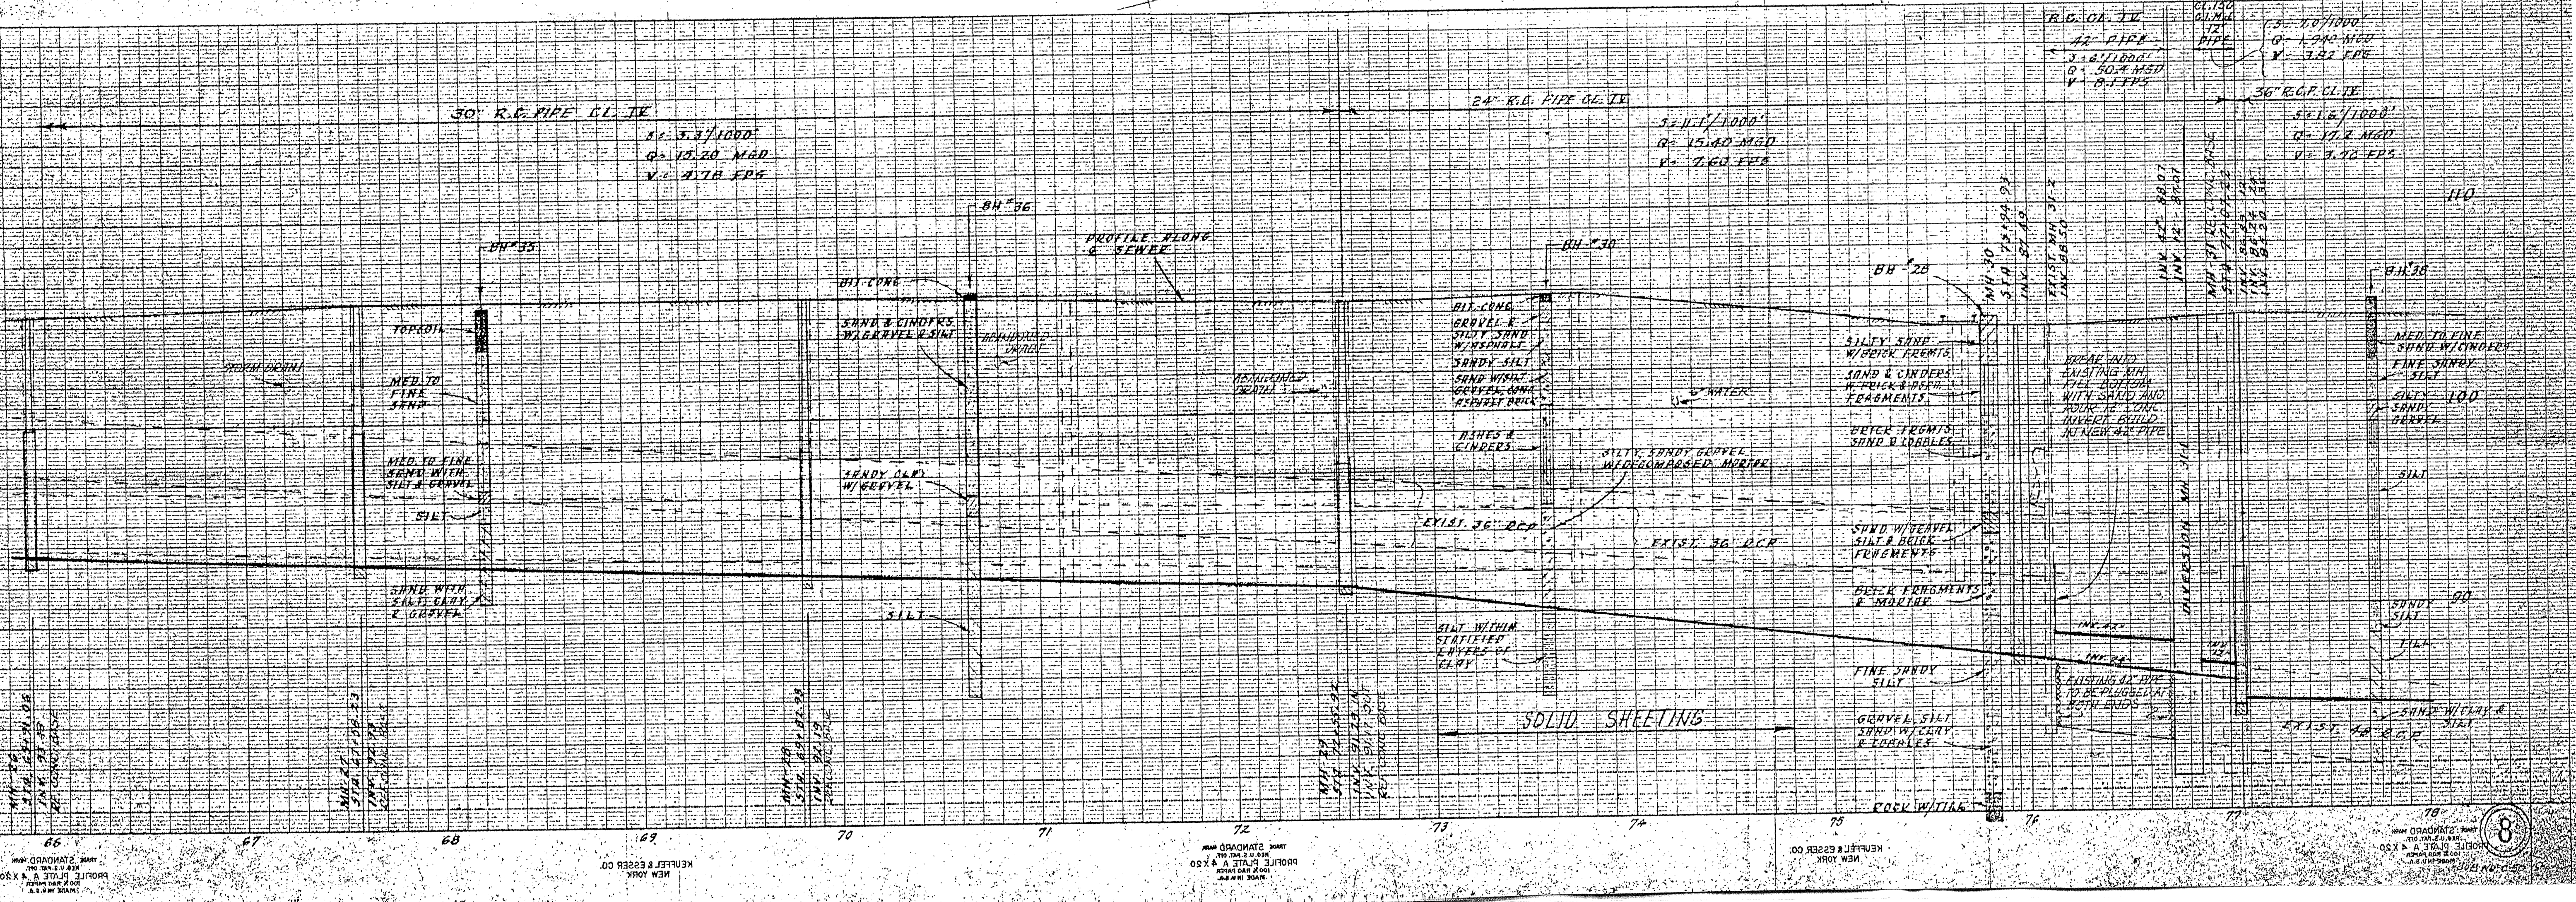


RECORD PLAN

CONTRACT NO. 4
 REFERENCE: BOOK 13 PAGES 54-56, 166-68
 CHICOPEE FALLS INDUSTRIAL AREA
 STA. 65+91 TO 77+07
 CHICOPEE RIVER
 INTERCEPTING SEWER
 CITY OF CHICOPEE, MASS.
 TIGHE & BOND, CONSULTING ENGINEERS
 HOLYOKE, MASS.
 SCALE: HORIZ. 1"=40'
 VERT. 1"=4'
 DATE: OCT., 1965

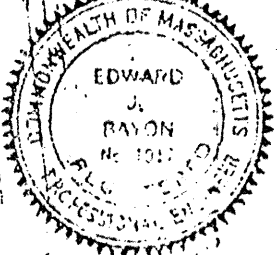

8