SHOP DRAWING REVIEW FORM AND TRANSMITTAL

DATE: November 8, 2021

TO: Carl Hendrickson **FROM:** Michael Andrus, P.E.

Project Manager
Veolia Water

BETA Group, Inc.

BETA Group, Inc.

825 West Water Street 701 George Washington Hwy Taunton, MA 02780 Lincoln, Rhode Island 02865

RE: City of Taunton, MA

WWTF Phase 1 Improvements

Contract S-2021-1

Shop Drawing No. 16080-01 – Precast Electric Manholes, FM Structure, Frames, and Covers

BETA COMMENTS:

<u>Item Action Code</u> <u>Description/Comments</u>

1 Precast Electric Manholes, FM Structure, Frames, and Covers (Shea, EJ)

- 1. See attached comments from SAR
- 2. Provide confirmation that all portions of this shop drawing are in compliance with American Iron and Steel requirements.

Action Codes

- 1 No Exception Taken
- 2 Make Corrections Noted
- 3 Amend and Resubmit
- 4 Rejected, See Remarks
- a. Installation shall proceed only when Action Code is '1' or '2'.
- b. Submittals action coded '3' shall be resubmitted within time limit set in Contract.
- c. Review does not relieve Contractor from responsibility of compliance with the Contract Documents.



Hart Engineering Corporation

SUBMITTAL: 16080-01

PROJECT: 9900. - Veolia/Taunton WWTF Phase 1 Improvements DATE: 10/05/2021

SUBMITTAL: 16080-01 - Precast Electrical Manholes, FM Structure, Frames and Covers

REVISION: 0 STATUS: Eng SPEC #: 16080

TO:

Carl Hendrickson

Veolia North America 125 S. 84th Street, Suite 175 Milwaukee, WI 53214 carl.hendrickson@veolia.com

FROM: Ryan Murphy

Hart Engineering Corporation 800 Scenic View Drive Cumberland, RI 02864 rmurphy@hartcompanies.com

Item	Revision	Description	Status	Date Sent	Date Returned	
16080-01	Eng	Precast Electrical Manholes, FM Structure, Frames and	Eng	10/05/2021		
		Covers	SHOP DRAWING REVIEW			
Notes:			1 – Approved		Approved as Noted	
			3 – Revise and Resubmit 4 - Rejected			
Additional No	otes:		5 - Record File Only - No Action Taken (Above Check Designates Action Code - See Review Comments) IMPORTANT NOTE FOR CONTRACTOR			
Status Codes 1-APP – No Exceptions Taken 2-ANR – Make Corrections Noted 3-R&R – Revise and Resubmit 4-REJ – Rejected 5-IPO – For Information Purposes Only 6-NRR – Not Required for Review ENG – Submitted to Engineer			Review is only for ger and information provi and comments made not relieve the Contra requirements of the p approval of a specific of an assembly of wh or correction of a Sho for extra work. The C and dimensions to be that pertains solely to means, methods, tech construction; coordin	neral compliance with to ided in Contract Docum on the Shop Drawings of actor from compliance will lans and specifications item shall not include a ich the item is a compo op Drawing shall be contractor is responsible confirmed and correlate to the fabrication processing action of the Work with the and performing all Work	nents. Corrections during review do vith the c. Review and/or review or approval nent. No approval astrued as an order e for: all quantities ted; information ses or to the d procedures of that of all trades	
Sincerely,	ina Corno	ration	BETA GROUP, IN	C. Checked By: 1	MC (SAR)	
Hart Engineering Corporation			By:MLA	Date:	11/8/21	
			DATE:	10/05/202	 1	



TRANSMITTAL

TO: BETA Gro	oup									
701 Georg	ge Washington Highway									
Lincoln, RI 02865										
Attention: Mike	e Andrus									
Sent by: M. Co	tter									
Date: November	er 8, 2021	SAR Job N	Jumber: 18009.00							
Reference: Tau	nton WWTF Upgrades – Phas	e 1								
☐ Enclosed He	erewith We are sending you th	e following item(s):								
□VIA	\square Print(s)	☐ Reproducible(s)	☐ Original Drawing(s)							
☐ Mail	☐ Diskette(s)	\square Report(s)	☐ Sketch (es)							
☐ Messenger	Shop Drawing(s)	☐ Specification(s)	\square Sample(s)							
☐ Express	☐ Copy of Letter	☐ Change Order	☐ Other							
☐ Email: Filen	ame:	Γime Sent AM								
Copies 1	Date	Description Submittal 16080-01 I Manholes, Frames an	REV 0 - Precast Electrical and Covers							
These are tran For approva Remarks	smitted as indicated al □ For review and com	ment X As requested	☐ For your information							
Copy to			Transmittal Enclosure							
File(s)										



Review Comments

JOB:	Taunton WWTF Upgrades – Phase 1
DATE:	November 8, 2021
SUBMITTAL NO.:	Submittal 16080-01 REV 0
SUBJECT:	Precast Electrical Manholes, Frames and Covers

	NO EXCEPTION		MAKE CORRECTIONS
	TAKEN	X	NOTED
П	REJECTED	П	REVISE AND RESURMIT

Checking is only for general conformance with the design concept of the project and general compliance with the information given in the contract documents. Any action shown is subject to the requirements of the plans and specifications. Contractor is responsible for: Dimensions which shall be confirmed and correlated at the job site fabrications process and techniques of construction; coordination of His work with that all other trades; and the satisfactory performance of his work.

SAR ENGINEERING, INC.

DATE: November 8, 2021 **BY:** M. Cotter

R-2/21/2003


Comments:

1. Coordinate the number of required conduit penetrations with the electrical contractor for both the transformer pad and handholes.

BILLING ADDRESS: 87 HAVERHILL RD, AMESBURY MA 01913

2' SQUARE AREA DRAIN

Air Release Riser

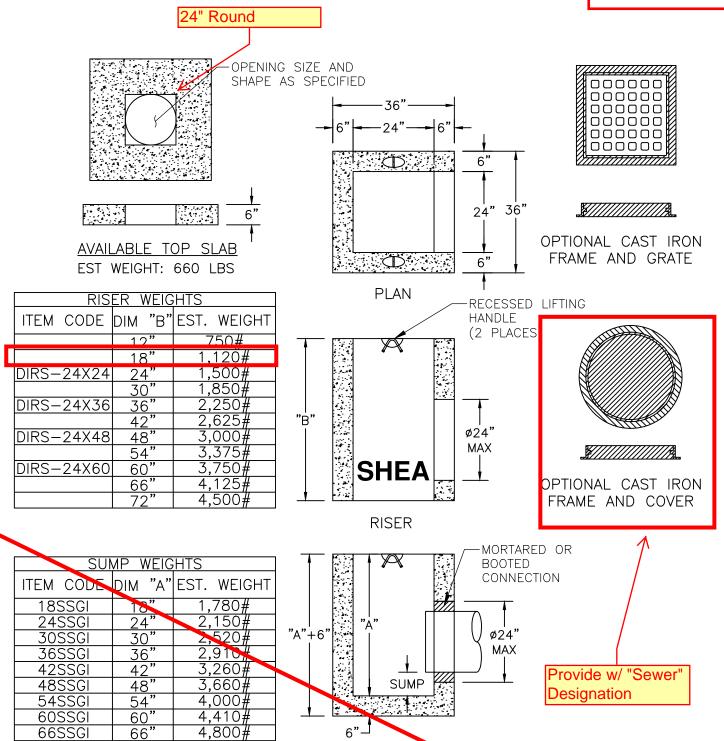

NOTES:

72SSGI

CONCRETE: 4,000 PSI MIN. AFTER 28 DAYS

5,170#

- DESIGNED FOR AASHTO HS-20 LOADING
- SUMP AS REQUIRED


66

SHEA PRODUCT ID: SEE TABLE	PREPARED FOR:	FILE NAME:	FILE NAME: 2SQAD.dwg		
WEIGHT (LBS): SEE TABLE	DRAWN BY: ARO	NTE: 06/01/18	PAGE: G9.3	CERTIFIED PLANT	
773 Salem Street-Wilmington, MA 153 Cranberry Hwy-Rochester, MA 87 Haverhill Road-Amesbury, MA 160 Old Turnpike Rd-Nottingham, NH					

BASE

2270 Cover



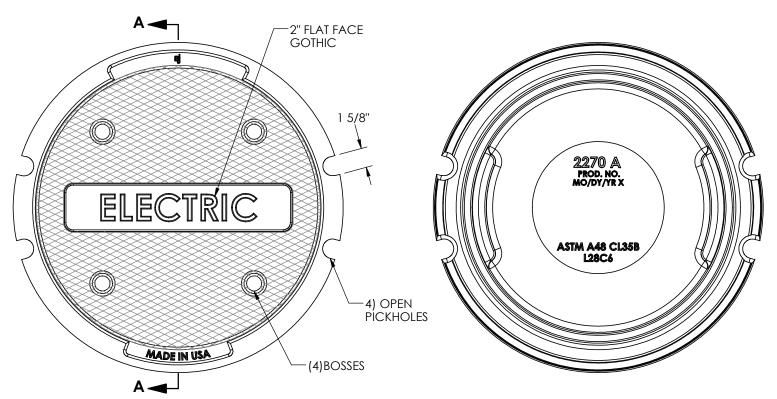

Product Number 00227029

Design Features


- -Materials
- Gray Iron (CL35B)
- -Design Load
- Extra Heavy Duty
 -Open Area
- n/a
- -Coating
- Undipped
- √ Designates Machined Surface

Certification

-ASTM A48

-Country of Origin: USA

BOTTOM VIEW

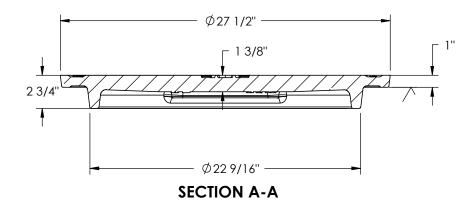

Drawing Revision

3/9/2010 Designer: JIJ 9/10/2013 Revised By: DAE

Disclaimer

Weights (lbs/kg), dimensions (inches/mm) and drawings provided for your guidance. We reserve the right to modify specifications without prior notice.

CONFIDENTIAL: This drawing is the property of EJ Group, Inc. and embodies confidential information, registered marks, patents, trade secret information, and/or know how that is the property of EJ Group, Inc. Copyright © 2011 EJ Group, Inc. All rights reserved.


Contact


800 626 4653

ejco.com

2274Z1 Frame



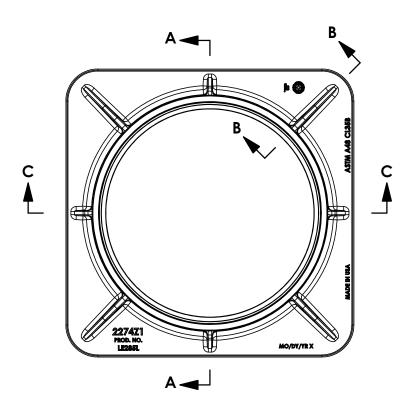

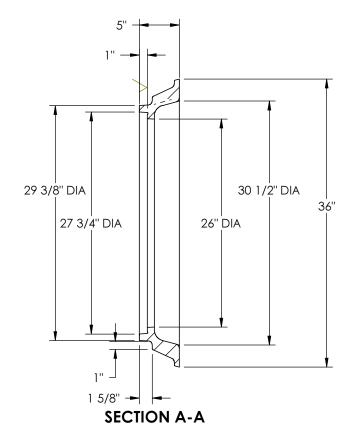


Product Number 00227415


Design Features

- -Materials
- Gray Iron (CL35B)
- -Design Load
- Extra Heavy Duty
 -Open Area
- n/a
- -Coating
- Undipped
- √ Designates Machined Surface

Certification

- -ASTM A48
- -Country of Origin: USA

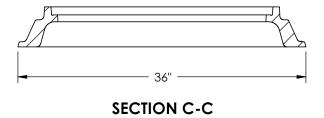

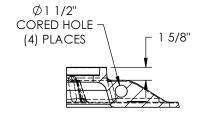

SECTION B-B

Drawing Revision

10/15/2013 Designer: MAH 5/30/2017 Revised By: CSF

Disclaimer

Weights (lbs/kg), dimensions (inches/mm) and drawings provided for your guidance. We reserve the right to modify specifications without prior notice.


CONFIDENTIAL: This drawing is the property of EJ Group, Inc. and embodies confidential information, registered marks, patents, trade secret information, and/or know how that is the property of EJ Group, Inc. Copyright © 2012 EJ Group, Inc. All rights reserved.

Contact

800 626 4653

ejco.com

MAILING ADDRESS: 87 HAVERHILL RD AMESBURY, MA 01913

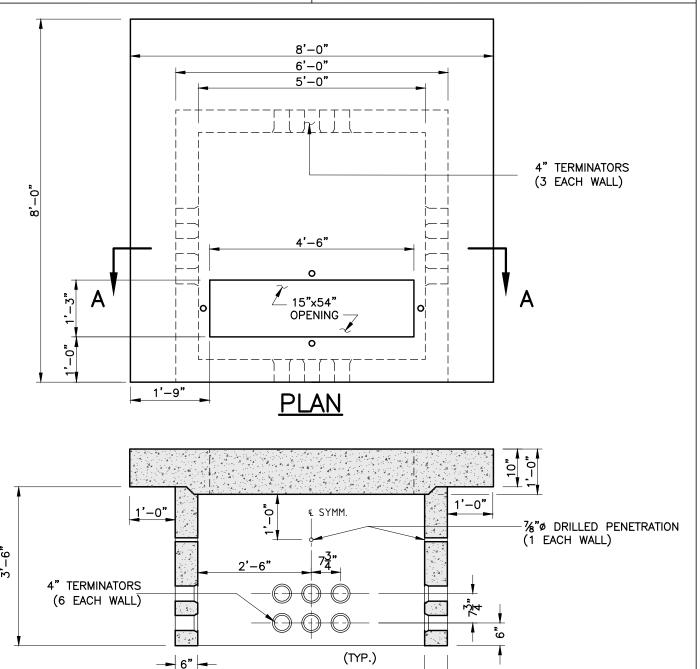

5'-0" 6'-0"

TYPICAL WALLS ELEVATION


NOTES:


- 1. CONCRETE: 5,000 PSI MINIMUM AFTER 28 DAYS.
- 2. DESIGN LOADING: AASHTO HS20-44, 0 TO 5 FEET COVER.
 3. DESIGN SPECIFICATIONS ACI 318 & AASHTO LOAD FACTOR DESIGN METHOD.
- 4. STEEL REINFORCEMENT CONFORMS TO ASTM A615, GRADE 60. MINIMUM STEEL COVER 1 ½".
- 5. ALL TERMINATORS SHALL HAVE BELL ENDS FLUSH WITH THE INSIDE WALL.

SHEA PRODUCT ID:	NSM3801-2	FILE NAME:	E	ES-MA 3801-2 >	KFMR VAULT	
WEIGHT (LBS):	14865	DRAWN BY:	L.P.	DATE: 12/19/2017	PAGE: II.D.5	CERTIFIED PLANT
773 Salem Str	reet-Wilmington, MA 1	53 Cranberry	Hwy-Rochester, M	A 87 Haverhill Road—Amesbur	ry, MA 160 Old Turnpike Rd-	-Nottingham, NH



MAILING ADDRESS: 87 HAVERHILL RD AMESBURY, MA 01913

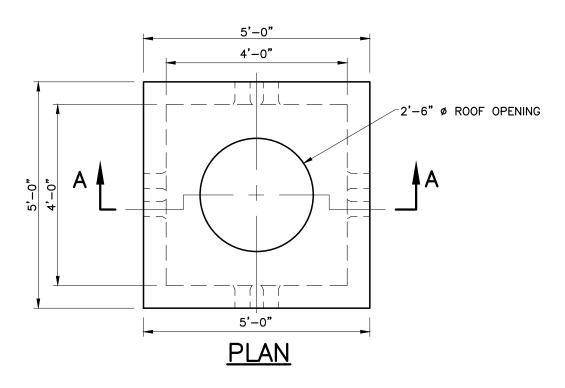

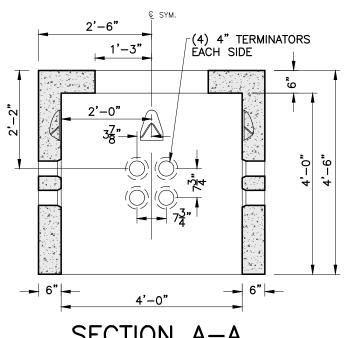

NOTES:

- CONCRETE: 5,000 PSI MINIMUM AFTER 28 DAYS.
 DESIGN LOADING: AASHTO HS-20-44, 0 TO 5 FEET COVER.
 STEEL REINFORCEMENT CONFORMS TO ASTM A615, GRADE 60.
- MINIMUM STEEL COVER 1".
 OPTIONAL OPENINGS AVAIL OPTIONAL OPENINGS AVAILABLE BY SPECIAL ORDER.

SHEA PRODUCT	D: HH-444	FILE NAME:		HANDHOLE 48X48		
WEIGHT (LBS):	6675	DRAWN BY:	L.P.	DATE: 11/13/2018 PAGE	I .B.6	CERTIFIED PLANT
773 Salem	Street-Wilmington, MA 1	53 Cranberry	Hwy-Rochester, N	MA 87 Haverhill Road—Amesbury, N	MA 160 Old Turnpike Rd-	Nottingham, NH

OPEN BOTTOM