

PREPARED BY

REGISTERED PROFESSIONAL



SUBCONSULTANT



PROJECT

Taunton Wastewater Treatment Facility Improvements Solids Handling

Taunton, MA

TITLE

Plumbing Demolition Solids Handling **Building First** Floor Plan

AS RE-ISSUED PER ADDENDUM #2

| 10. | F | REVISIONS | DATE |
|--------------|---|------------|------|
| DRAWN BY: | | RLB | |
| DESIGNED BY: | | RLB | |
| CHECKED BY: | | JL | |
| ISSUE DATE: | | 10/16/2020 | |


BETA JOB NO.: SCALE

AS SHOWN

6050

SHEET NO.

P-7.1

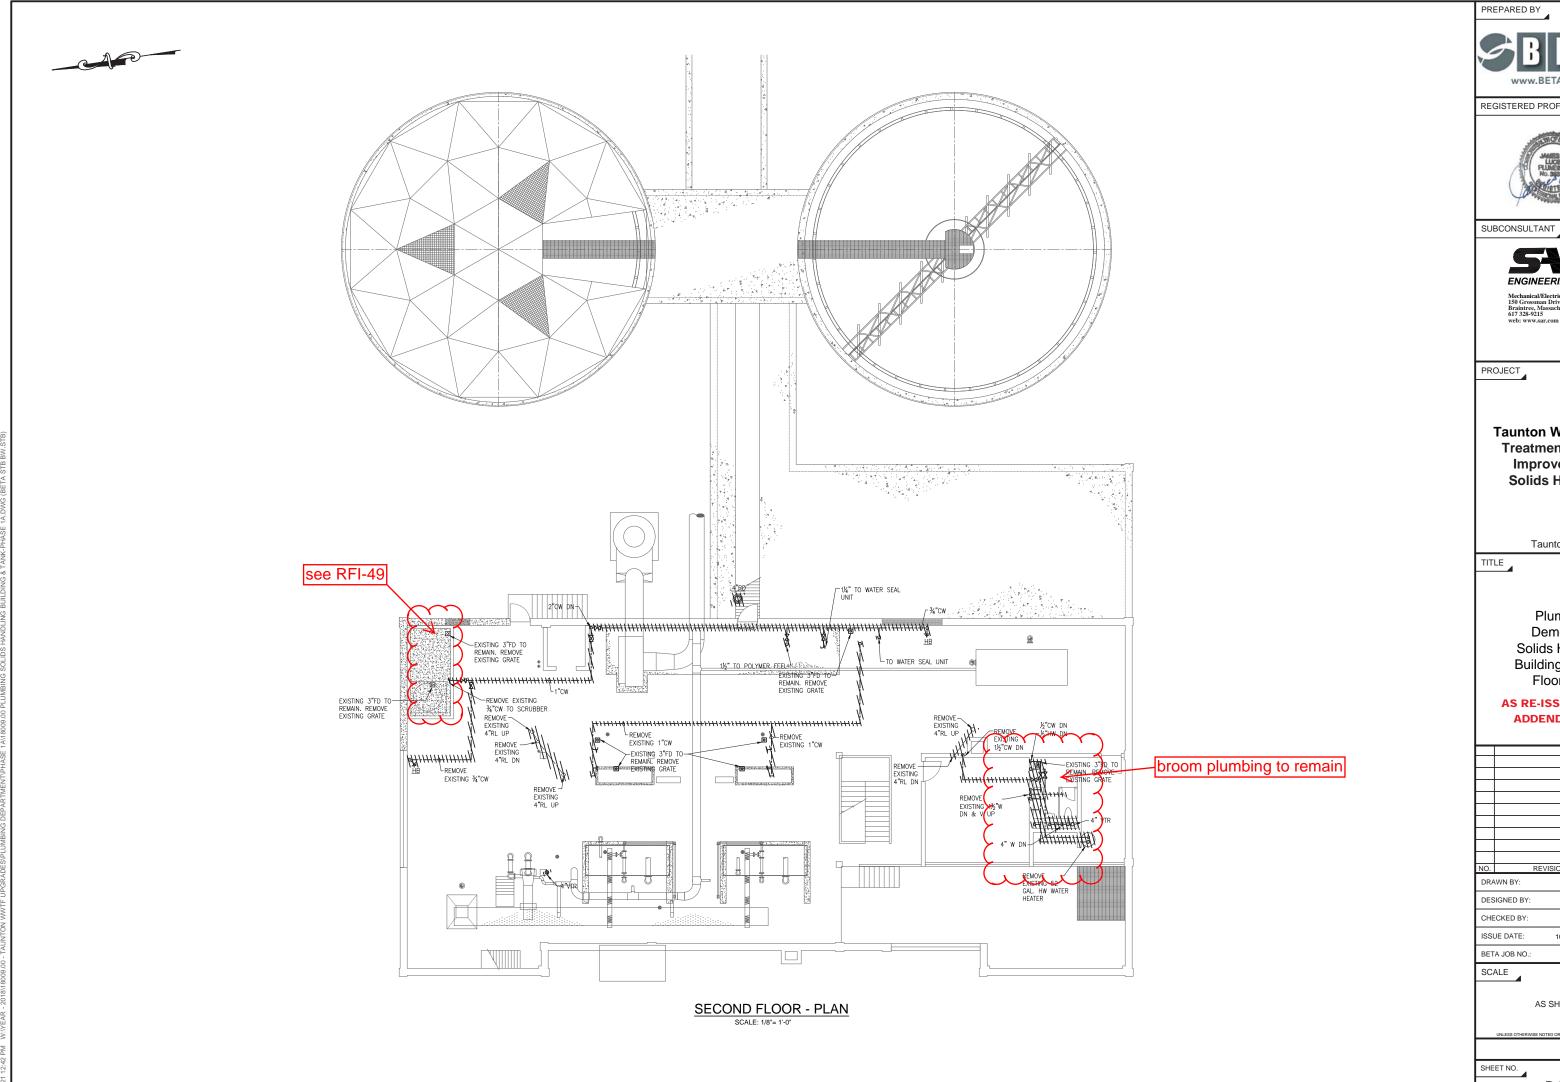

REGISTERED PROFESSIONAL





Taunton Wastewater Treatment Facility Improvements **Solids Handling**

Taunton, MA

Plumbing Demolition Solids Handling Building Second Floor Plan


AS RE-ISSUED PER ADDENDUM #2


| NO. | | REVISIONS | DATE |
|--------------|--|------------|------|
| DRAWN BY: | | RLB | |
| DESIGNED BY: | | RLB | |
| CHECKED BY: | | JL | |
| ISSUE DATE: | | 10/16/2020 | |
| | | | |

AS SHOWN

6050

P-7.2

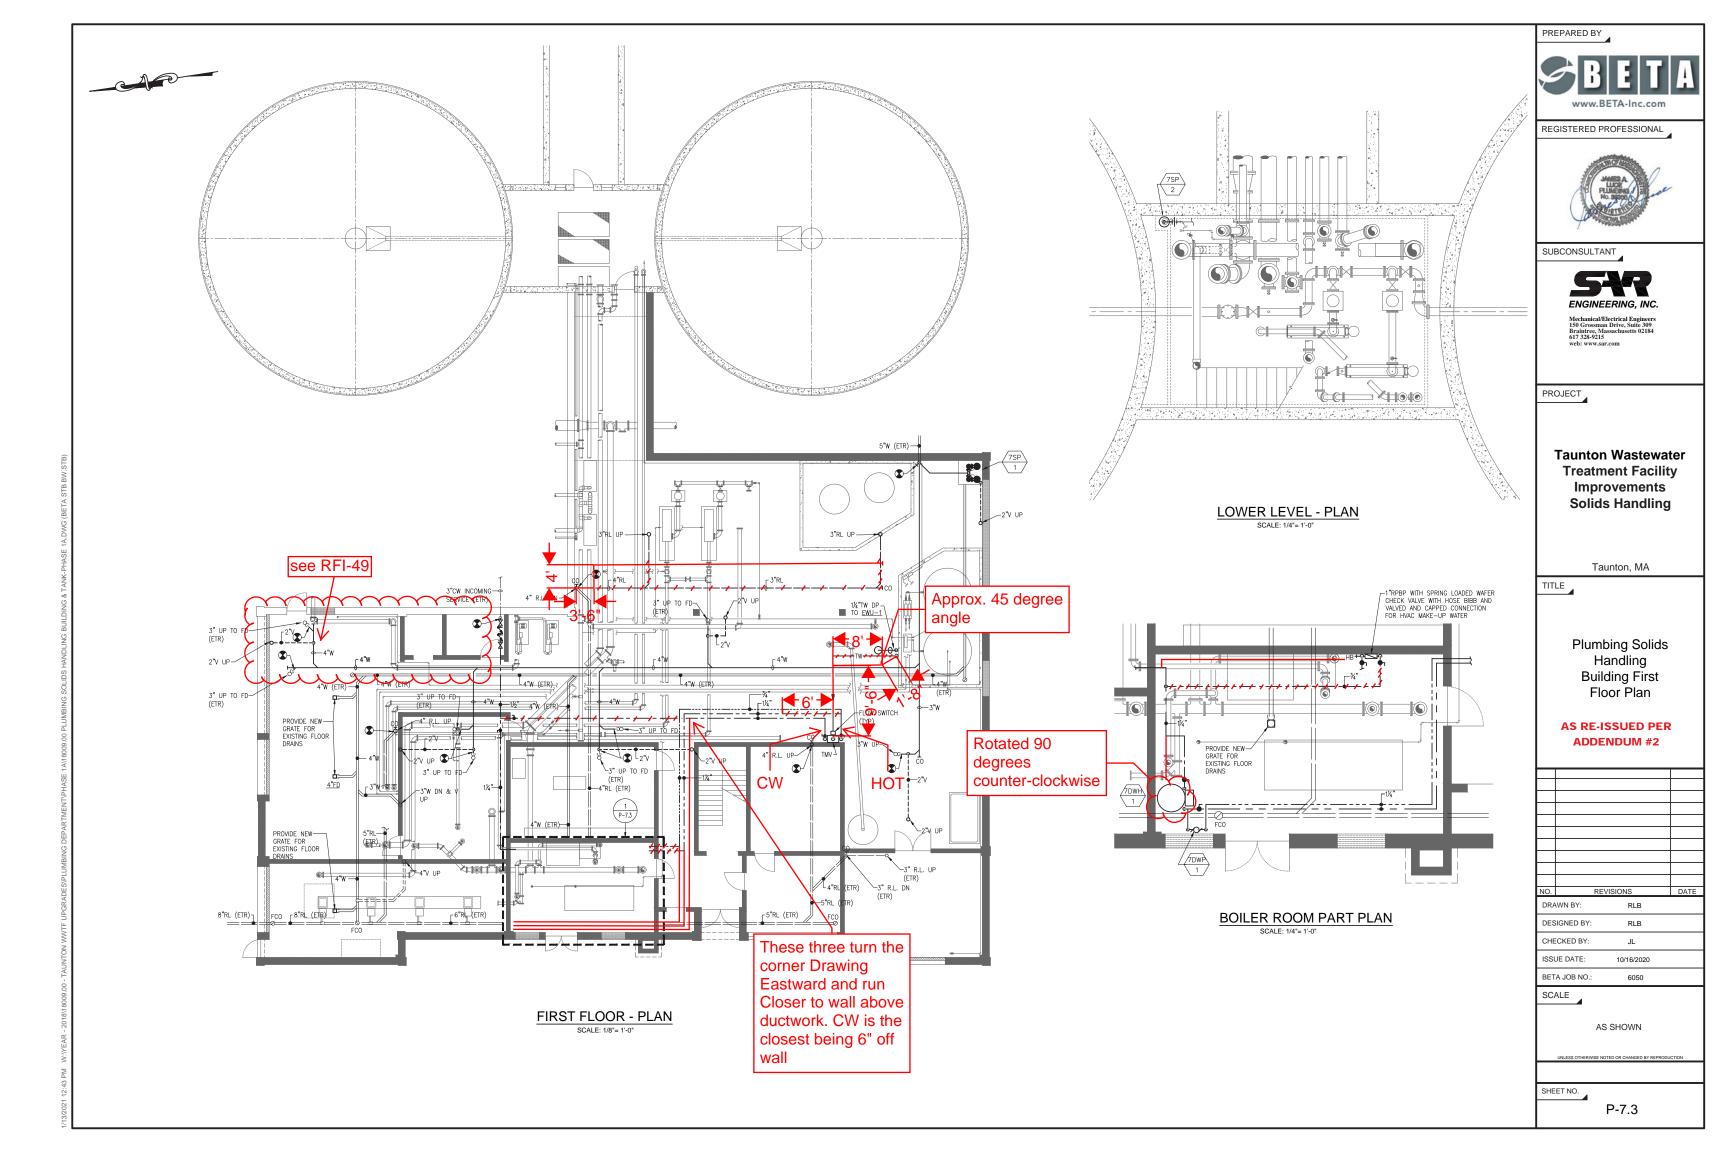

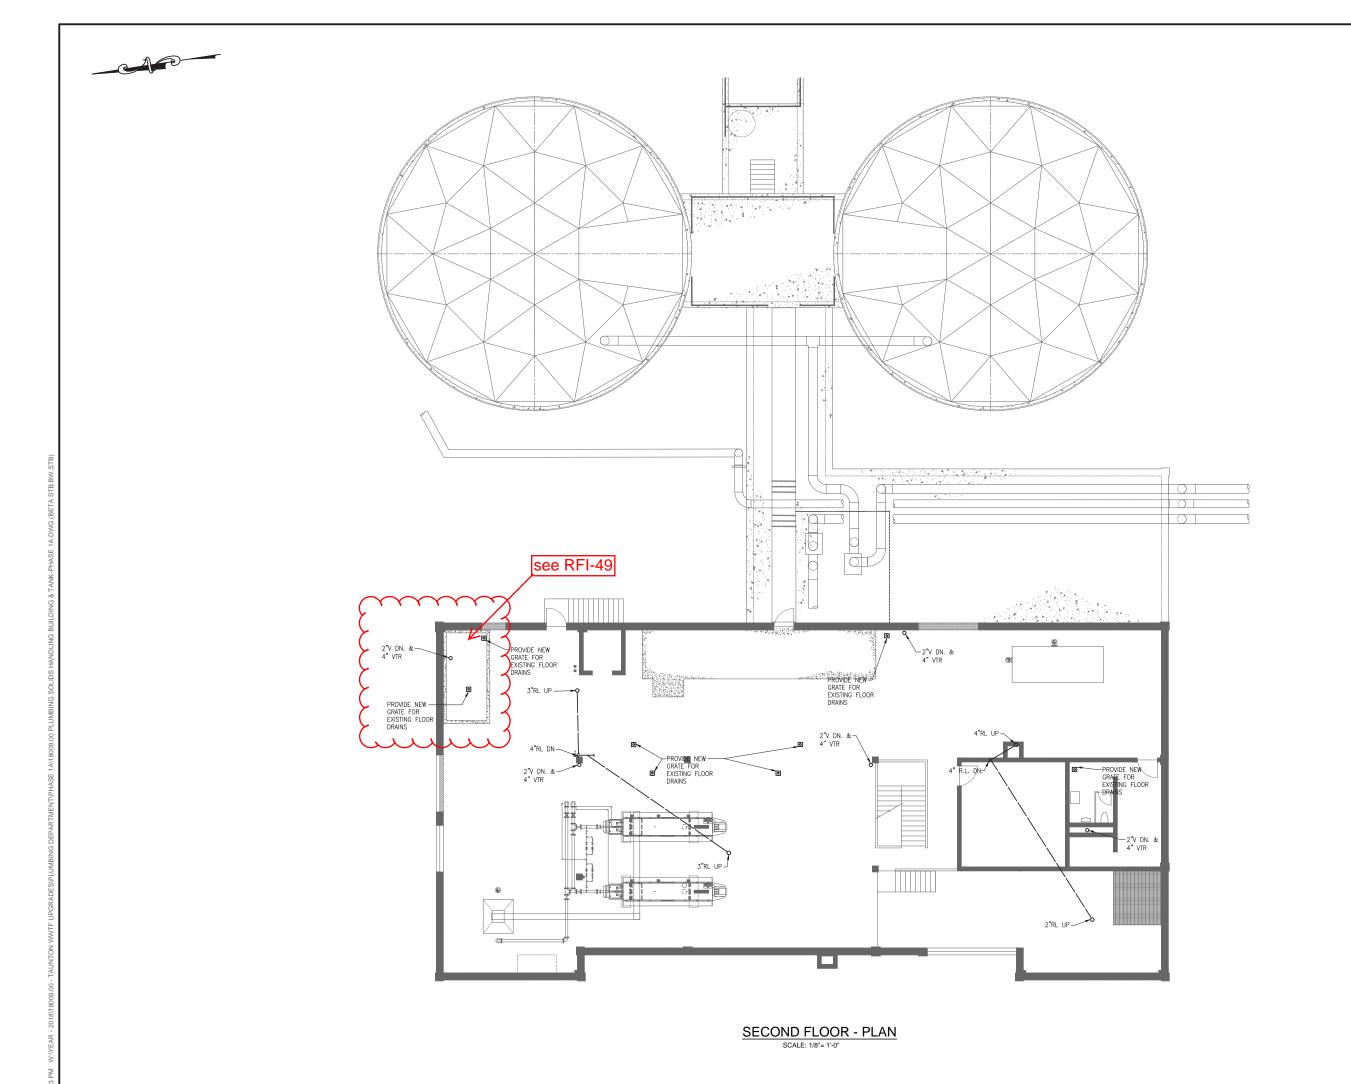

PREPARED BY



REGISTERED PROFESSIONAL



SUBCONSULTANT



PROJECT

Taunton Wastewater Treatment Facility Improvements **Solids Handling**

Taunton, MA

TITLE

Plumbing Solids Handling Building Second Floor Plan

AS RE-ISSUED PER ADDENDUM #2

| NO. | | REVISIONS | DATE |
|--------------|--|------------|------|
| DRAWN BY: | | RLB | |
| DESIGNED BY: | | RLB | |
| CHECKED BY: | | JL | |
| ISSUE DATE: | | 10/16/2020 | |

BETA JOB NO.: SCALE

AS SHOWN

6050

P-7.4

SHEET NO.