

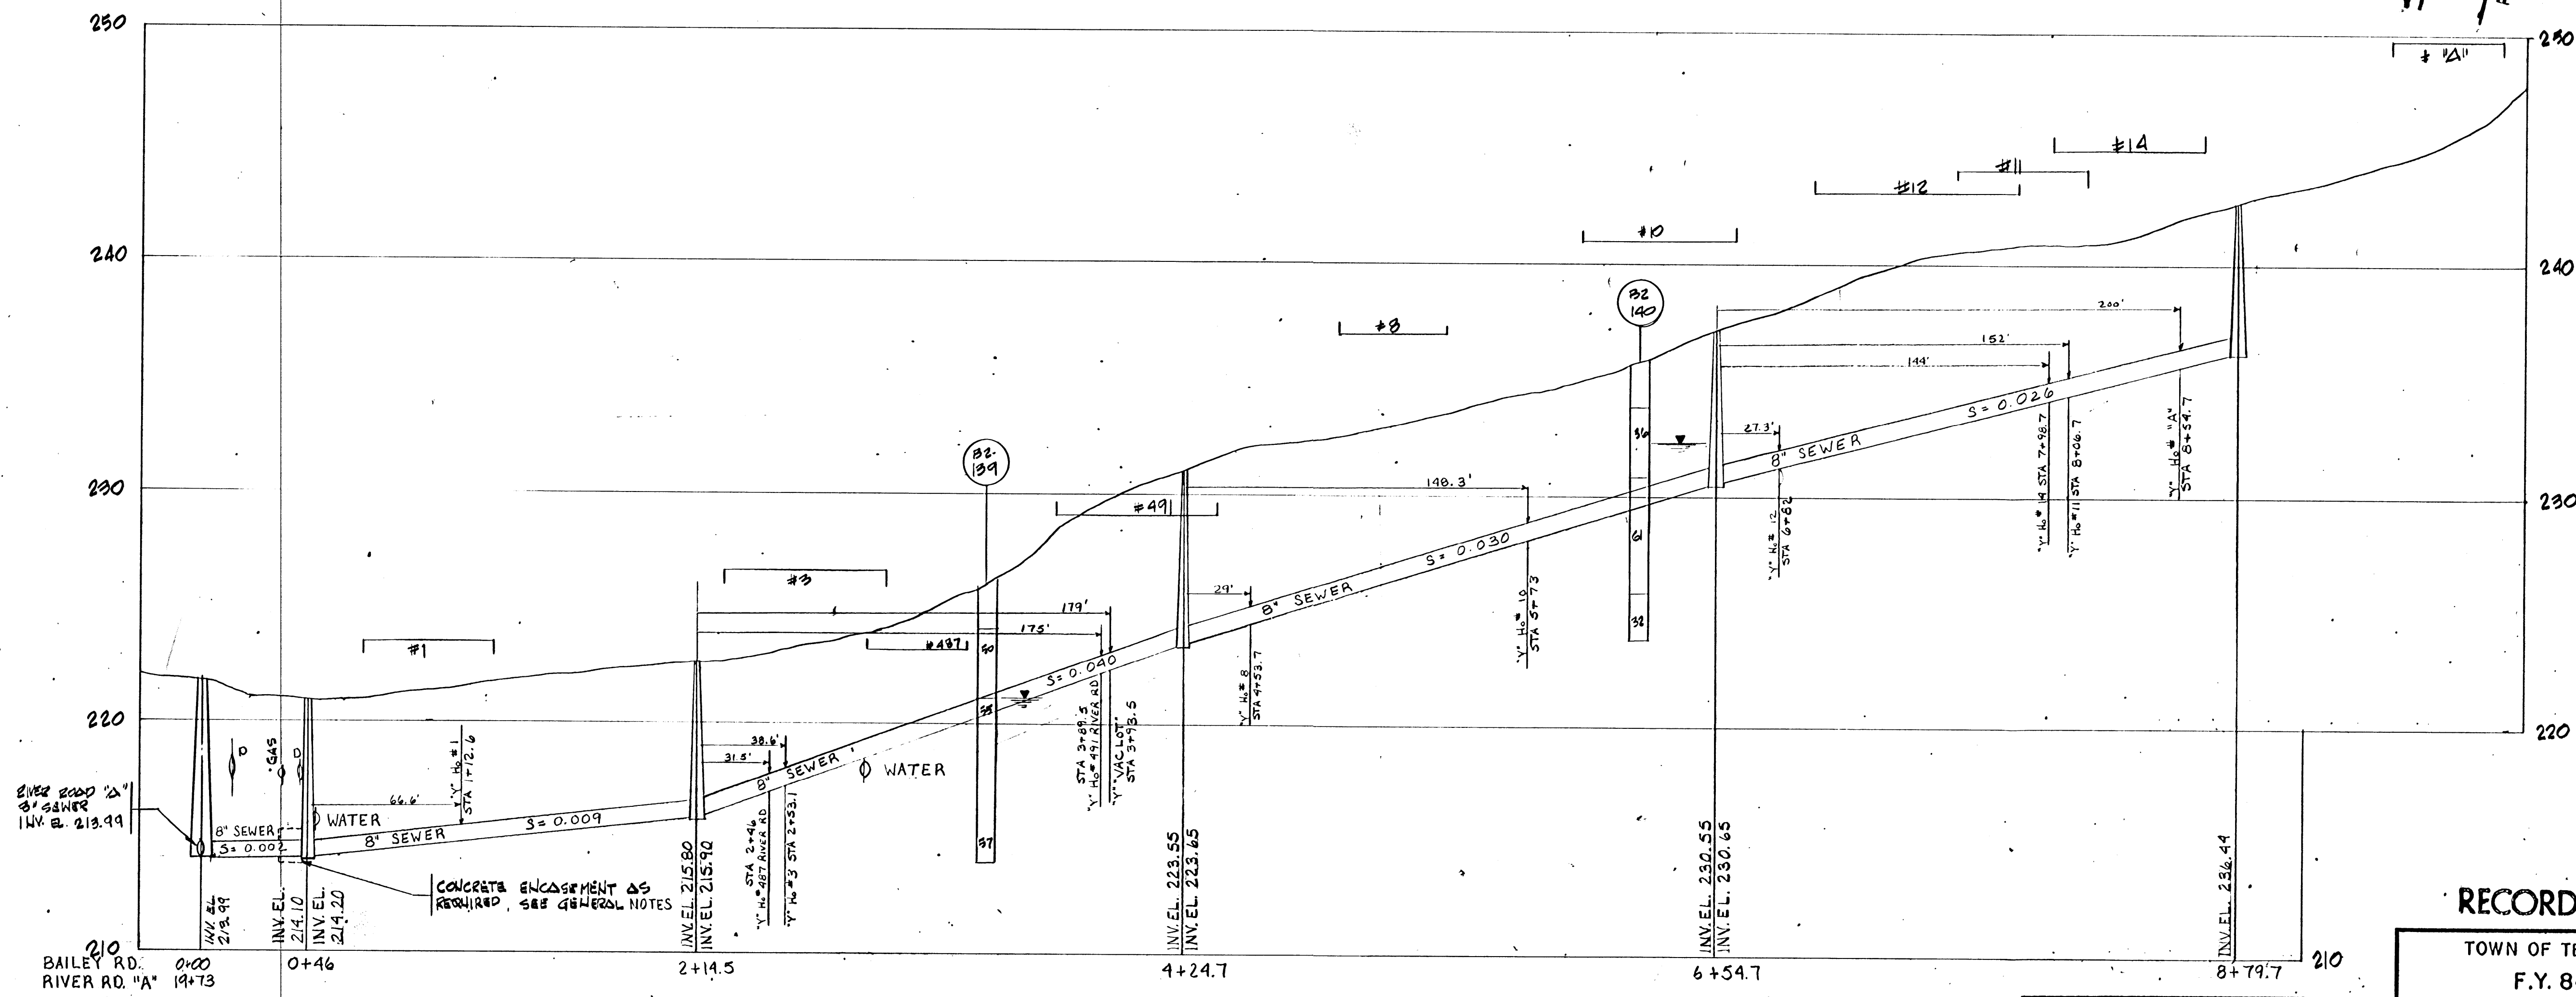


ARCHITECTURAL	STRUCTURAL	ELECTRICAL	INSTRUMENTATION	HVAC	PLUMBING	PROJECT ENGINEER	PROJECT MANAGER
Approved by: _____	Approved by: _____	Approved by: _____	Approved by: _____	Approved by: _____	Approved by: _____	Approved by: _____	Approved by: _____
Date: _____	Date: _____	Date: _____	Date: _____	Date: _____	Date: _____	Date: _____	Date: _____

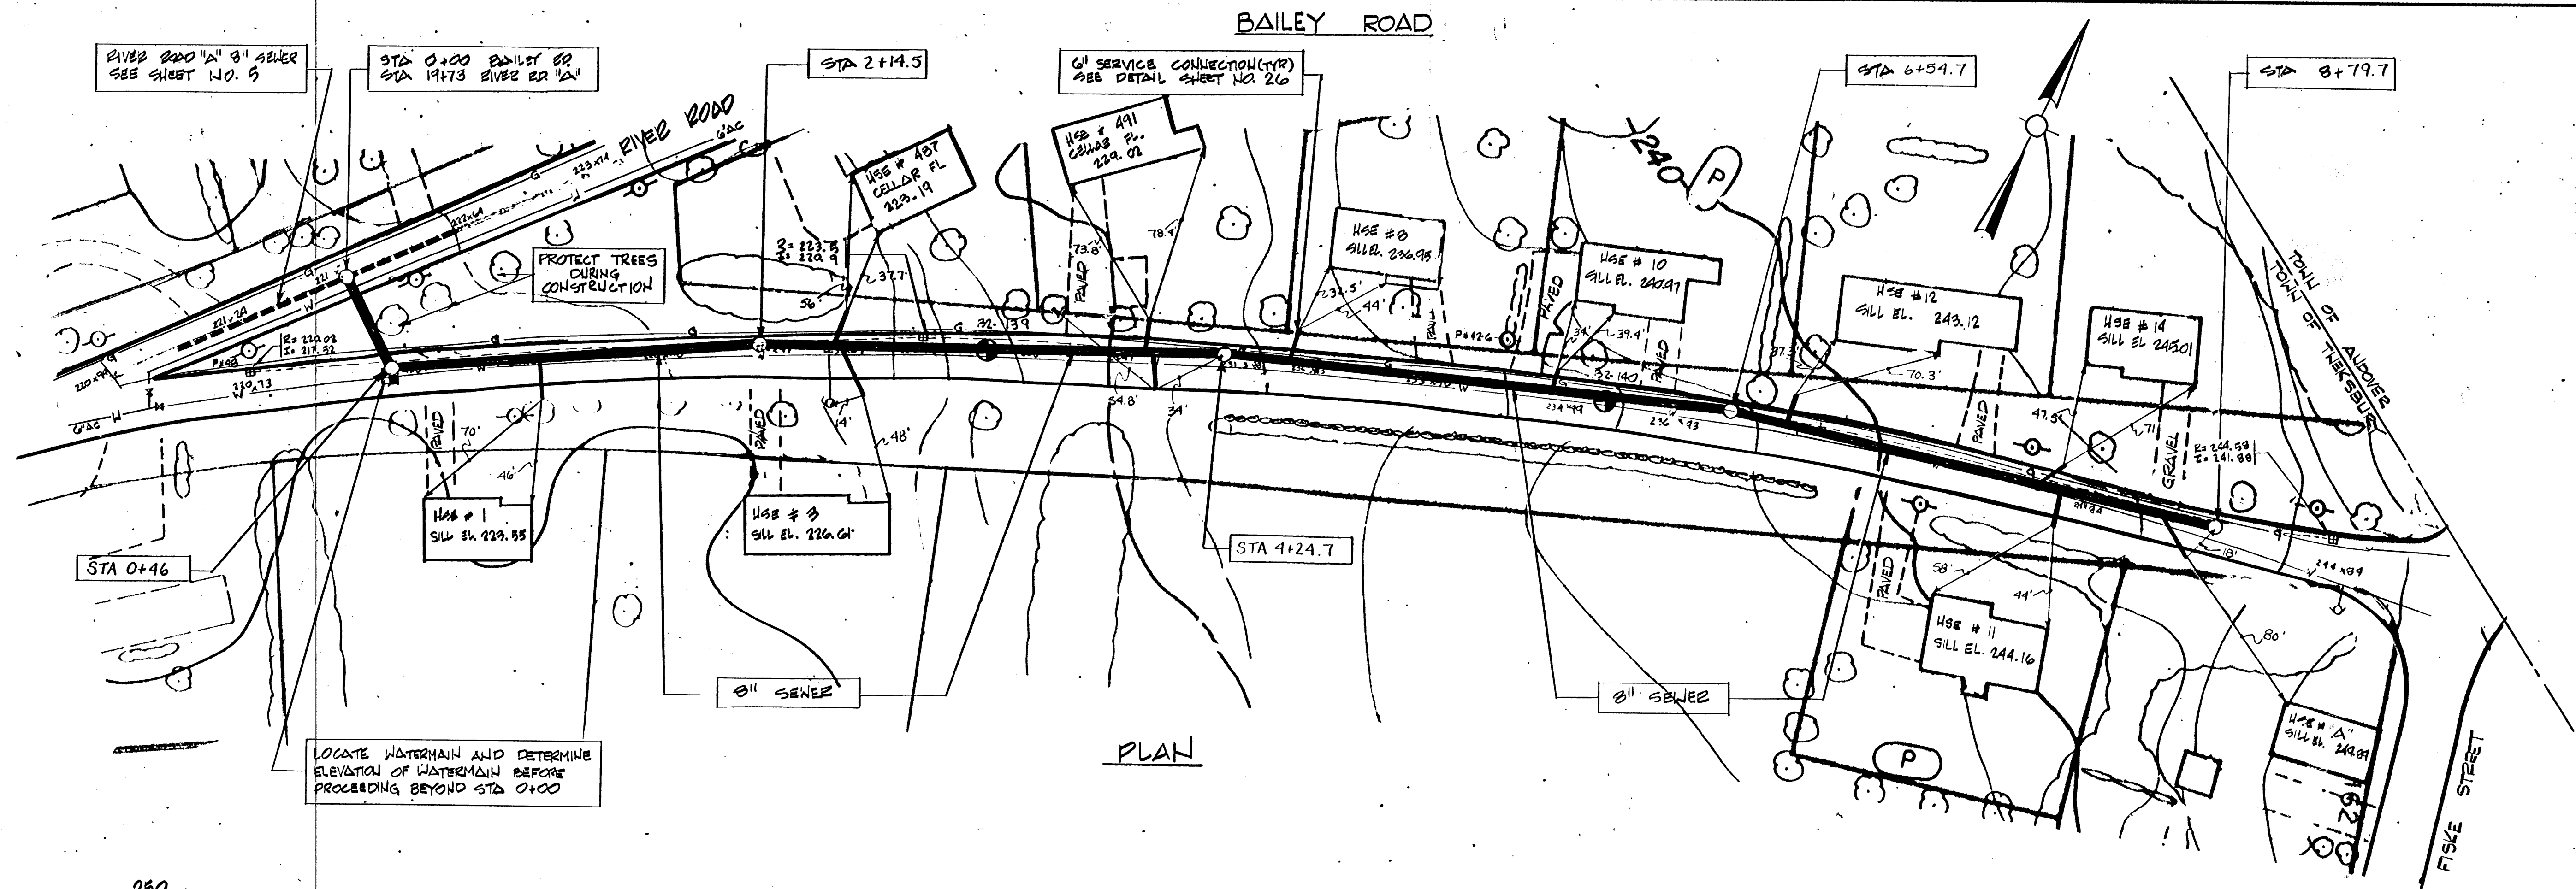

PROFILE

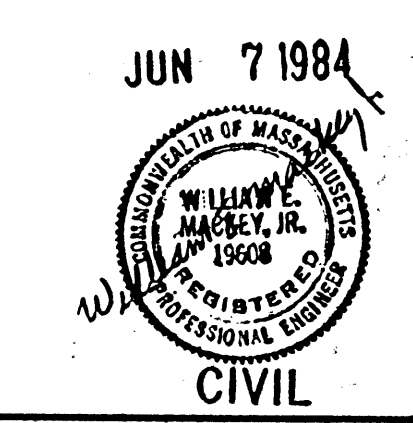

Date	CH'K'D.	Revision
7/88		REVISED FOR RECORD
Designed by: PNP		
Drawn by: SDR		
Checked by: WEI		
Approved by: _____		
Date: APRIL 1984		
Scale: HORIZ. 1" = 40'		
Scale: VERT. 1" = 4'		

**RECORD DRAWING**

TOWN OF TEWKSBURY, MASSACHUSETTS  
F.Y. 84 LATERAL SEWERS

CONTRACT NO. 13

**BAILEY ROAD**

**CAMP DRESSER & McKEE INC.**  
One Center Plaza  
Boston, Massachusetts 02108

**CDM**  
environmental engineers, scientists,  
planners, & management consultants

SHEET NO. **6**

959-36321