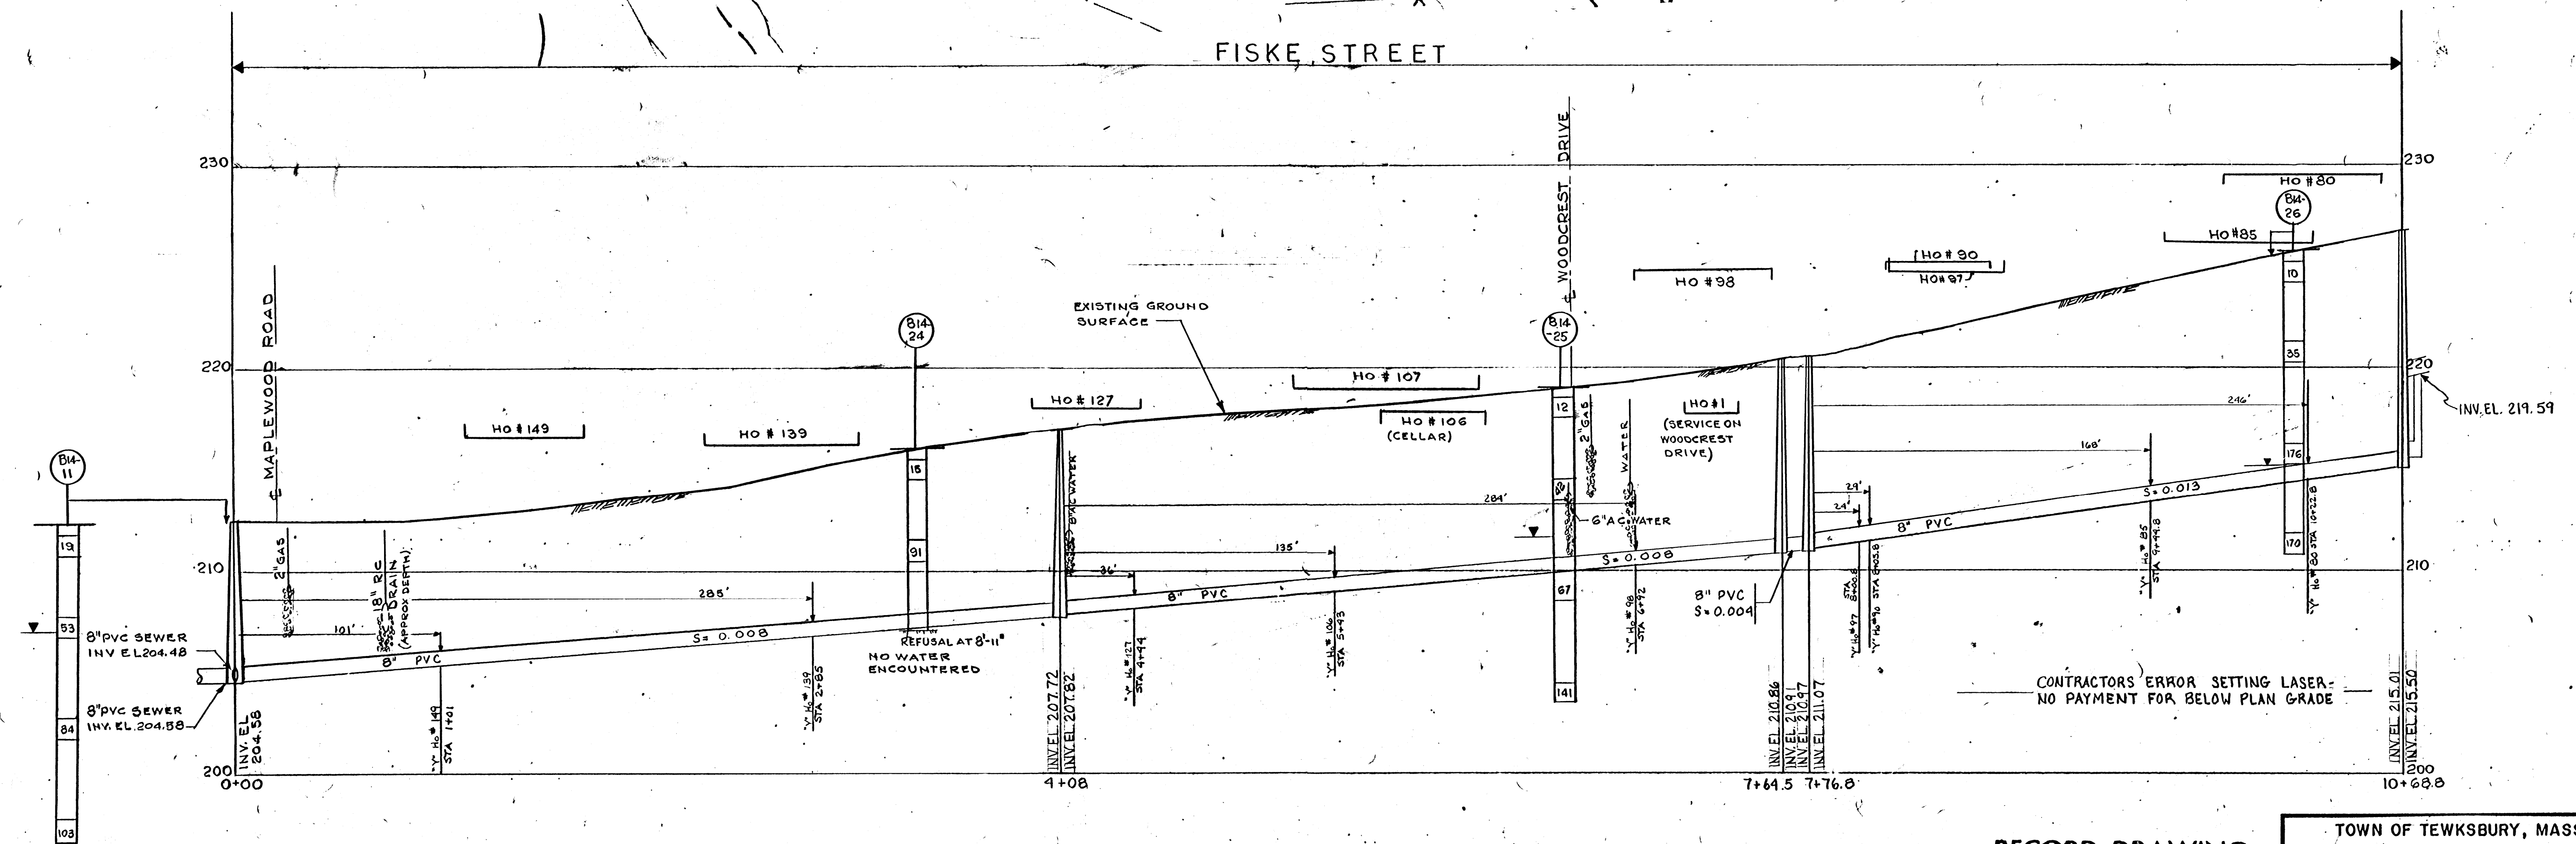
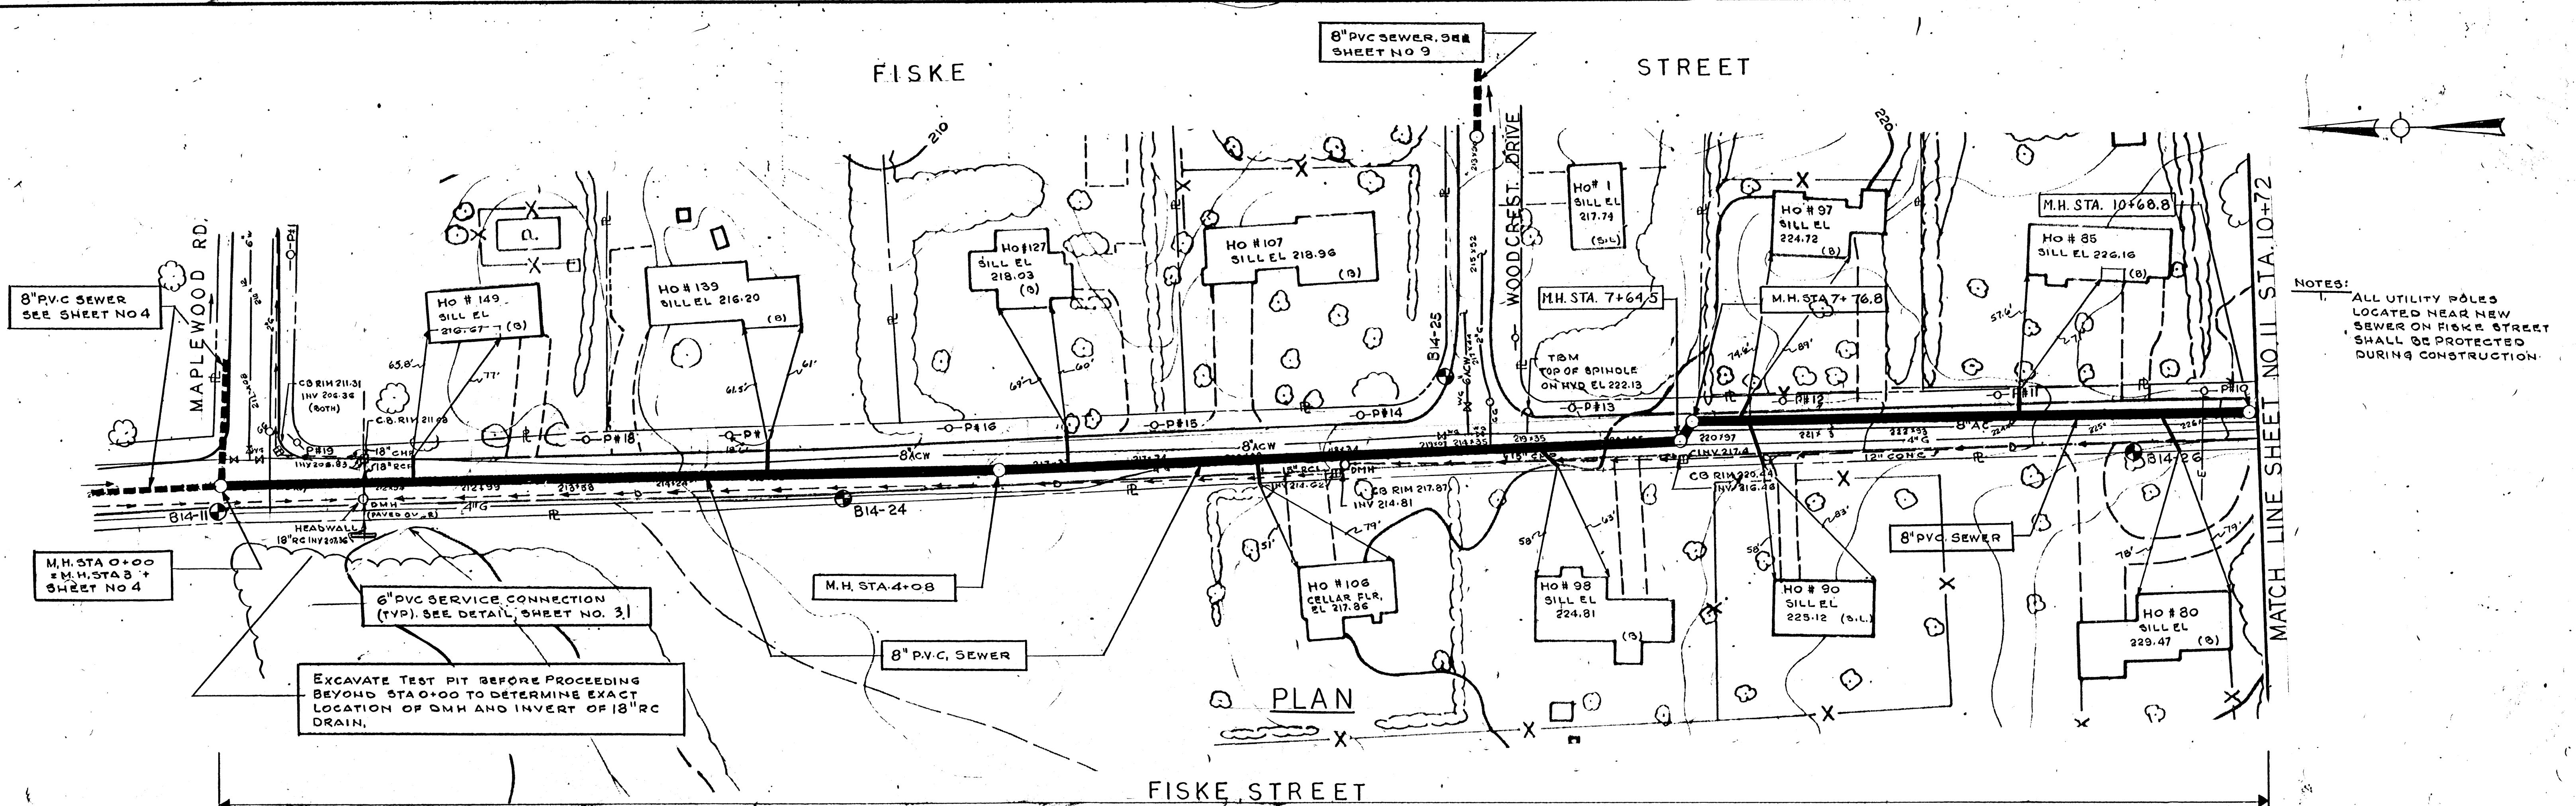


[illegible]

## PROFILE

# RECORD DRAWING

7/82	REVISED FOR RELOAD	
Date	Chk'd.	Revision
Designed by: <u>RMN</u>		Date: <u>MAY 1985</u>  HORIZ. 1" = 40' VERT. 1" = 4'
Drawn by: <u>VA</u>		
Checked by: <u>R.A.S.</u>		
Approved by: <u>INEM</u>		
Scales		

TOWN OF TEWKSBURY, MASSACHUSETTS  
F.Y. 85 LATERAL SEWERS

**CONTRACT NO. 14**

FISKE STREET

**CAMP DRESSER & McKEE INC.**

One Center Plaza  
Boston, Massachusetts 02108

**CDM**

SHEET NO.

0

9-37807