



FISKE STREET

6" PVC SERVICE CONNECTION  
(TYP.) SEE DETAIL, SHEET  
NO. 31.

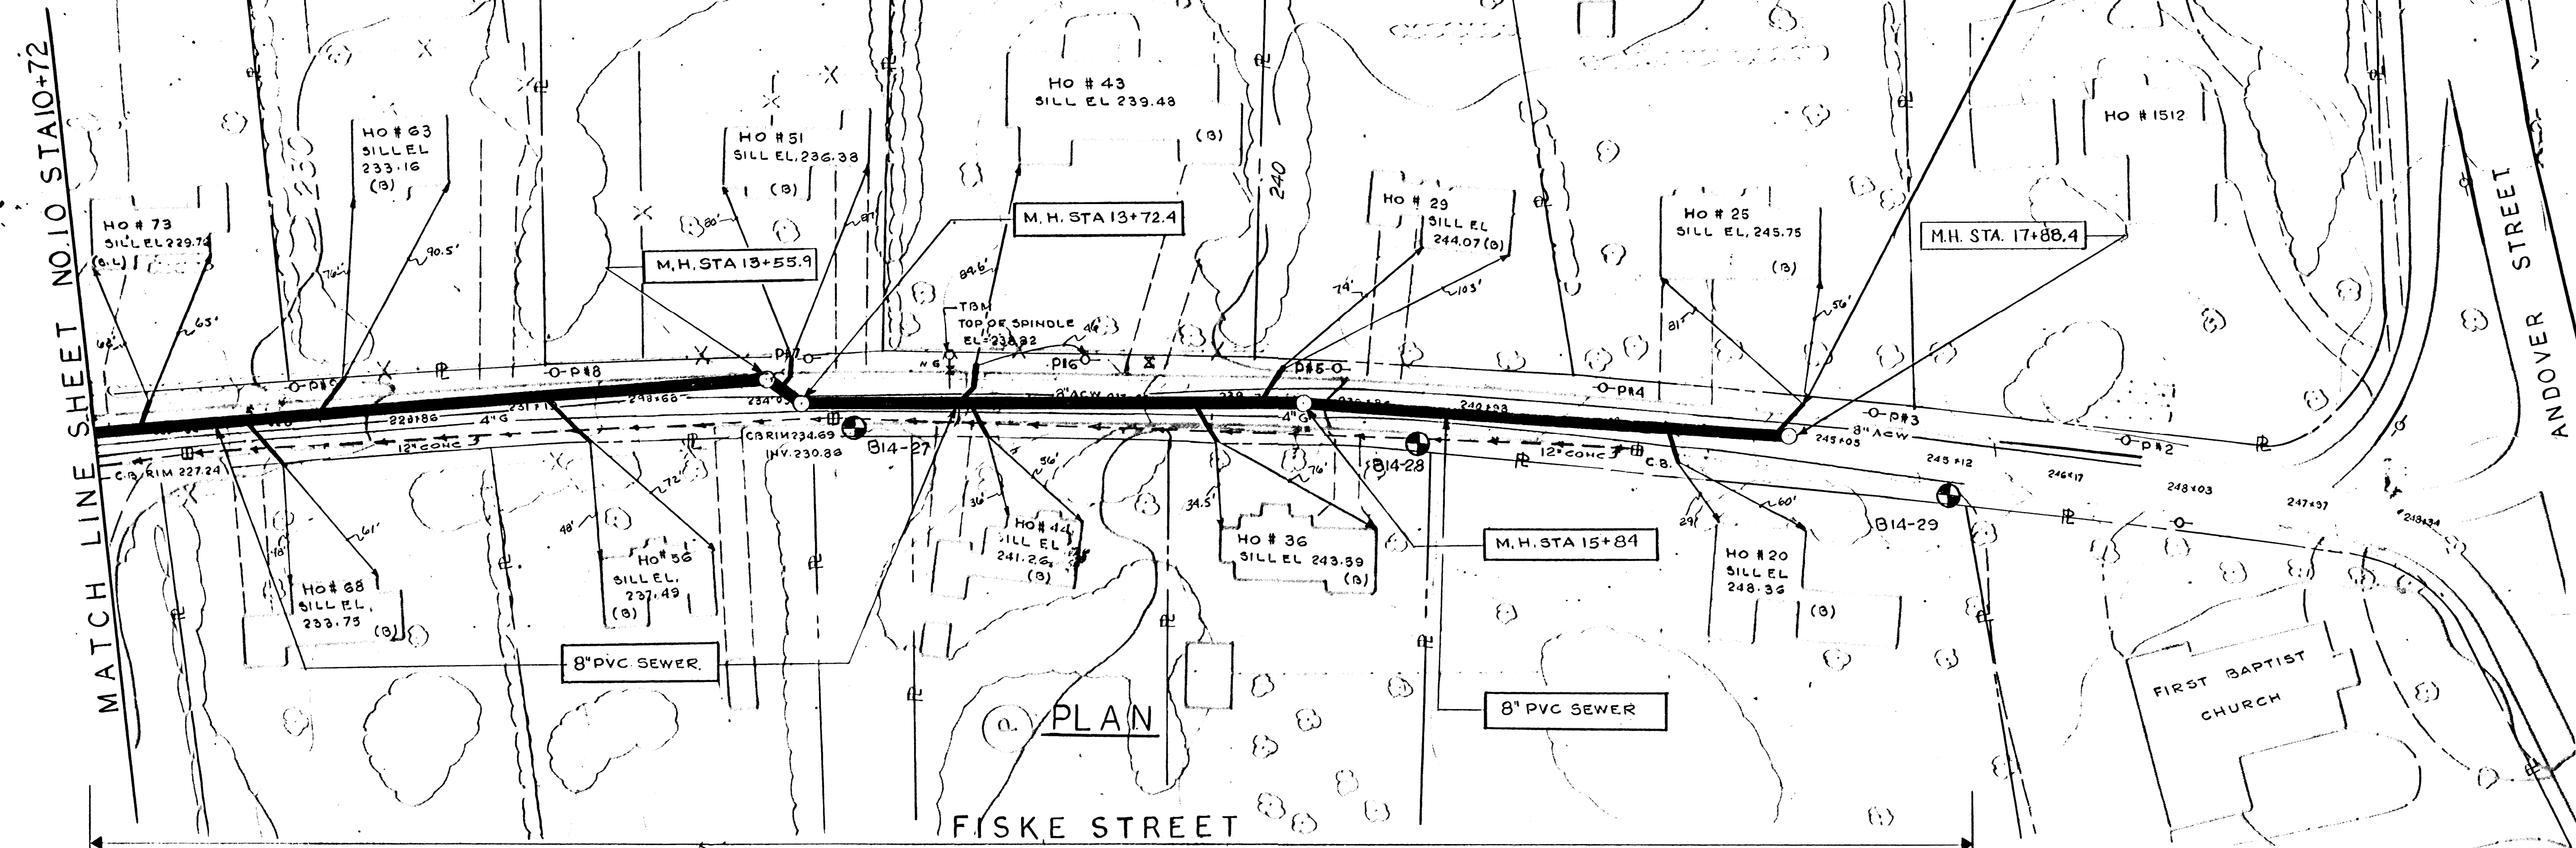

PLAN

FISKE STREET

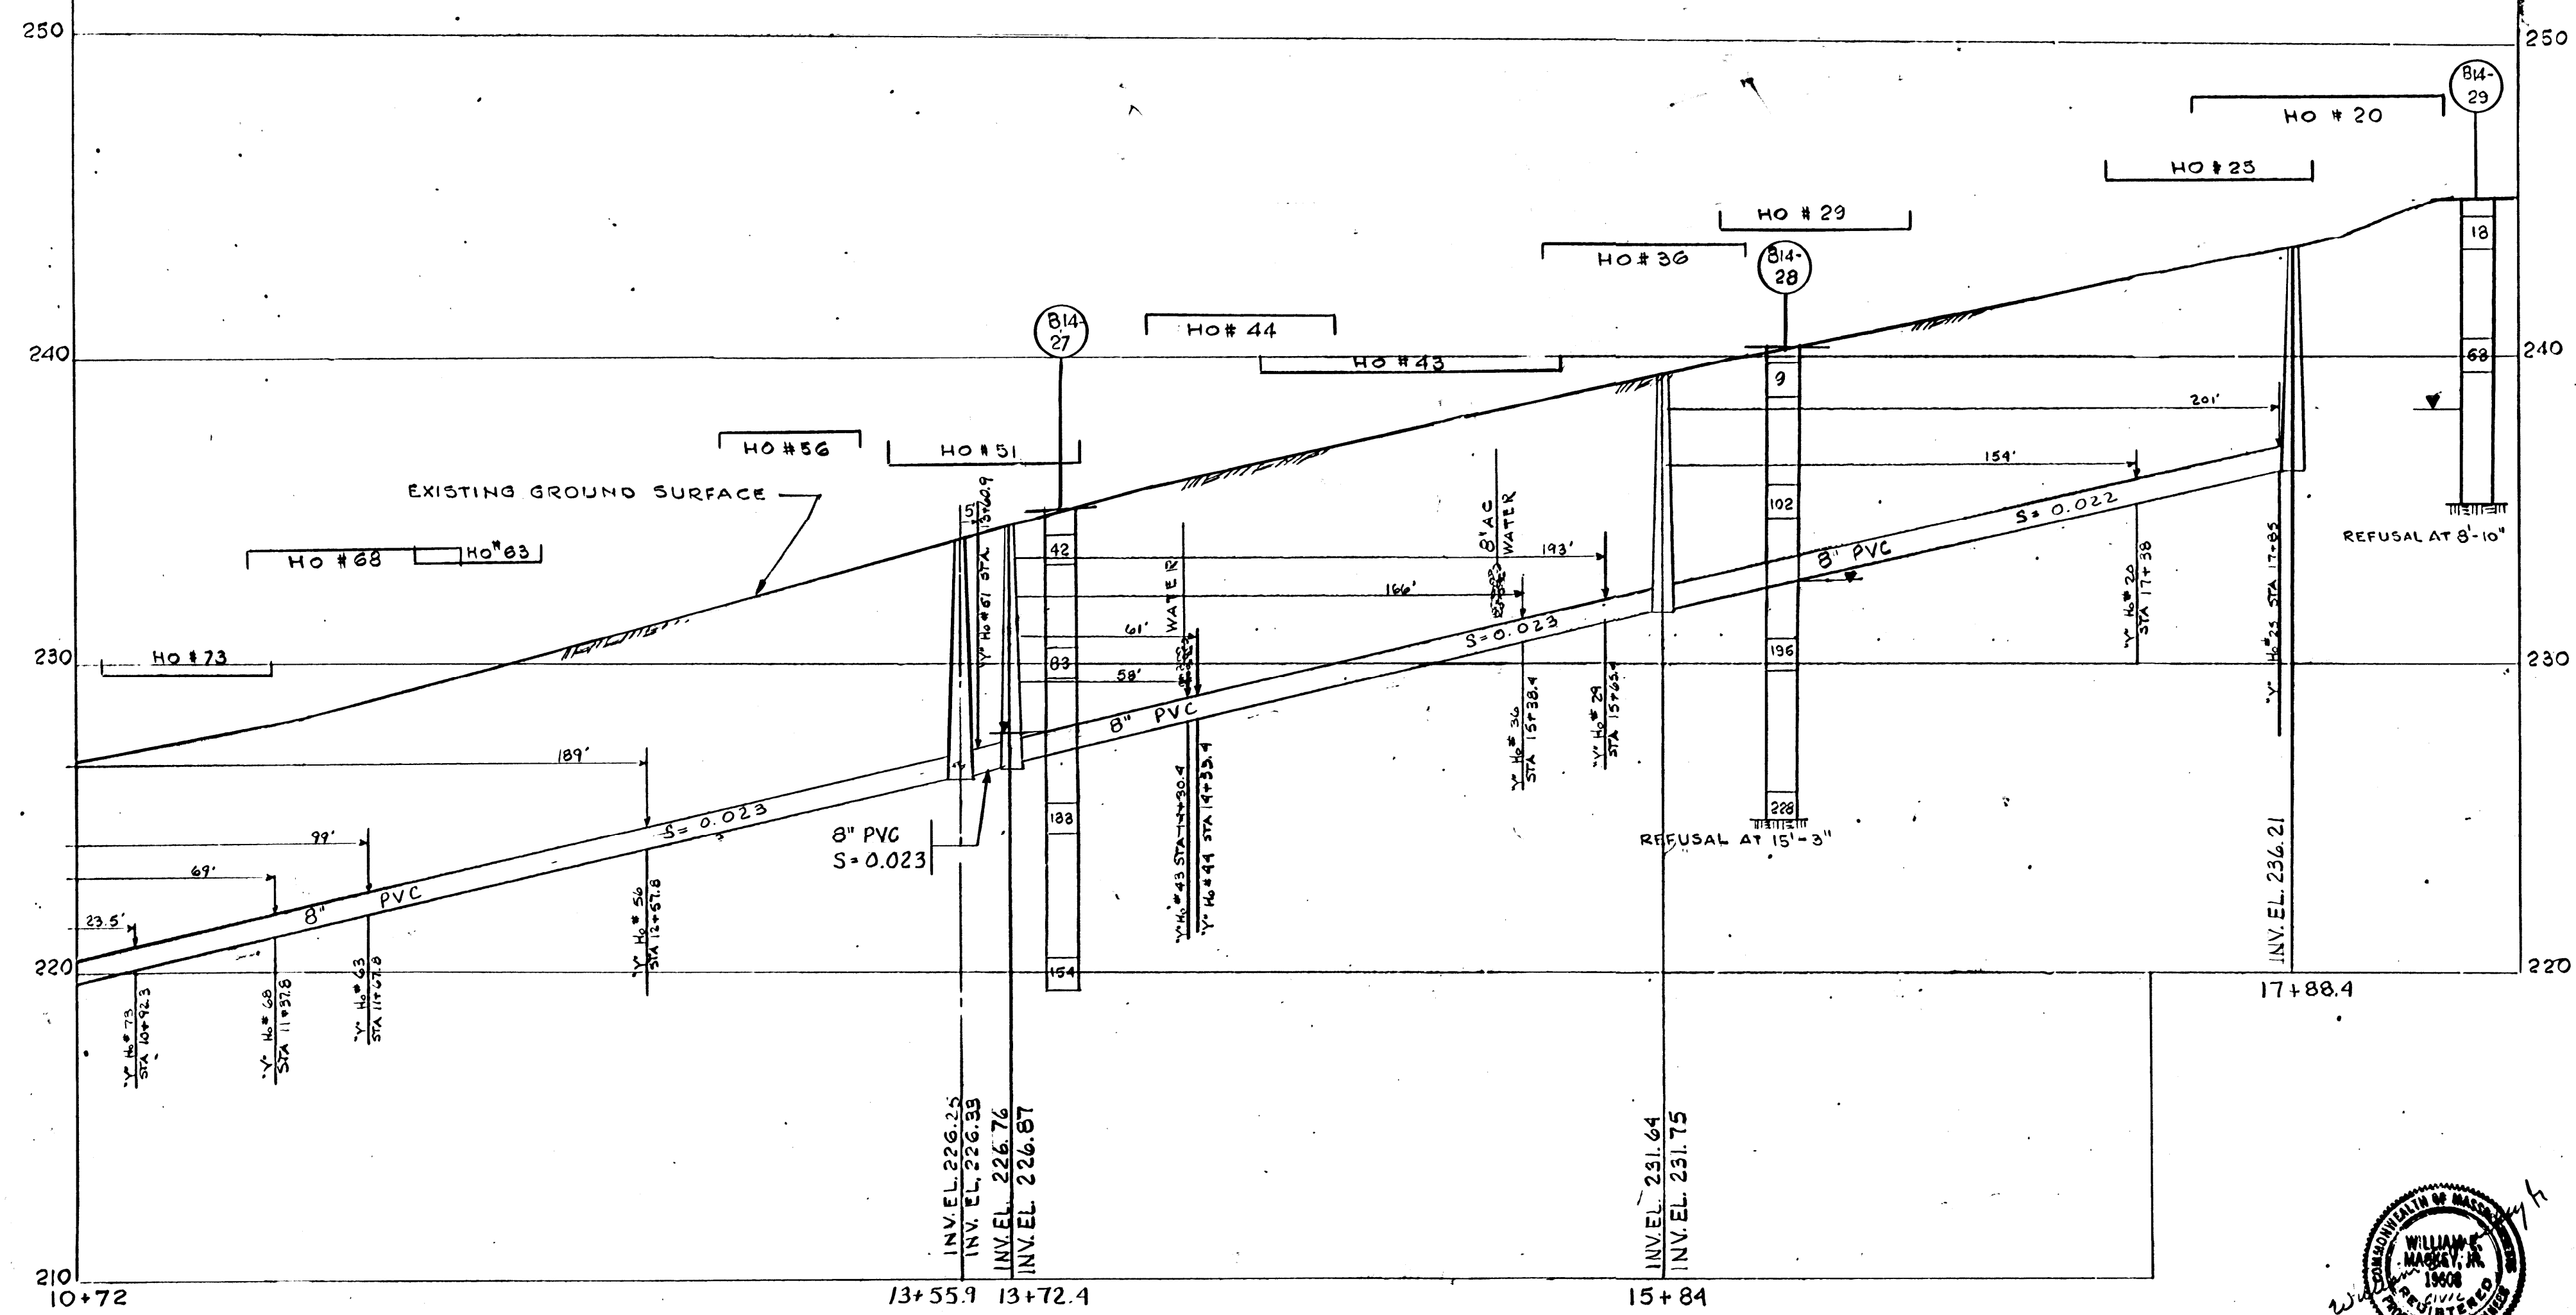

PROFILE

NOTES:  
1. ALL UTILITY POLES LOCATED NEAR  
NEW SEWER ON FISKE STREET SHALL  
BE PROTECTED DURING CONSTRUCTION

RECORD DRAWING

7/88		REVISED FOR RECORD
Date	Ch'k'd.	Revision
Designed by: <u>RMN.</u>		Date: <u>MAY 1985</u>  HORIZ. 1" = 40' VERT. 1" = 40'
Drawn by: <u>VA.</u>		
Checked by: <u>R.A.S.</u>		
Approved by: <u>WEM</u>		
		Scale: _____

TOWN OF TEWKSBURY, MASSACHUSETTS  
F.Y. 85 LATERAL SEWERS

CONTRACT NO. 14

FISKE STREET

**CAMP DRESSER & McKEE INC.**

One Center Plaza  
Boston, Massachusetts 02108

**CDM**

SHEET NO.

959-37808

