


CATCHBASIN DATA

EXISTING CB #2	NEW CB #9	CB #18	NEW CB #24
RIM = 393.20	STA 602+96.5, 23' LT	RIM = 394.01	STA 600+01, 18.5' RT
(2) 6" UD IN=389.00	RIM = 395.43	6" UD IN = 389.01	RIM = 395.00
2" FM IN = 389.00	6" UD IN = 391.90	24" IN = 385.96	6" UD IN = 394.50
(2) 8" ROOF DRAIN IN = 387.5	6" UD OUT = 392.60	6" UD OUT = 385.91	6" UD OUT = 395.50
15" PE OUT = 387.00	(3) 15" IN = 388.80	15" IN = 393.85	15" IN = 393.85
	18" OUT = 388.75	15" OUT = 388.75	15" OUT = 393.80
CB #3	NEW CB #10	CB #19	NEW CB #27
RIM = 393.91	RIM = 395.58	RIM = 394.93	RIM = 395.00
24" PE IN = 386.76	6" UD IN = 391.16	6" UD IN = 390.58	(2) 6" UD IN = 393.50
24" PE OUT = 386.71	6" UD OUT = 392.37	24" IN = 387.03	15" IN = 391.90
	15" OUT = 389.33	6" UD OUT = 386.93	18" IN = 391.90
CB #5	NEW CB #11	CB #20	NEW CB #28
RIM = 396.23	RIM = 396.63	RIM = 396.14	RIM = 398.00
6" UD IN = 389.36	6" UD IN = 392.17	(2) 6" UD IN = 391.69	6" UD IN = 393.50
15" PE IN = 387.23	6" UD OUT = 389.21	(2) 15" IN = 389.14	6" UD OUT = 384.50
(2) 24" PE IN = 387.23	15" OUT = 391.71	24" IN = 389.14	6" UD OUT = 384.50
24" PE OUT = 387.23		6" UD OUT = 389.09	15" OUT = 392.15
CB #5A	NEW CB #12	CB #21	CB #29
RIM = 394.41	RIM = 395.75	RIM = 396.21	RIM = 395.59
15" PE OUT = 387.31	6" UD IN = 391.25	(2) 6" UD IN = 391.43	15" OUT = 391.39
	6" UD IN = 391.25	15" IN = 388.23	15" OUT = 391.39
CB #6	NEW CB #13	NEW CB #22	NEW CB #V5
RIM = 395.39	RIM = 397.87	RIM = 397.87	RIM = 392.50
6" UD IN = 389.90	RIM = 395.00	6" UD IN = 392.62	24" IN = 386.30
15" & 18" PE IN = 387.49	6" UD IN = 389.90	15" IN = 390.62	24" OUT = 386.25
24" PE OUT = 387.49	6" UD IN = 389.85	15" IN = 390.79	
	15" OUT = 389.19	24" OUT = 390.62	
NEW CB #7	NEW CB #14	NEW CB #23	POND #1 OUTLET STRUCTURE
RIM = 394.00	RIM = 395.00	STA 600+00, 18' LT	TOP = 391.18
6" IN = 389.60	6" UD IN = 394.50	RIM = 399.00	TOP OF DOME GRATE = 390.62
8" IN = 389.00 (ROOF DRAIN)	6" UD IN = 394.50	6" UD IN = 394.50	3" ORIFICE = 395.00
15" OUT = 388.41	6" UD OUT = 395.50	8" IN = 393.50	8" ORIFICE = 395.00
	18" IN = 388.20	15" IN = 393.50	(2) 24" W X 12" H WEIRS = 397.60
	18" OUT = 388.20	15" OUT = 393.45	24" PE OUT = 384.95
NEW CB #8	CB #17	CB #17	STHM #1
RIM = 394.00	RIM = 394.08	RIM = 394.08	SOLID COVER = 388.35
6" UD IN = 389.50	6" UD IN = 391.25	6" UD IN = 391.25	24" PE IN = 384.72
8" IN = 389.00 (ROOF DRAIN)	6" UD OUT = 392.33	15" OUT = 389.19	24" PE OUT = 384.72
15" OUT = 388.41	15" OUT = 389.75		30" PE OUT = 384.60

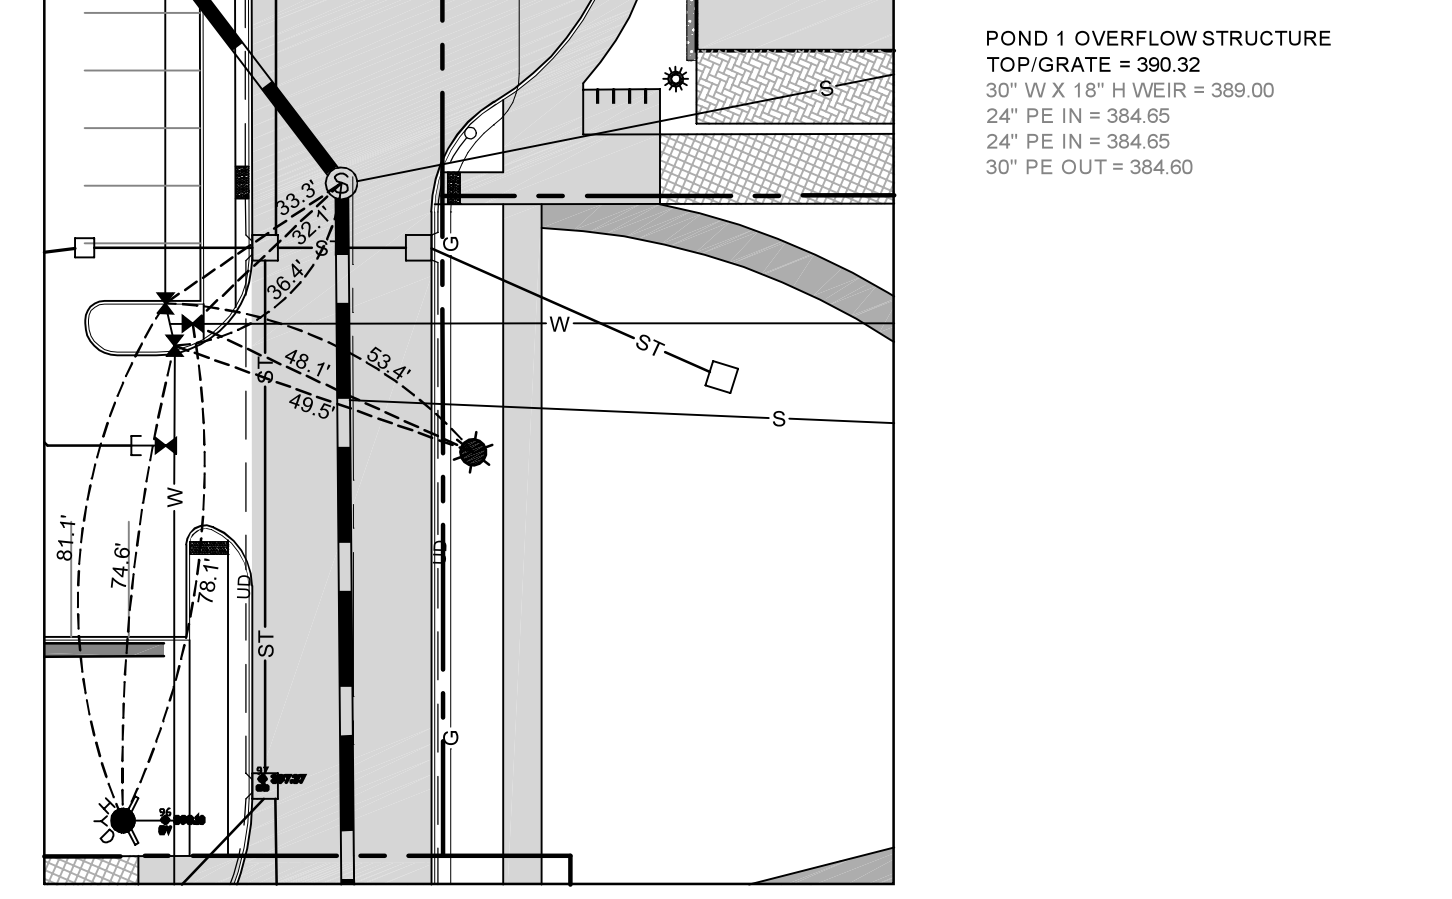

THIS PLAN WAS REVISED IN OCTOBER 2019 TO SHOW THE RECORD HORIZONTAL LOCATIONS AND TIES TO THE FOLLOWING ITEMS:

- HOTEL
 - HYDRANTS, VALVES, WATERMAIN & WATER SERVICES
 - SANITARY MANHOLES, SEWER MAINS & SERVICES
 - STORM MANHOLES, CATCH BASINS & STORM PIPES
 - TRANSFORMER PADS, ELECTRIC PEDESTALS, CABLE PEDESTALS, TELECOMM. PEDESTALS, HANDHOLES
 - LIGHT POLES
 - POND #1/PARKING LOT RETAINING WALL
 - BUILDING FOOTPRINT

THIS PLAN WAS REVISED IN OCTOBER 2019 TO SHOW THE RECORD VERTICAL ELEVATIONS OF THE FOLLOWING ITEMS:

- HOTEL
 - SANITARY MANHOLE RIMS, SEWER MAIN INVERTS
 - STORM MANHOLE RIMS, CATCH BASIN RIMS/GRATES, STORM PIPE INVERTS

DRAFT

PENDING INSTALLATION OF:
 TRASH ENCLOSURE & GENERATOR SCREENING
 VEHICLE CHARGING STATIONS
 COMMUNICATION PEDESTALS
 FLAG POLE, BENCH & WALL SEATING, PATIO FENCE

REVISIONS		# OF SHEETS
THESE PLANS WITH LATEST REVISIONS SHOULD ONLY BE USED FOR THE PURPOSE SHOWN BELOW:		
<input type="checkbox"/>	SKETCH/CONCEPT	
<input type="checkbox"/>	PRELIMINARY	
<input type="checkbox"/>	FINAL	
<input checked="" type="checkbox"/>	RECORD DRAWING	


proj. no. 01-087
 survey L&D
 design DJG/ABR
 drawn NDS
 checked DJG/ABR
 date 10/25/19
 scale 1" = 30'
 sht. no. **R2**

FINNEY CROSSING
 A PLANNED UNIT DEVELOPMENT
 WILLISTON, VERMONT

SITE & UTILITY PLAN

LAMOUREUX & DICKINSON
 Consulting Engineers, Inc.
 14 Morse Drive
 Essex Junction, VT 05452
 (802) 878-4450

WILLISTON DISCRETIONARY PERMIT DP-09-01
 TAX PARCEL # 08-143-010

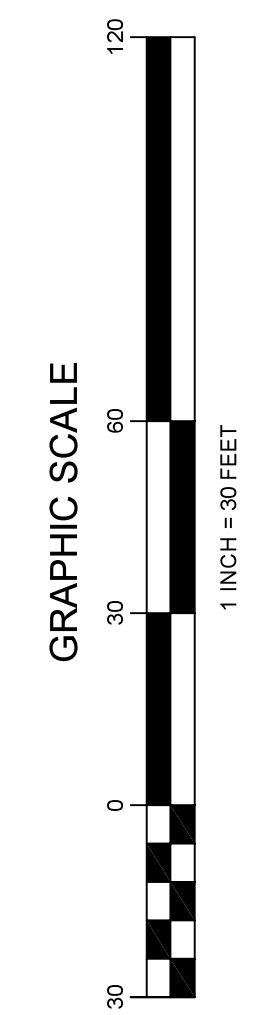

SEE SHEET R3 FOR HOLLAND LANE

SEE SHEET R3 FOR MARKET STREET

SEE SHEET R4 FOR STILLWATER LANE

SEE SHEET R4 & R6B FOR HOLLAND LANE

SEE SHEET R6B FOR SEYMOUR STREET