

THIS PLAN WAS REVISED IN NOVEMBER 2017 TO SHOW THE RECORD HORIZONTAL LOCATIONS AND TIES TO THE FOLLOWING ITEMS:


- HYDRANTS, VALVES, CURB STOPS

THIS PLAN WAS REVISED IN OCTOBER 2019 TO SHOW THE RECORD HORIZONTAL LOCATIONS OF THE FOLLOWING ITEMS:

- SANITARY MANHOLES, SEWER MAINS & SERVICES
- STORM MAHOLES, CATCH BASINS & STORM PIPES
- WATERMAIN, WATER SERVICES
- GAS MAINS, GAS SERVICES & GAS VALVES
- UNDERGROUND ELECTRIC, CABLE & TELECOMM. CONDUITS
- TRANSFORMER PADS, ELECTRIC PEDESTALS, CABLE PEDESTALS & TELECOMM. PEDESTALS
- LIGHT POLES

THIS PLAN WAS REVISED IN OCTOBER 2019 TO SHOW THE RECORD VERTICAL ELEVATIONS OF THE FOLLOWING ITEMS:

- SANITARY MANHOLE RIMS, SEWER MAIN INVERTS
- STORM MANHOLE RIMS, CATCH BASIN RIMS/GRATES, STORM PIPE INVERTS

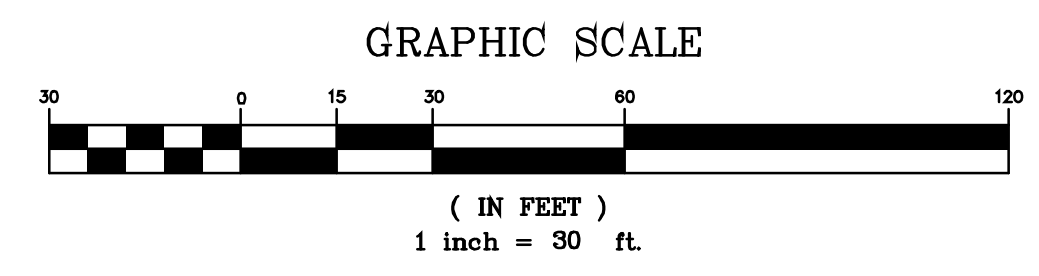

WILLISTON DISCRETIONARY PERMIT DP-09-01
TAX PARCEL # 08:104:010, 08:143:002,004, & 010

REVISIONS		# OF SHEETS
THESE PLANS WITH LATEST REVISIONS SHOULD ONLY BE USED FOR THE PURPOSE SHOWN BELOW:		
<input type="checkbox"/> SKETCH/CONCEPT		
<input type="checkbox"/> PRELIMINARY		
<input type="checkbox"/> FINAL		
<input checked="" type="checkbox"/> RECORD DRAWING		

proj. no. 01-087	proj. no. 01-087
survey L&D	survey L&D
design DJG/ABR	design DJG/ABR
drawn L&D	drawn L&D
checked DJG/ABR	checked DJG/ABR
date 11/27/17	date 11/27/17
scale AS SHOWN	scale AS SHOWN
sheet no. R6B	sheet no. R6B

FINNEY CROSSING
A PLANNED UNIT DEVELOPMENT
WILLISTON, VERMONT

- PLAN -
HOLLAND LANE & SEYMOUR STREET

LD **LAMOUREUX & DICKINSON**
Consulting Engineers, Inc.
14 Morse Drive
Essex Junction, VT 05452
(802) 878-4450