





Area 1



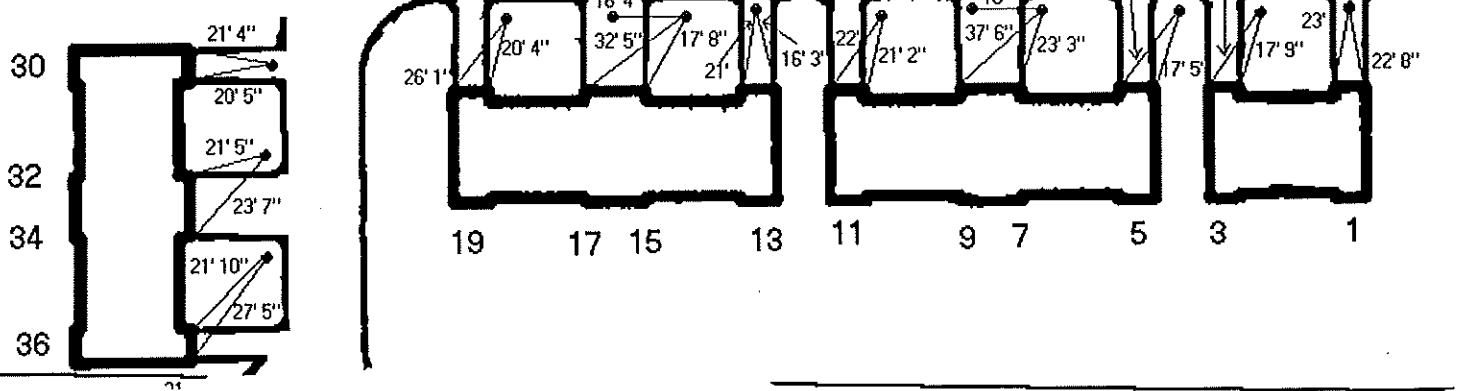

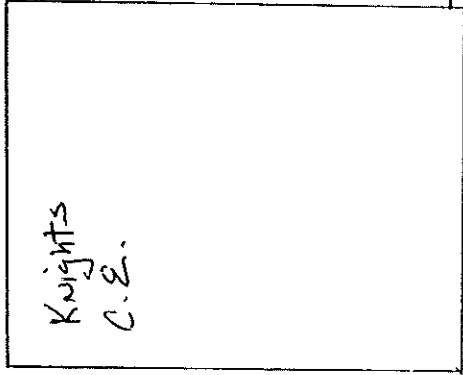

1/2" copper

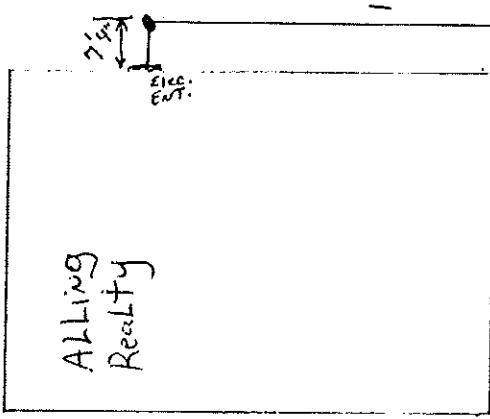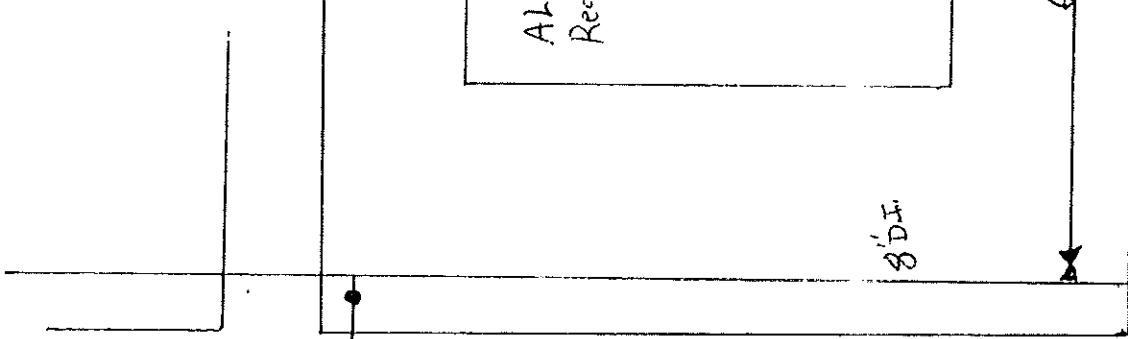

1/2" copper

6"



U.S. Route 2A



TO  
TAFIS  
CORNERS →

1/2" copper

#233

1011 A

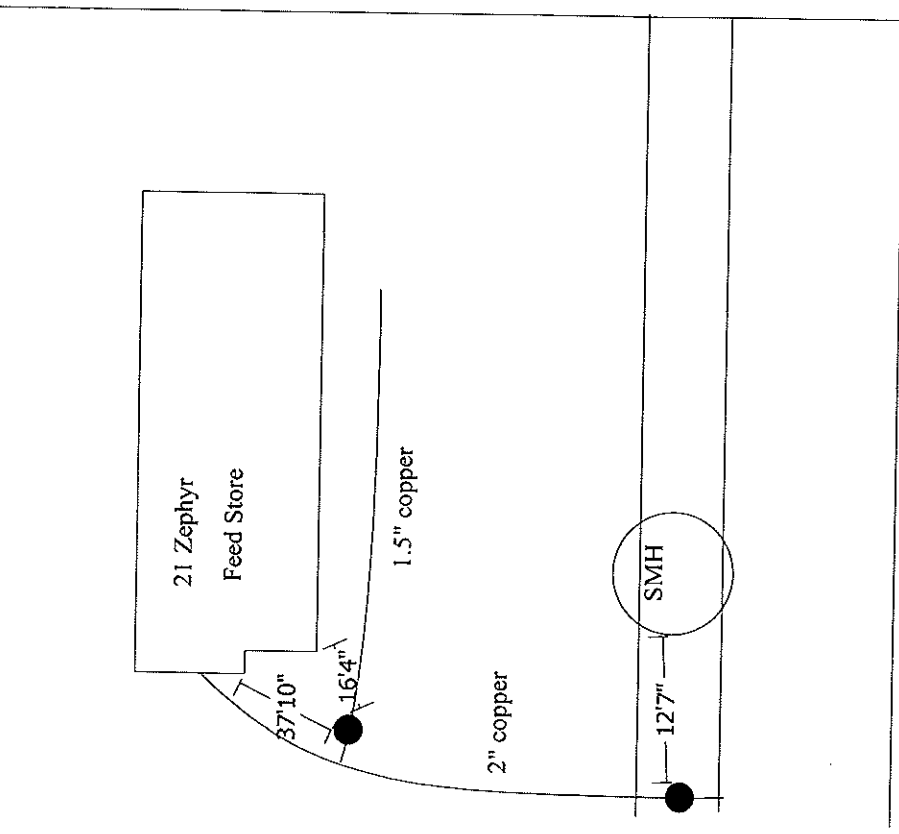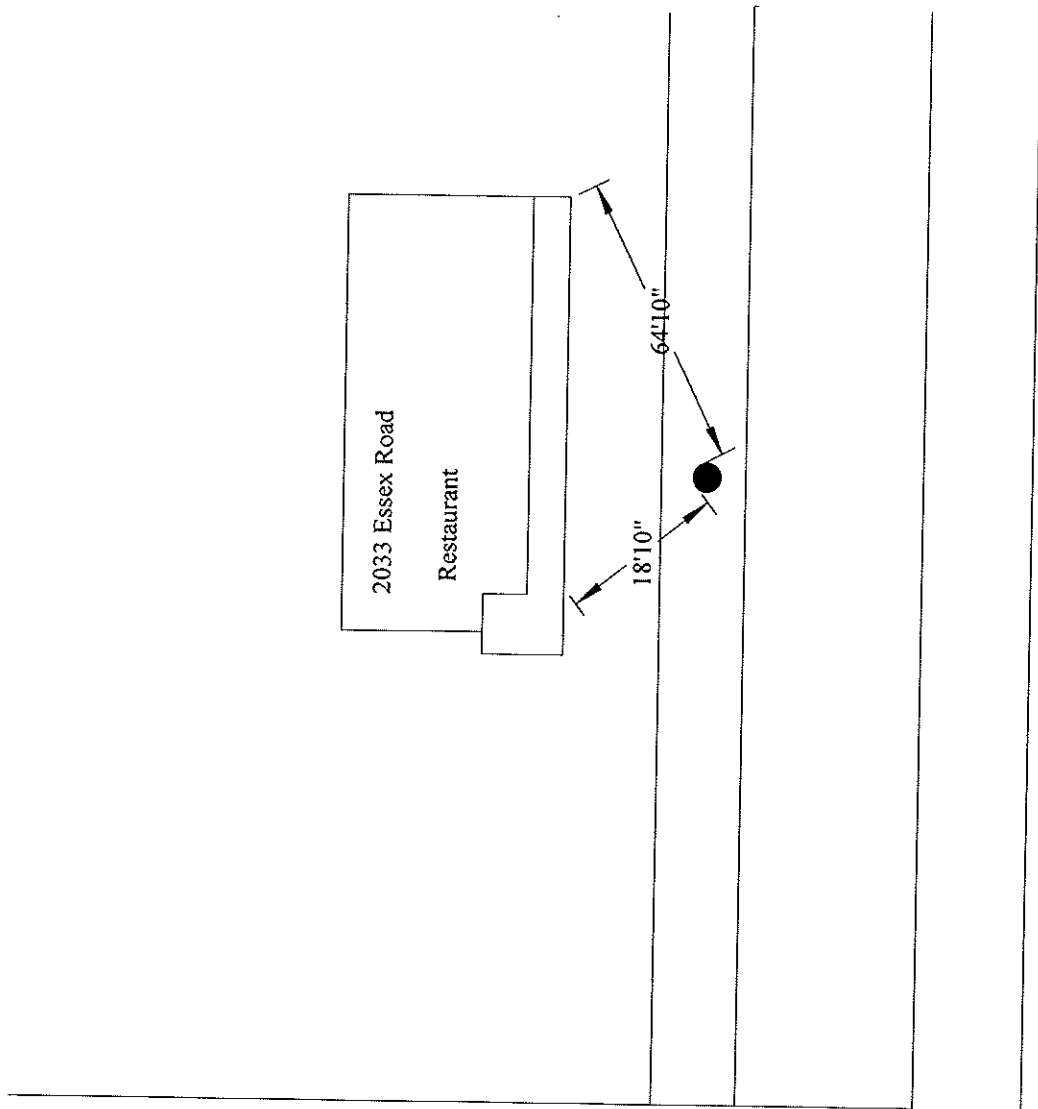

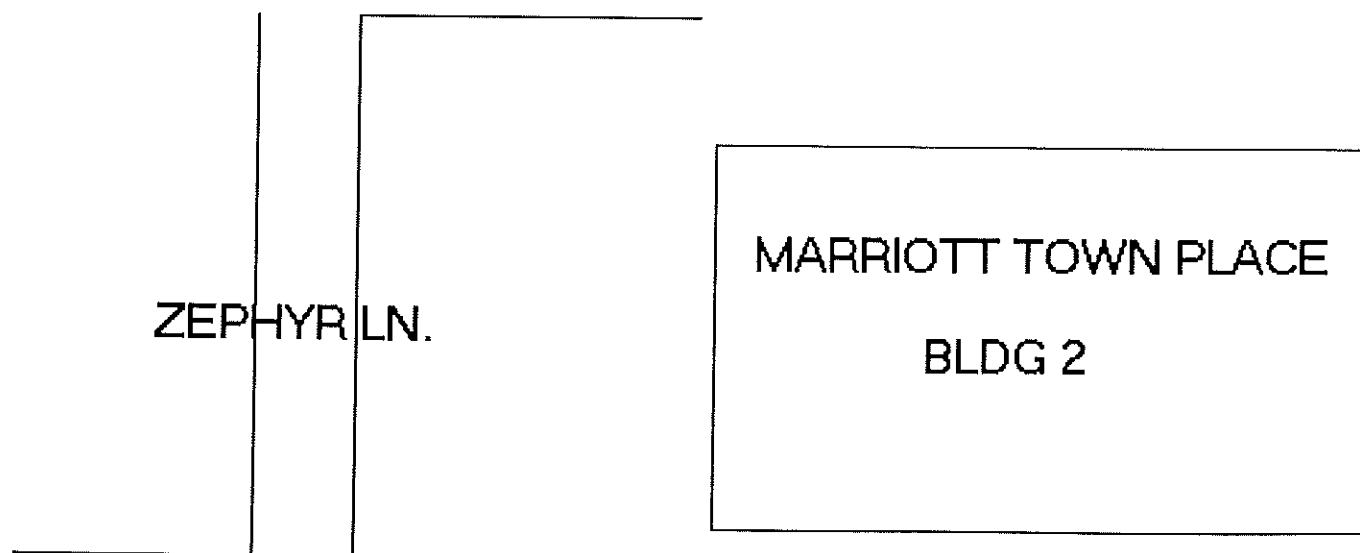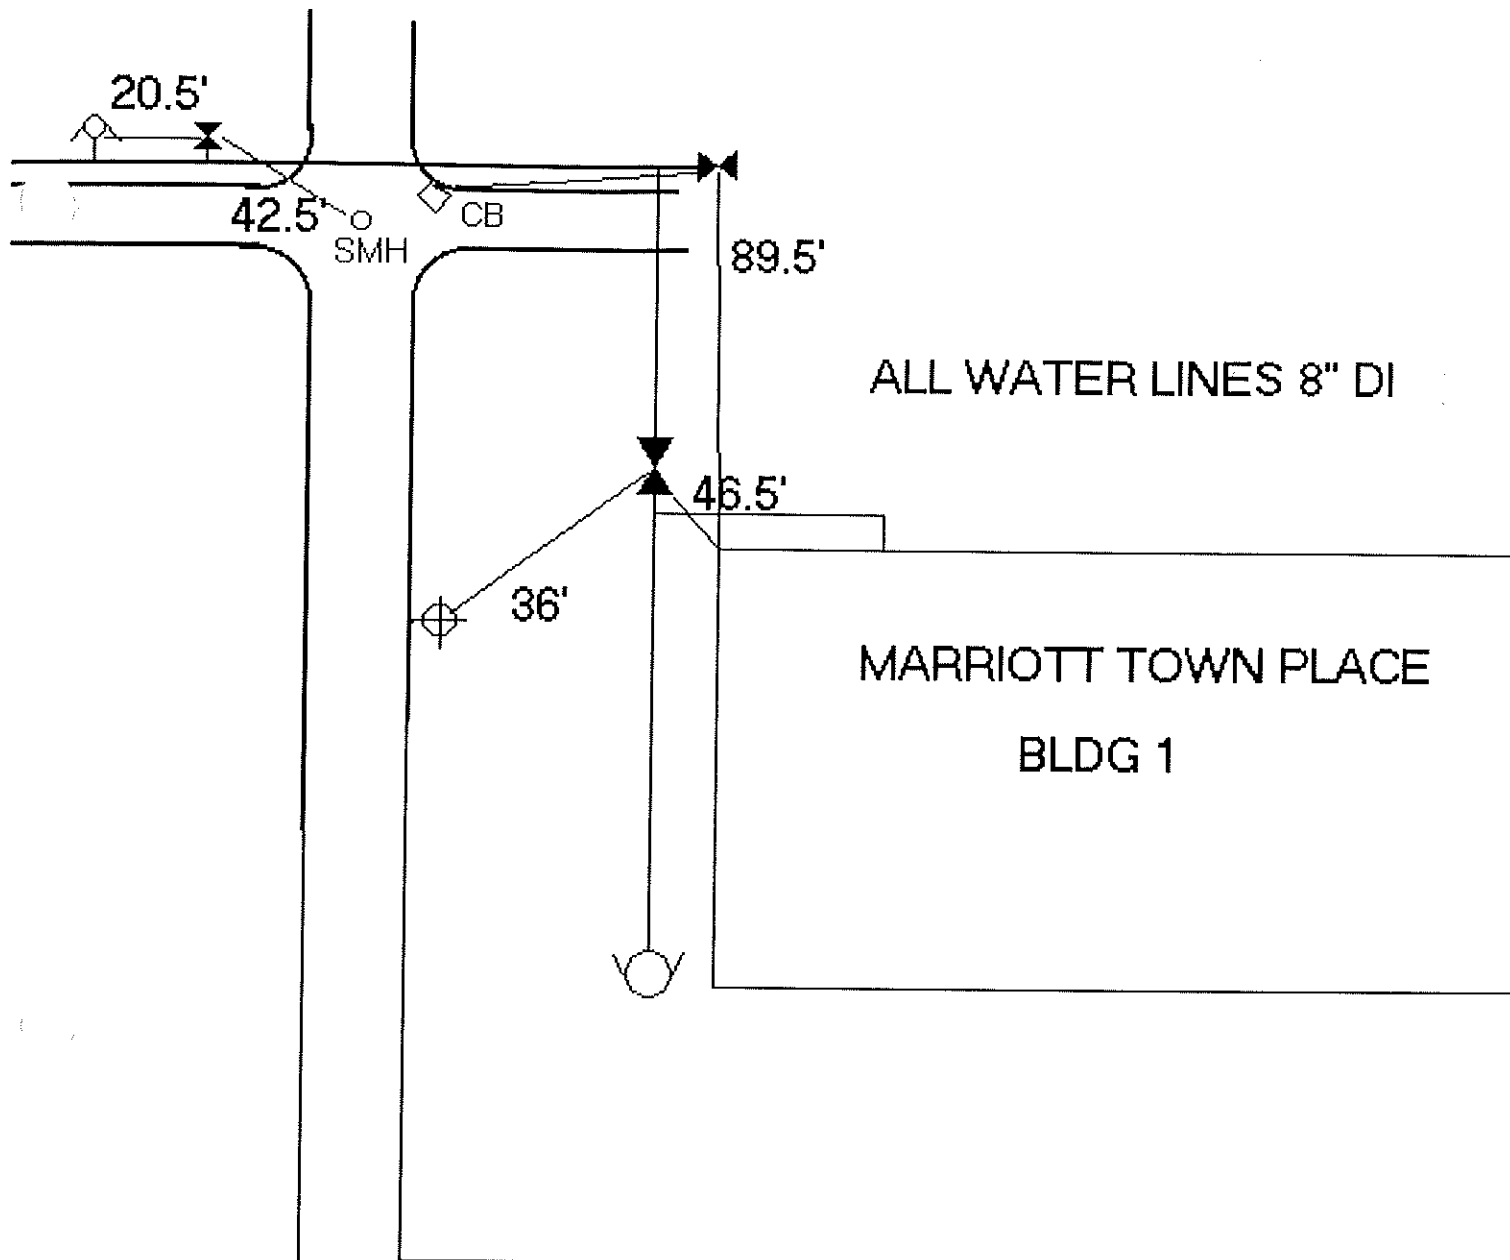


ROUTE 2A

2141  
Essex Rd.

2121  
Essex Rd  
1.5 or 2" copper  
No As Builts

Curb stop in regular  
valve box, no rod,  
use large curb stop  
wrench

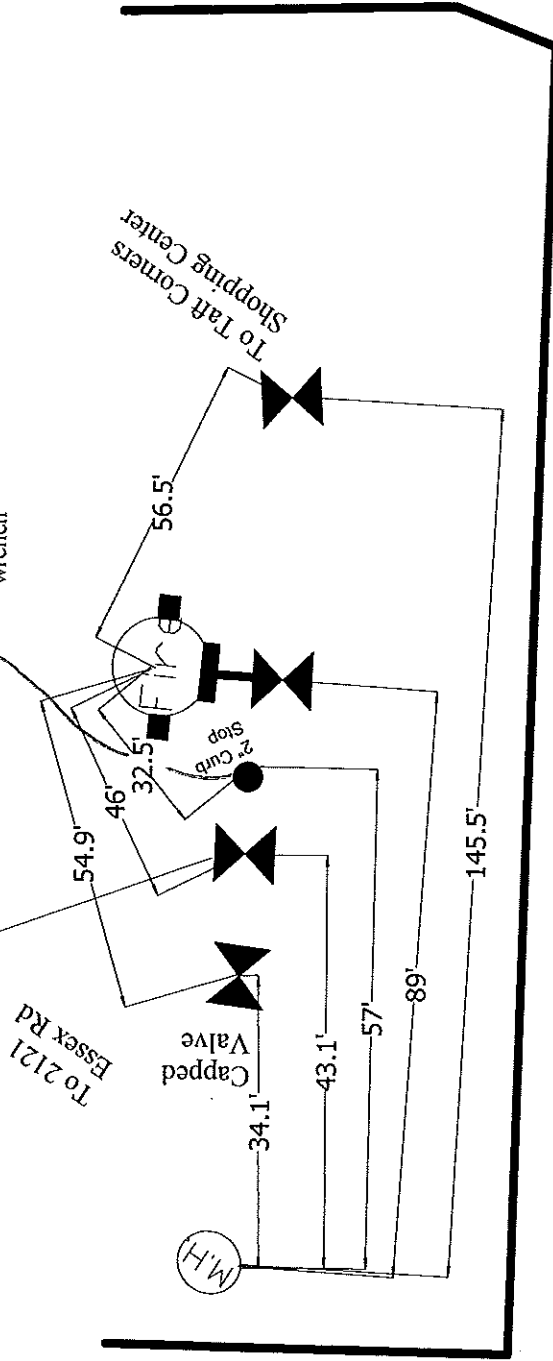


Essex Rd.




NORTH  
TANKS  
CROSS

TANK CORE

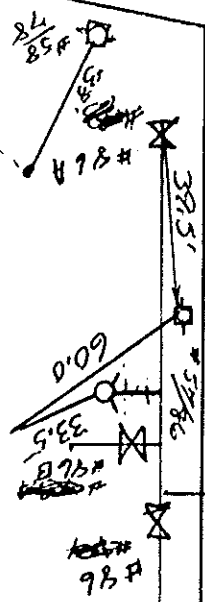


STAIRS

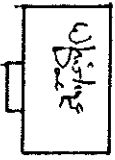

3/4" C.L.D.

R 7  
R 7  
H 45.0' 98.0'


22

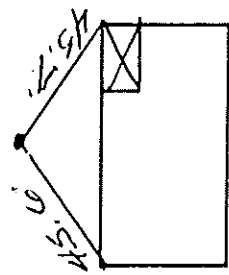

NORTH

JOHN



North

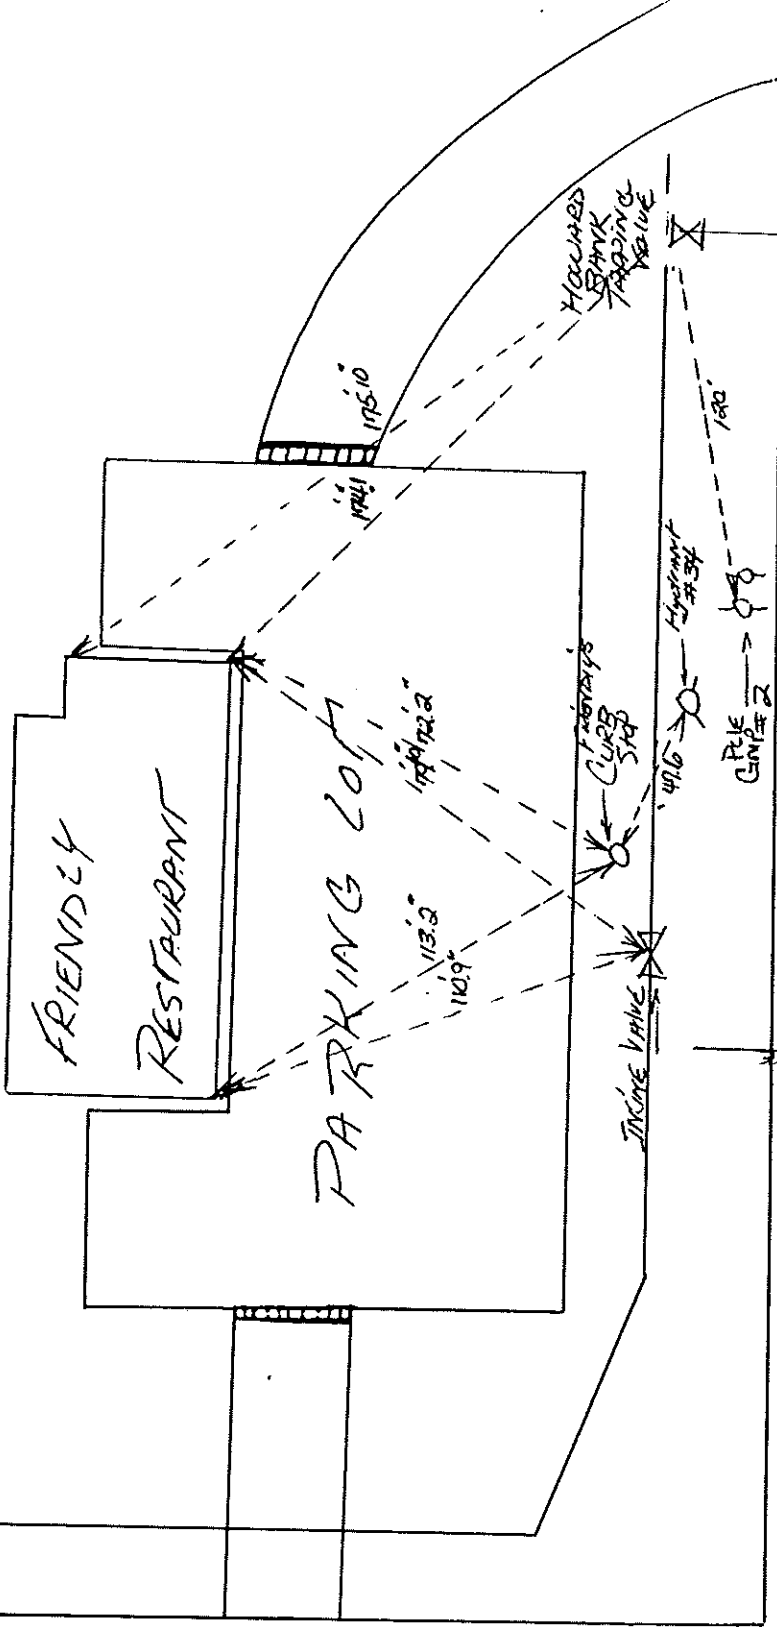

SEWER LINE  
STEEL  
4 - RT 2A

RT 2


North

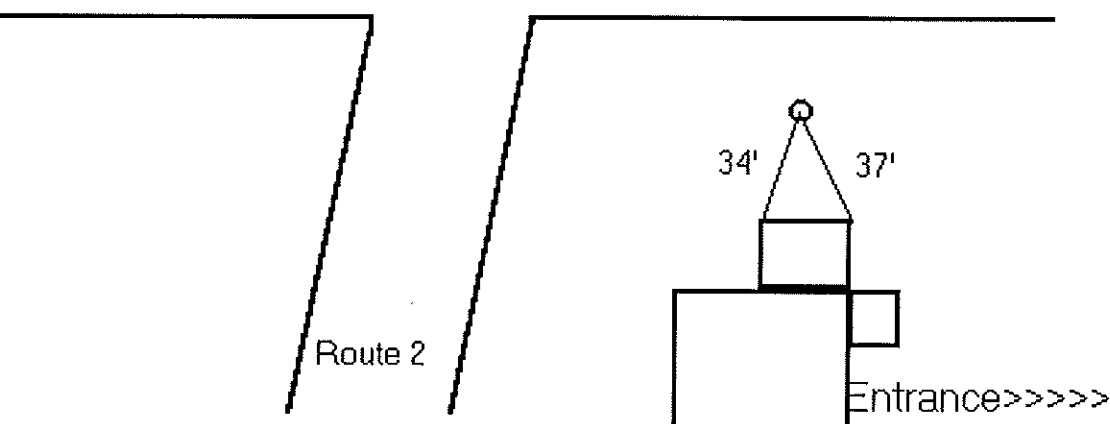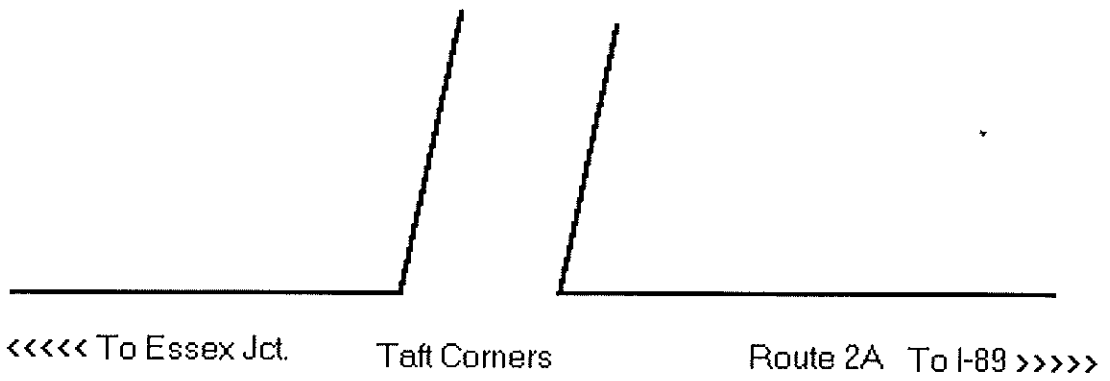

Calvin Morse Tavern  
500 Interstate Corporate Center (911 Address)


ROUTE 2

Building

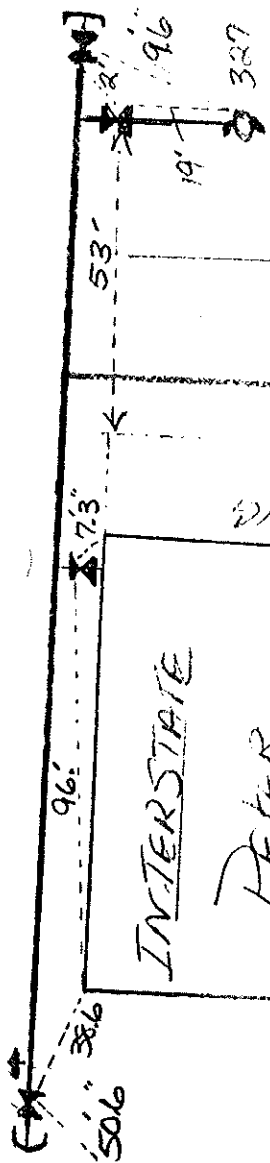


INTERSTATE  
 PETER  
 JUDGE, CO.

RETAINING  
 WALL

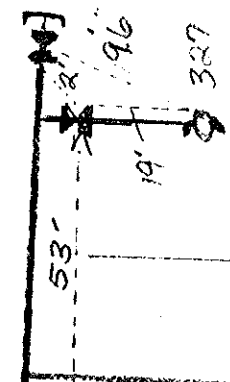

Old Farm  
 House

12' AC  
 #50/01  
 28.5'

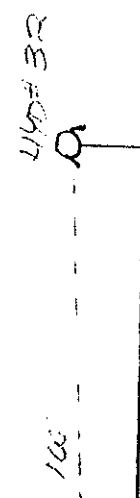


15' from rd.


TRAF. CONNER'S

ROUTE 2A

E. Baulinghams

ND

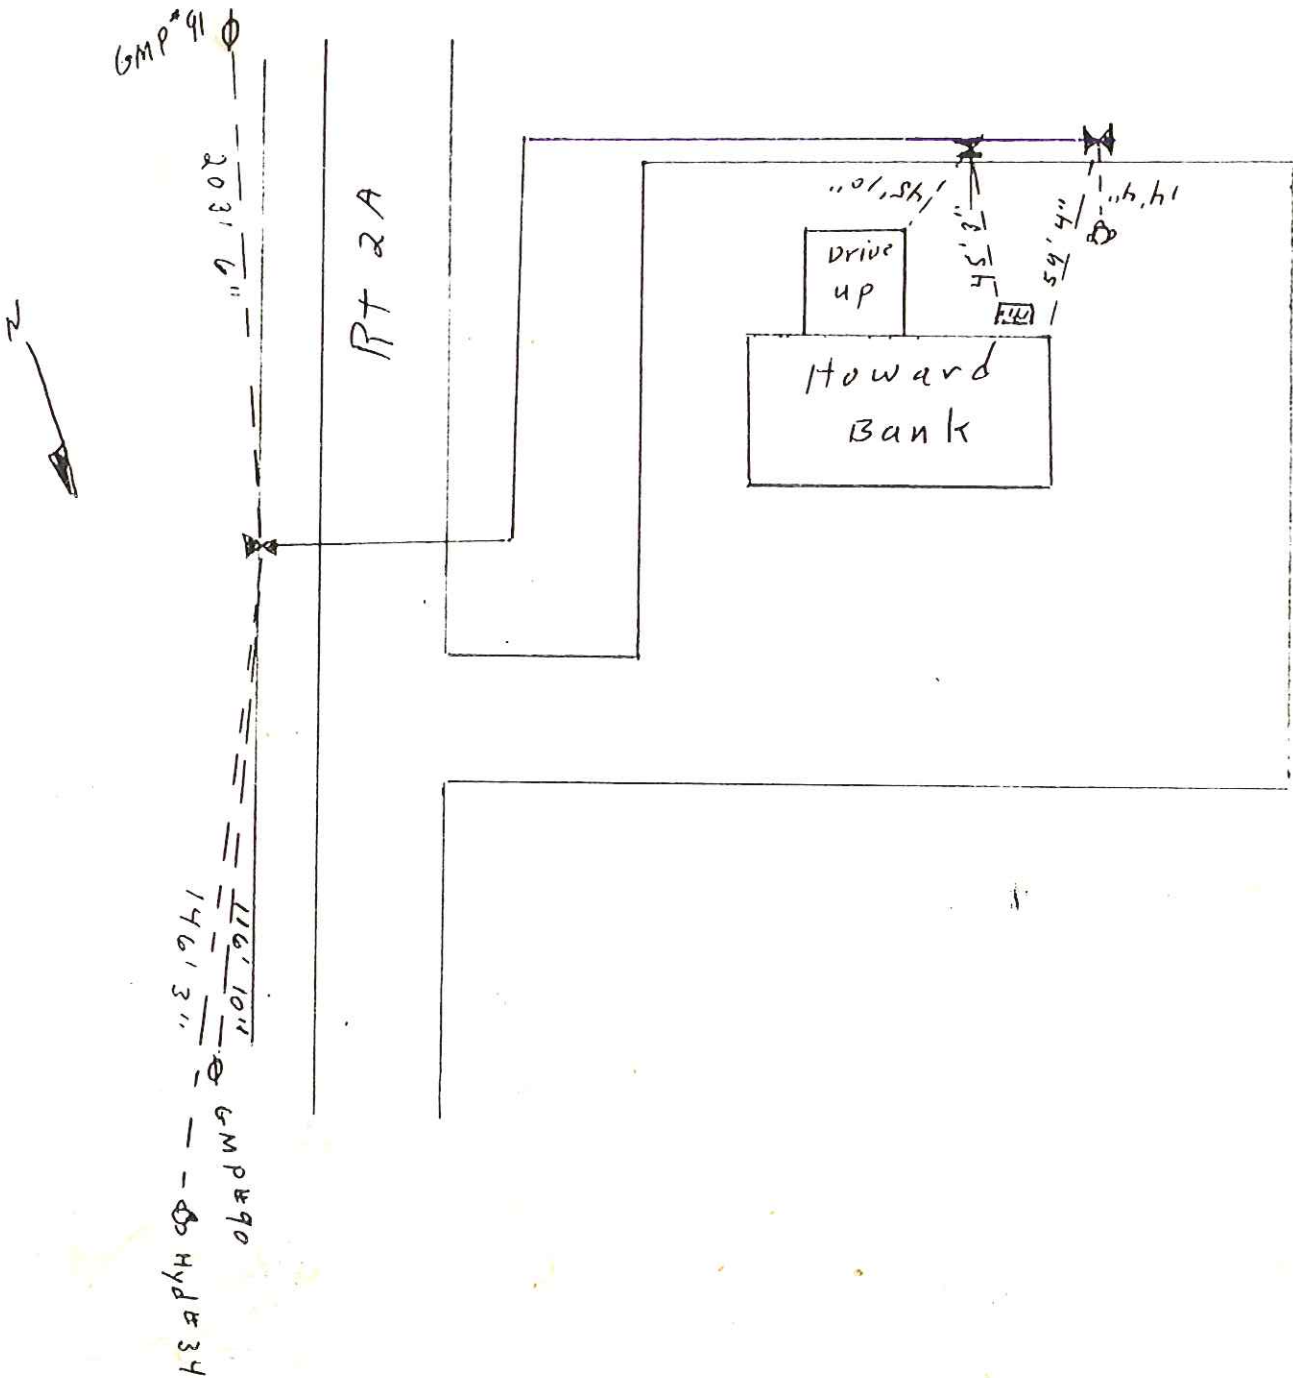

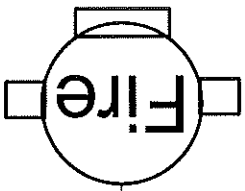


6" D.I.


60  
Wright  
Road  
Northfield  
Savings  
Bank

Wright Road


St. George Road

48.48'  
56'

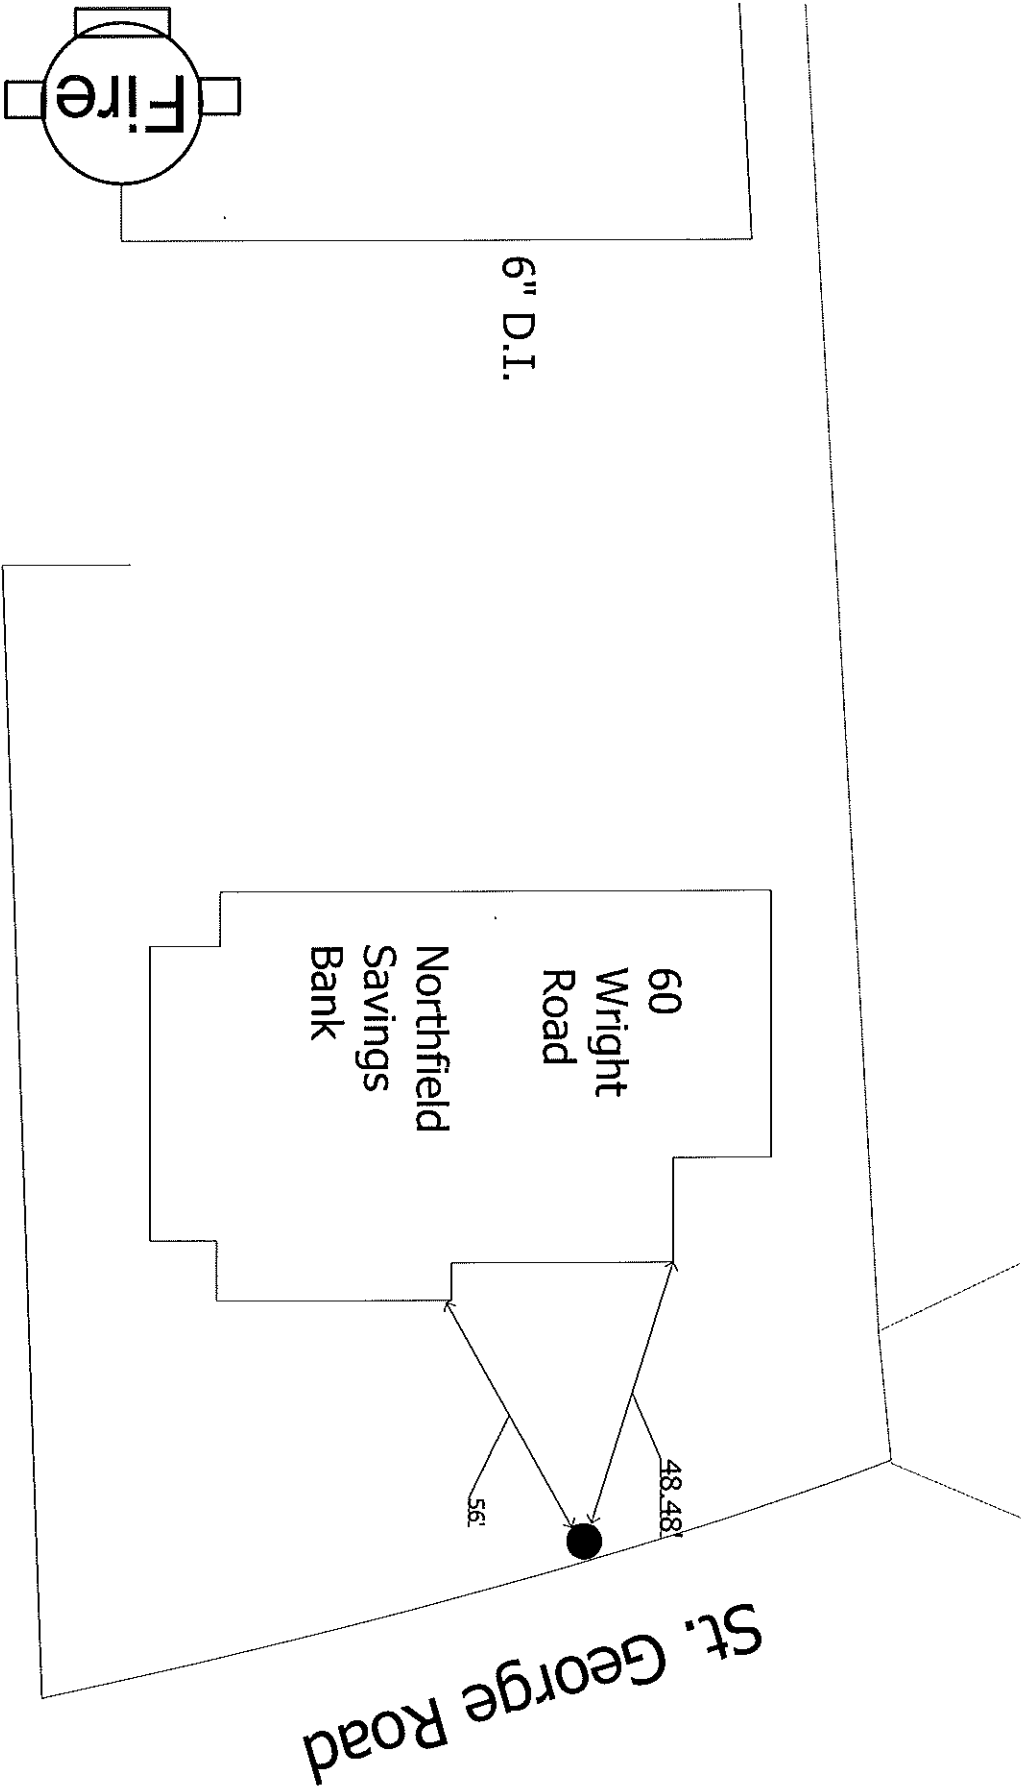

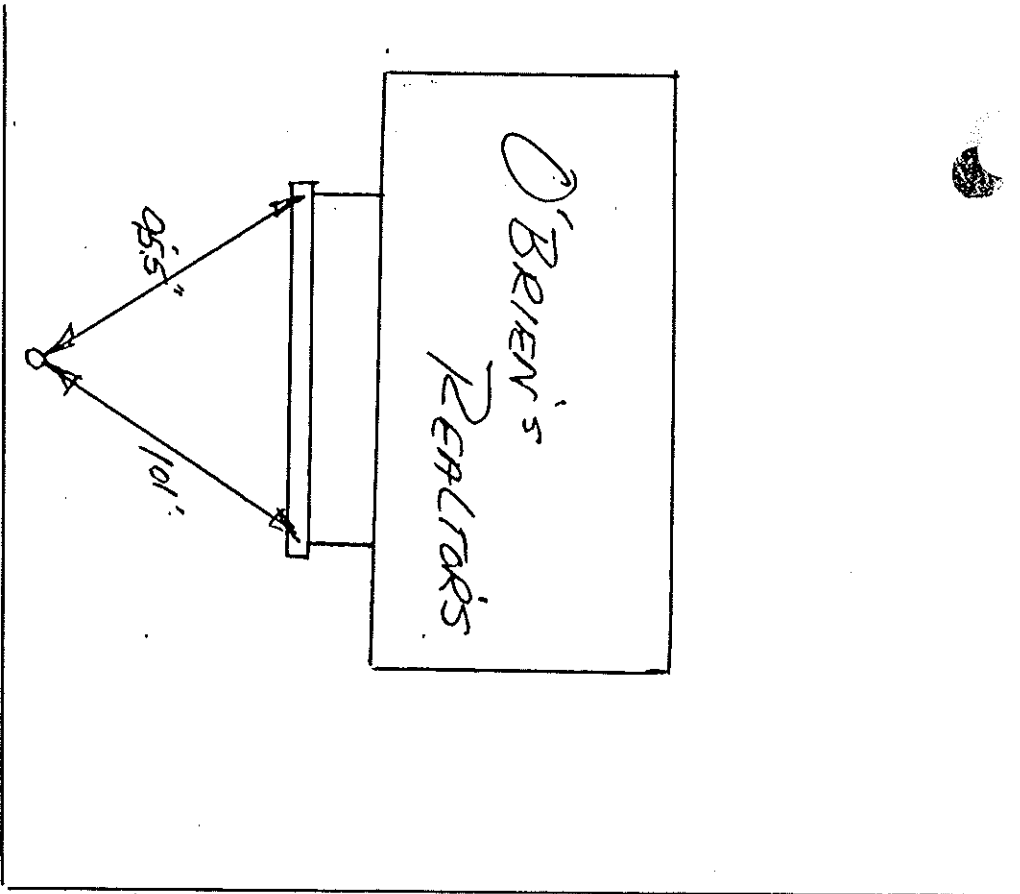

R21-2A

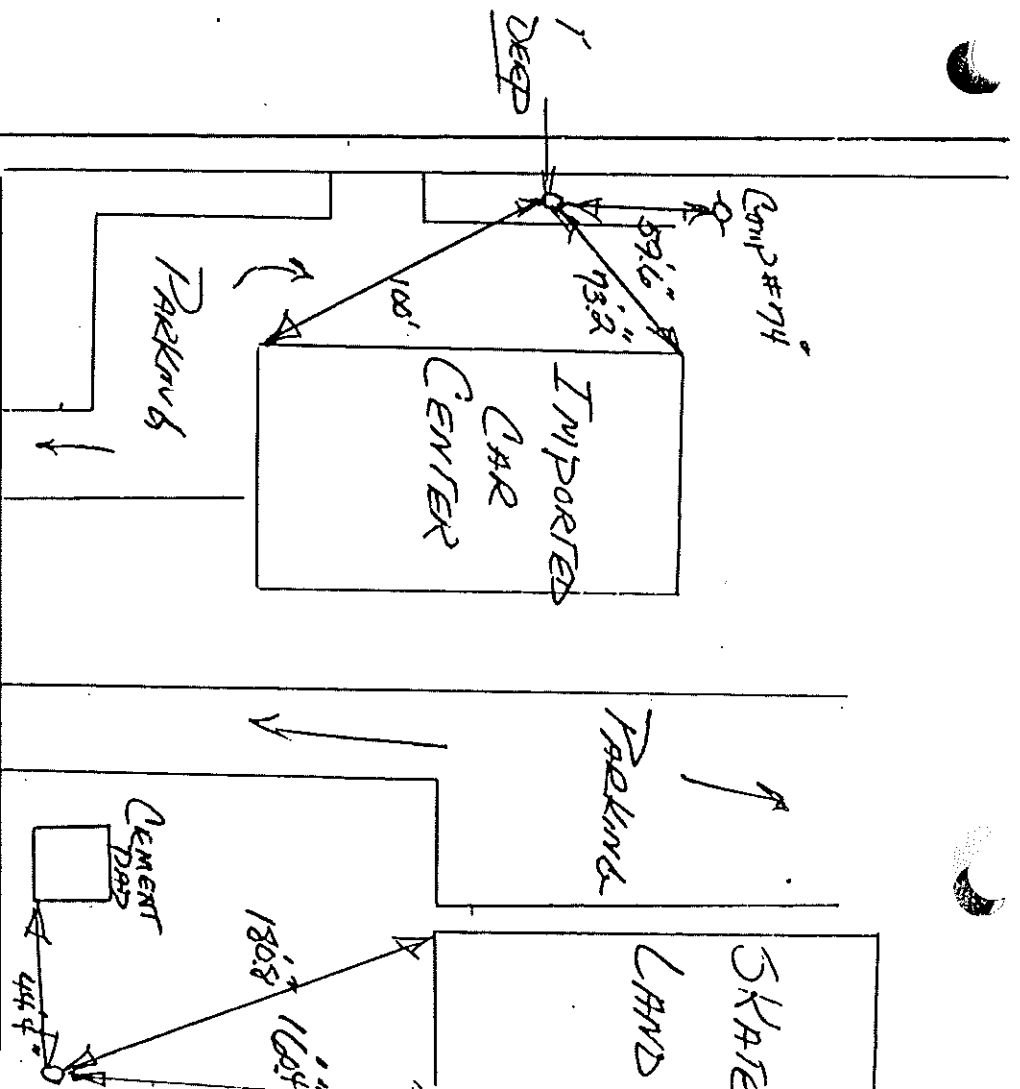

#63

#62

NORTH →

E 1451

Route 2A

→ South

63

O'BRIEN'S  
REALTORS

SEE  
PLAN

56' 5"

17' 6"

100' 2"

Stallford  
&  
SON  
Glass Co.

7

6

9

11' 2"

928"

1945"

Imported Car  
Center

Vermont  
Auto  
Glass.  
Installed  
meter  
10/6/57  
WJS

PARKING  
Lot

Gmp #3  
50


76.16

66"

50

Masonic  
Center



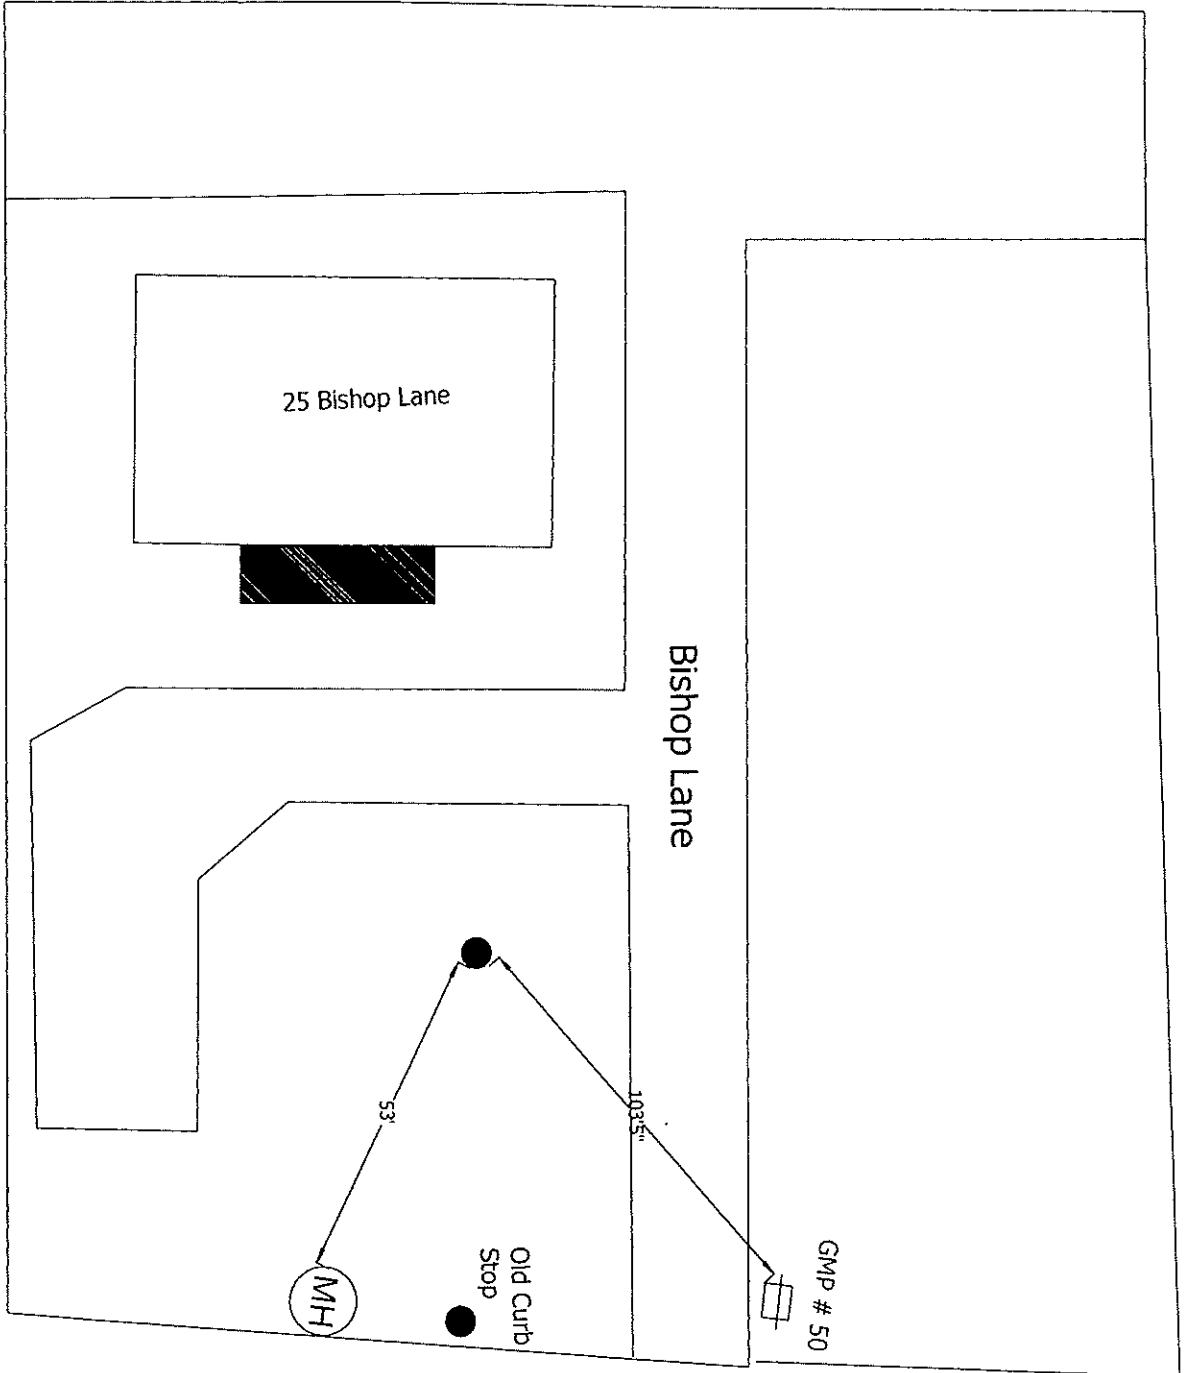

# Ponderosa

Fatt Corners Comm. Park

Lot 30

Marshal Ave.



curb stop

Transformer


24'6"


20'6"

(2" copper service)


Sidewalk

2A


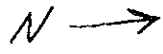


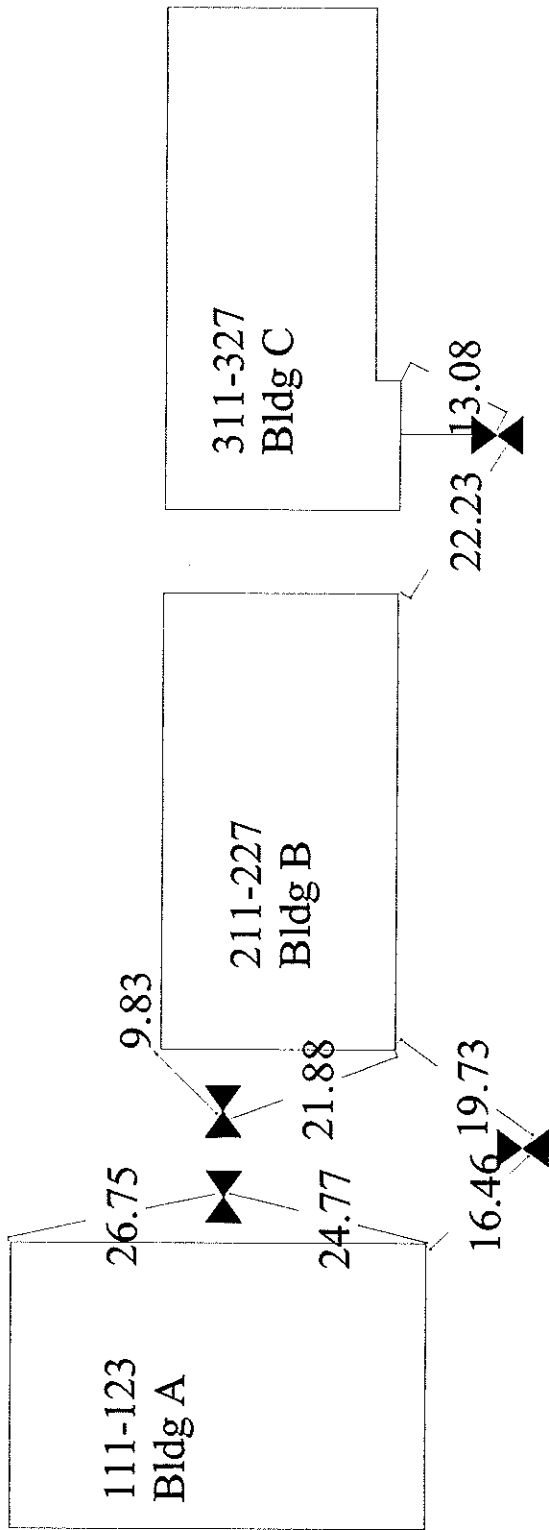


*MTP Hoousing*


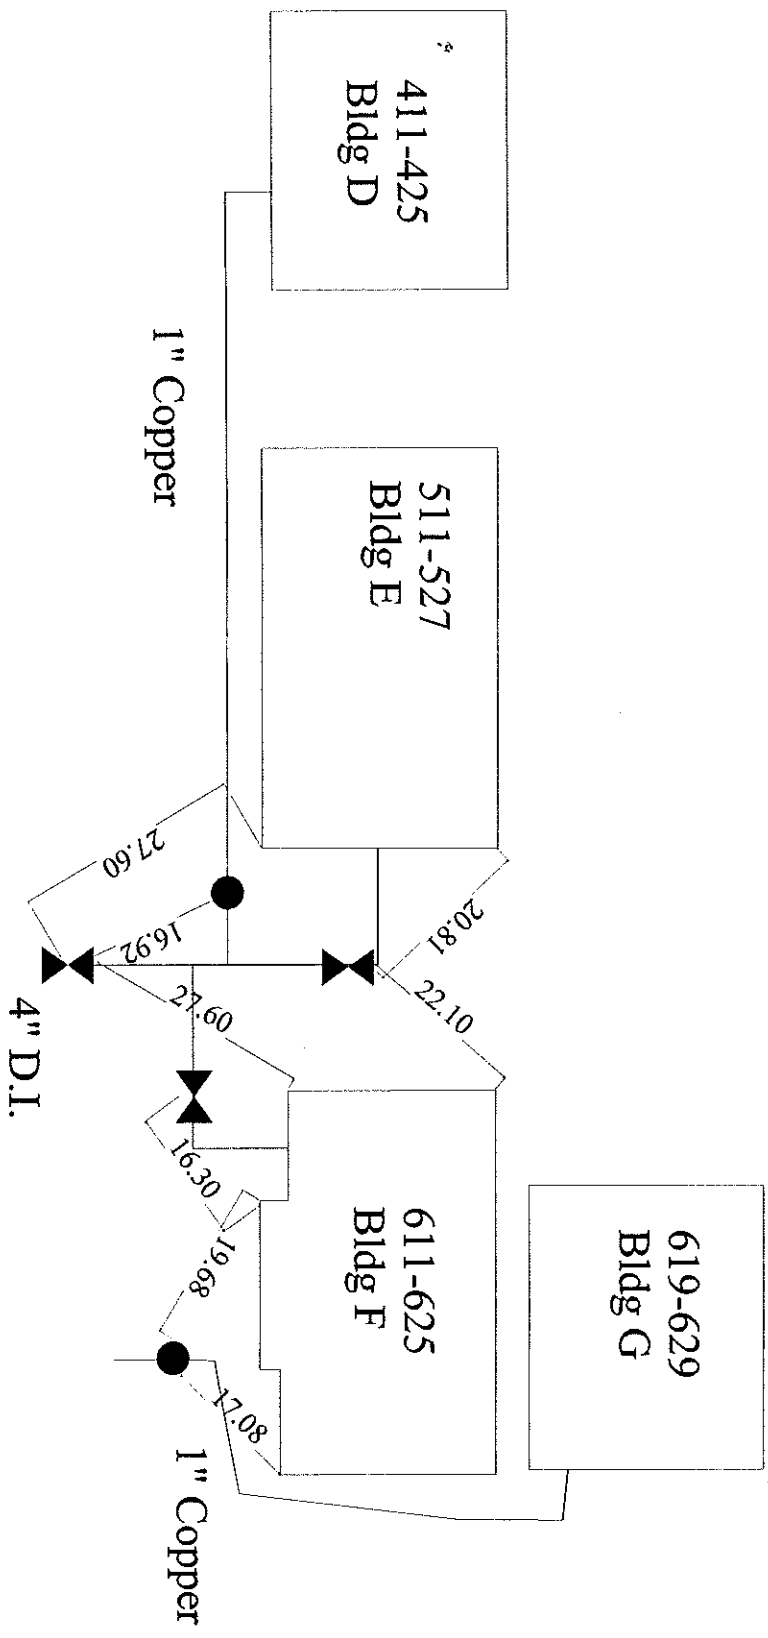



*MTP Housing*

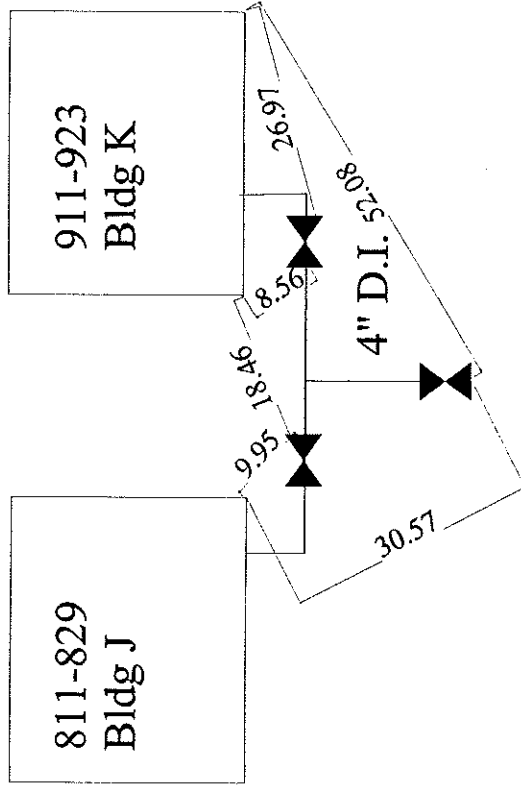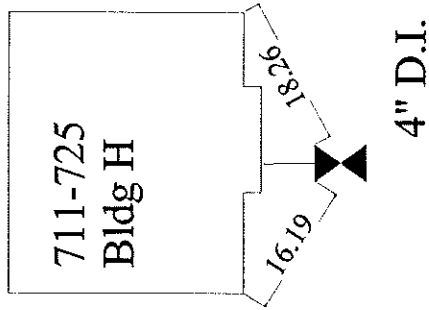


*MTP Housing*

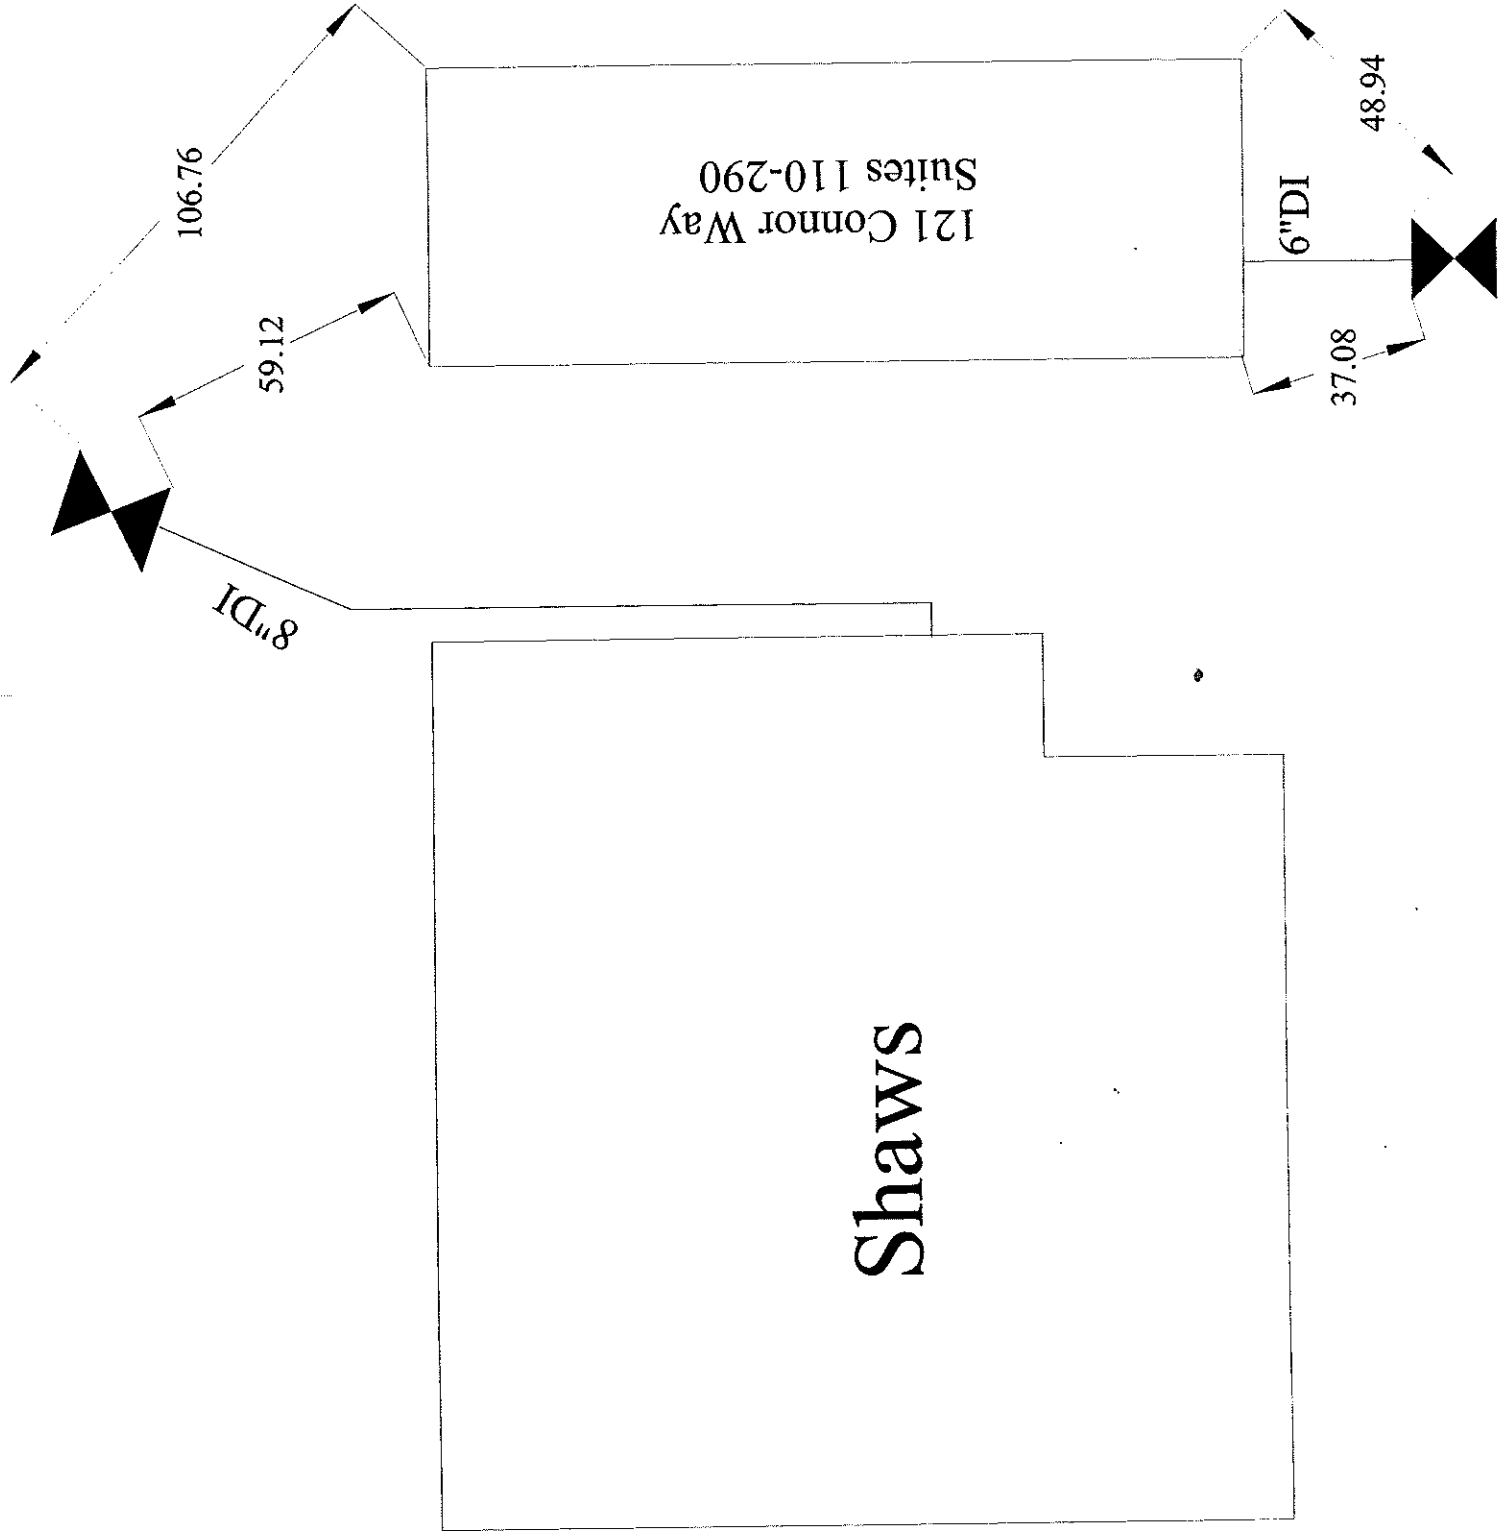

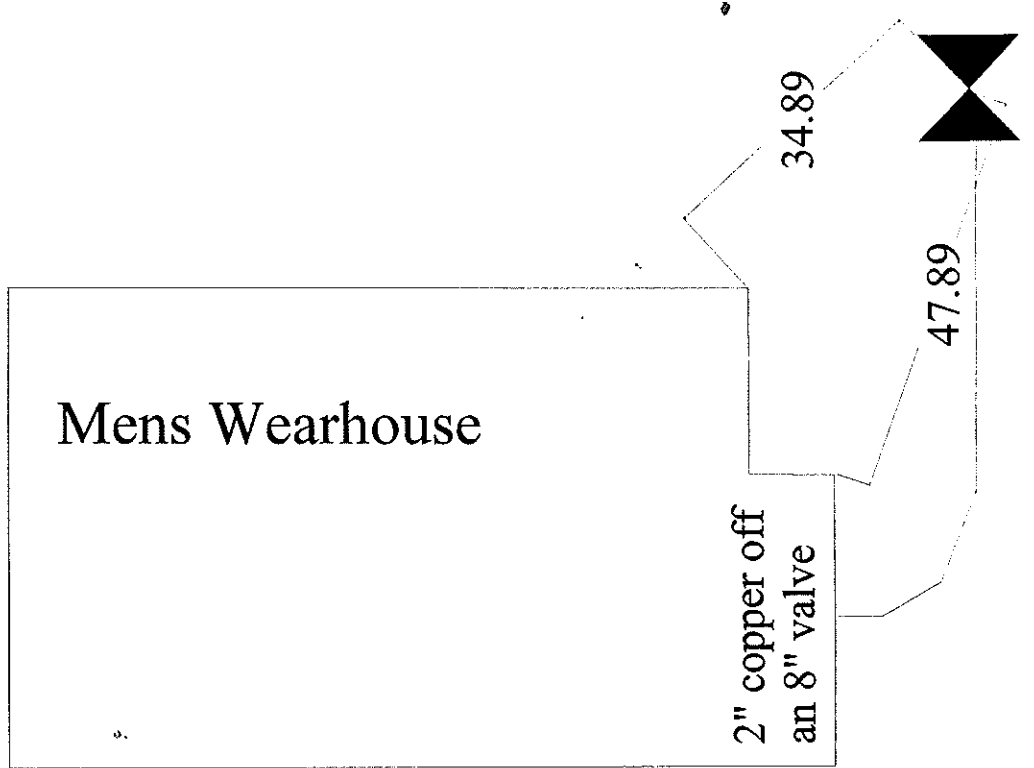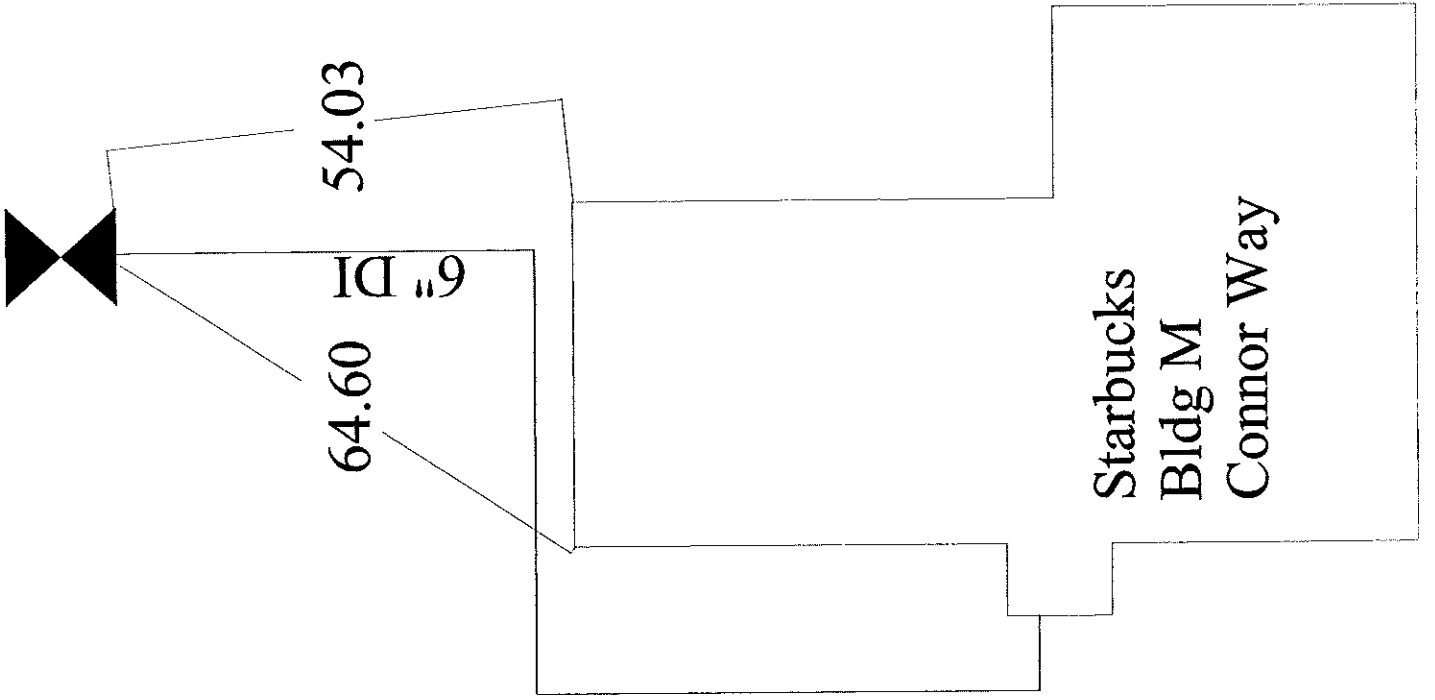


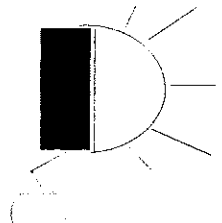

160.98

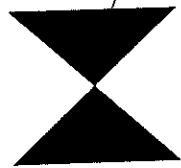


94.49

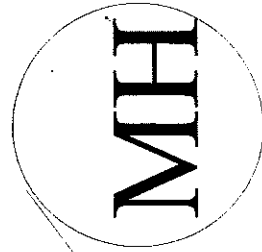

166 Sycamore St.

Bldg D

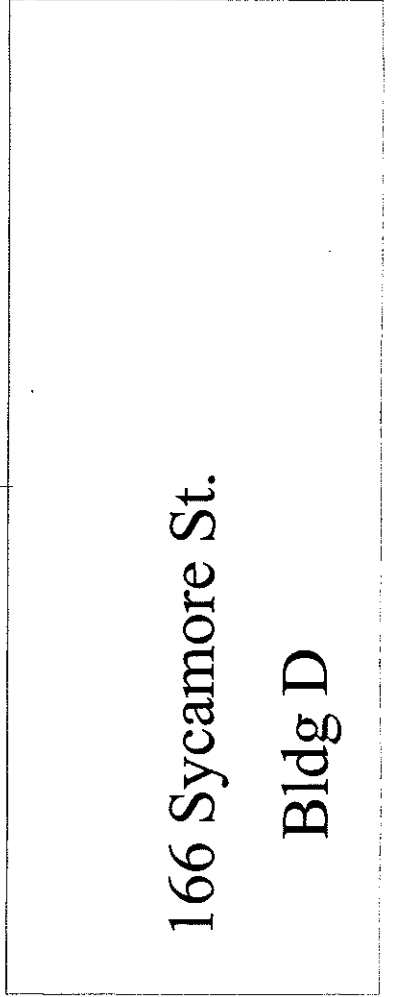




# Bldg A Theatre


•  
Loading  
Dock


57.50

51.96


8" DI

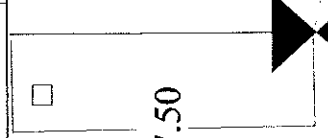


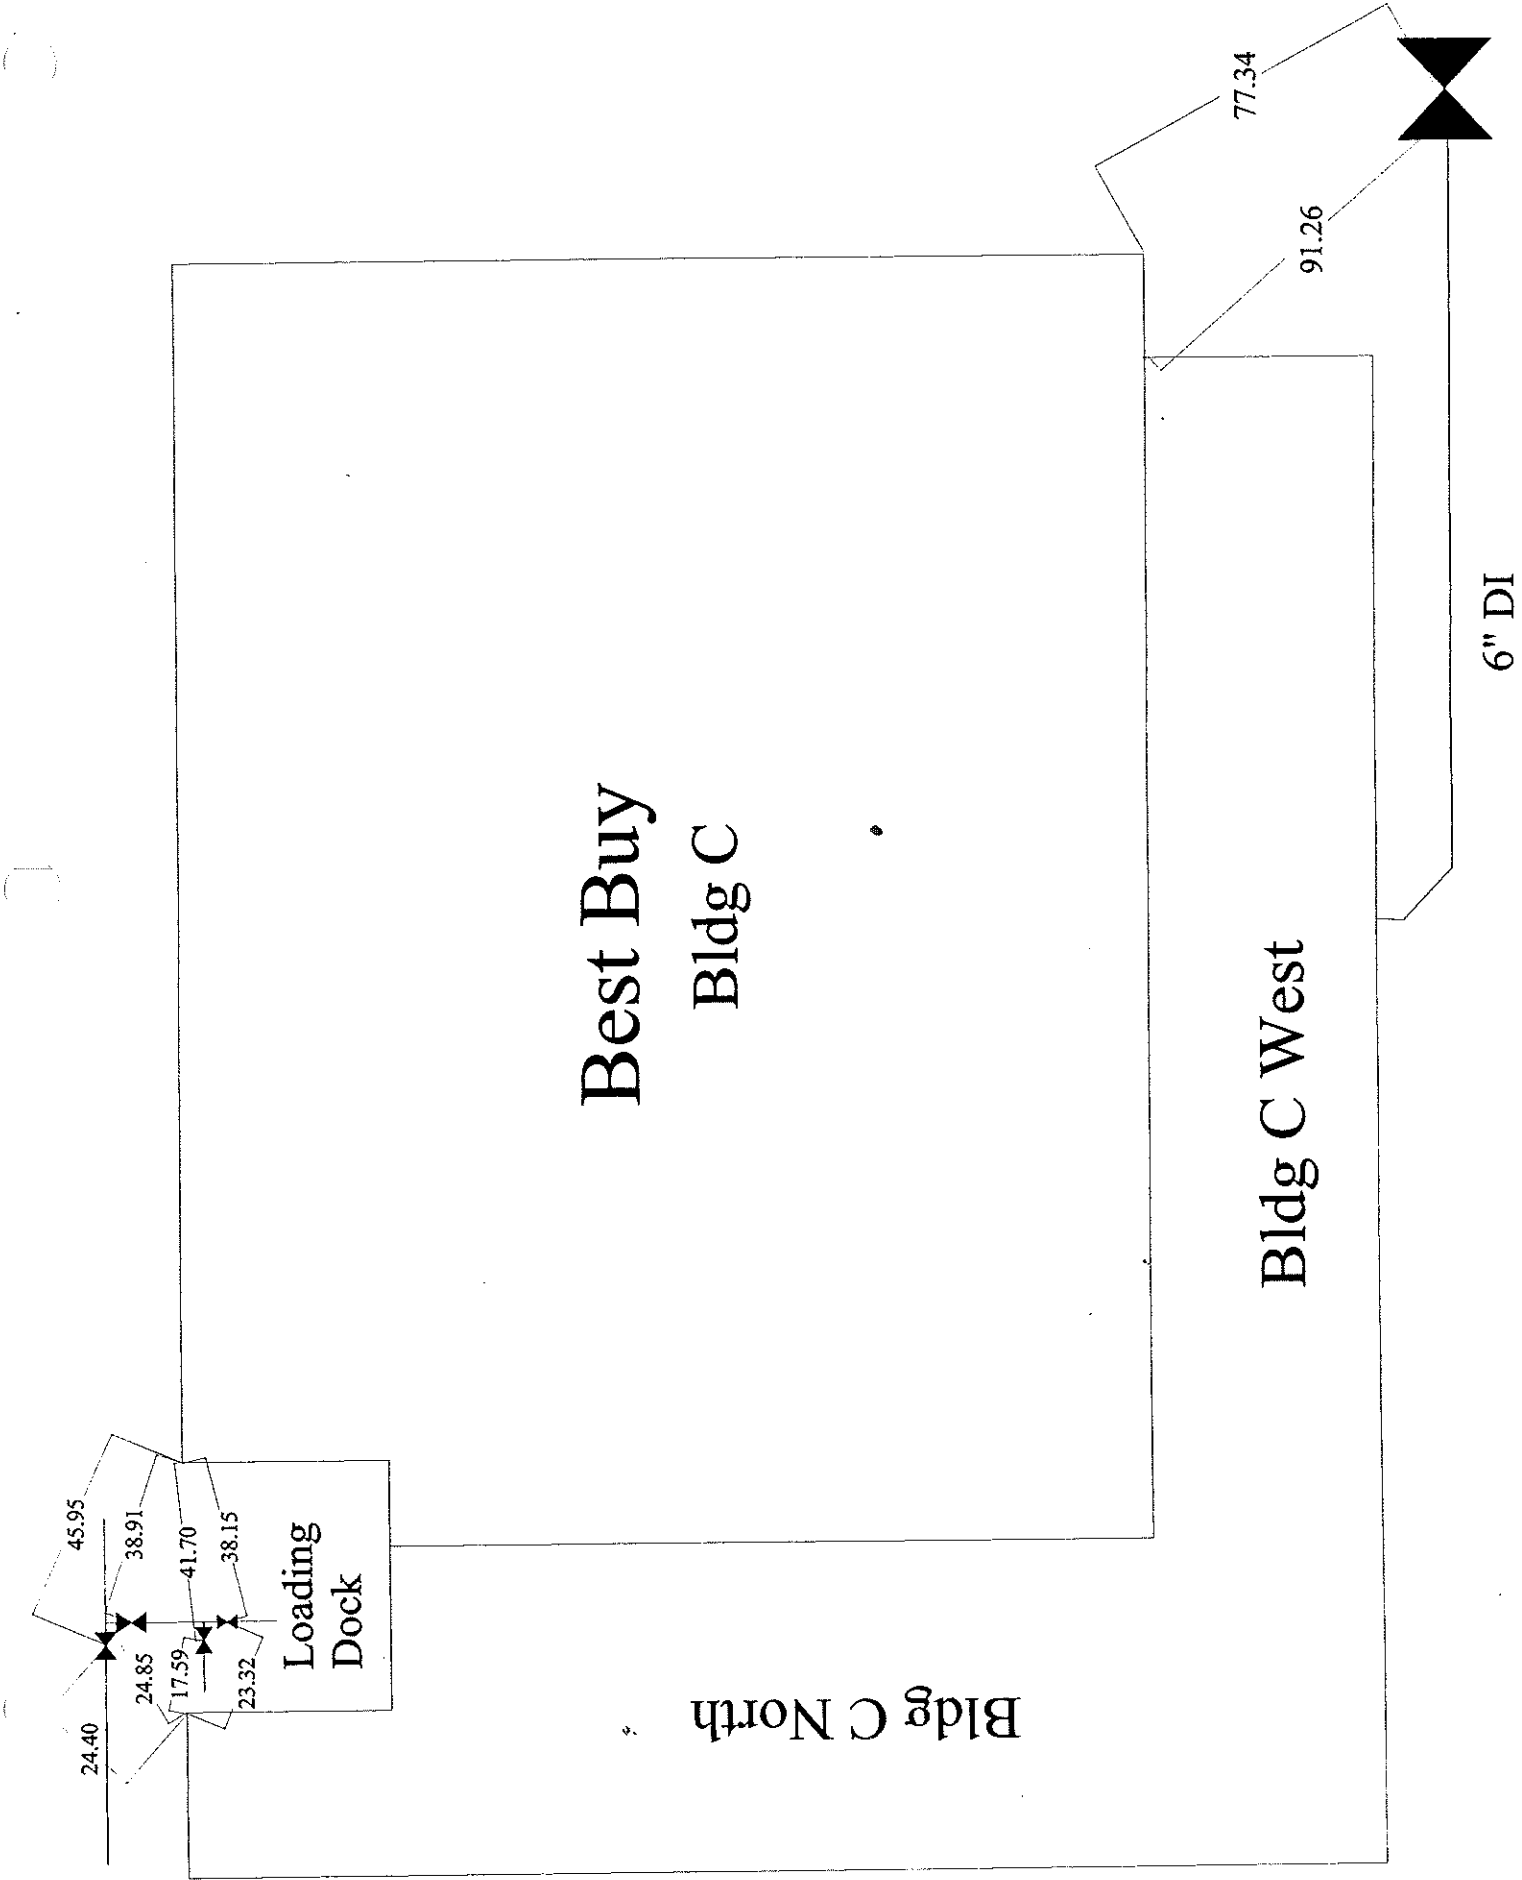

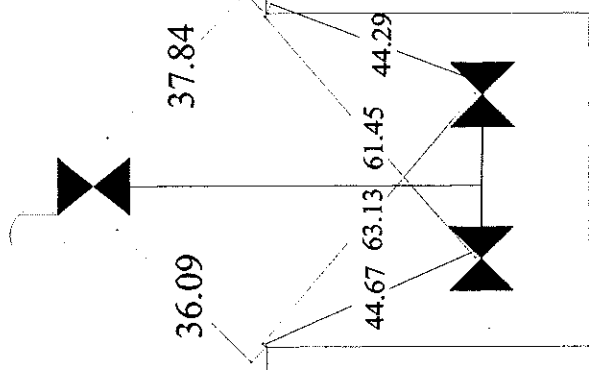

# Building B Christmas Tree Shops

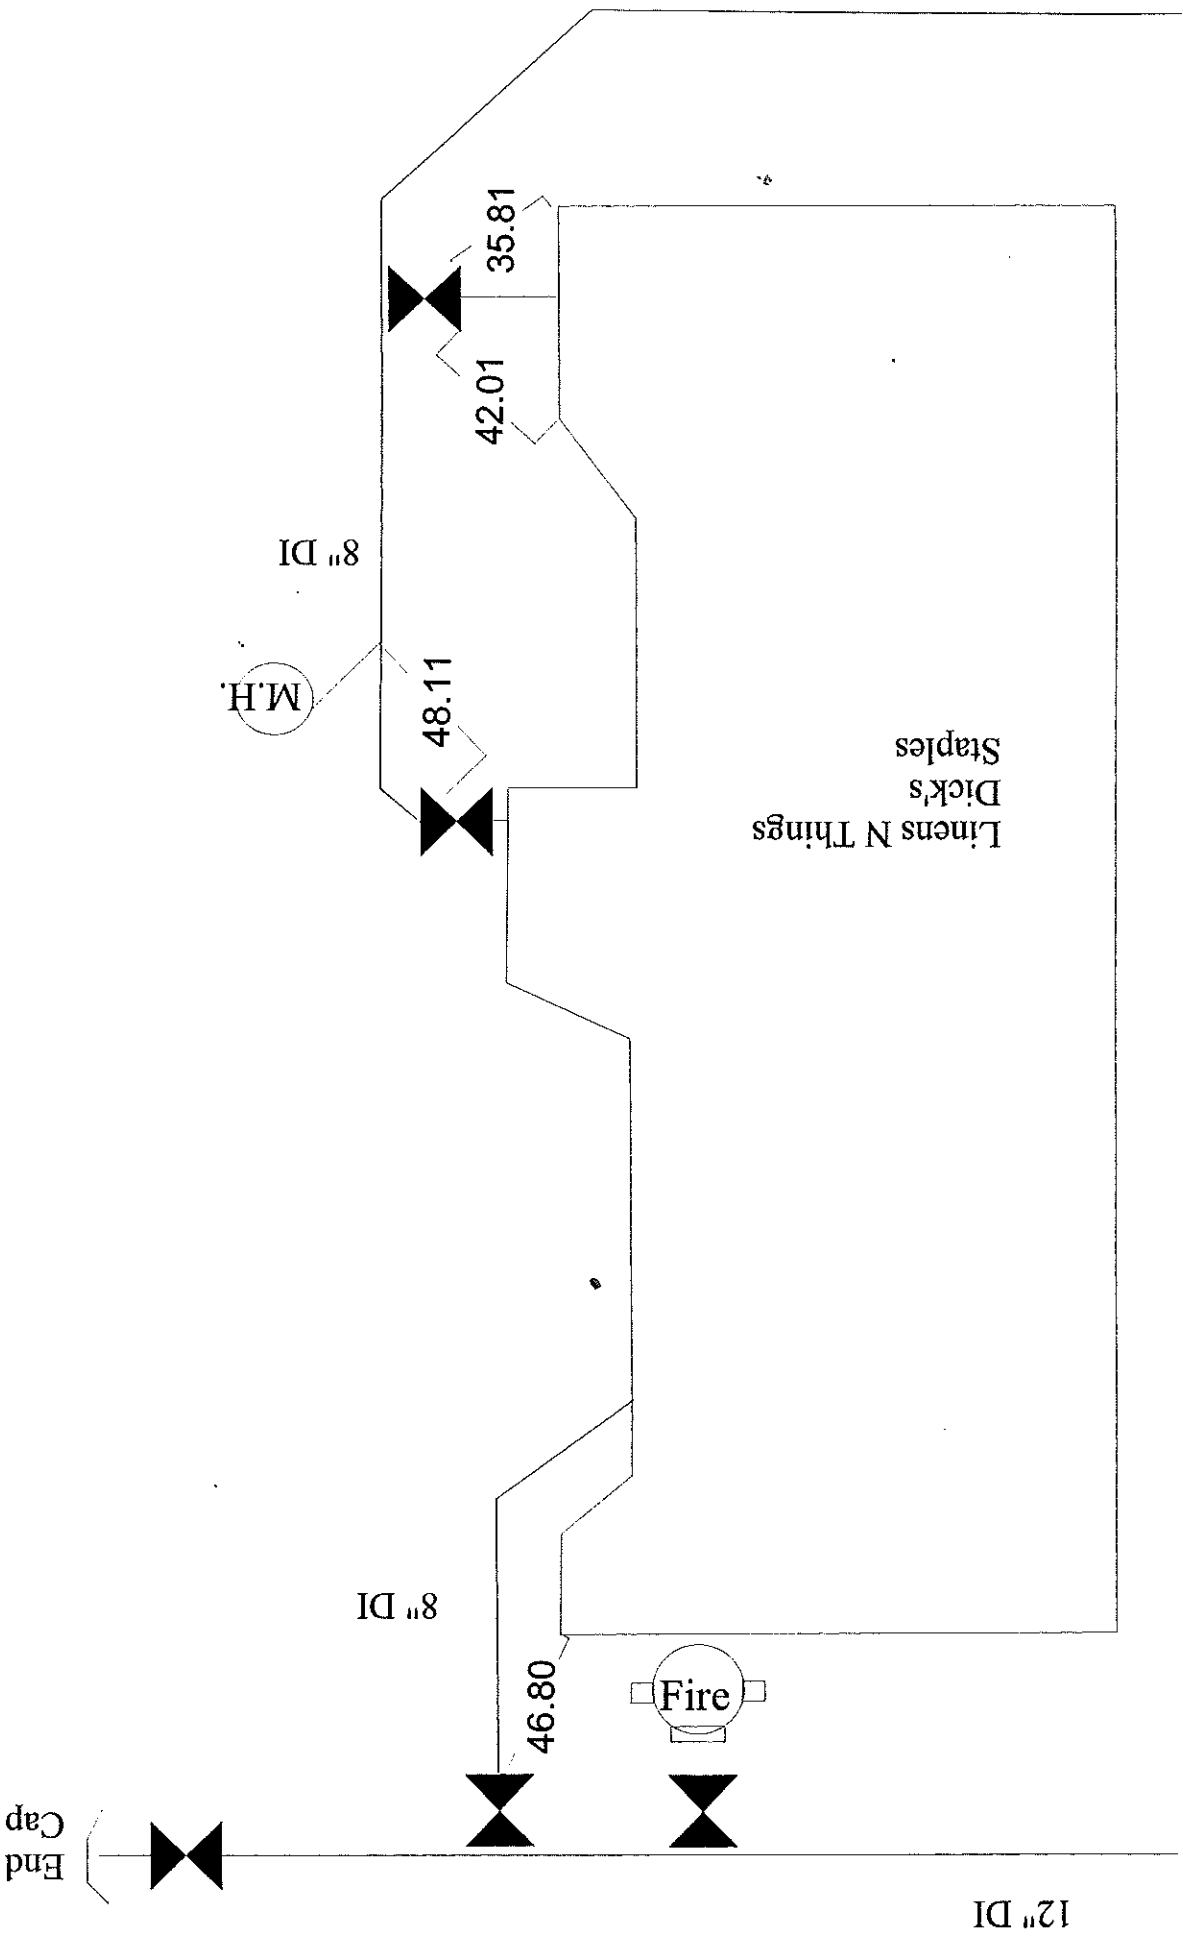

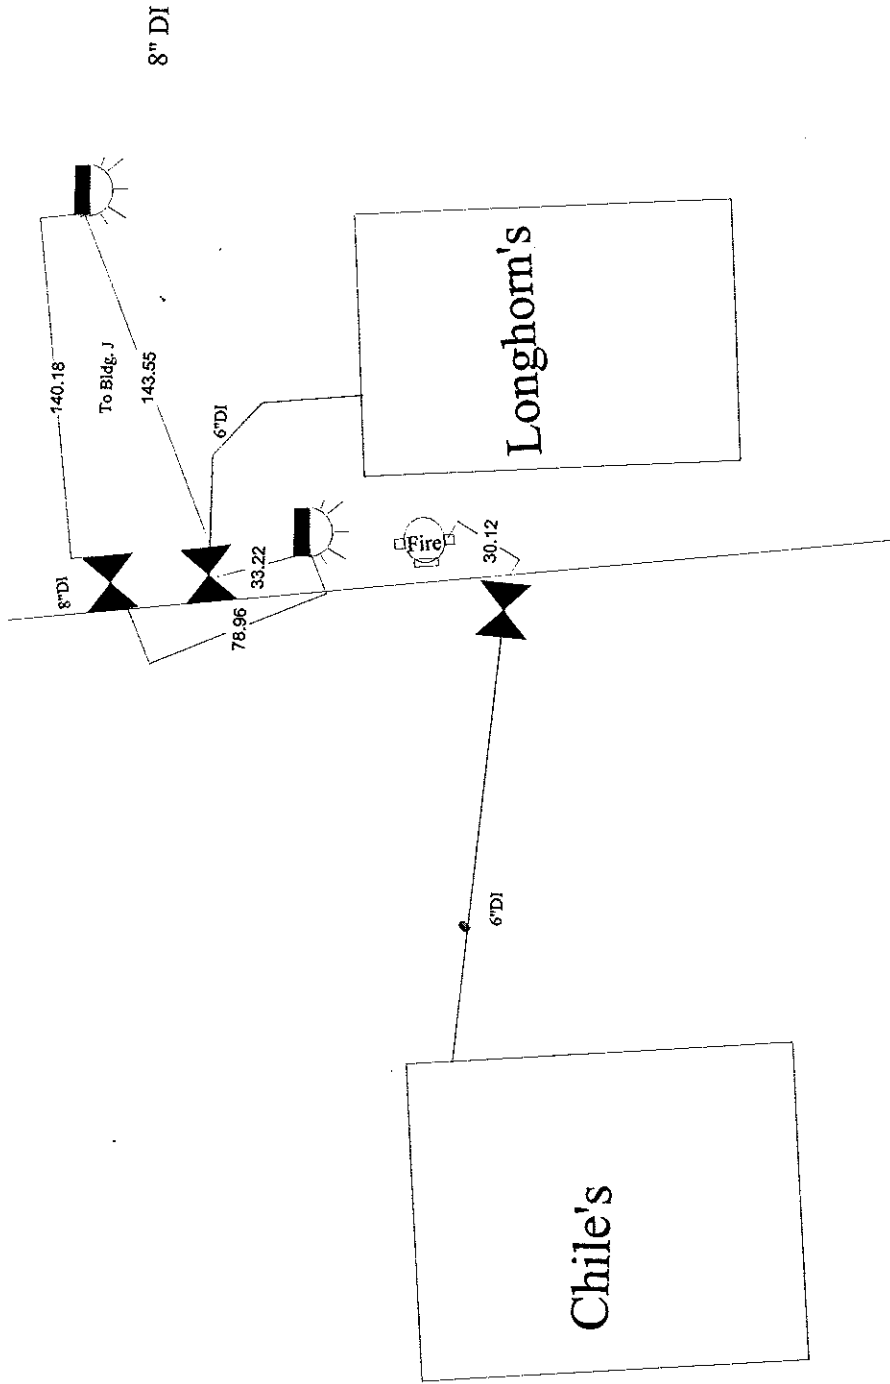


EAST

# 67

# 66

Route 2


# 6202

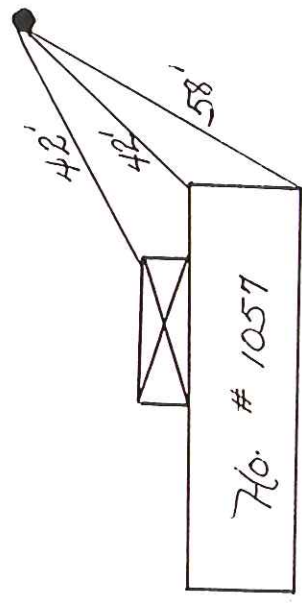


West

South

I 89

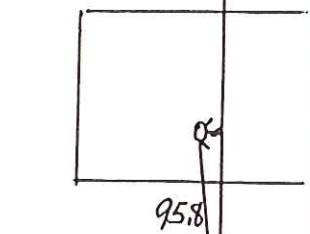


Sunoco sign

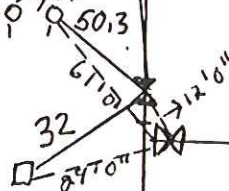


100/12

see next page curb stops

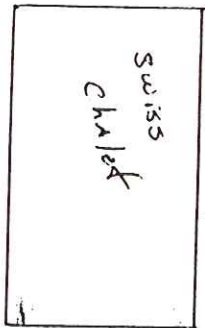

RT 2A

#69

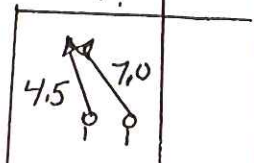


Green Mt power sign


#69

95.4'

9/97

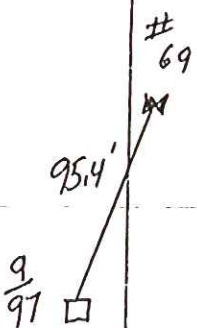

Curb Steps  
Susse Chalet

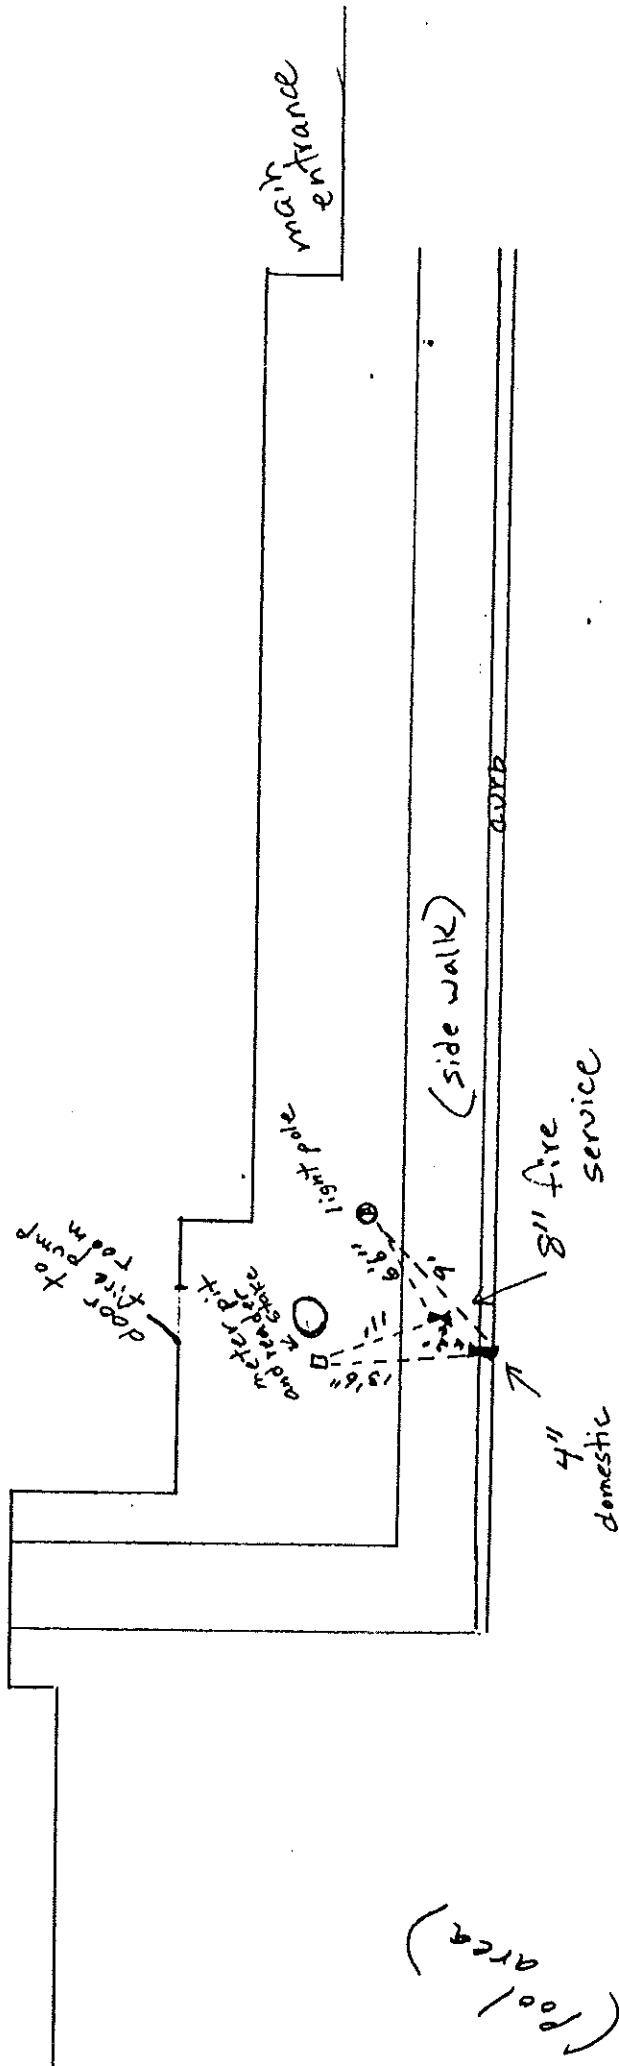


(Parking lot)

← interstate  
Rt. 2A ↓



East

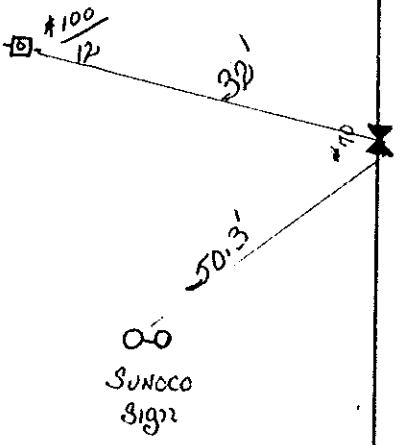

Route 2A

West

WEST

80