


5/10/96

	From Hyd	SMH
Dist. to curb stop A-	4'-6"	17'-2"
Dist. to curb stop B-	5'-1"	17'-0"
Dist. to curb stop C-	5'-8"	17'-1"
Dist. to curb stop D-	6'-4"	16'-11"
Dist. to curb stop E-	7'-0"	16'-2"
Dist. to curb stop F-	7'-11"	16'-5"
Dist. to 6" back Valve -	5'-8"	24'
Dist. to cleanout 1 -	24'	5'
Dist. to cleanout 2 -	20'-7"	3'-7"

C = Unit 12  
 D = Unit 16

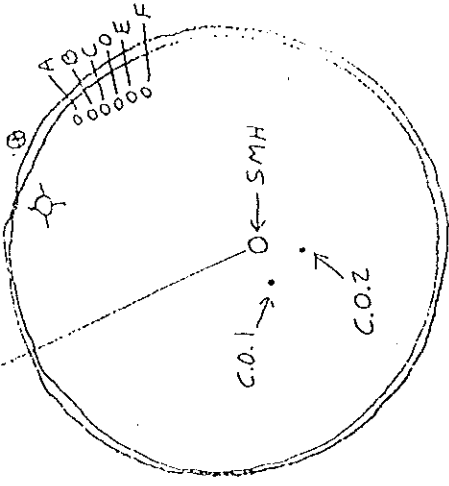

N.T.S

River Cove Swing Ties

