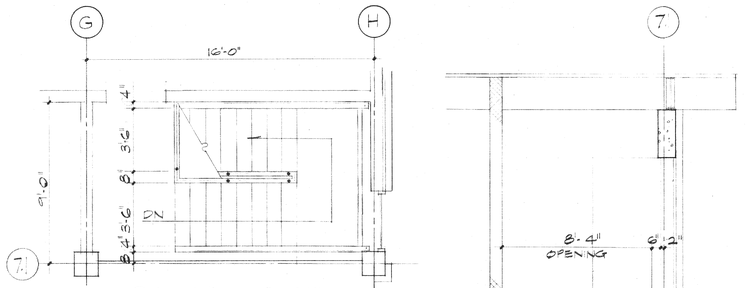

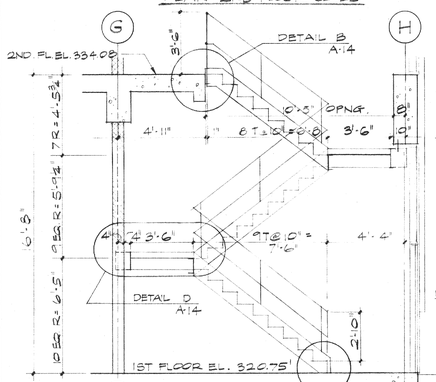

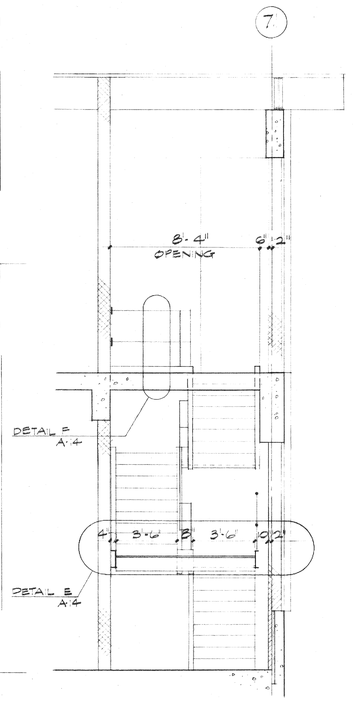

STAIR Nº 1 / FIRST FLOOR PLAN IS SHOWN ON DWG A-1 /

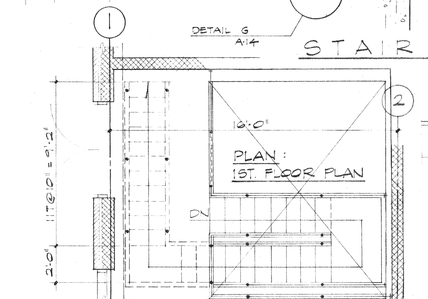

STAIR Nº 4

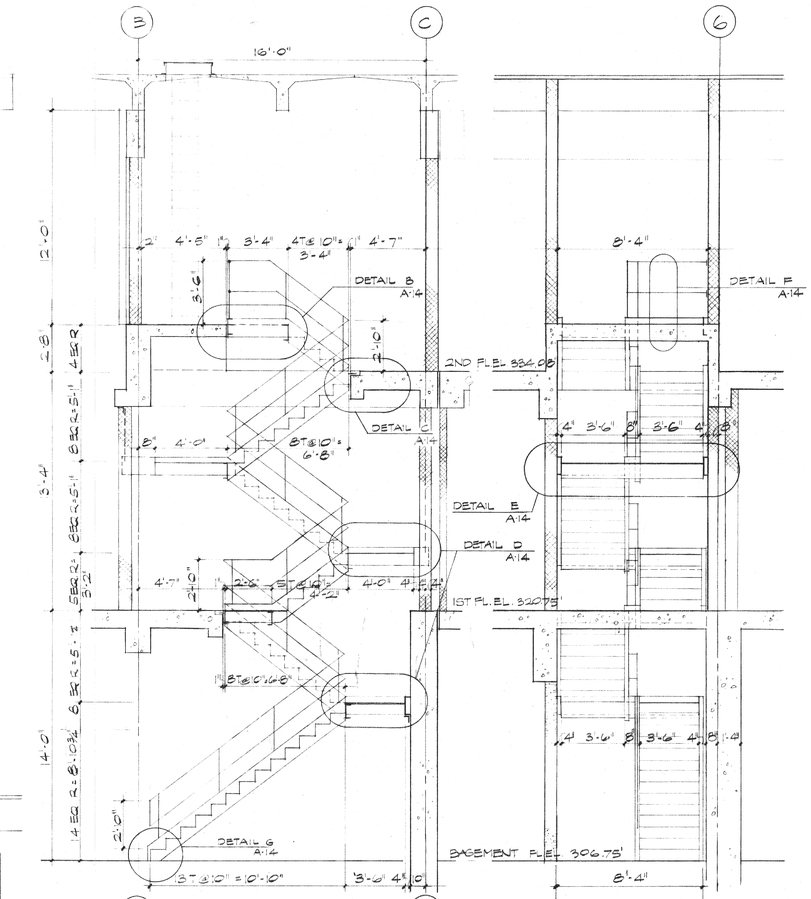

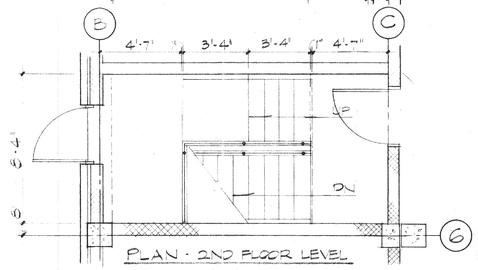

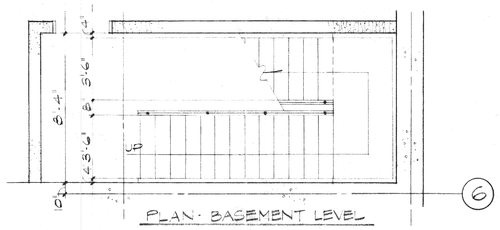

STAIR Nº 2 / FIRST FLOOR PLAN SHOWN ON DWG. A-6 /

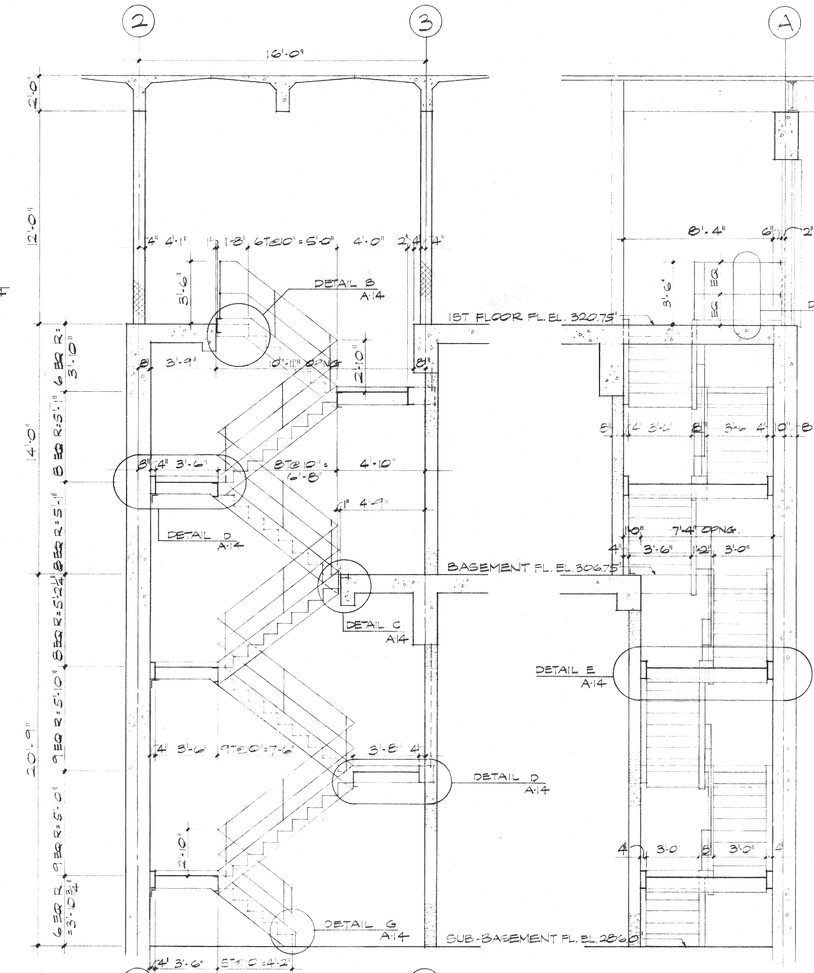

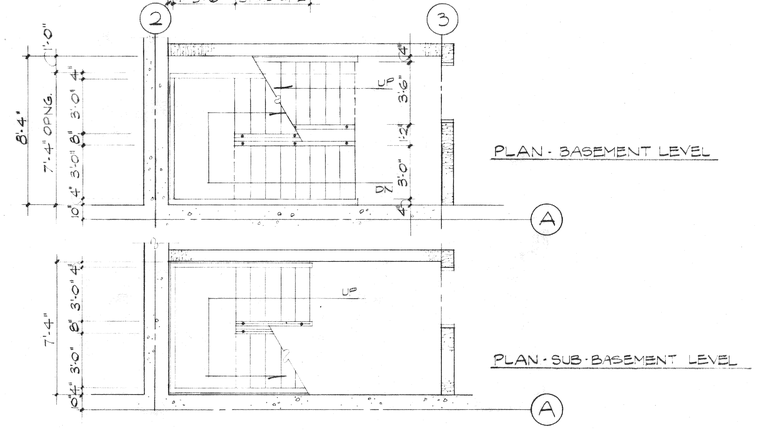

STAIR Nº 3 / FIRST FLOOR PLAN SHOWN ON DWG. A-6 /

RECORD DRAWING

NUMBER	DATE	MADE BY	CHECKED BY	DESCRIPTION

REVISIONS

DRAWN BY: M Schumann

DEPT. CHECK: M Kilton

PROJ. CHECK: R J Marshall

MICHAEL EUGENE GRILLI No. 3620 REGISTERED PROFESSIONAL ENGINEER

METCALF & EDDY, INC. / ENGINEERS
BOSTON / NEW YORK / PALO ALTO / CHICAGO

Edward P. Habasevich — REG. ARCH. — MASS. NO. 3456 — DATE 6-20-1977

Michael E. Grilli — REG. PROF. ENGR — R.I. NO. 3620 — DATE 6-27-77

SCALE: 1/4" = 1'-0"

UNLESS OTHERWISE NOTED OR CHANGED BY REPRODUCTION

TOWN OF BURRILLVILLE, RHODE ISLAND
BOARD OF SEWER COMMISSIONERS

WASTEWATER TREATMENT FACILITIES

STAIRS AND STAIR DETAILS I

ARCHITECTURAL

JOB 4868

FILE NO. H-68981-1

SHEET A-13

MAKEPEACE P-1457