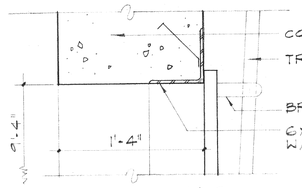

H-3

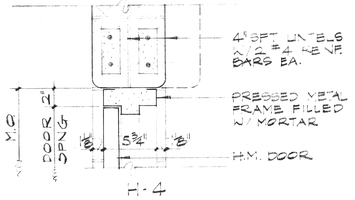

H-4

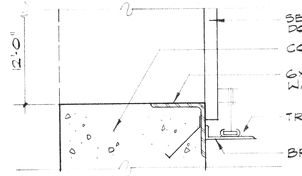

J-9

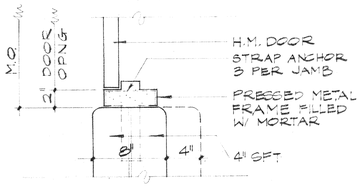

J-10

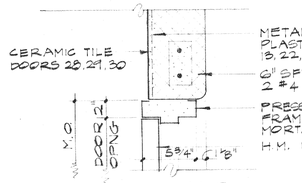

H-5

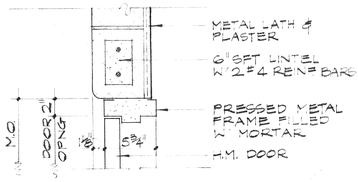

H-6

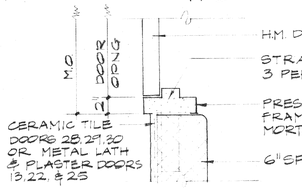

J-11

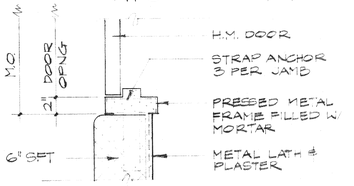

J-12

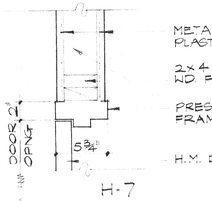

H-7

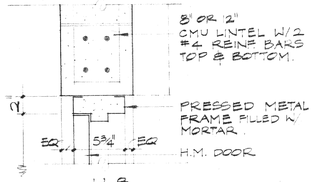

H-8

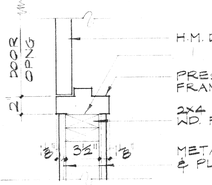

J-13

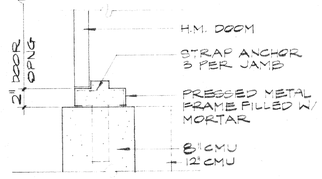

J-14

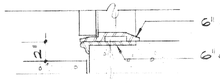

S-1

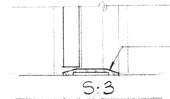

S-3

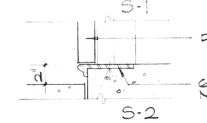

S-2

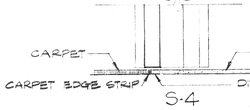

S-4

DOOR DETAILS CONTINUED FROM DWG A-15

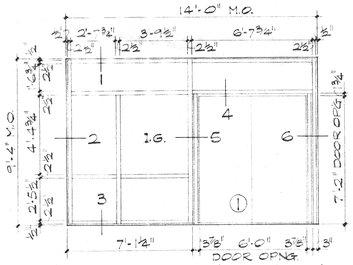

W-1 (ENTRANCE)

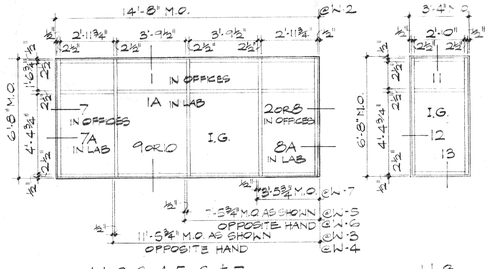

W-2,3,4,5,6&7

W-8

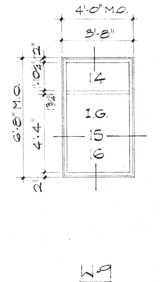

W-9

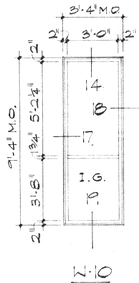

W-10

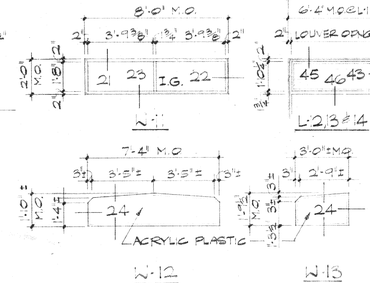

W-11

W-12

L-2,3 & 14

W-13

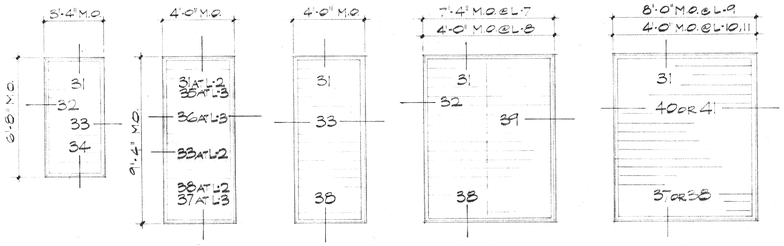

L-1 L-2&3 L-4&5 L-7&8 L-9,10&11

WINDOW WALL & LOUVER TYPES SCALE ½" = 1'-0"

WINDOW WALL DETAILS ARE SHOWN ON DWG A-17. SEE SPEC'S FOR GLAZING TYPES.

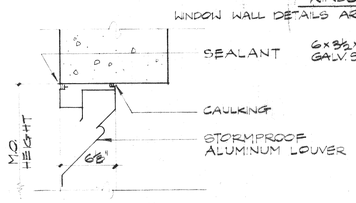

31

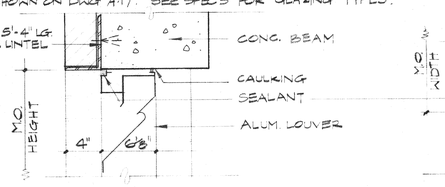

35

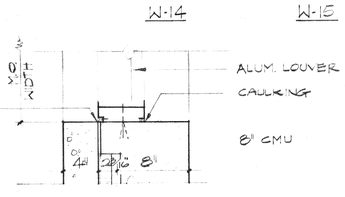

39

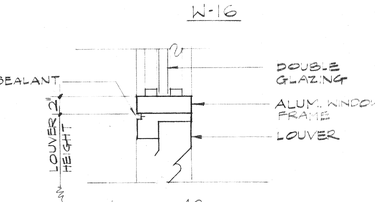

42

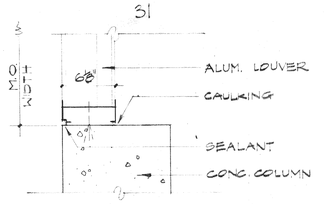

32

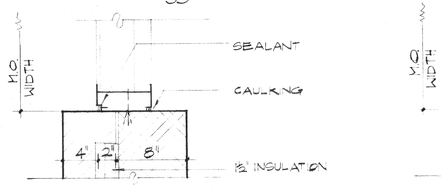

36

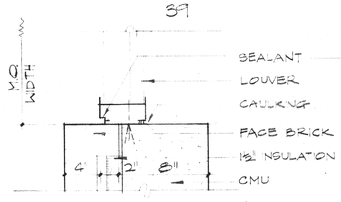

40

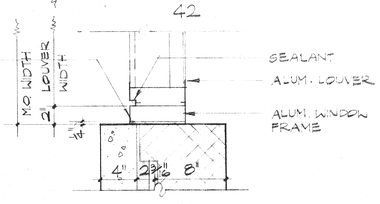

43

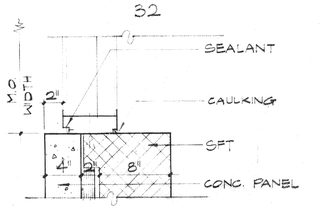

33

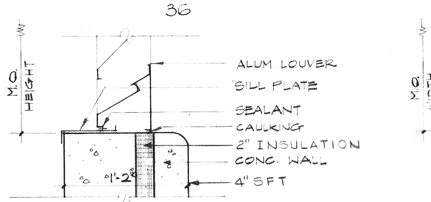

37

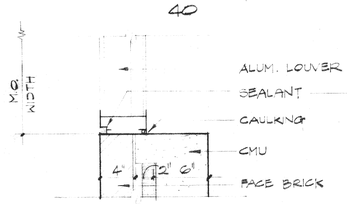

41

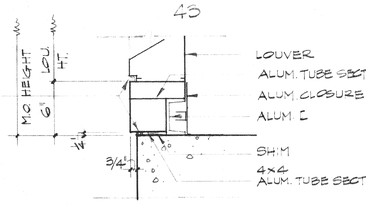

44

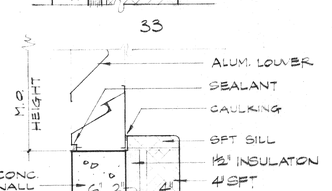

34

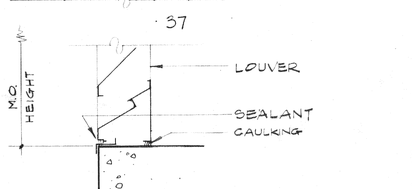

38

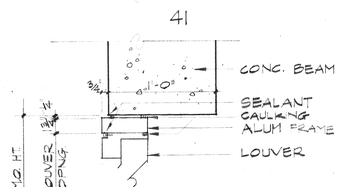

45

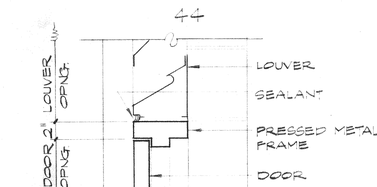

46

LOUVER DETAILS SCALE 1½" = 1'-0"

RECORD DRAWING

NUMBER	DATE	MADE BY	CHECKED BY	DESCRIPTION
				REVISIONS

DRAWN BY: M. Schumann
DEPT. CHECK: N. Klepon
PROJ. CHECK: R.J. Marshall

MICHAEL EUGENE GRILLI No. 3620 REGISTERED PROFESSIONAL ENGINEER

METCALF & EDDY, INC. / ENGINEERS
BOSTON / NEW YORK / PALO ALTO / CHICAGO

Clayton L. Hathaway — 6-20-1977
REG. ARCH. MASS. NO. 3454 — DATE
Michael E. Grilli — 6-27-77
REG. PROF. ENGR. R.I. NO. 3620 — DATE

SCALE: AS SHOWN

UNLESS OTHERWISE NOTED OR CHANGED BY REPRODUCTION

TOWN OF BURRILLVILLE, RHODE ISLAND
BOARD OF SEWER COMMISSIONERS
WASTEWATER TREATMENT FACILITIES
DOOR AND LOUVER DETAILS
ARCHITECTURAL

JOB 4868
FILE NO. H-68984-1
SHEET A-16

MAKEPEACE P-1457