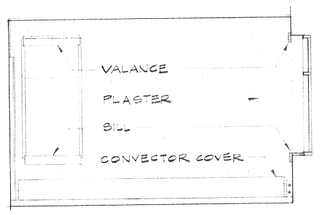

R

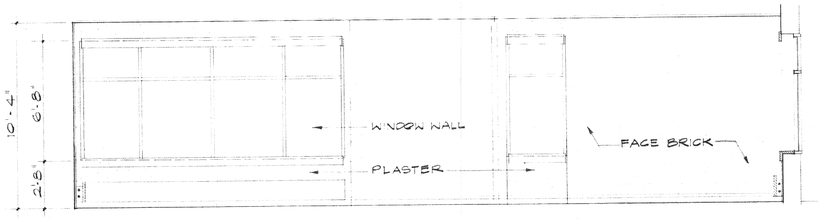

S

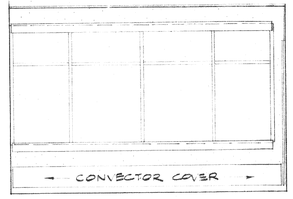

T

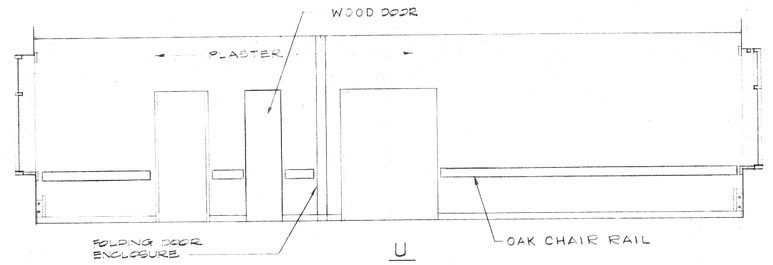

U

CONFERENCE ROOM

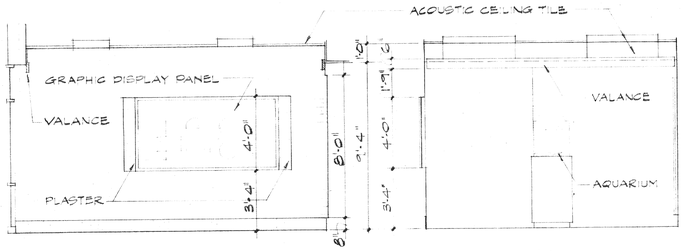

V W

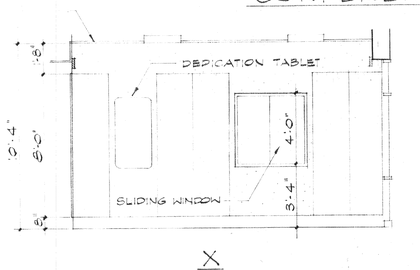

X

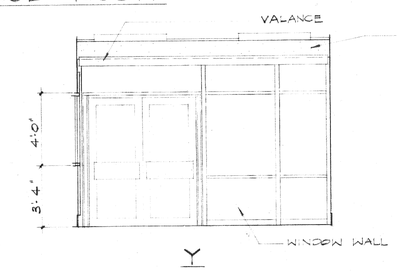

Y

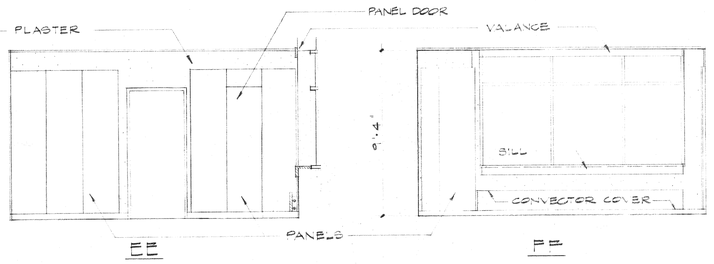

EE FF

LOBBY

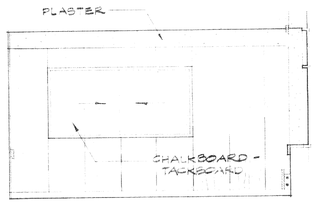

AA

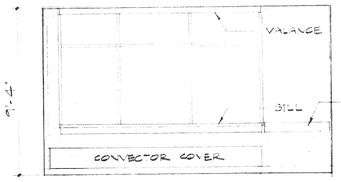

BB

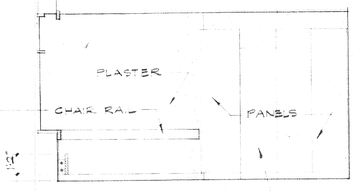

CC

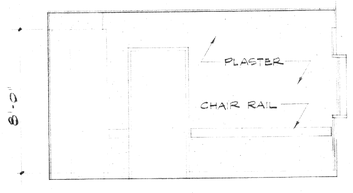

DD

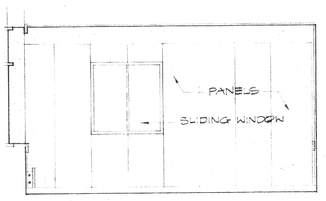

GG

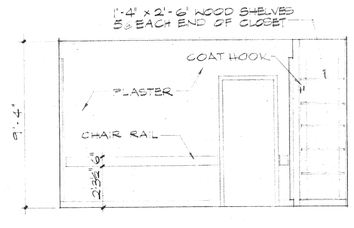

HH

SUPERINTENDENT'S OFFICE

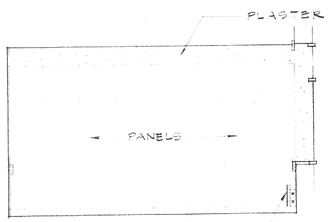

JJ

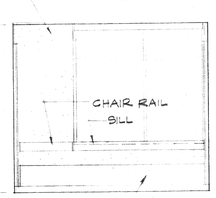

KK

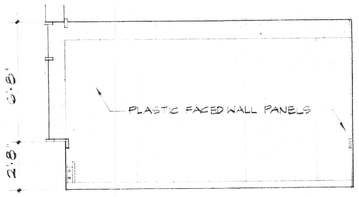

LL

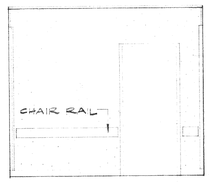

MM

GENERAL OFFICE

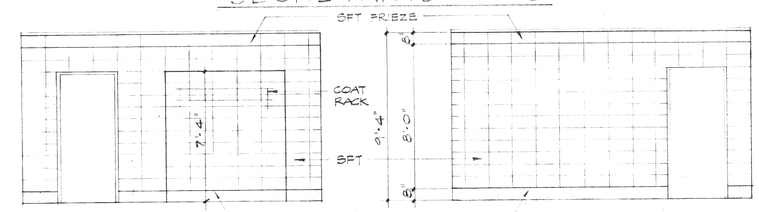

NN PP

SECRETARY'S OFFICE

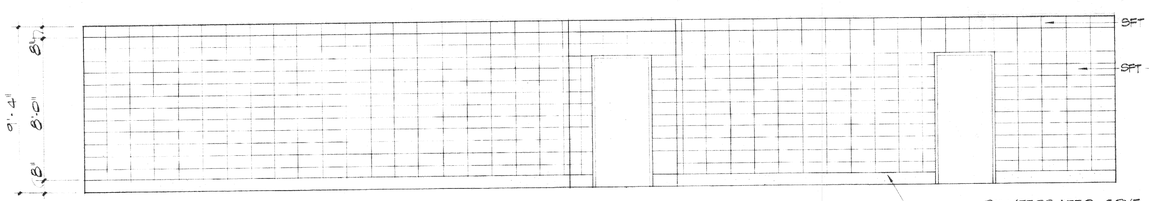

RR

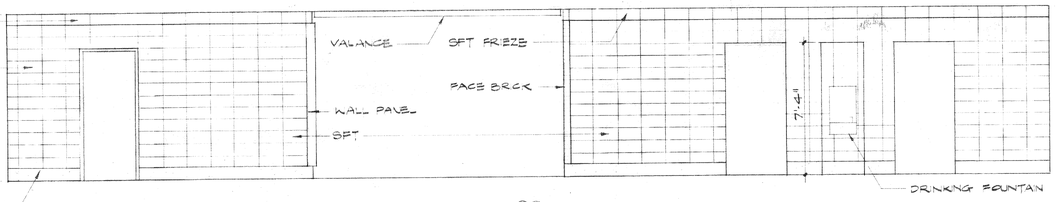

SS

CORRIDOR N° 1

RECORD DRAWING

NUMBER	DATE	MADE BY	CHECKED BY	DESCRIPTION

REVISIONS

DRAWN BY MCS

DEPT. CHECK M Wilson

PROJ. CHECK A J Trastek

MICHAEL EUGENE GRILLI No. 3620 REGISTERED PROFESSIONAL ENGINEER

METCALF & EDDY, INC. / ENGINEERS
BOSTON / NEW YORK / PALO ALTO / CHICAGO

Howard E. Hawkes REG. ARCH., MASS. NO. 3454 — DATE 6.20.1977

Michael E. Grilli REG. PROF. ENGR. R.I. NO. 3620 — DATE 6-27-77

SCALE: 1/4" = 1'-0"

UNLESS OTHERWISE NOTED OR CHANGED BY REPRODUCTION

TOWN OF BURRILLVILLE, RHODE ISLAND
BOARD OF SEWER COMMISSIONERS

WASTEWATER TREATMENT FACILITIES

OPERATIONS BUILDING
INTERIOR ELEVATIONS II

ARCHITECTURAL

JOB 4868

FILE NO. H-68976-1

SHEET A-8

MAKEPEACE P-1457