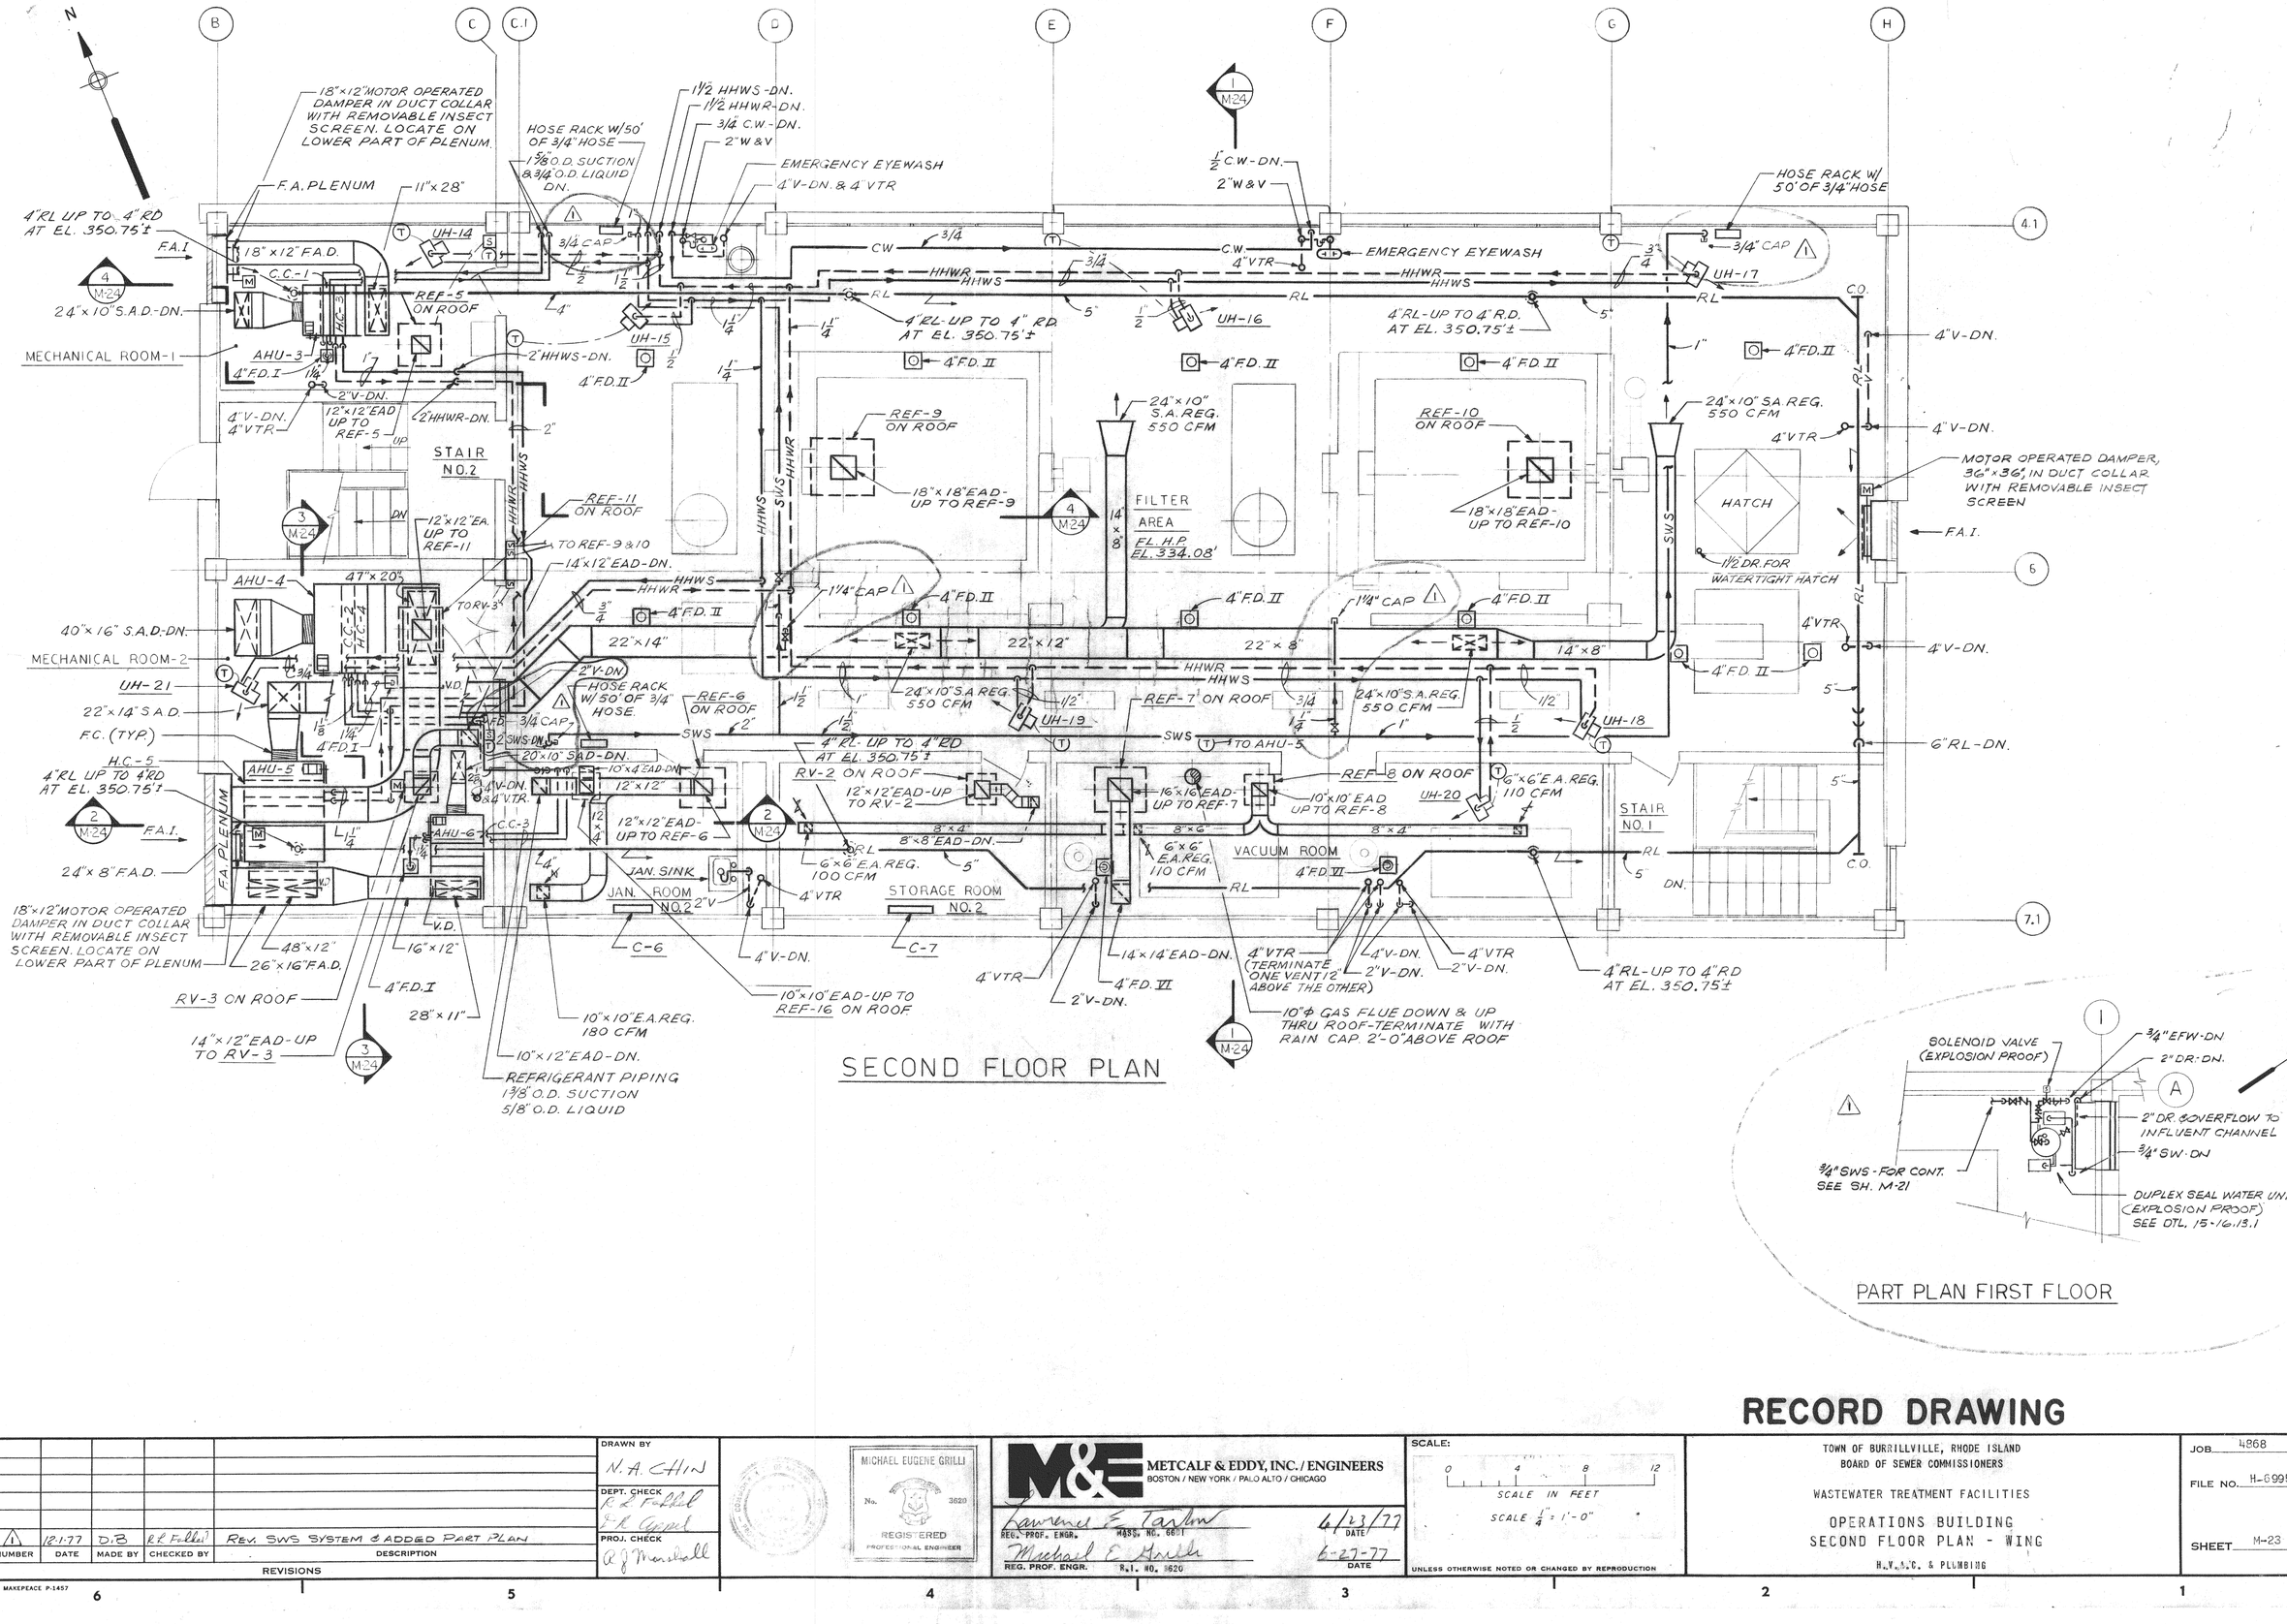

RECORD DRAWING

NUMBER	DATE	MADE BY	CHECKED BY	DESCRIPTION
1	12-1-77	D.B.	R.L. Follett	REV. SWS SYSTEM & ADDED PART PLAN

REVISIONS

DRAWN BY: N.A. CHIN
DEPT. CHECK: R.L. Follett, J.R. Gagne
PROJ. CHECK: A.J. Marshall

MICHAEL EUGENE GRILLI No. 3620 REGISTERED PROFESSIONAL ENGINEER

M&E METCALF & EDDY, INC. / ENGINEERS
BOSTON / NEW YORK / PALO ALTO / CHICAGO

Lawrence E. Taylor — REG. PROF. ENGR. — MASS. NO. 6611 — 4/23/77 DATE
Michael E. Grilli — REG. PROF. ENGR. — R.I. NO. 3620 — 6-27-77 DATE

SCALE: 0 4 8 12 — SCALE IN FEET — SCALE 1/4" = 1'-0"

UNLESS OTHERWISE NOTED OR CHANGED BY REPRODUCTION

TOWN OF BURRILLVILLE, RHODE ISLAND
BOARD OF SEWER COMMISSIONERS

WASTEWATER TREATMENT FACILITIES

OPERATIONS BUILDING
SECOND FLOOR PLAN - WING

H.V.A.C. & PLUMBING

JOB 4868
FILE NO. H-69950-1
SHEET M-23

MAKEPEACE P-1457