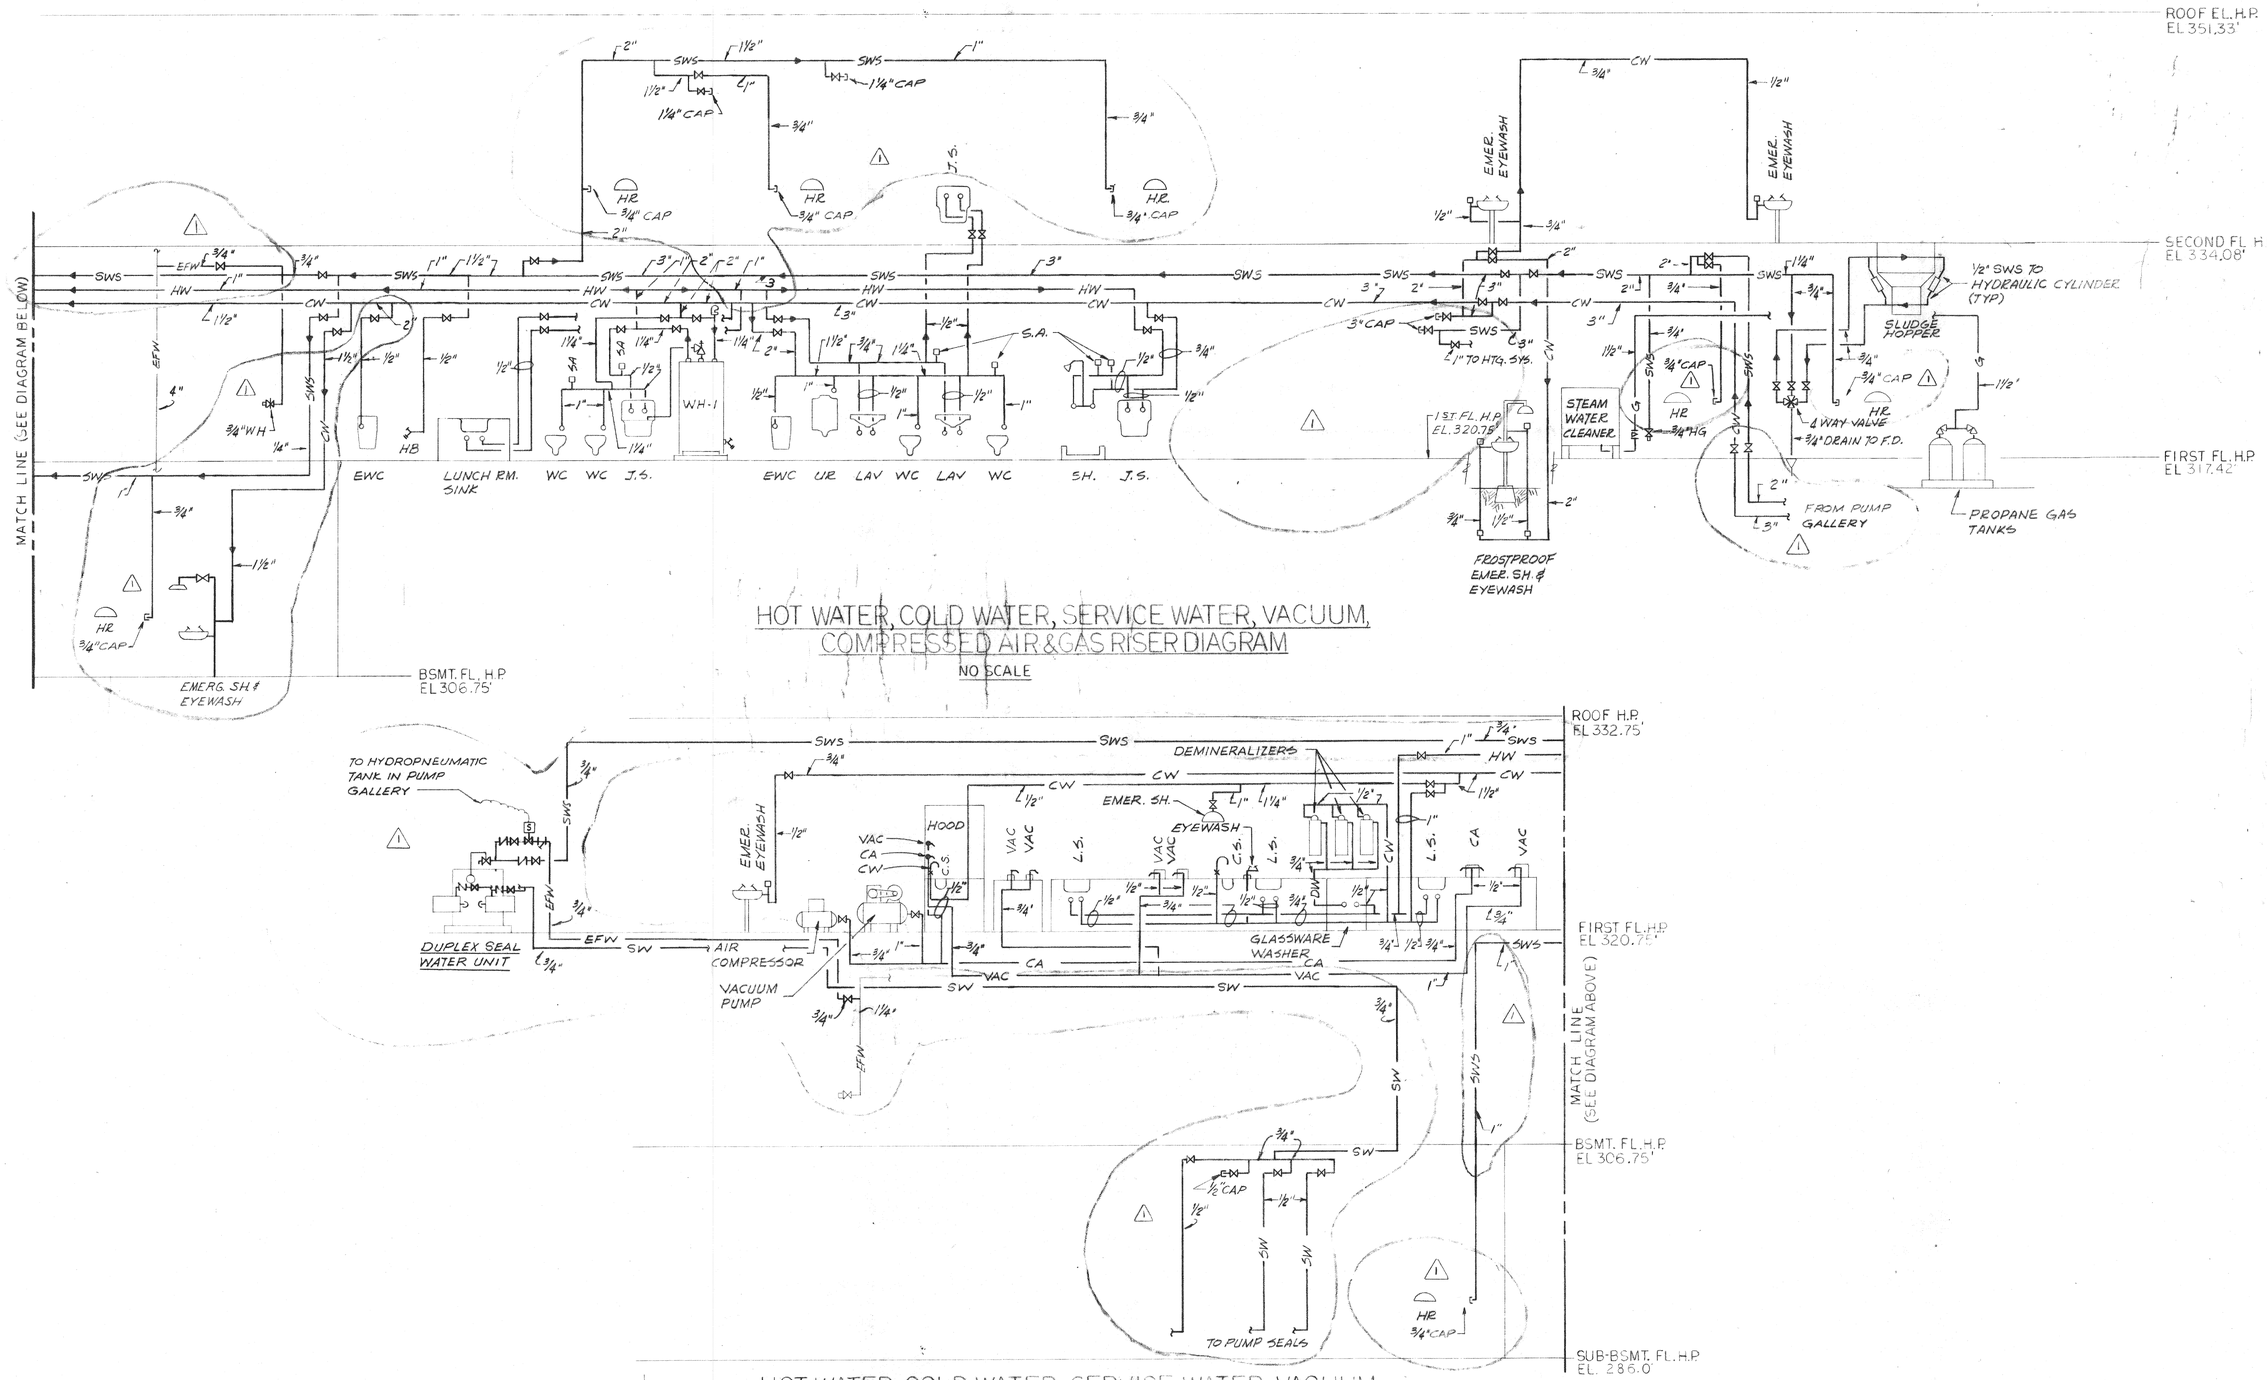

RECORD DRAWING

NUMBER	DATE	MADE BY	CHECKED BY	DESCRIPTION
1	12-1-77	D.B.	R.E. Fabbo	REV. SWS SYS & ADDED SW SYS.

REVISIONS

DRAWN BY: D. Burke
DEPT. CHECK: R.E. Fabbo
PROJ. CHECK: R.J. Marshall

MICHAEL EUGENE GRILLI No. 3620 REGISTERED PROFESSIONAL ENGINEER

METCALF & EDDY, INC. / ENGINEERS
BOSTON / NEW YORK / PALO ALTO / CHICAGO

Lawrence E. Tarbox — REG. PROF. ENGR. — MASS. NO. 6001 — 6/23/77 DATE
Michael E. Grilli — REG. PROF. ENGR. R.I. NO. 3620 — 6-27-77 DATE

SCALE: NONE

UNLESS OTHERWISE NOTED OR CHANGED BY REPRODUCTION

TOWN OF BURRILLVILLE, RHODE ISLAND
BOARD OF SEWER COMMISSIONERS

WASTEWATER TREATMENT FACILITIES

RISER DIAGRAM II

H.V.&.C. & PLUMBING

JOB 4868
FILE NO. H-69952-1
SHEET M-26

MAKEPEACE P-1457