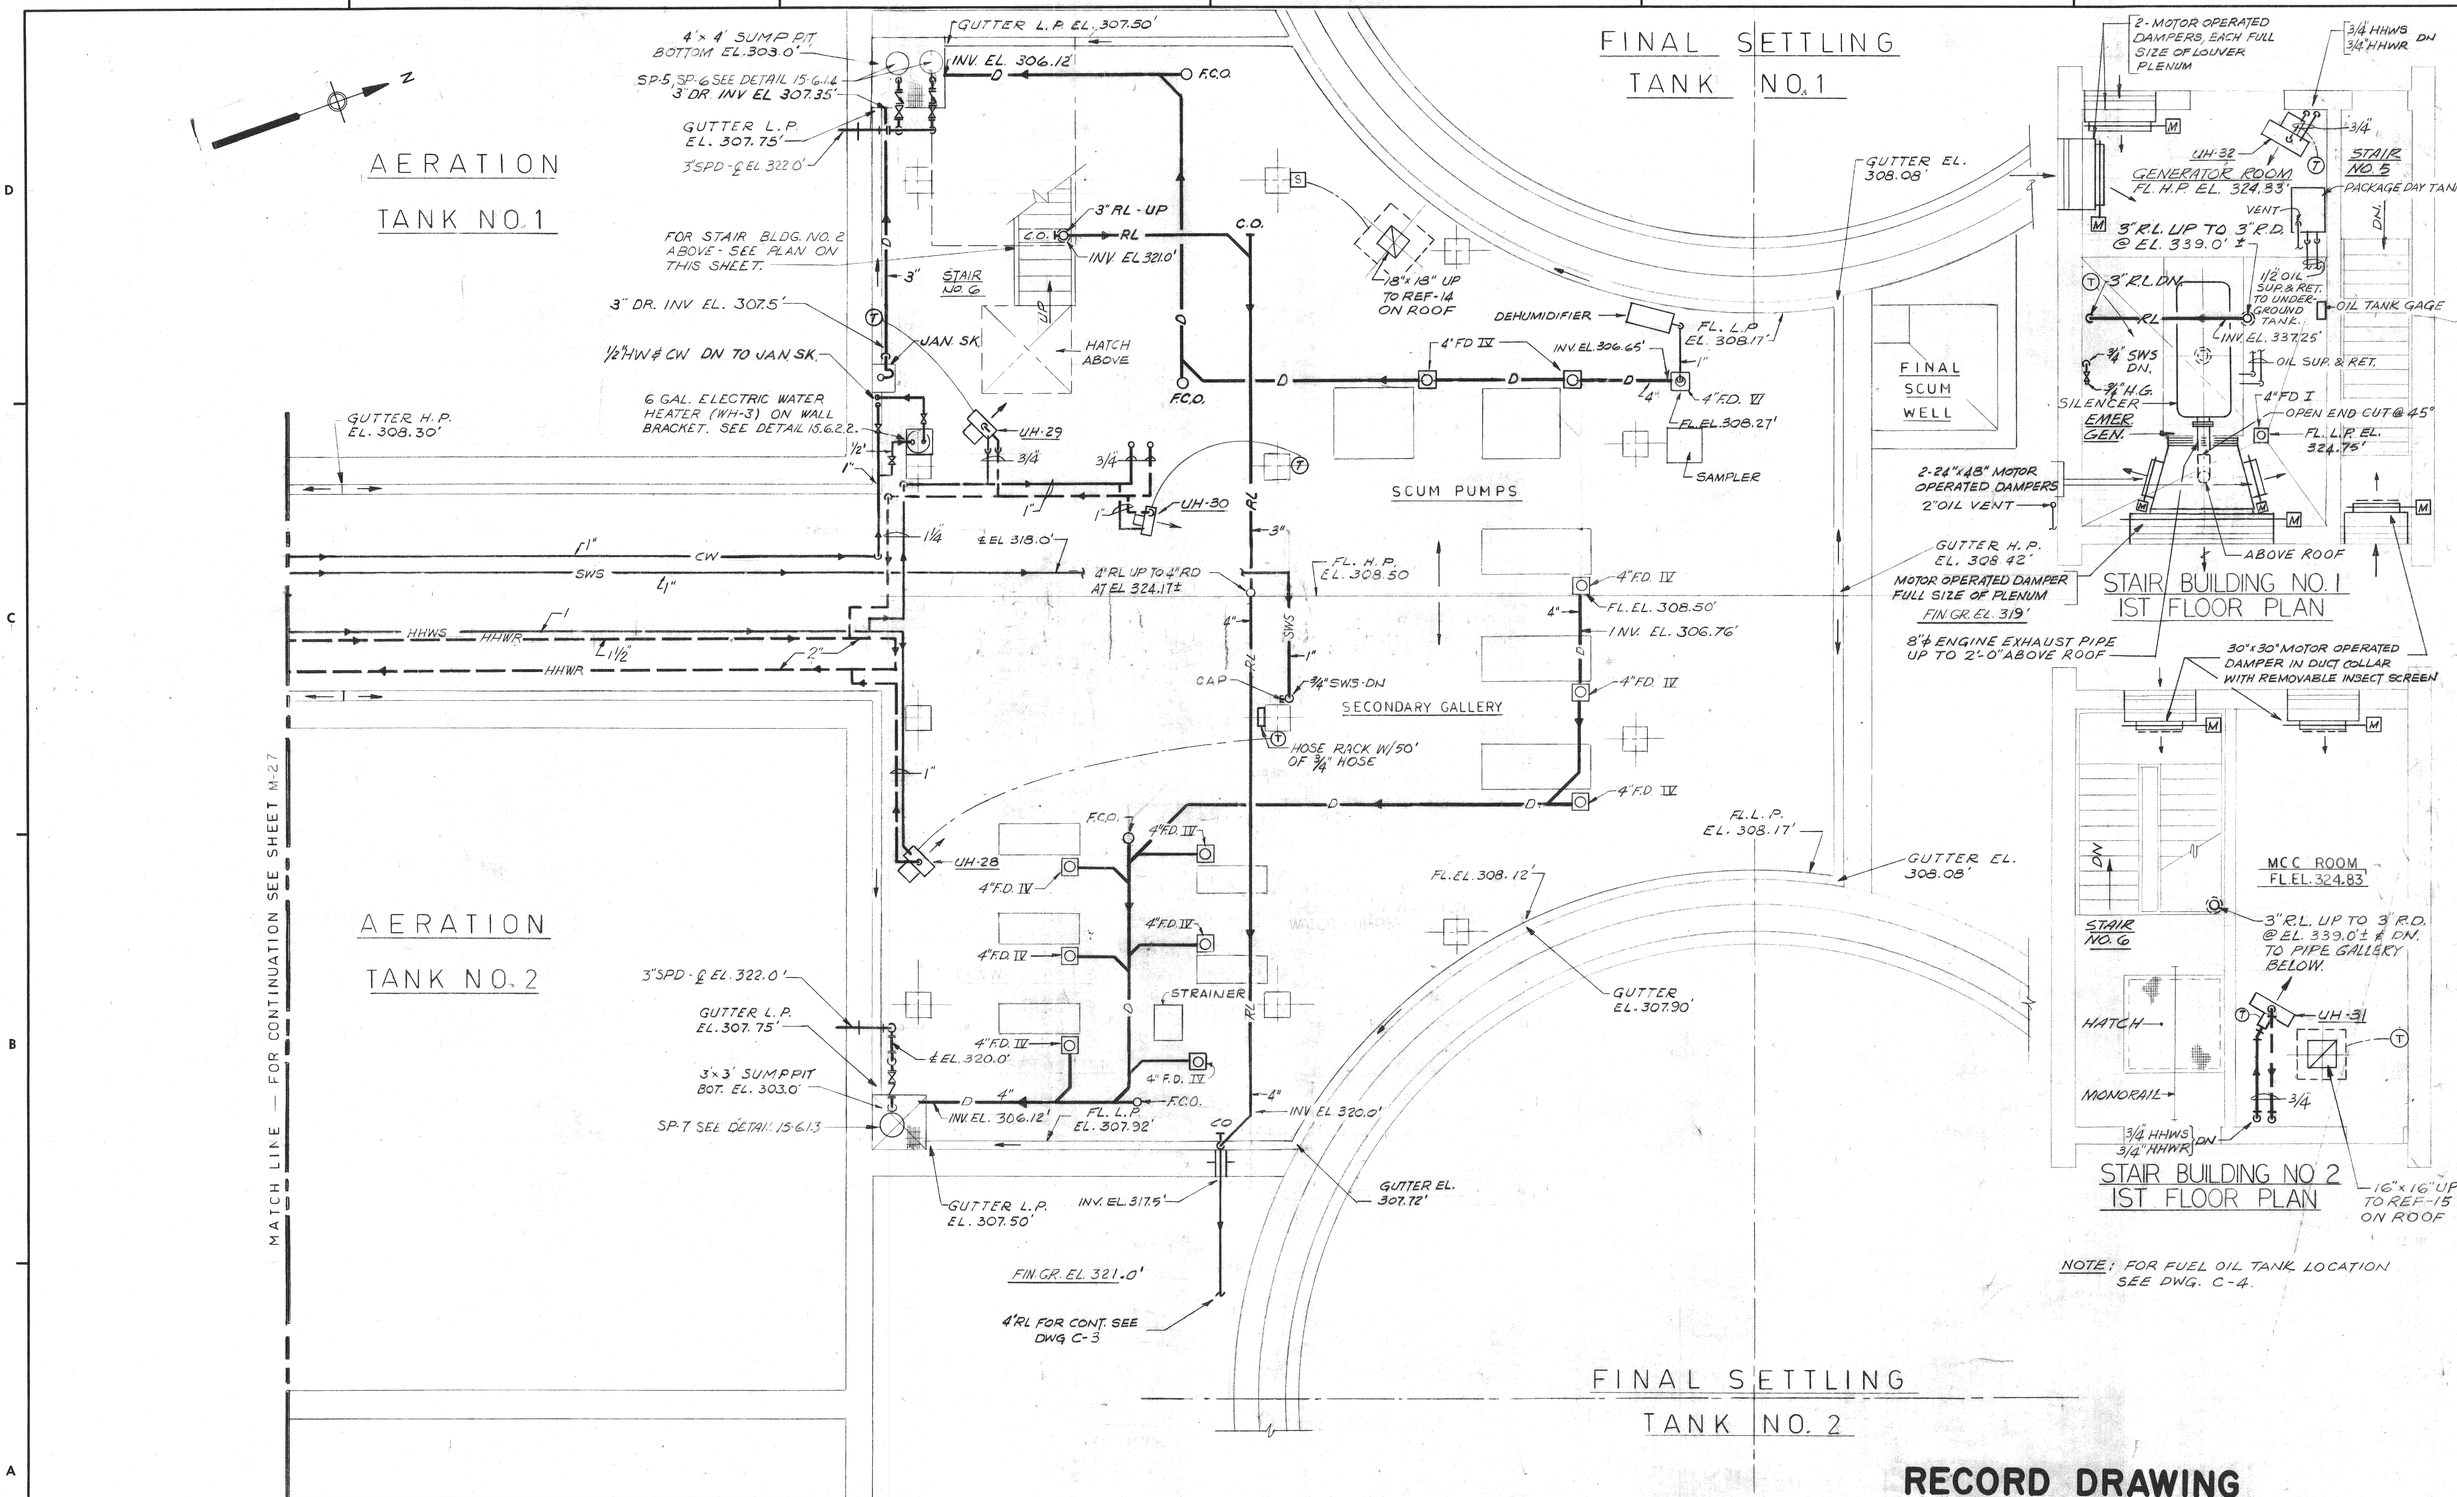

RECORD DRAWING

NUMBER	DATE	MADE BY	CHECKED BY	DESCRIPTION

REVISIONS

DRAWN BY: Carl C. Stockdale
DEPT. CHECK: R. L. Faddel, F. R. Appel
PROJ. CHECK: R. J. Marshall

MICHAEL EUGENE GRILLI No. 3620 REGISTERED PROFESSIONAL ENGINEER

M&E METCALF & EDDY, INC. / ENGINEERS
BOSTON / NEW YORK / PALO ALTO / CHICAGO

Lawrence E. Tarbox — REG. PROF. ENGR. MASS. NO. 6581 — 6/23/77 DATE
Michael E. Grilli — REG. PROF. ENGR. R.I. NO. 3620 — 6-27-77 DATE

SCALE: 0 4 8 12 — SCALE IN FEET — SCALE 1/4" = 1'-0"
UNLESS OTHERWISE NOTED OR CHANGED BY REPRODUCTION

TOWN OF BURRILLVILLE, RHODE ISLAND
BOARD OF SEWER COMMISSIONS
WASTEWATER TREATMENT FACILITIES
PUMP GALLERY LOWER PLAN II
H.V.A.C. & PLUMBING

JOB 4868
FILE NO. H-69037-1
SHEET M-28

MAKEPEACE P-1457