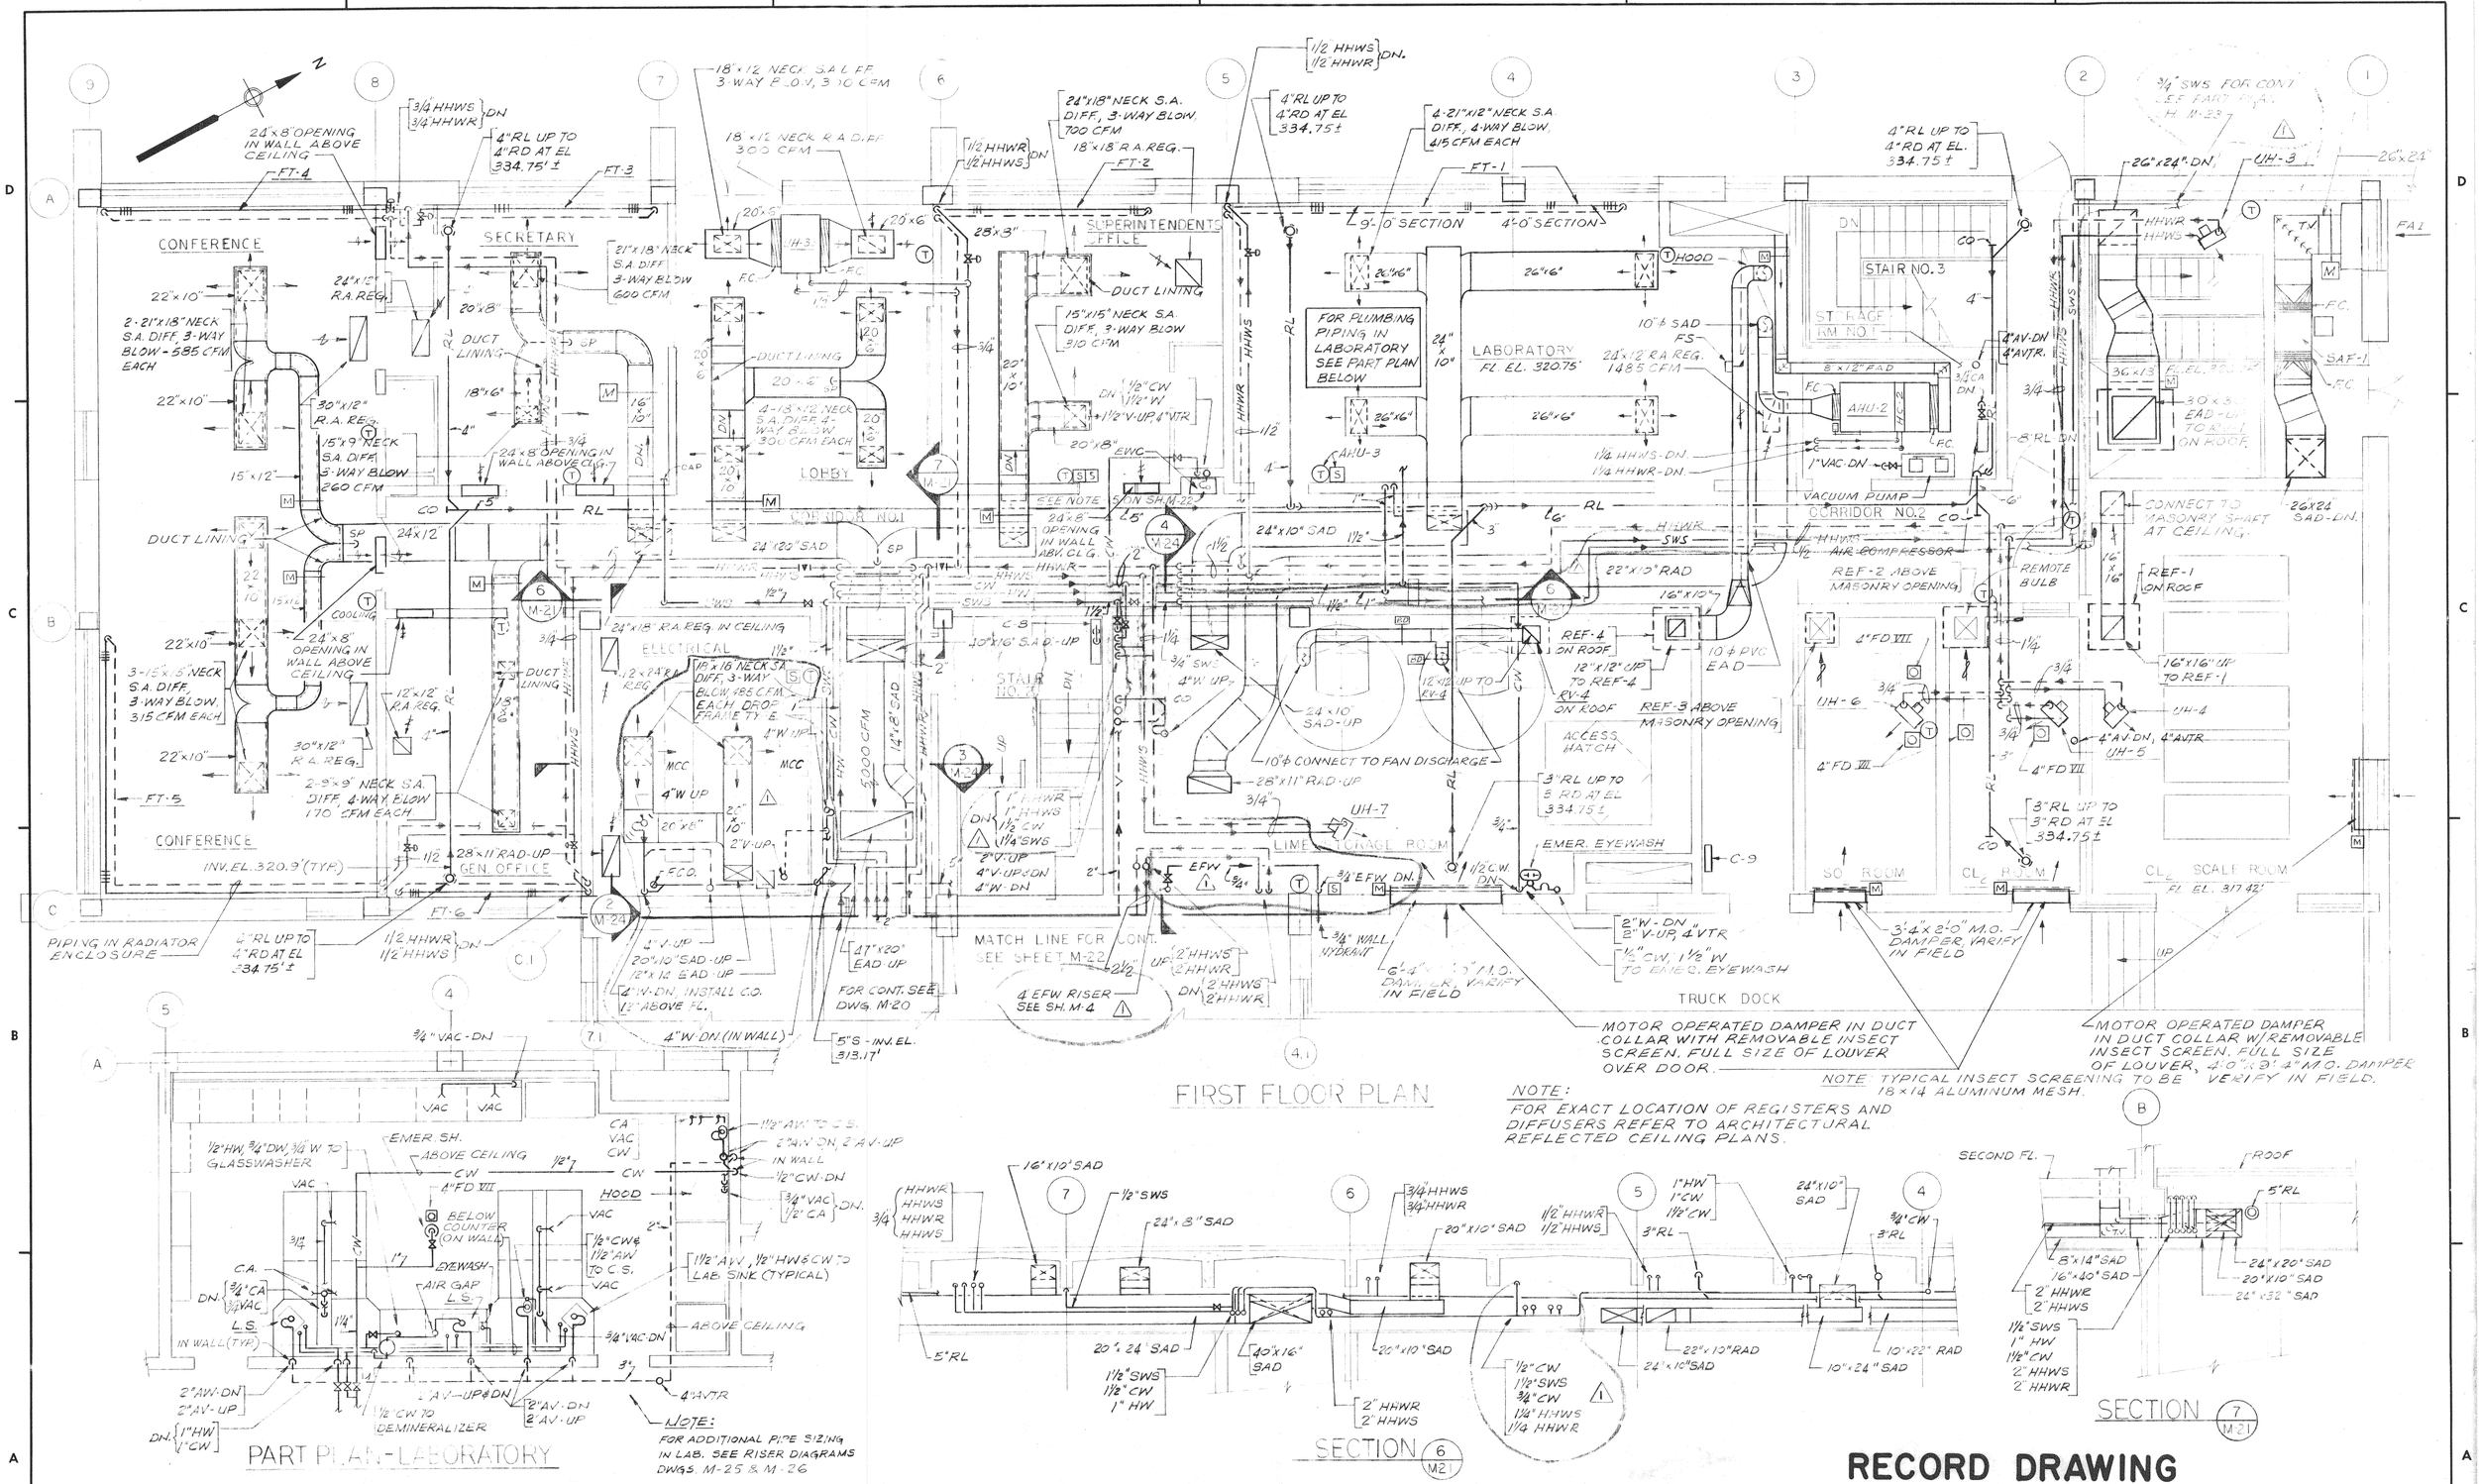

RECORD DRAWING

NUMBER	DATE	MADE BY	CHECKED BY	DESCRIPTION
1	12-7-77	C DONOVAN	R L Fadell	CHANGED DUCTS TO ACCOMODATE MOVED MCC'S. ADDED EFW & REV. CW, SWS & DRAINAGE SYSTEM.

REVISIONS

DRAWN BY: [signature]
DEPT. CHECK: R L Fadell, [signature]
PROJ. CHECK: R J Marshall

MICHAEL EUGENE GRILLI

M&E METCALF & EDDY, INC. / ENGINEERS
BOSTON / NEW YORK / PALO ALTO / CHICAGO

Lawrence E Taylor — REG. PROF. ENGR. — MASS. NO. 6881 — DATE 6/23/77
Michael E Grilli — REG. PROF. ENGR. — R.I. NO. 4620 — DATE 6-27-77

SCALE: 0 4 8 12 — SCALE IN FEET — SCALE 1/4" = 1'-0"

UNLESS OTHERWISE NOTED OR CHANGED BY REPRODUCTION

TOWN OF BURRILLVILLE, RHODE ISLAND
BOARD OF SEWER COMMISSIONERS

WASTEWATER TREATMENT FACILITIES

OPERATIONS BUILDING
FIRST FLOOR PLAN I

H.V.A.C. & PLUMBING

JOB 4868
FILE NO. H-69948-1
SHEET M-21

MAKEPEACE P-1457