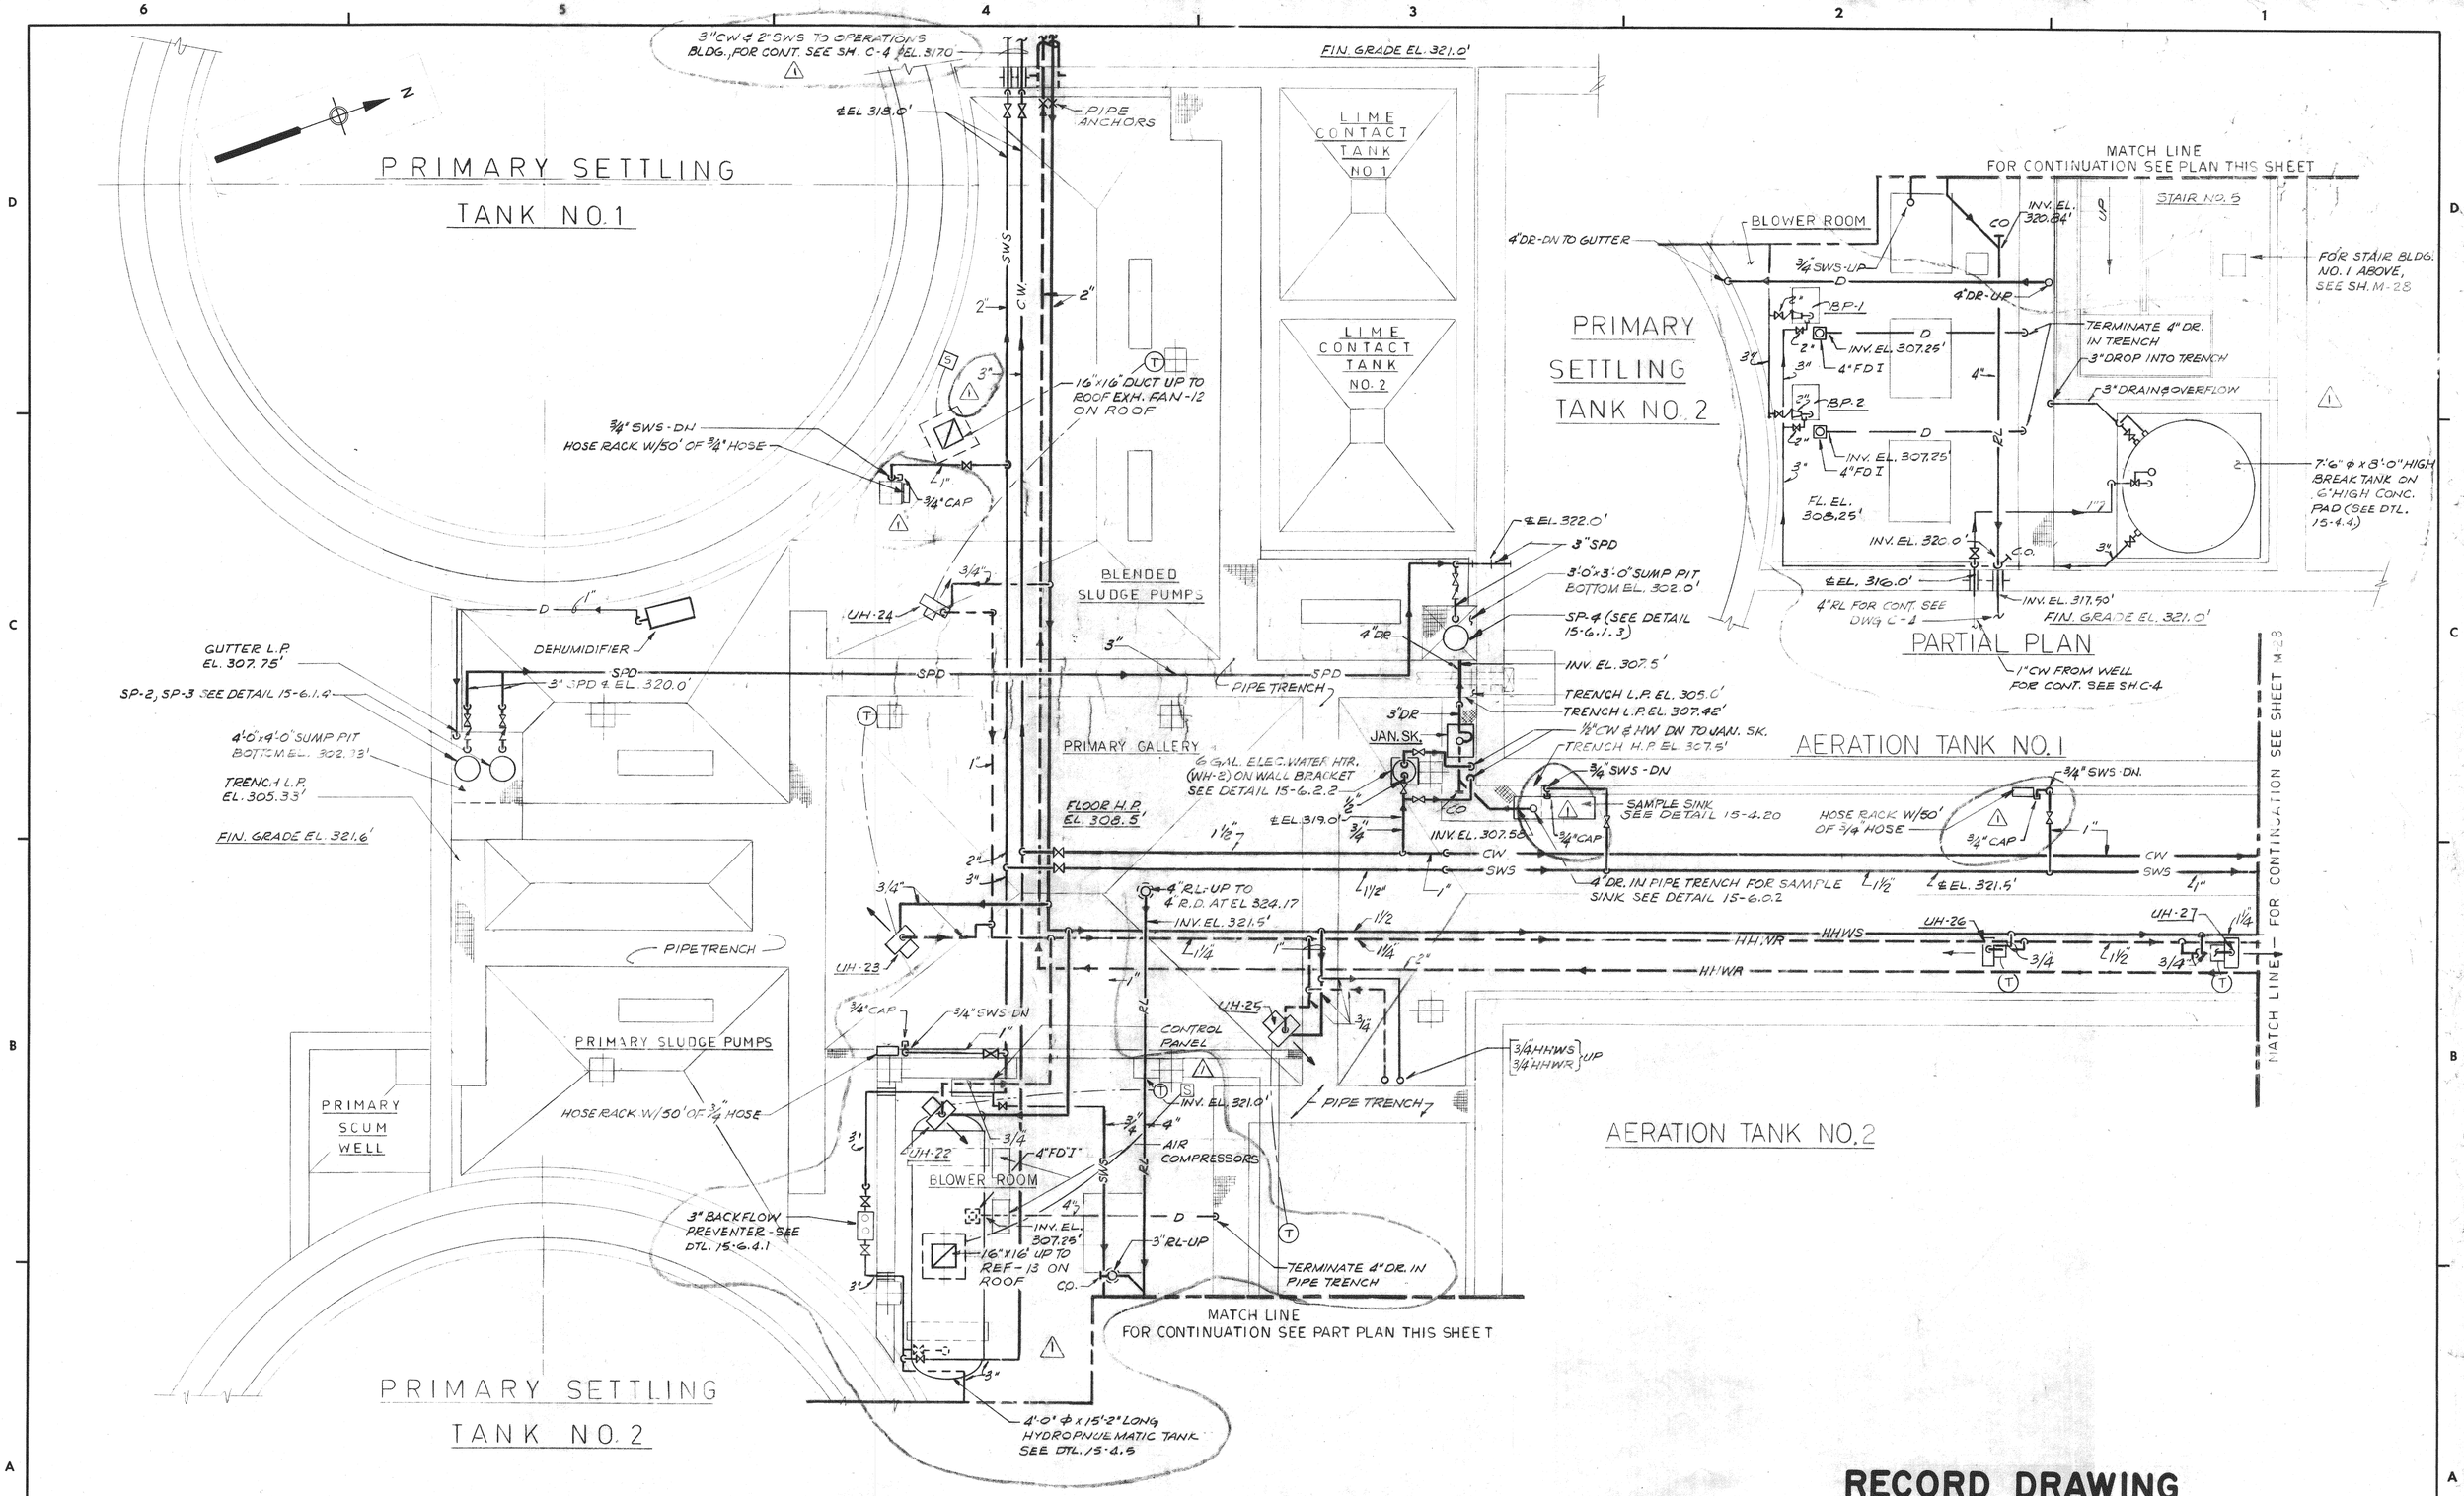

RECORD DRAWING

NUMBER	DATE	MADE BY	CHECKED BY	DESCRIPTION
1	12-7-77	C. DONOVAN	R.L. Fallel	MOVED THERMOSTAT AND SWITCH. ADDED BREAK TANK & HYDRO SYS. - REV. SWS. SYSTEM

REVISIONS

DRAWN BY N. NORBERG
DEPT. CHECK R.L. Fallel
PROJ. CHECK R.J. Marshall

MICHAEL EUGENE GRILLI No. 3620 REGISTERED PROFESSIONAL ENGINEER

M&E METCALF & EDDY, INC. / ENGINEERS
BOSTON / NEW YORK / PALO ALTO / CHICAGO

Lawrence E. Tarbox — REG. PROF. ENGR. MASS. NO. 6681 — DATE 6/23/77
Michael E. Grilli — REG. PROF. ENGR. R.I. NO. 3620 — DATE 6-27-77

SCALE: 0 4 8 12 — SCALE IN FEET — SCALE 1/4" = 1'-0"

UNLESS OTHERWISE NOTED OR CHANGED BY REPRODUCTION

TOWN OF BURRILLVILLE, RHODE ISLAND
BOARD OF SEWER COMMISSIONERS

WASTEWATER TREATMENT FACILITIES

PUMP GALLERY LOWER PLAN I

H.V.A.C. & PLUMBING

JOB 4868
FILE NO. H-69953-1
SHEET M-27

MAKEPEACE P-1457