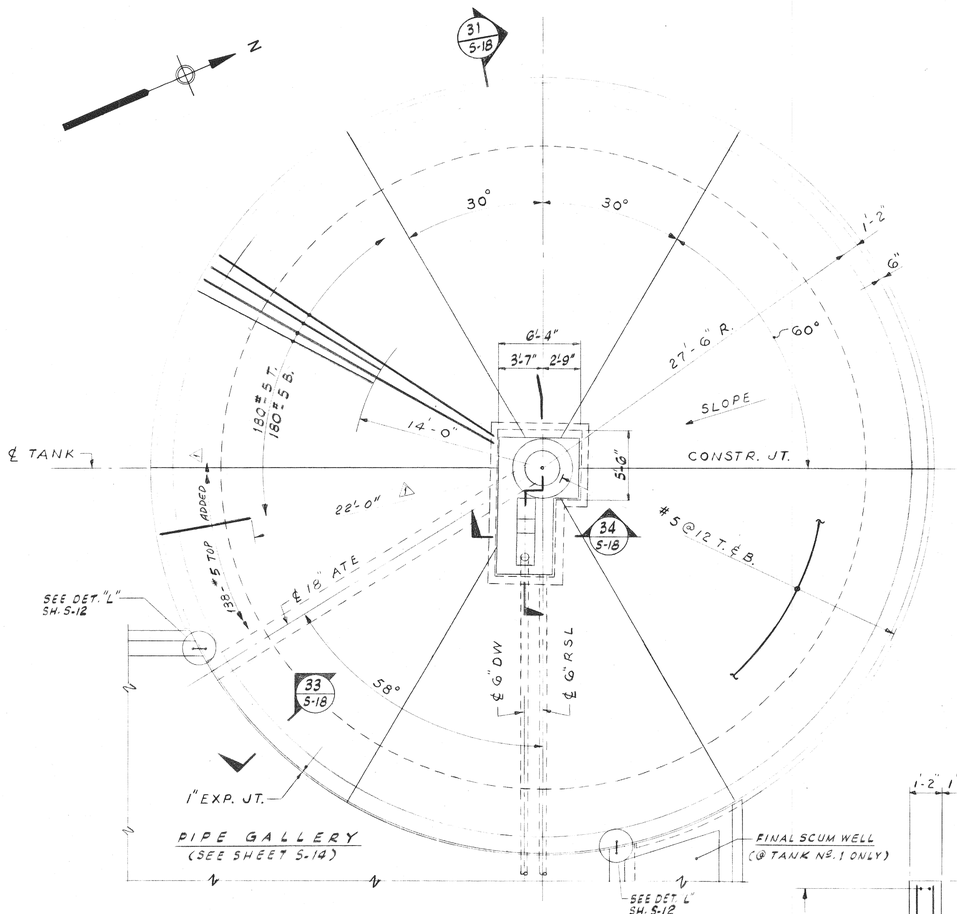

BOTTOM PLAN

SCALE : 3/16" = 1'-0"

NOTE: VERT. CONST. JTS. NOT PERMITTED IN TANK WALLS

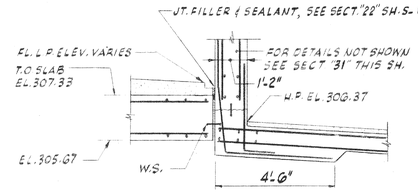

SECTION 33 S-14,S-18

SCALE : 3/8" = 1'-0"

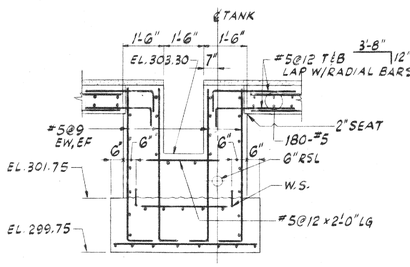

SECTION 34 S-18

SCALE : 3/8" = 1'-0"

℄ FINAL SETTLING TANK No. 1 AS SHOWN
FINAL SETTLING TANK No. 2 OPP. HAND

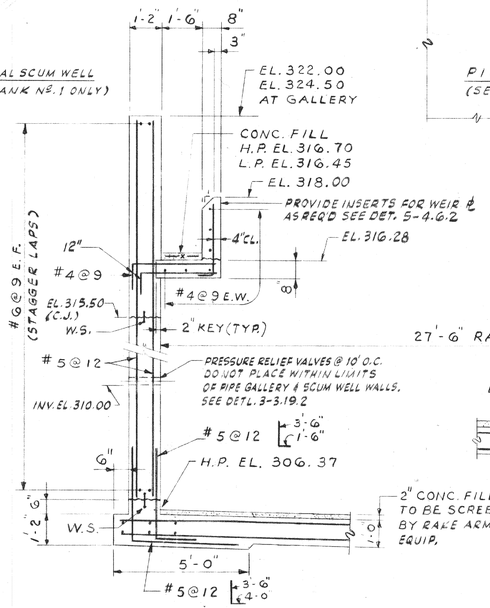

TOP PLAN

SCALE : 3/16" = 1'-0"

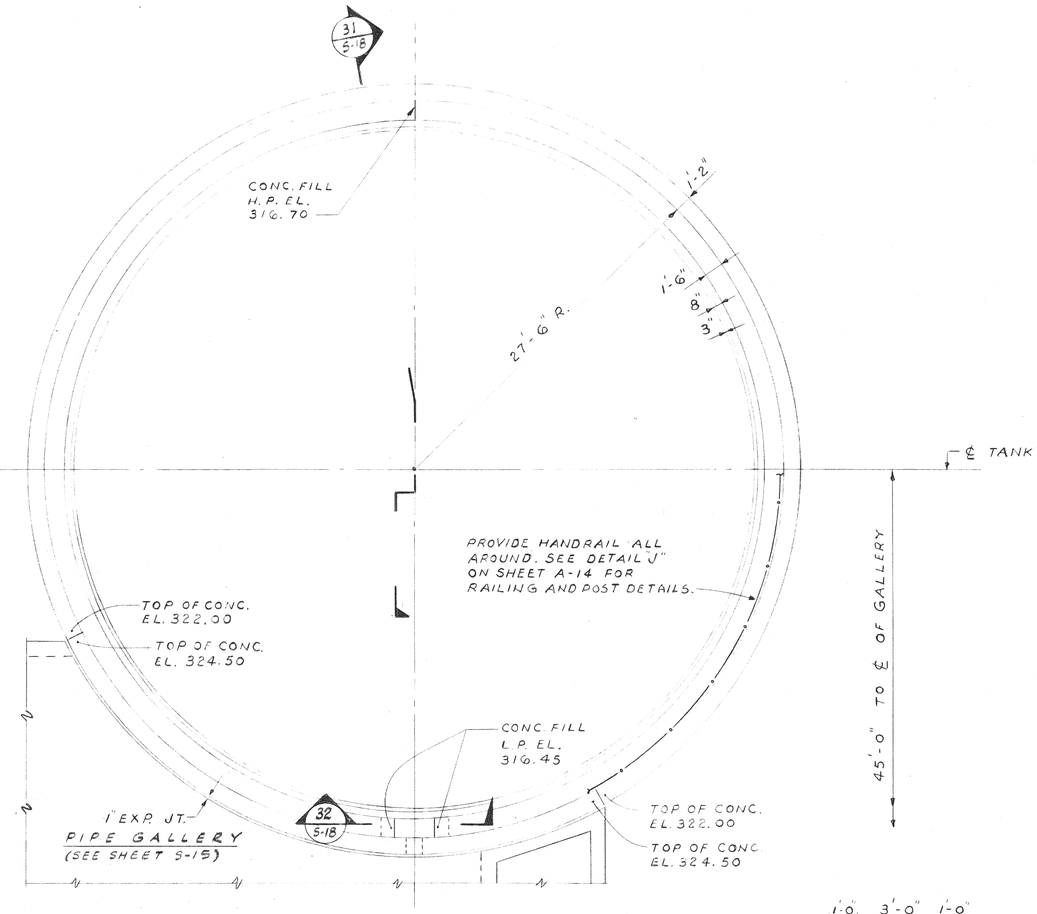

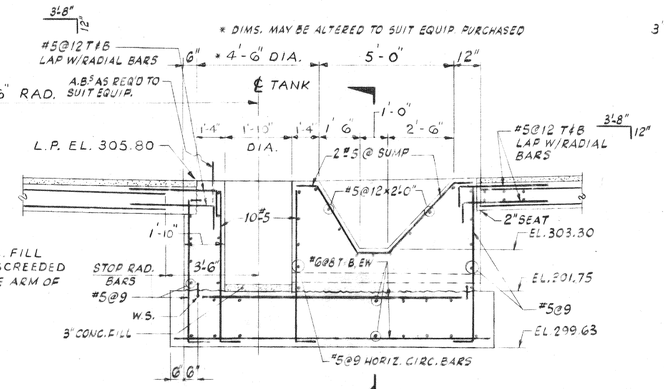

34 S-18

SECTION 31 S-18

SCALE 3/8" = 1'-0"

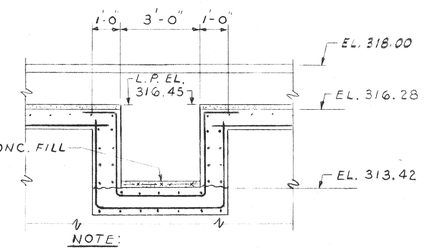

NOTE:
ALL REINF. #4@9 E.W., T.&B. UNLESS OTHERWISE NOTED. DWL. INTO TANK WALL

SECTION 32 S-18

SCALE : 3/8" = 1'-0"

RECORD DRAWING

NUMBER	DATE	MADE BY	CHECKED BY	DESCRIPTION
1	5-15-78	EGiserin		General Revisions

REVISIONS

DRAWN BY: R Horvath
DEPT. CHECK: Raymond J. Bernstein
PROJ. CHECK: W. J. Murdock

METCALF & EDDY, INC. / ENGINEERS
BOSTON / NEW YORK / PALO ALTO / CHICAGO

REG. PROF. ENGR. R.I. NO. 1310 — 6 27 77 DATE

REG. PROF. ENGR. R.I. NO. 3627 — 6 27 77 DATE

SCALE: AS SHOWN

UNLESS OTHERWISE NOTED OR CHANGED BY REPRODUCTION

TOWN OF BURRILLVILLE, RHODE ISLAND
BOARD OF SEWER COMMISSIONERS

WASTEWATER TREATMENT FACILITIES

FINAL SETTLING TANK

STRUCTURAL

JOB 4868

FILE NO. H-69006-1

SHEET S-18

MAKEPEACE P-1457