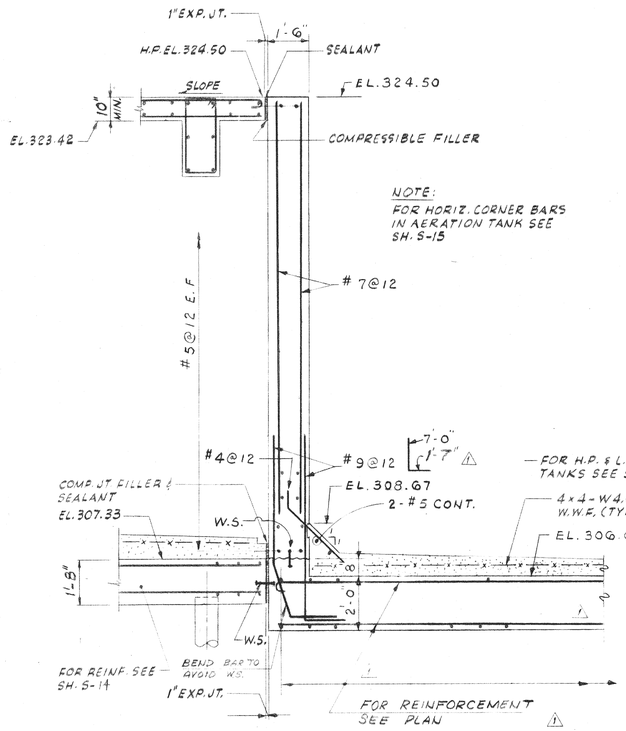

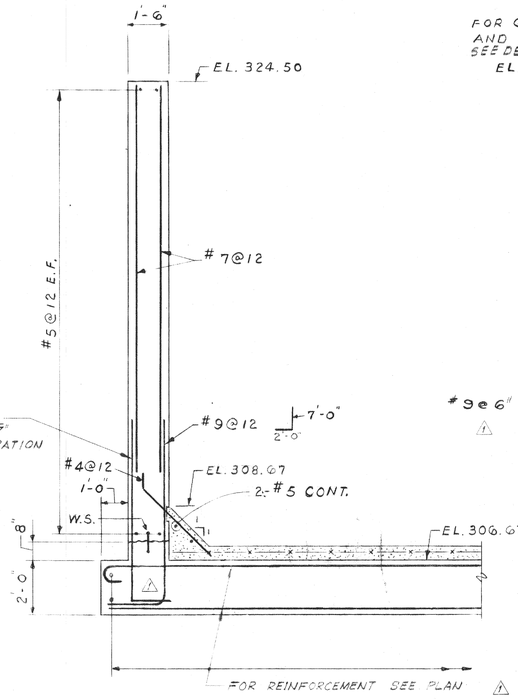

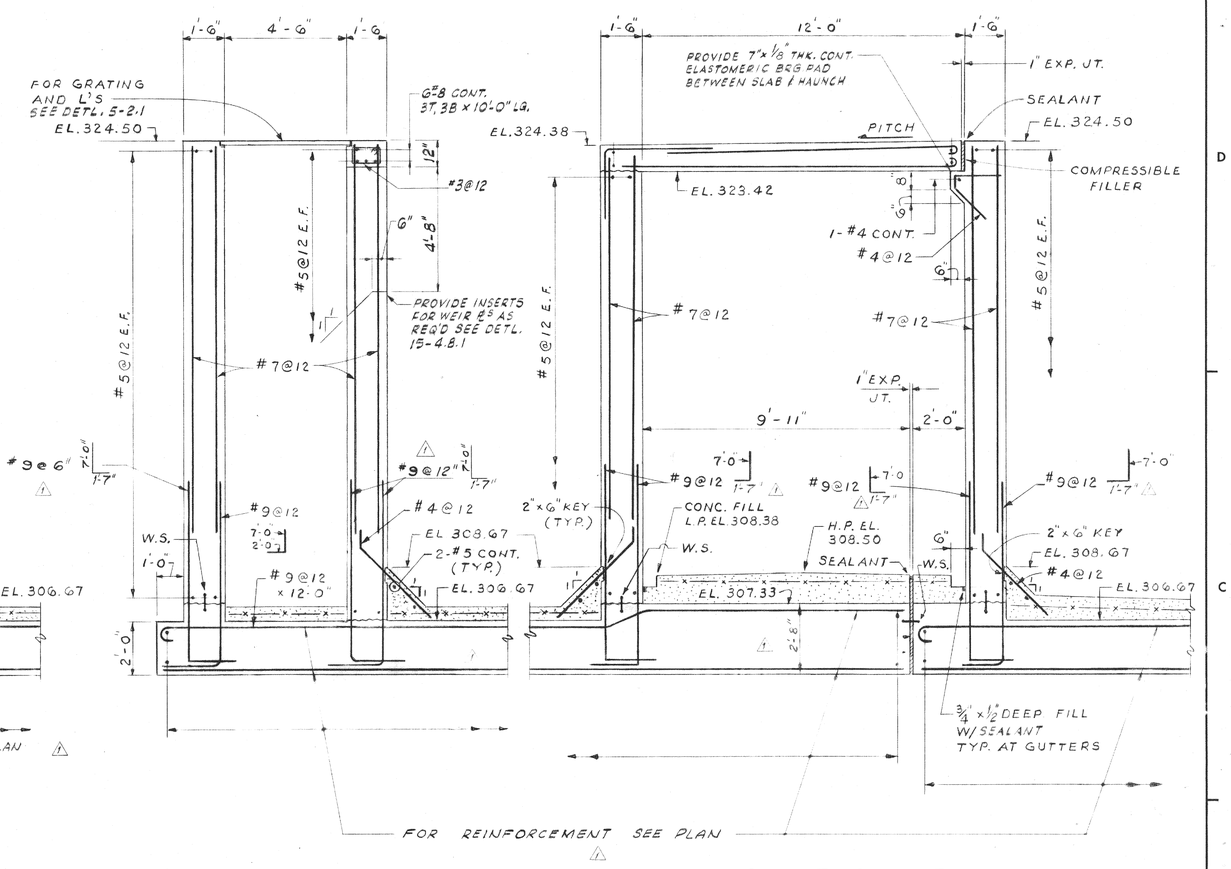

SECTION 19 (S-14, S-15)
SCALE: 3/8" = 1'-0"

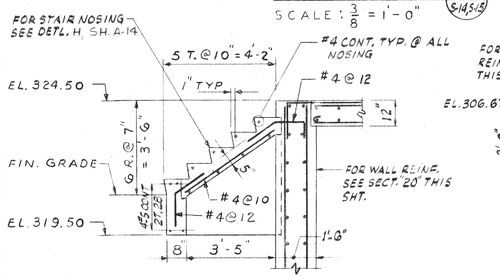

SECTION 20 (S-14, S-15)
SCALE: 3/8" = 1'-0"

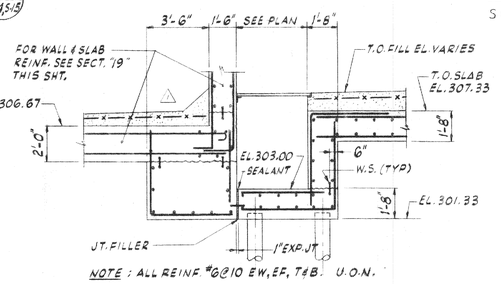

NOTE: ALL REINF. #6@10 EW, EF, T&B. U.O.N.

SECTION 21 (S-14, S-15)
SCALE: 3/8" = 1'-0"

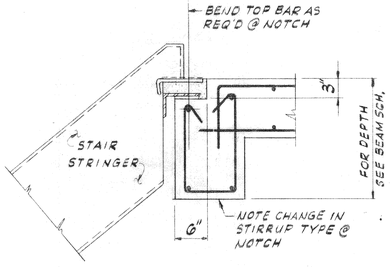

SECTION 22 (S-14, S-15)
SCALE: 3/8" = 1'-0"

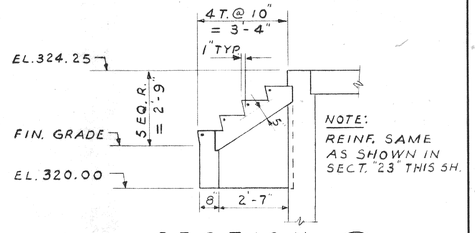

SECTION 23 (S-15)
SCALE: 3/8" = 1'-0"

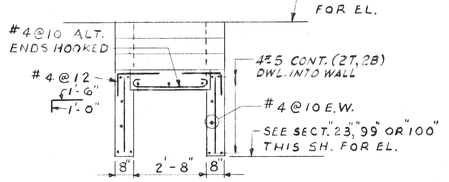

SECTION 24 (S-15)
SCALE: 3/8" = 1'-0"

SECTION 25 (S-14)
SCALE: 1/4" = 1'-0"

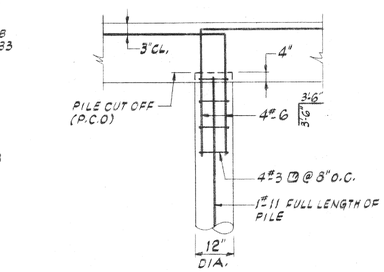

TYP. PILE DETAIL
NO SCALE

NOTE: FOR PILE CUT-OFF ELEV, SEE SCHED. ON SH. S-13

DETAIL (M, S-17)
NO SCALE

NOTE: LENGTH OF NOTCH SHALL BE 4" LONGER EA. SIDE THAN WIDTH BETWEEN STAIR STRINGERS.

SECTION 99 (S-15)
SCALE: 3/8" = 1'-0"

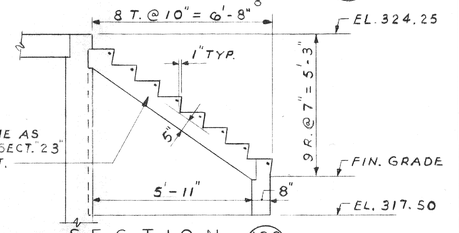

NOTE: REINF. SAME AS SHOWN IN SECT. "23" THIS SHEET.

SECTION 100 (S-15)
SCALE 3/8" = 1'-0"

RECORD DRAWING

NUMBER	DATE	MADE BY	CHECKED BY	DESCRIPTION
1	5-12-78	RGuilla		GENERAL REVISIONS

REVISIONS

DRAWN BY: Q. Gorgoglione, P. Dolan
DEPT. CHECK: Daniel J. Bourdeau
PROJ. CHECK: R.J. Marshall

THE STATE OF NEW HAMPSHIRE — ARTHUR B. ROBICHAUD JR. 7250 — PROFESSIONAL ENGINEER

MICHAEL EUGENE GRILLI — No. 3620 — REGISTERED PROFESSIONAL ENGINEER

METCALF & EDDY, INC. / ENGINEERS
BOSTON · NEW YORK / PALO ALTO / CHICAGO

REG. PROF. ENGR. — N.H. NO. 7780 — 6-27-77 DATE
REG. PROF. ENGR. — R.I. NO. 3620 — 6-27-77 DATE

SCALE: AS NOTED

UNLESS OTHERWISE NOTED OR CHANGED BY REPRODUCTION

TOWN OF BURRILLVILLE, RHODE ISLAND
BOARD OF SEWER COMMISSIONERS

WASTEWATER TREATMENT FACILITIES

AERATION TANKS AND PIPE GALLERY SECTIONS

STRUCTURAL

JOB NO. 4613
FILE NO. P-6900H-1
SHEET S-16

MAKEPEACE P-1457