


BASE SLAB PLAN
SCALE: 1/4" = 1'-0"

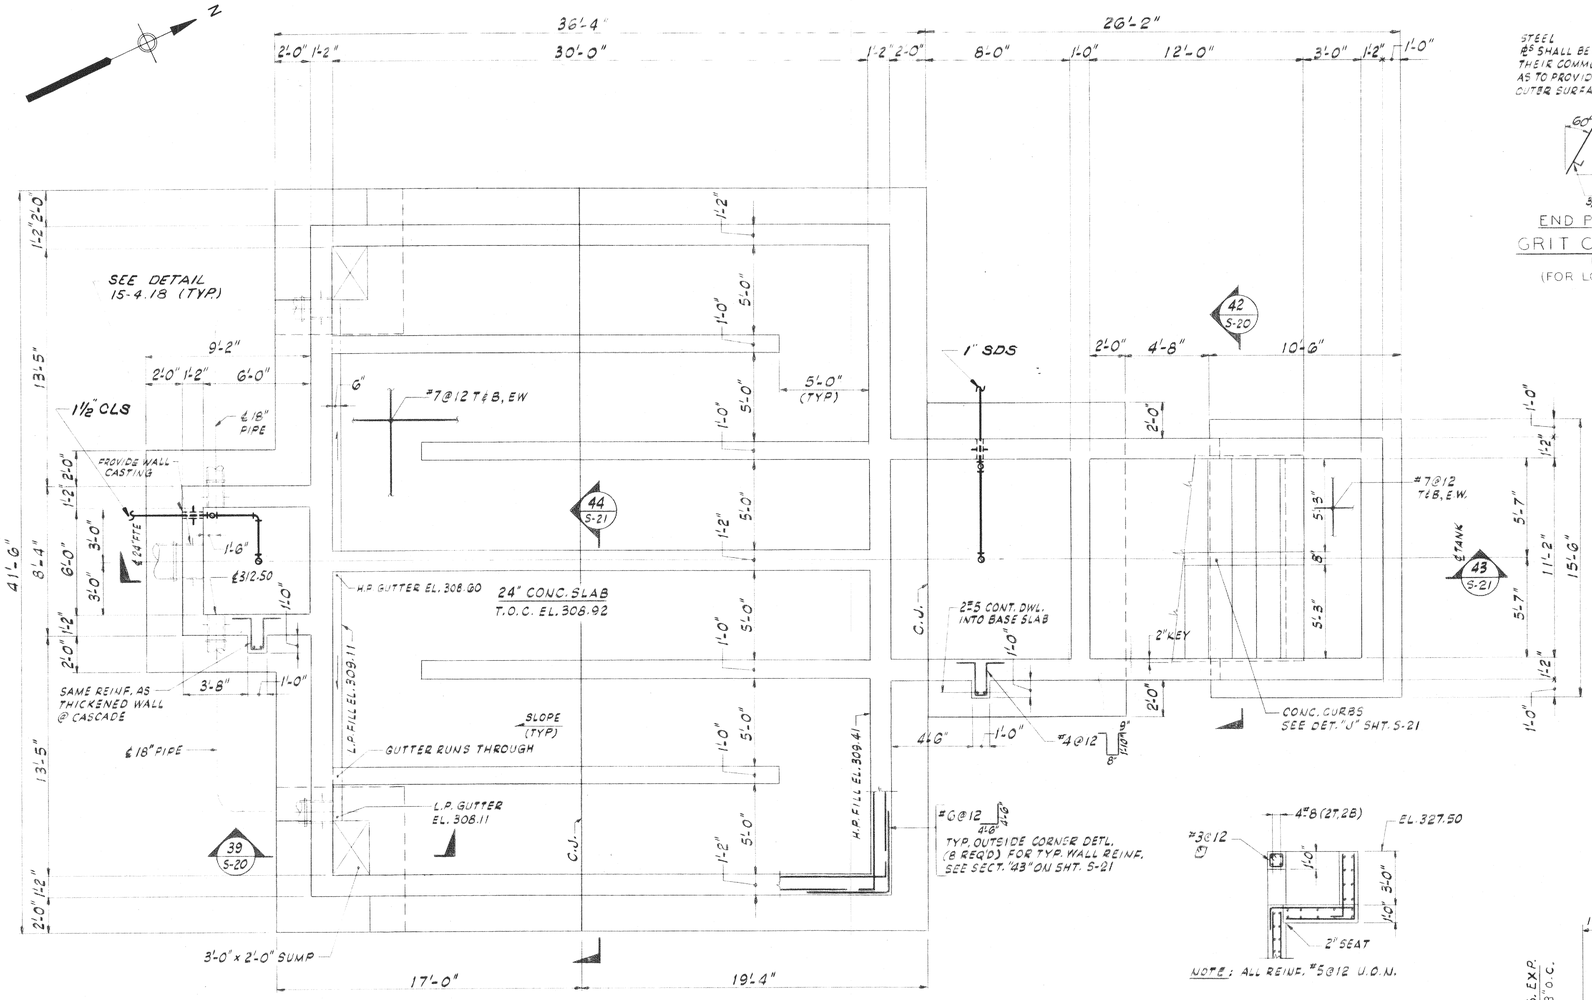


END PLATE SIDE PLATE
GRIT CHAMBER PLATE DETAILS
NO SCALE
(FOR LOCATION SEE SHT. S-19)




RAIL TIE-DOWN DETAIL
NO SCALE
(FOR LOCATION SEE SHT. S-19)

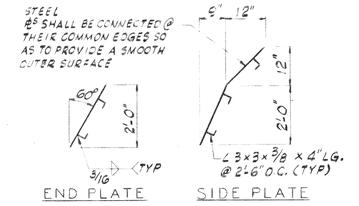


SECTION 42/S-20
SCALE: 1/4" = 1'-0"

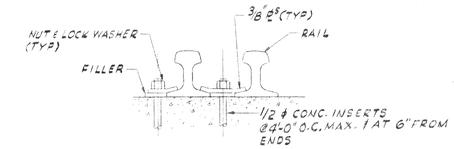


SECTION 50/S-19
SCALE: 1/4" = 1'-0"

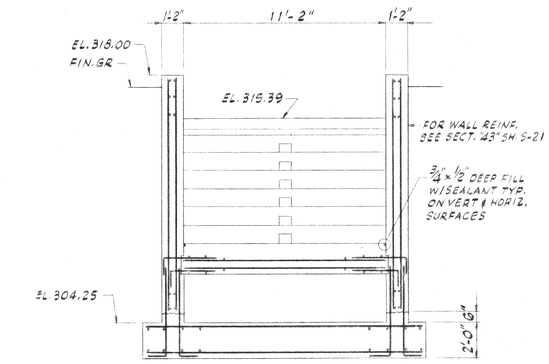


ELEVATION OF BAFFLE




SECTION 105/S-20
SCALE 3/8" = 1'-0"

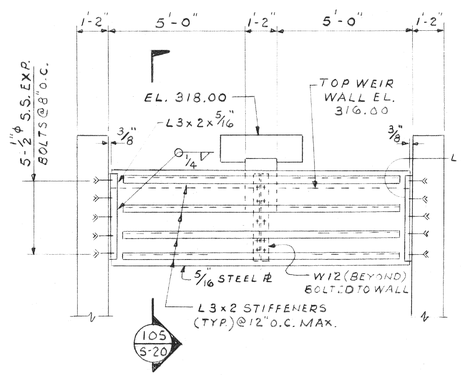


SECTION 39/S-20
SCALE: 1/4" = 1'-0"

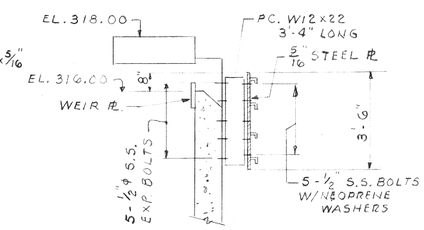


SECTION 40/S-19
SCALE: 1/4" = 1'-0"

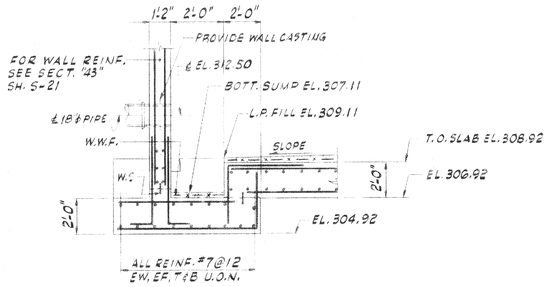


SECTION 41/S-19
SCALE: 1/4" = 1'-0"

# RECORD DRAWING
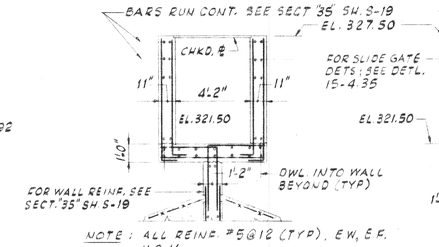
| NUMBER | DATE | MADE BY | CHECKED BY | DESCRIPTION |
|---|---|---|---|---|
| | | | | |

REVISIONS

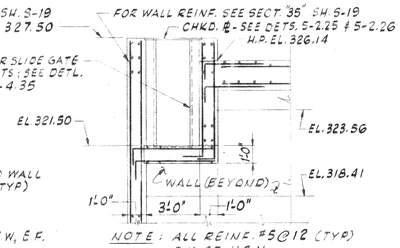DRAWN BY: P. Walton
DEPT. CHECK: Donald Donaldson
PROJ. CHECK: J. of Marshall

MICHAEL EUGENE GRILLI — NO. 3620 — REGISTERED PROFESSIONAL ENGINEER

M&E METCALF & EDDY, INC. / ENGINEERS
BOSTON / NEW YORK PALO ALTO CHICAGO

REG. PROF. ENGR. N.H. NO. 1380 — DATE
REG. PROF. ENGR. R.I. NO. 3620 — DATE 6-27-11

SCALE: AS SHOWN

UNLESS OTHERWISE NOTED OR CHANGED BY REPRODUCTION

TOWN OF BURRILLVILLE, RHODE ISLAND
BOARD OF SEWER COMMISSIONERS
WASTEWATER TREATMENT FACILITIES
CHLORINE CONTACT TANK
STRUCTURAL

JOB 4868
FILE NO. H-69009-1
SHEET S-20

MAKEPEACE P-1457