


REGISTER OF ACQUISITION

TRACT NO.	GRANTOR	ACREAGE			REMARKS
		FEE	EASM'T.	LEASED PERMIT	
14	U.S. RUBBER CO.		0.19		RCP EASEMENT
15	U.S. RUBBER CO.		0.17		" "
16	U.S. RUBBER CO.		0.13		" "
17	U.S. RUBBER CO.		0.24		" "
18	BOSTON & MAINE R.R. CO.		0.018		" "
19	BOSTON & MAINE R.R. CO.		0.015		" "
20	BOSTON & MAINE R.R. CO.		0.13		DIKE EASEMENT
20A	BOSTON & MAINE R.R. CO.		0.10		RCP EASEMENT
21	U.S. RUBBER CO.		0.06		" "
R6A	CHICOPEE MFG. CORP.	NOT ACQUIRED			DELETED FROM PLAN
R8	U.S. RUBBER CO.		3.0±		
R9	CHICOPEE MFG. CORP.		0.35±		
R10	WESTERN MASS. ELECTRIC CO.		2.8±		
R11	FRANK J. & MARY A. MURDZA		0.72		
R12	WALTER S. MURDZA	0.84			
R13	U.S. RUBBER CO.		26±		ACCESS FROM HAMPDEN ST.

LEGEND  
 □ S.B. — STONE BOUND FOUND.  
 ● I.P. — IRON PIPE OR IRON PIN FOUND.

11804  
 Hamden County Registry of Deeds  
 MAY 12 1985  
 RECEIVED FOR RECORD  
 3 O'CLOCK 19 P.M.  
 Plans 99 Page 11

11804  
 Hamden County Registry of Deeds  
 MAY 12 1985  
 RECEIVED FOR RECORD  
 3 O'CLOCK 19 P.M.  

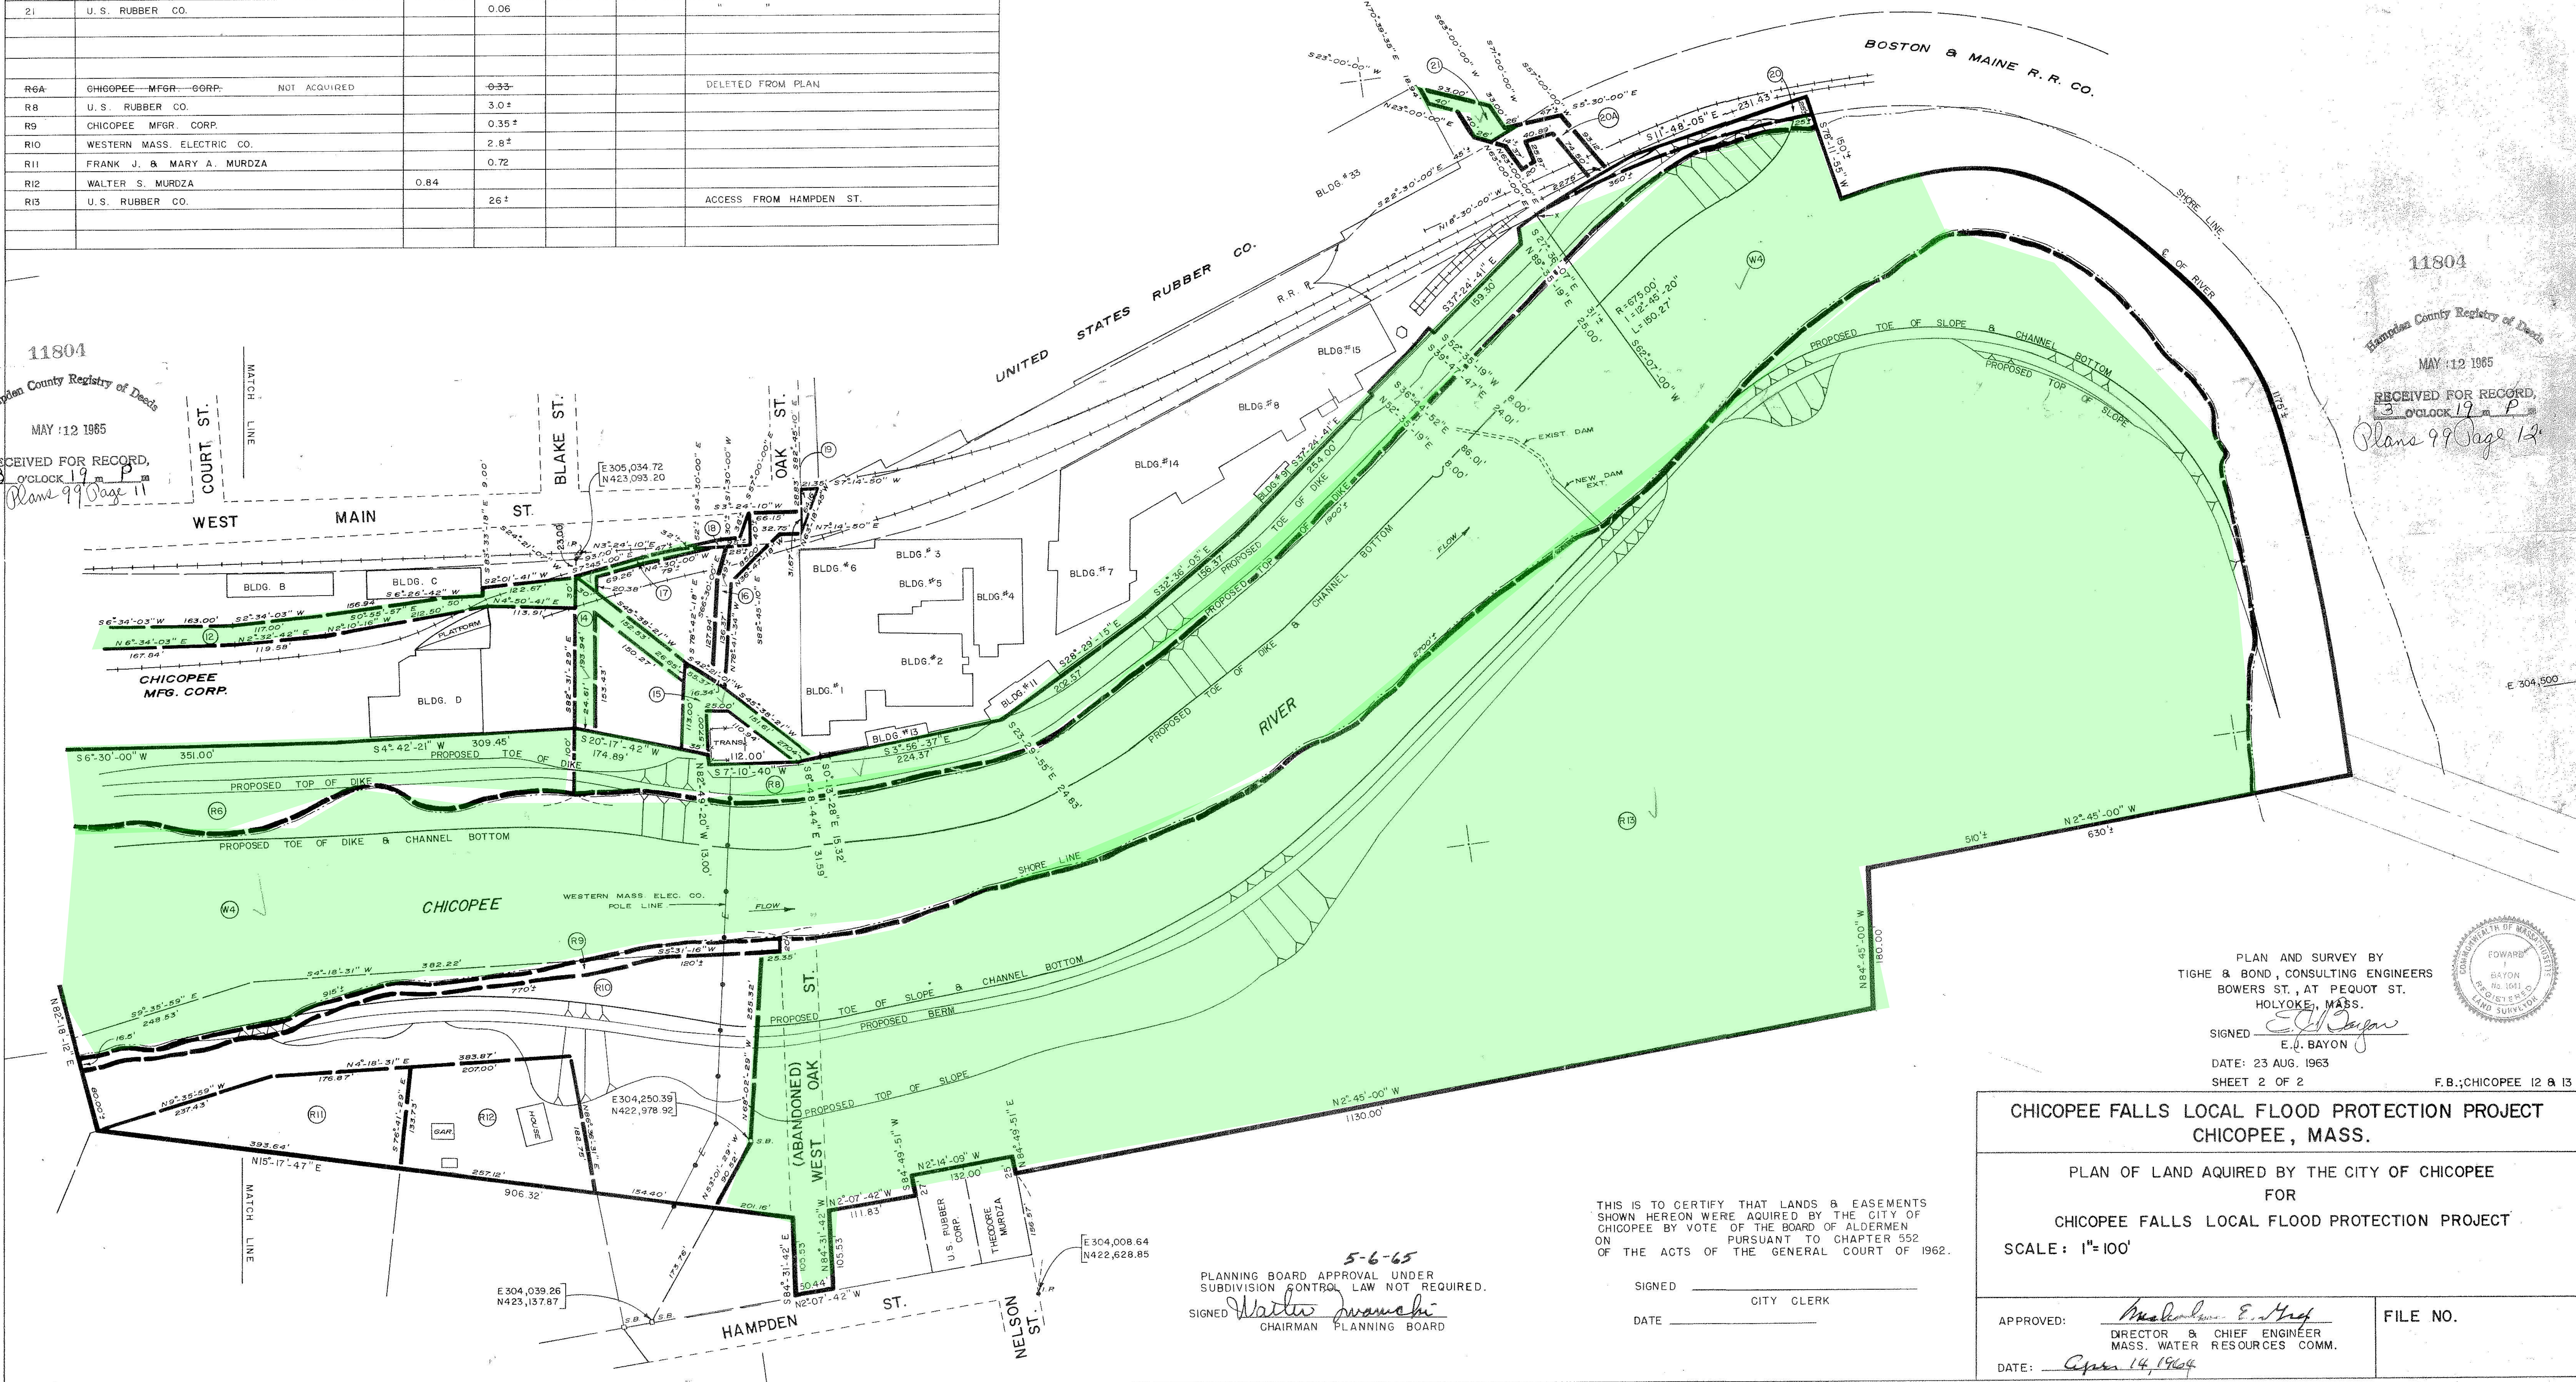

5-6-65  
 PLANNING BOARD APPROVAL UNDER  
 SUBDIVISION CONTROL LAW NOT REQUIRED.  
 CHAIRMAN PLANNING BOARD

THIS IS TO CERTIFY THAT LANDS & EASEMENTS  
 SHOWN HEREON WERE ACQUIRED BY THE CITY OF  
 CHICOPEE BY VOTE OF THE BOARD OF ALDERMEN  
 ON PURSUANT TO CHAPTER 552  
 OF THE ACTS OF THE GENERAL COURT OF 1962.

SIGNED \_\_\_\_\_ CITY CLERK  
 DATE \_\_\_\_\_

PLAN AND SURVEY BY  
 TIGHE & BOND, CONSULTING ENGINEERS  
 BOWERS ST., AT PEQUOT ST.  
 HOLYOKE, MASS.  
 SIGNED *E. J. Bayon*  
 E. J. BAYON  
 DATE: 23 AUG. 1963  
 SHEET 2 OF 2 F.B.; CHICOPEE 12 & 13

CHICOPEE FALLS LOCAL FLOOD PROTECTION PROJECT  
 CHICOPEE, MASS.

PLAN OF LAND ACQUIRED BY THE CITY OF CHICOPEE  
 FOR  
 CHICOPEE FALLS LOCAL FLOOD PROTECTION PROJECT  
 SCALE: 1"=100'

 DIRECTOR & CHIEF ENGINEER  
 MASS. WATER RESOURCES COMM.  
 DATE: *April 14, 1964*

FILE NO. \_\_\_\_\_