PB 229 Pg 26 3/27/13

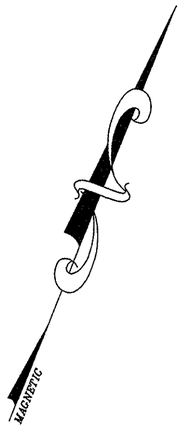

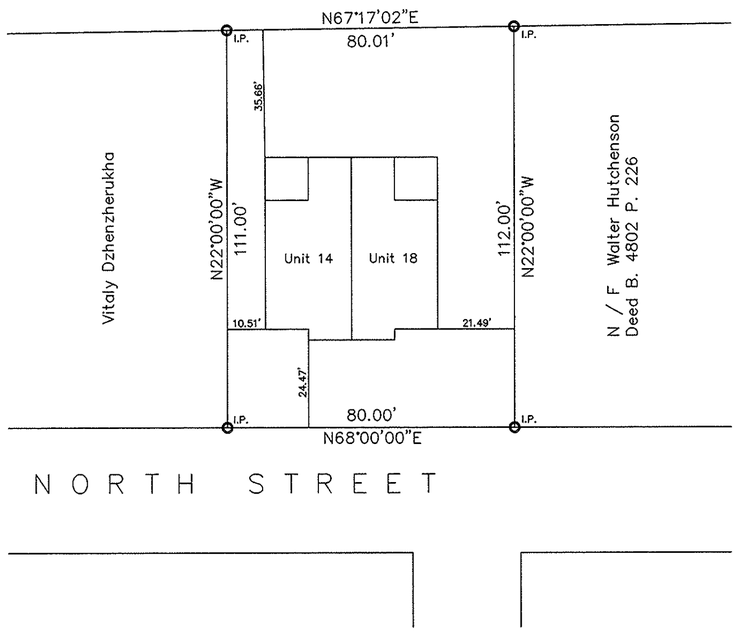

ANDERSON ASSOCIATES
LAND SURVEYOR, LAND
PLANNING CONSULTANT,
SITE DESIGN

375 WALNUT STREET EXTENTION
P.O. BOX 382
AGAWAM, MASSACHUSETTS 01001

Tel. 413 525-4145
Fax 413 273-1776

M & J Condominiums
SOUTH HADLEY, MA

PREPARED FOR:

Vitaly Dzhenzherukha
32 Westview Lane
Agawam, MA 01001

NO.	DATE	DESCRIPTION

2013 00007164
Bk: 229Pg: 26 Page: 1 of 1
Recorded: 03/27/2013 02:55 PM

I report that this plan shows the property lines that are the lines of existing ownerships, and the lines of streets and ways shown are those of public or private streets or ways already established, and no new lines for division of existing ownership or for new ways are shown.

Date: MARCH 25, 2013

Ronald R. Huot
Registered Land Surveyor

I certify that the plans fully and accurately depict the layouts, location, unit number and dimensions of the units as built.

Ronald R. Huot
Ronald R. Huot PLS

SCALE: 1" = 30'

DATE: March, 2013

GRAPHIC SCALE

30 0 15 30 60 120

(IN FEET)
1 inch = 30 ft.

This plan prepared in accordance with the rules and regulations of the Registry of Deeds.

Date: MARCH 25, 2013

COMMONWEALTH OF MASSACHUSETTS
RONALD R. HUOT
No. 31785
REGISTERED LAND SURVEYOR

Ronald R. Huot

DRAWING NO.